

12/14/76

9:30 A.M.
3/15/77
9:30 A.M.

3/23/77
afternoon
please

3/24/77

PERMIT

SEWAGE DISPOSAL SYSTEM

MARYLAND STATE DEPARTMENT OF HEALTH

HOWARD COUNTY

ELLICOTT CITY

INDEXED

Approved
Hal Benson

DISTRICT _____

DATE 11/26/76

J. N. Karey

J. N. KAREY

Waterloo Sanitation Co. 7994942

IS PERMITTED TO INSTALL

ALTER ☒

ADDRESS 102 Edgerton Road., Towson, Md. 21204

PHONE _____

A SEWAGE DISPOSAL SYSTEM LOCATED AT _____

SUBDIVISION _____

ROAD

8209 Washington Blvd.

LOT _____

(Colonial Auto Parts)

PROPERTY OWNER

J. N. Karey

J. N.K. Holding Company, Inc.

ADDRESS 3624 Lochearn Drive, Baltimore, Md. 21207

SPECIFICATIONS

DRAIN FIELD _____ DEPTH _____ FEET, BOTTOM AREA _____ SQ. FT.

SEEPAGE PITS _____ ABSORBENT SIDE-WALL AREA _____ SQ. FT.

SEPTIC TANK CAPACITY _____ GALLONS

FOR GARBAGE GRINDER, INCREASE DISPOSAL AREA 22% & TANK CAPACITY 50%.

OTHER REPAIR - Call for inspection when ground is opened up and Sanitarian will

recommend repair system. 12/14/76 Recommend trench 60 ft. long, 10 ft deep

5 ft of gravel under distribution pipe. If existing steel septic tank is collapsed or leaking a 1000 gal. septic tank will be installed. Trench to be placed parallel to Rte #1, about 100 ft. behind house. Call for insp. of trench before ground is installed.


PLANS APPROVED BY Palmer F. Wine

DATE 11/26/76

FILL SEPTIC TANK AND DISTRIBUTION BOX WITH WATER BEFORE CALLING FOR AN INSPECTION. COVER NO WORK UNTIL INSPECTED AND APPROVED.

NEITHER THE HOWARD COUNTY COMMISSIONERS NOR THE HEALTH DEPARTMENT IS RESPONSIBLE FOR THE SUCCESSFUL OPERATION OF ANY SYSTEM.

24824

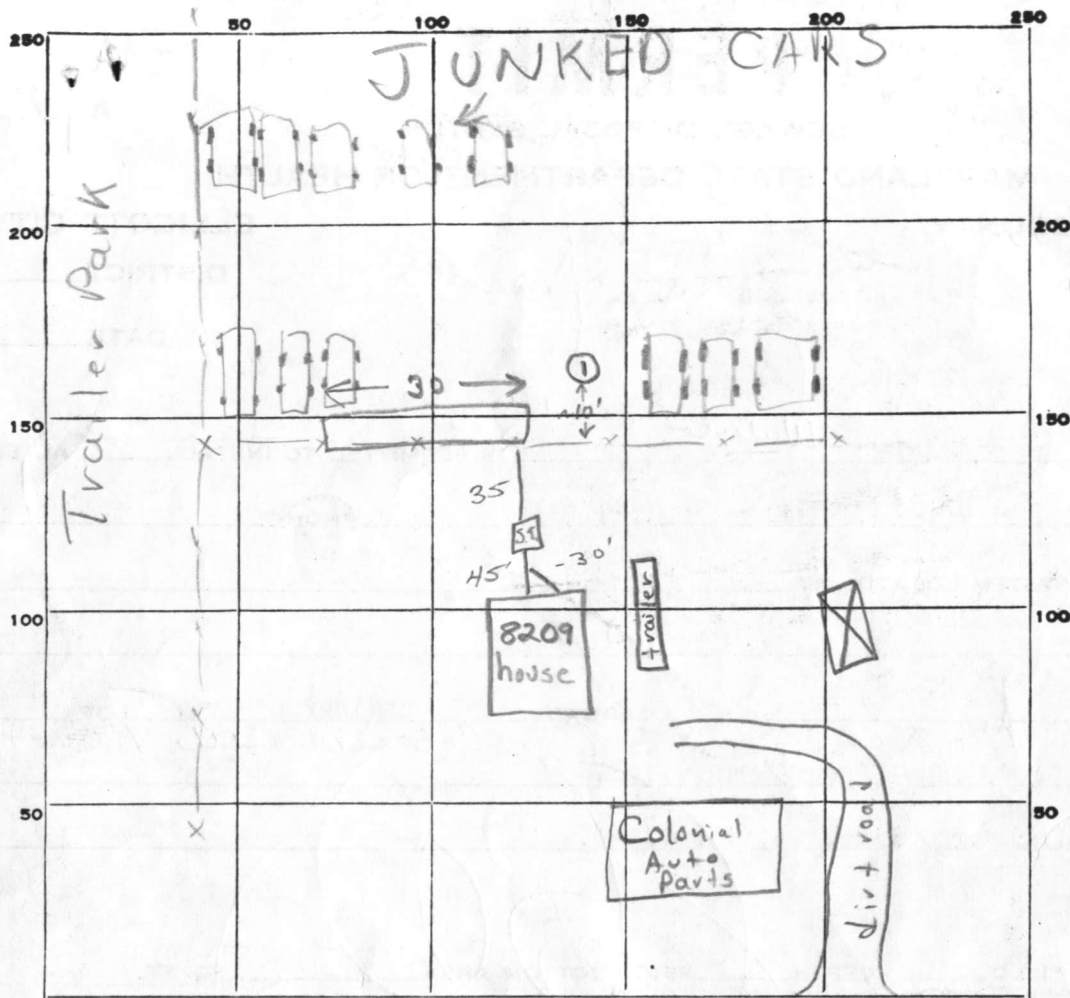

INDICATE NORTH. - NAME ADJOINING ROADWAY AS BASE LINE.

Rte 1

PERMIT CARD _____

SEPTIC TANK, LEVEL 1000 g/l

CLEANOUTS 3+ yes

DISTRIBUTION BOX, LEVEL _____

TILE FIELD, DEPTH 10' FT. TRENCH WIDTH 2-12' FT. variable

GRAVEL DEPTH 5 ft. IN. TOTAL LENGTH 30 FT.

NUMBER OF TRENCHES 1 one side TOTAL BOTTOM AREA ~ 350 ft²

SEEPAGE PITS, INSIDE DIAMETER _____ FT. DEPTH BELOW INLET _____ FT.

ABSORBENT AREA _____ SQ. FT.

REMARKS 12/14/76 hole dug O.K. F.S., 3/16/77 Septic tank exposed, is collapsed,
new tank required F.S., 3/23/77 - HIB - 12:15 pm - not ready
for insp. 3/28/77 - cover all work

DATE SYSTEM APPROVED March 28 1977 INSPECTOR hal Benson