

PERMIT

SEWAGE DISPOSAL SYSTEM

MARYLAND STATE DEPARTMENT OF HEALTH

HOWARD COUNTY

ELLICOTT CITY

DISTRICT 5th

DATE 6/16/81

Jack Fyock

IS PERMITTED TO INSTALL ☒ ALTER

ADDRESS 13775 Triadelphia Road, Glenelg, Md. 21737 PHONE 988-9270

SUBDIVISION Clarksville Ridge ROAD 6722 Surrey Lane LOT 45, Sec. 3

PROPERTY OWNER Dr. Donald Coker Clarksville, Md.

ADDRESS 6428 Brass Knoll, Columbia, Maryland 21044

SPECIFICATIONS 4 Bedrooms

SEPTIC TANK CAPACITY 1250 GALLONS

DRAIN FIELD _____ DEPTH _____ FEET, BOTTOM AREA _____ SQ. FT.

DEEP TRENCH _____ DEPTH _____ FEET, BOTTOM AREA _____ SQ. FT.

TRENCH

SEEPAGE PITS ☒ ABSORBENT SIDE-WALL AREA 600 SQ. FT.

INLET PIPE _____ FT. BELOW ORIGINAL GRADE. MAXIMUM DEPTH _____ FT. BELOW ORIGINAL GRADE

EFFECTIVE DEPTH AT _____ FT. BELOW ORIGINAL GRADE.

LOCATE DISPOSAL AREA _____ FT. FROM _____ LOT LINE AND _____ FT. FROM _____ LOT LINE AS SEEN WHEN
FACING LOT FROM

Trench absorption system for 4 bedroom house to have a total of 600 sq. ft. sidewall absorption area (one side only). Trench inlet to be at 4 to 4 1/2 ft. below original grade with 6 ft. of gravel under distribution pipe (for a maximum depth of 10 to 10 1/2 ft. below original grade). Start the trench 100 ft from the back lot line and 10 feet from the left side line as seen when facing the property from the road (Surrey Lane) continue to dig trench on level ground for 100 ft. in total length. Call for inspection of trench before gravel is installed. See approved plan of 10/30/80 for more details.

PLANS APPROVED BY Frank Skinner/ Jim Stayer DATE 10/30/80 9/22/80 7/6/81 J.S.

COVER NO WORK UNTIL INSPECTED AND APPROVED.

NEITHER THE HOWARD COUNTY COUNCIL NOR THE HEALTH DEPARTMENT IS RESPONSIBLE FOR THE SUCCESSFUL OPERATION OF ANY SYSTEM.

NOTE: IF TRENCH IS USED CALL FOR INSPECTION BEFORE PLACING GRAVEL IN TRENCH.


NOTE: NO DRY WELL SHALL EXCEED 15 FOOT IN DIAMETER.

NOTE: ALL PIPE FROM HOUSE TO DISPOSAL AREA MUST BE CAST IRON.

PERMIT VOID AFTER THREE YEARS.

NOTE: INSTALL STAND PIPE ON SEPTIC TANK AND DRY WELL. STAND PIPES MUST BE 6 INCHES IN DIAMETER. CAST IRON, CONCRETE OR TERRAZO ACCEPTED.

*INSTALLER IS RESPONSIBLE FOR OBTAINING FINAL APPROVAL ON THIS PERMIT.

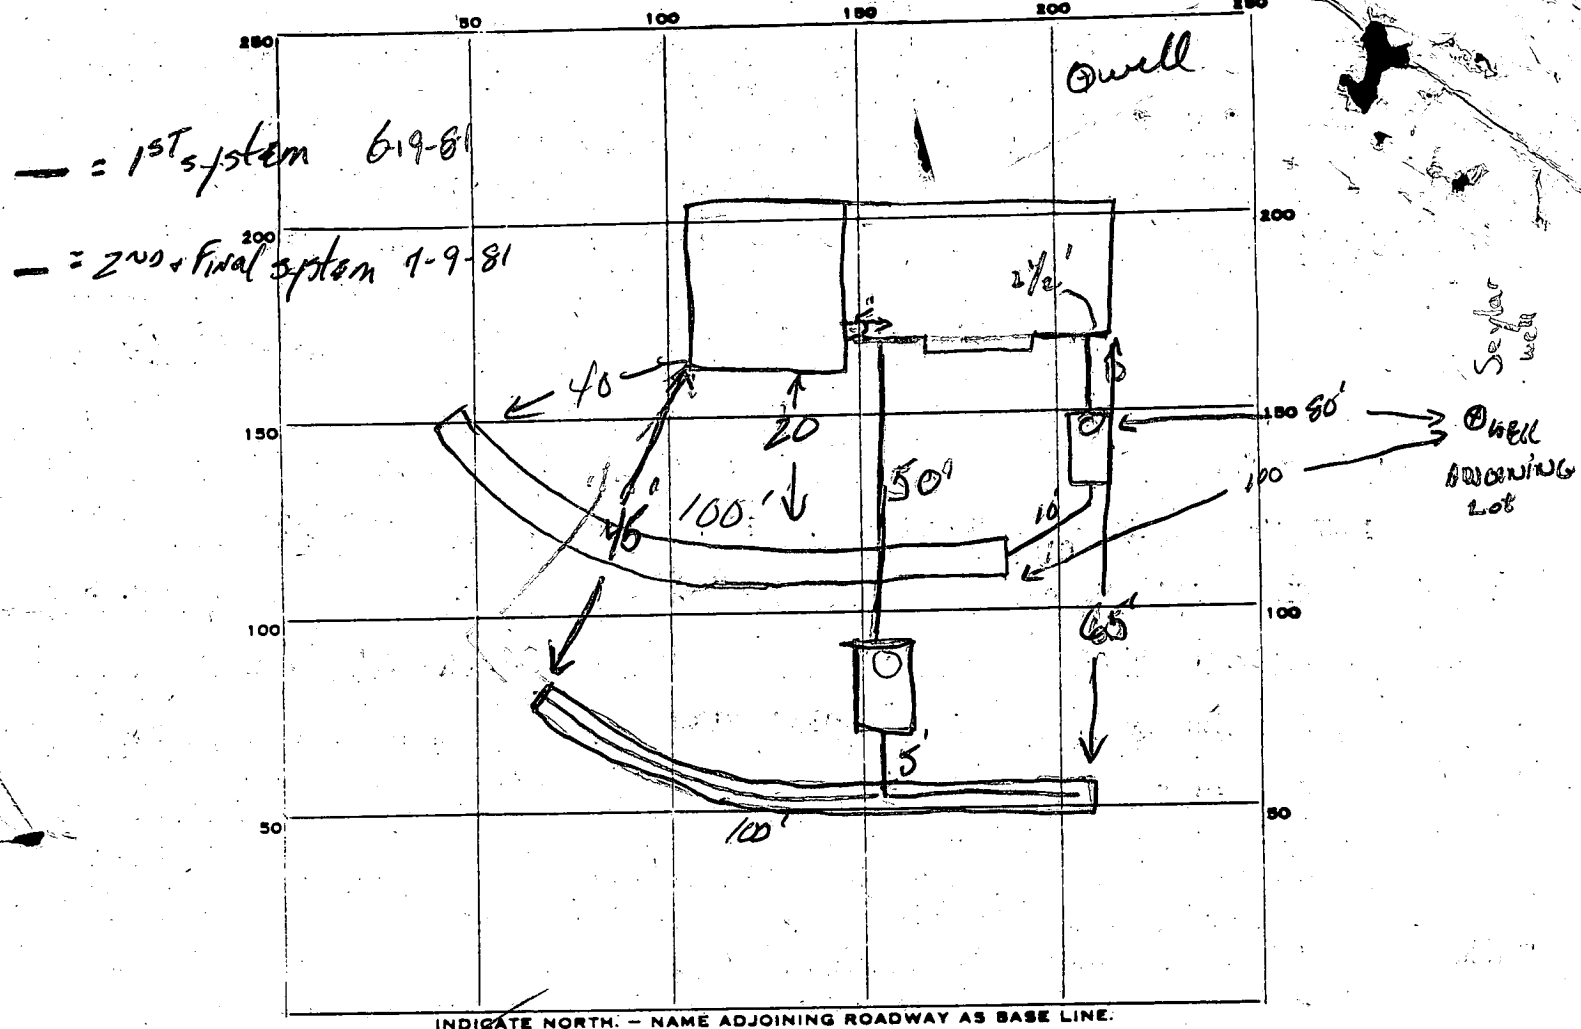

PERMIT CARD ☒

SEPTIC TANK, LEVEL ☒

CLEANOUTS ☒ Manhole

DISTRIBUTION BOX, LEVEL ☒

TILE, FIELD, DEPTH 9/10 FT. TRENCH WIDTH 2/2 FT.

GRAVEL DEPTH 6' 6 1/2 IN. TOTAL LENGTH 100 FT.

NUMBER OF TRENCHES 1/1 TOTAL BOTTOM AREA 600 ~~600~~ 600 ϕ

SEEPAGE PITS, INSIDE DIAMETER 1 FT. DEPTH BELOW INLET 1 FT.

ABSORBENT AREA 1 SQ. FT.

REMARKS 8/9/81 OK to add Gravel to Trench 6-19-81 OK to Cover
all work SK + JS 6-881 Septic tank 82' from well of
adjoining prop. Trench 100' from well - SK +
7/6/81 1st system to be abandoned. O.K. to Cover 1st & 45' of 2nd system's pipe and
from here SK + JS 7-9-81 OK to add gravel to trench - SK + JS 7-9-81 Cover
all work

DATE SYSTEM APPROVED 7-9-81 INSPECTOR Inspector H. Krieb

APPLICATION

SEWAGE DISPOSAL TESTING

STATE OF MARYLAND - DEPARTMENT OF HEALTH AND MENTAL HYGIENE

A 30928

HOWARD COUNTY HEALTH DEPARTMENT
ENVIRONMENTAL HEALTH SERVICES

P.O. BOX 476 ELLICOTT, MARYLAND 21043
TELEPHONE: 992-2330

4 B.R. 1250 gal. Septic tank.

Trench absorption system

DISTRICT 5th.

DATE Sept. 15, 1980

BLDG. PERMIT SIGNED
AND RETURNED 11/3/80

Serial # 44915

TO: THE COUNTY HEALTH OFFICE
ELLICOTT CITY, MARYLAND

I HEREBY APPLY FOR THE NECESSARY TEST IN ORDER TO CONSTRUCT (OR RECONSTRUCT) A SEWAGE DISPOSAL SYSTEM.

PROPERTY OWNER John Kenneth & Betty June Pramik

ADDRESS 11431 Rowley Road, Clarksville, Maryland PHONE 498-3178

PROPERTY LOCATION:

SUBDIVISION Clarksville Ridge, Section #3 LOT NO. 45

ROAD AND DESCRIPTION Directions: Route 32 to Clarksville Ridge - enter on Whitegate Road
going South - follow Whitegate to Surrey Lane - left on Surrey, lot on right

SIZE OF LOT 1 Acre TYPE BLDG. 4 bedrooms
Single Family home

THE SYSTEM INSTALLED UNDER THIS APPLICATION IS ACCEPTABLE ONLY UNTIL PUBLIC FACILITIES BECOME AVAILABLE.

I FULLY UNDERSTAND THE FEE CONNECTED WITH THE FILING OF THIS PERC TEST APPLICATION IS NON-REFUNDABLE UNDER ANY CIRCUMSTANCES.

SIGNATURE OF APPLICANT

APPROVED BY Frank Skinner FOR Trench absorption system DATE 10/30/80
9/22/80

REJECTED BY FOR DATE


HOLD PENDING FURTHER TESTS DATE

REASONS FOR REJECTION OR HOLDING Hold for certified rules 10/24/80
Eggen test made OK to change sewage area slightly

THIS IS NOT A PERMIT

0'
0-3'
Clay, Sand
3-13'
Sand, Clay
mica

LOT 45

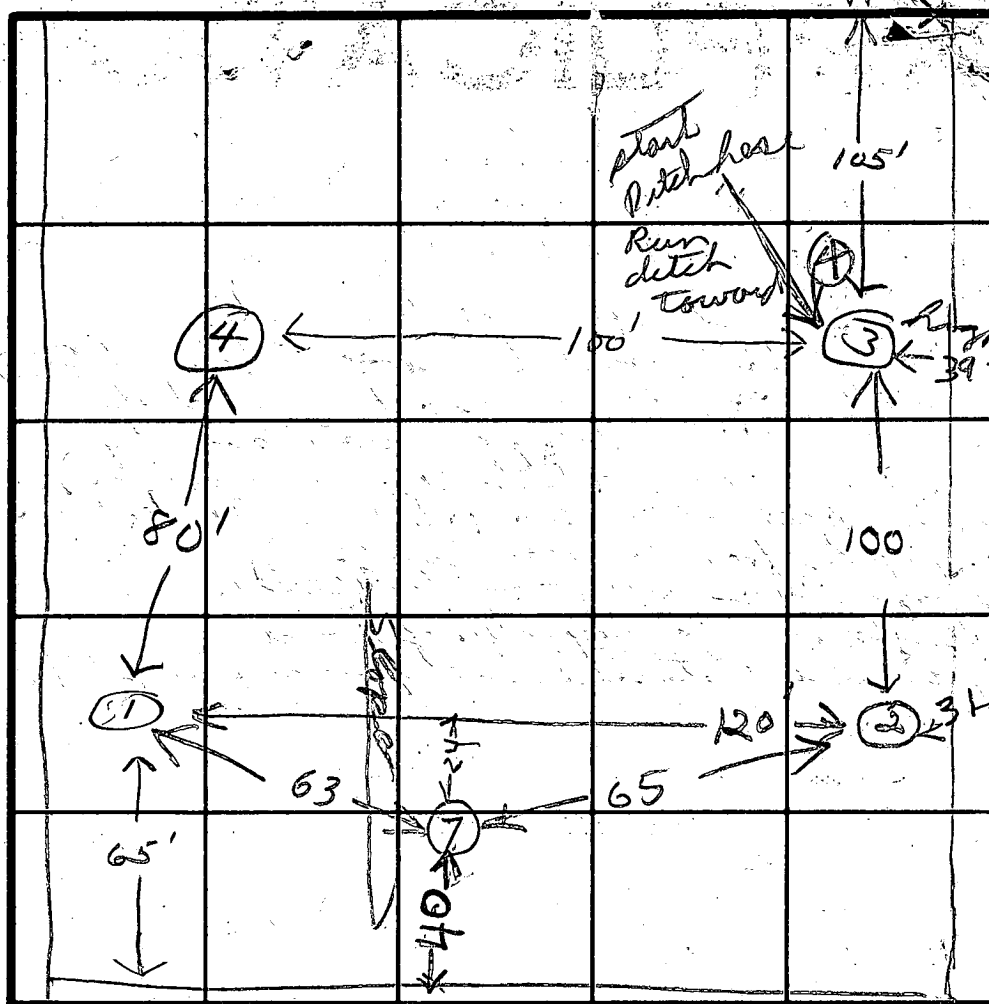

SURRY LA

DATE	TEST NO.	DEPTH	PRE-WET		TEST - 1" DROP		TIME
			START	STOP	START	STOP	
9/17/80	1 S	3 1/2	2:05	2:08	2:08	2:18	10
	1 D	12 1/2	2:06	2:08	2:08	2:10	2
	2 S	3	2:32	2:35	2:35	2:41	6
	2 D	12	2:30	2:32	2:32	2:35	3
	3 S	3	3:00	3:02	3:02	3:05	3
	3 D	12 1/2	3:00	3:03	3:03	3:07	4
	4 V	12	soil similar				
10/24/80	5 S	3	200	203	203	207	4
	5 D	12	200	203	203	207	4
	5 S	3	230	234	234	239	5
10/24/80	6 V	12	ALL SAND				
	7 V	12	TOP	4F7	CLAY		
			BOT	2F7	SANDY	9	41

REMARKS LOT not stacked 10/23/90

TYPE OF SOIL

TESTED BY

TESTED BY JS + SK
RAGMOND HONGES

JACK FULTON

ALSO PRESENT


ENT L. Fuller
FYDOR COMPANY

14-0

72

100' trench
c 6' storm

120
5m

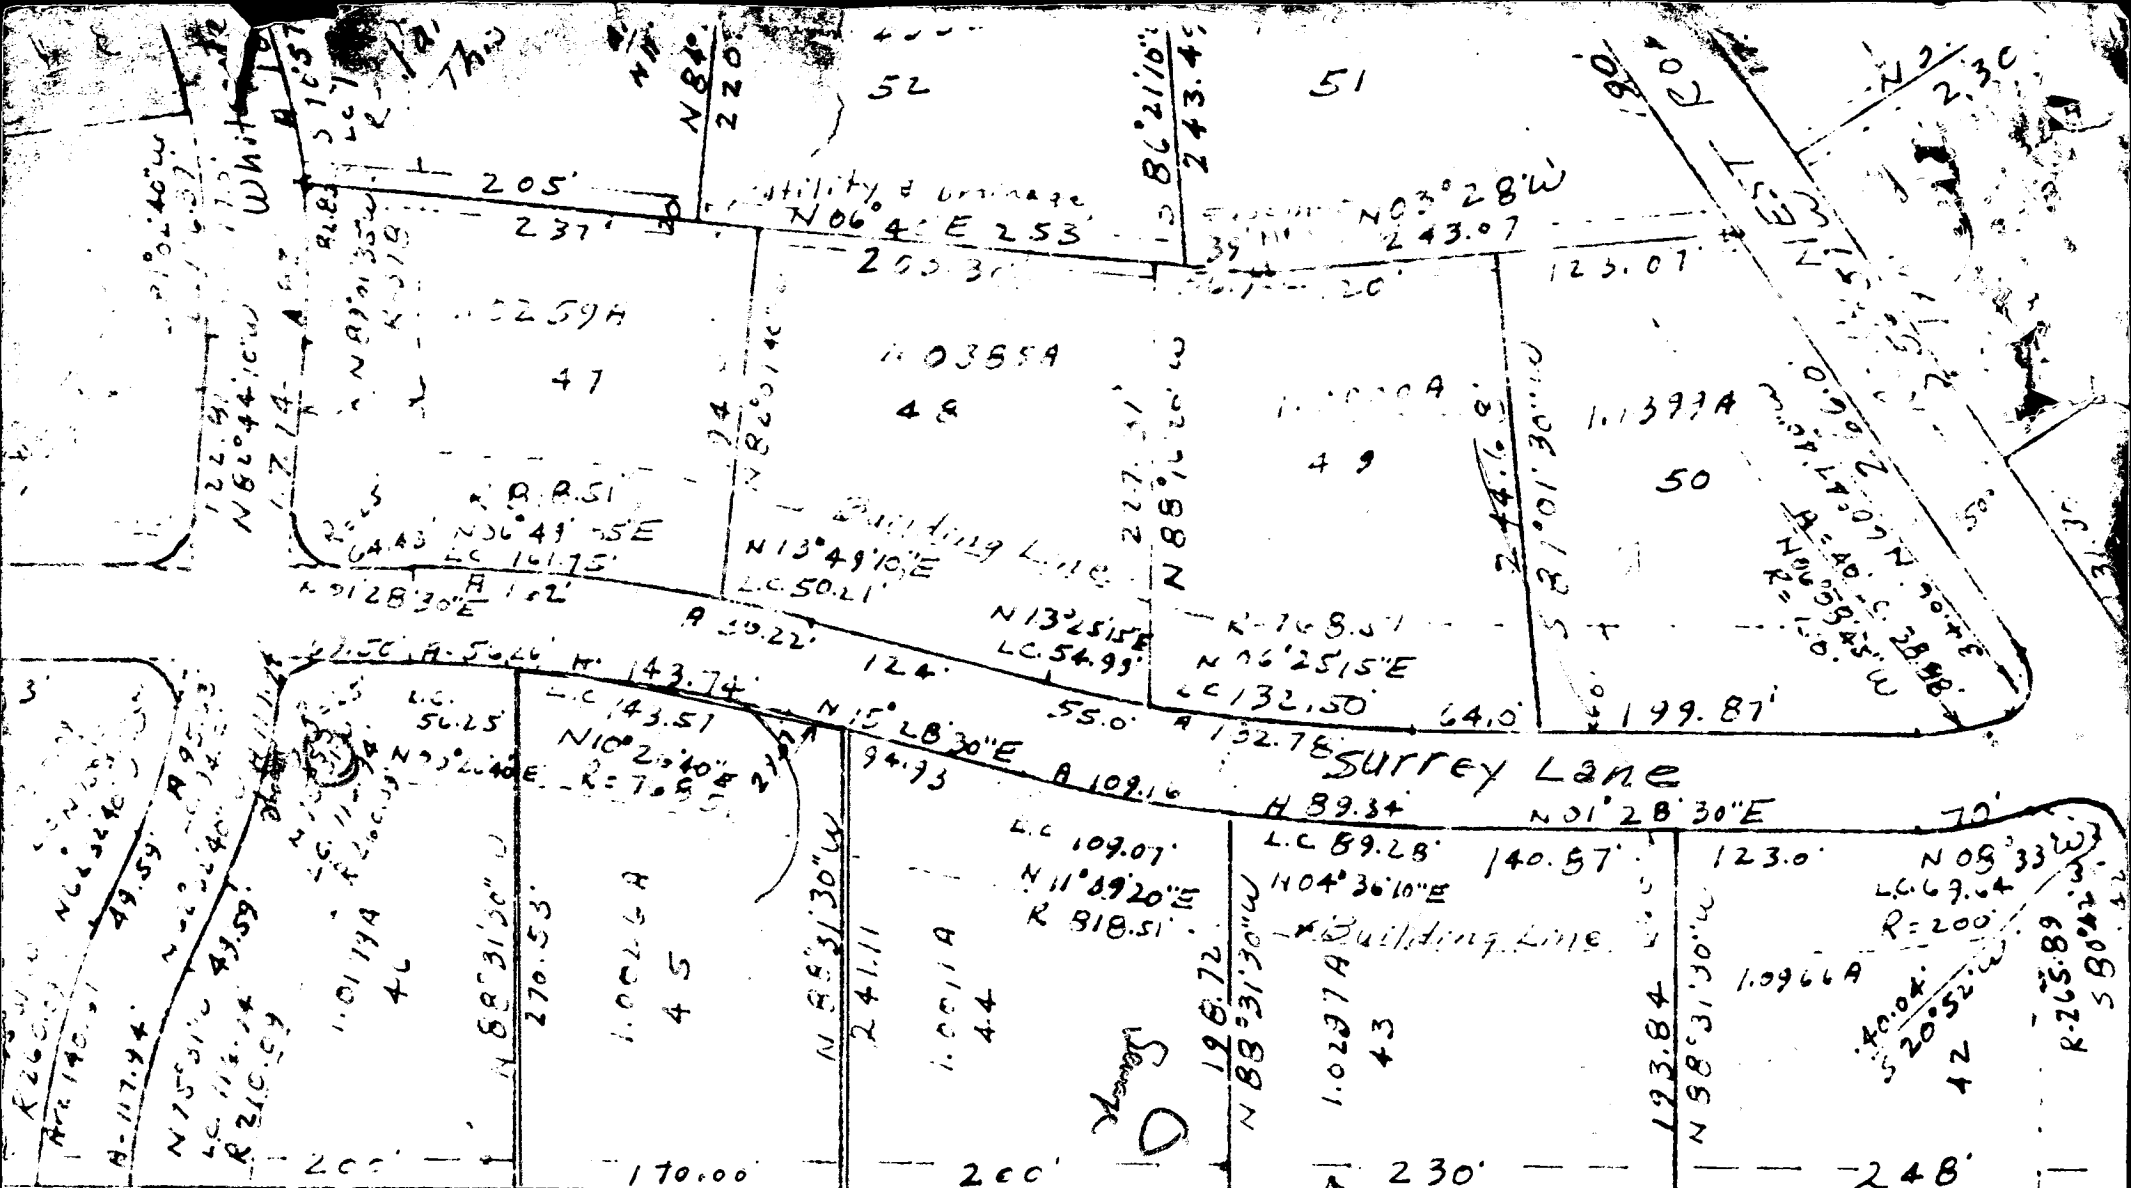

The requirements of section 12A, 12B, 12C, 12D of Article 17 of the Annotated Code of Maryland-1939 edition (Title: clerk of Courts, Subtitle: clerk of Circuit Courts) as far as they relate to the marking of this plat and the setting of markers have been complied with.

Owner of land shown hereon
J. H. Life Registered Surveyor No. 2537
 Surveyors Certificate