

11/6/80

French *in*

11/6/80 FILE
APPROVED
C.B.S.

PERMIT

SEWAGE DISPOSAL SYSTEM

MARYLAND STATE DEPARTMENT OF HEALTH

HOWARD COUNTY

04-319716

INDEXED

ELLICOTT CITY

DISTRICT 4th

DATE 10/31/80

Hy and Lowe

IS PERMITTED TO INSTALL ☒ ALTER

ADDRESS 7000 Warfield Road, Gaithersburg, Md. 20760 PHONE 253-2663 or 926-5924

SUBDIVISION ROAD 3530 Route 94 LOT 11A

PROPERTY OWNER Larry Bickett

ADDRESS 17725 New Hampshire Avenue, Ashton, Maryland Phone: 774-6569 or 587-1866

SPECIFICATIONS 3 bedrooms

SEPTIC TANK CAPACITY 1000 GALLONS

DRAIN FIELD DEPTH FEET, BOTTOM AREA SQ. FT.

DEEP TRENCH DEPTH FEET, BOTTOM AREA SQ. FT.

SEEPAGE PITS ABSORBENT SIDE-WALL AREA SQ. FT.

INLET PIPE FT. BELOW ORIGINAL GRADE. MAXIMUM DEPTH FT. BELOW ORIGINAL GRADE

EFFECTIVE DEPTH AT FT. BELOW ORIGINAL GRADE.

LOCATE DISPOSAL AREA FT. FROM LOT LINE AND FT. FROM LOT LINE AS SEEN WHEN

FACING LOT FROM

TRENCHES - To be 2 ft. wide. Inlet to 2-2½ ft. below original grade and effective absorbent area from 2½-9 ft. only. Maximum depth of trenches to be 9 ft. below original grade. A minimum of 130 sq. ft. effective absorbent sidewall area per bedroom needed. Trenches cannot exceed 100 ft. in length. Distribution box to be used if more than one (1) trench used. Two inspections of trenches required - before and after ~~stems~~ installed. If more than one (1) trench used - need to have 15 ft. distance between trenches, center to center. Run trenches on contour.

LOCATION: Start trenches as shown on house plan of 10/31/80.

PLANS APPROVED BY Charles B. Streaker DATE 10/31/80

COVER NO WORK UNTIL INSPECTED AND APPROVED.

NEITHER THE HOWARD COUNTY COUNCIL NOR THE HEALTH DEPARTMENT IS RESPONSIBLE FOR THE SUCCESSFUL OPERATION OF ANY SYSTEM.

NOTE: IF TRENCH IS USED CALL FOR INSPECTION BEFORE PLACING GRAVEL IN TRENCH.

NOTE: NO DRY WELL SHALL EXCEED 15 FOOT IN DIAMETER.


NOTE: ALL PIPE FROM HOUSE TO DISPOSAL AREA MUST BE CAST IRON.

PERMIT VOID AFTER THREE YEARS.

NOTE: INSTALL STAND PIPE ON SEPTIC TANK AND DRY WELL. STAND PIPES MUST BE 6 INCHES IN DIAMETER. CAST IRON, CONCRETE OR TERRA COTTA ACCEPTED.

*INSTALLER IS RESPONSIBLE FOR OBTAINING FINAL APPROVAL ON THIS PERMIT.

A 30955

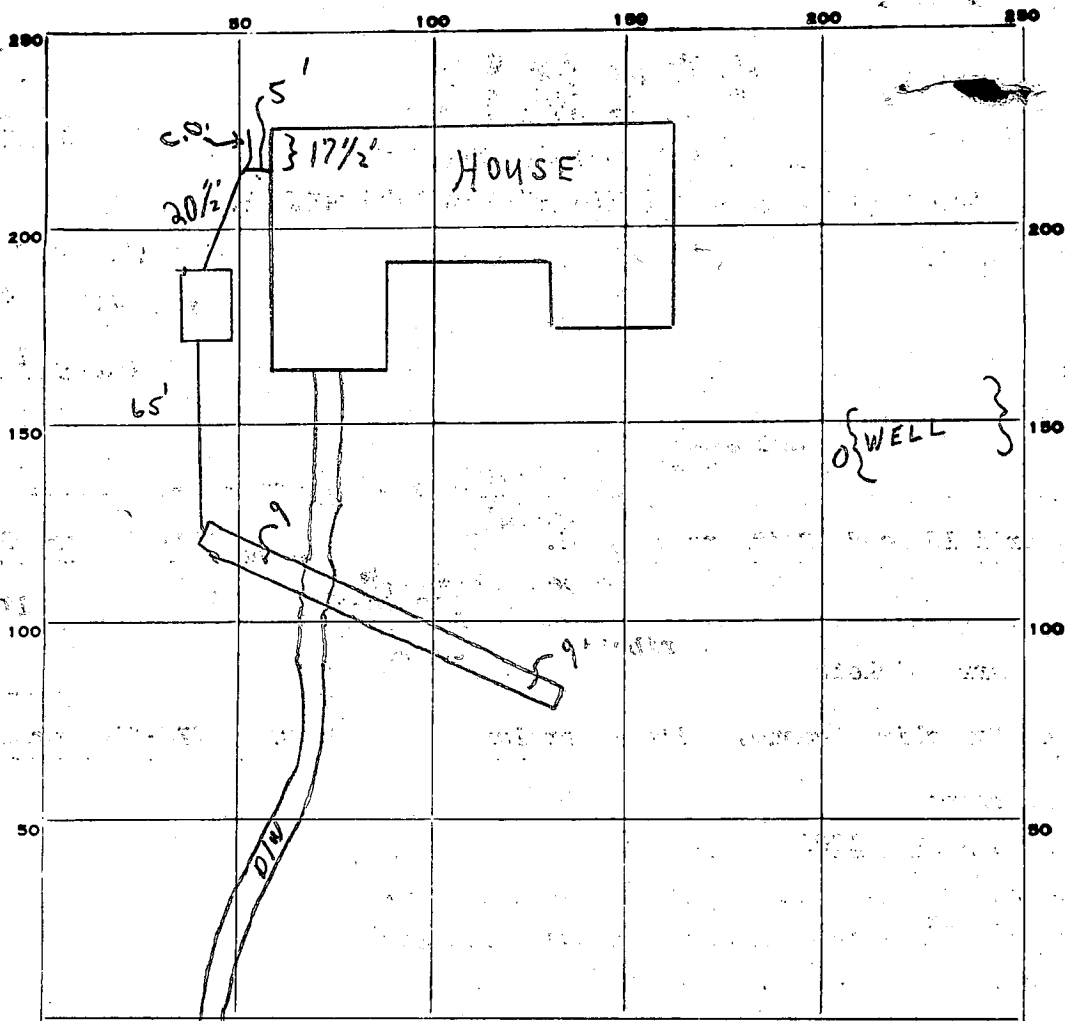

INDICATE NORTH. — NAME ADJOINING ROADWAY AS BASE LINE.

PERMIT CARD ☒

RT. 94

MANHOLE
S.T.

SEPTIC TANK, LEVEL ☒

CLEANOUTS ☒

DISTRIBUTION BOX, LEVEL

TILE FIELD, DEPTH 9 FT. TRENCH WIDTH 2 FT.

GRAVEL DEPTH ? IN. TOTAL LENGTH 62 1/2 FT.

NUMBER OF TRENCHES 1 TOTAL BOTTOM AREA

SEEPAGE PITS, INSIDE DIAMETER _____ FT. DEPTH BELOW INLET _____ FT.

ABSORBENT AREA 406 SQ. FT.

REMARKS 11/6/80 TRENCH ONLY OK FOR STONE; SYSTEM COMPLETE
C.B.S. C.B.S.

DATE SYSTEM APPROVED

11/6/80

INSPECTOR

C.B. Streater

Retest

APPLICATION

SEWAGE DISPOSAL TESTING

STATE OF MARYLAND - DEPARTMENT OF HEALTH AND MENTAL HYGIENE

HOWARD COUNTY HEALTH DEPARTMENT
ENVIRONMENTAL HEALTH SERVICES
P.O. BOX 476 ELLICOTT, MARYLAND 21043
TELEPHONE: 992-2330

A 30955

P _____

DISTRICT 4th

DATE 9/26/80

TO: THE COUNTY HEALTH OFFICER
ELLICOTT CITY, MARYLAND

I, HEREBY, APPLY FOR THE NECESSARY TEST IN ORDER TO CONSTRUCT (OR RECONSTRUCT) A SEWAGE DISPOSAL SYSTEM.

PROPERTY OWNER Larry Bickett 587-1266 8:30-4:30

ADDRESS 17725 New Hampshire Avenue, Ashton, Md. PHONE 774-6569 AFTER 5:30

PROPERTY LOCATION:

SUBDIVISION _____ LOT NO. 11A

ROAD AND DESCRIPTION 3530 Route 94

SIZE OF LOT 5.474 acres TYPE BLDG. 3 or 4 bedrooms

THE SYSTEM INSTALLED UNDER THIS APPLICATION IS ACCEPTABLE ONLY UNTIL PUBLIC FACILITIES BECOME AVAILABLE.

I FULLY UNDERSTAND THE FEE CONNECTED WITH THE FILING OF THIS PERC TEST APPLICATION IS NON-REFUNDABLE UNDER

ANY CIRCUMSTANCES.

SIGNATURE OF APPLICANT Larry D. Bickett

APPROVED BY _____ FOR _____ DATE _____

REJECTED BY _____ FOR _____ DATE _____

HOLD PENDING FURTHER TESTS _____ DATE _____

REASONS FOR REJECTION OR HOLDING _____

THIS IS NOT A PERMIT

{ NY & LOWE DIGGER.

PRELIMINARY.

APPLICATION

A 18819

SEWAGE DISPOSAL TESTING

P _____

STATE OF MARYLAND - DEPARTMENT OF HEALTH AND MENTAL HYGIENE

HOWARD COUNTY HEALTH DEPARTMENT
ENVIRONMENTAL HEALTH SERVICES
P. O. BOX 476, ELLICOTT CITY, MARYLAND 21043
TELEPHONE: 465-8000, EXT. 356

DISTRICT STH 4th

DATE 8/3/73

TO: THE COUNTY HEALTH OFFICER
ELLICOTT CITY, MARYLAND

I, HEREBY, APPLY FOR THE NECESSARY TEST IN ORDER TO CONSTRUCT (OR RECONSTRUCT) A SEWAGE DISPOSAL SYSTEM.

PROPERTY OWNER Eugene Edw. Jackson

ADDRESS 7800 Lancaster Mill Rd., Gaithersburg, Md. PHONE 948-2527

PROPERTY LOCATION:

SUBDIVISION _____ LOT NO. 11A
left

ROAD AND DESCRIPTION Route 94 - Route 144 to Route 94 - turn ~~right~~ - approx. 7 miles
in from Rt. 144 on right hand side. Will have sign with name on it on lot.

SIZE OF LOT 5.474 acres TYPE BLDG. 4 bedrooms
NUMBER OF BEDROOMS

IF NOT SINGLE RESIDENCE DESCRIBE _____

THE SYSTEM INSTALLED UNDER THIS APPLICATION IS ACCEPTABLE ONLY UNTIL PUBLIC FACILITIES BECOME AVAILABLE.

SIGNATURE OF APPLICANT Eugene Edward Jackson

APPROVED BY _____ FOR _____ DATE _____
(KIND OF SYSTEM)

REJECTED BY _____ FOR _____ DATE _____
(KIND OF SYSTEM)

HOLD PENDING FURTHER TESTS _____ DATE _____

REASONS FOR REJECTION OR HOLDING _____

THIS IS NOT A PERMIT

Claude Skinner
(Excluded Town)

R.R. SPIKE SET IN TOP
CABIN ROCK

STONE
MARKED WR

N 86° 30' E

1462.97'
1218.97'

7.456

12

5.28 Acres

11B

5.220 Acres

11A

5.474 Acres

10
9.000 Acres

9A
5.000 Acres

\$12,250

9C
5.020 Acres

9B
5.081 Acres

\$9,500


6
6.729 Acres

7
7.000 Acres

BARN

5
5.00 Acres

1999.81

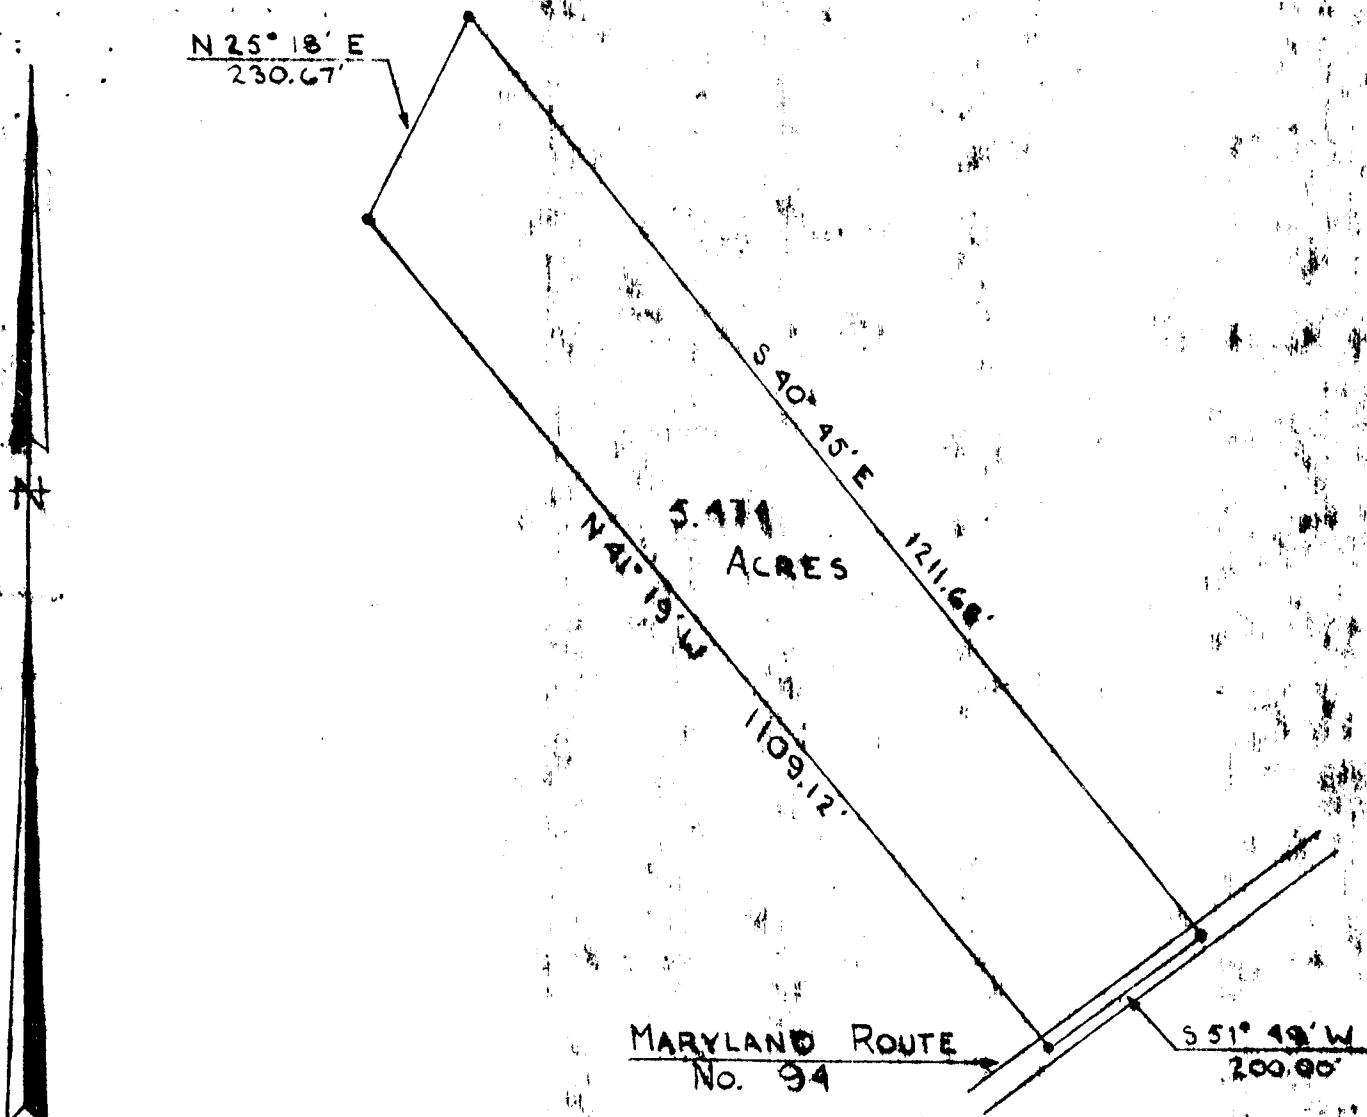


PLAT FROM DEEDS
 FOR
 EUGENE JACKSON
 FOURTH ELECTION DIST., HOWARD CO.
 FLORENCE, MARYLAND
 SCALE 1 IN = 200 FT. NOVEMBER 28, 1975

Note: The lot shown hereon complies with the minimum ownership and lot area as required by the Maryland State Health Department.

Approved: Private Water & Private Sewer

[Signature] 12/1/75
 Howard County Health Officer Date

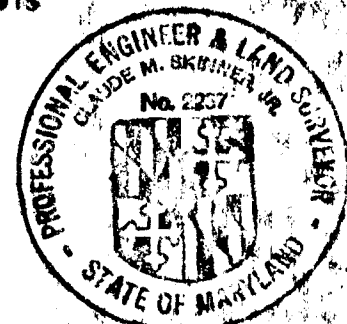

[Signature]

DNR 131 (7-77)

EMERGENCY NO. (If any) -

B 1 3827 1 2 3 (SEQ. NO.) 8 (THIS NUMBER IS TO BE PUNCHED IN COLS. 3-6 ON ALL CARDS)	SEQUENCE NO. (WRA USE ONLY)	STATE OF MARYLAND WATER RESOURCES ADMINISTRATION TAWES STATE OFFICE BLDG., ANNAPOLIS, MARYLAND 21401 APPLICATION FOR PERMIT TO DRILL WELL	WRA PERMIT NUMBER HO-73 3482 FILL IN THIS FORM COMPLETELY
--	--------------------------------	--	--

DATE RECEIVED (WRA USE ONLY) 10/31/79 9:30 A.M.	OWNER Cookitt Lane COL 15 LAST NAME FIRST NAME COL. 34 STREET OR RFD 17725 Ave. Hampshire Ave. COL 36 COL. 55 POST OFFICE Chilton Md. COL 57 COL. 76
--	--


B 1 CONTINUED 1 2 3 (SEQ. NO.) 8	DRILLER INFORMATION DATE 10/12/79 LICENSE NUMBER 46 77 80 FIRST NAME DRILLER LAST NAME SIGNATURE H. T. ...	B 3 LOCATION OF WELL 1 2 3 (SEQ. NO.) 8 COUNTY Howard (DO NOT ABBREVIATE COUNTY NAME) 21 SUBDIVISION N/A 23 42 SECTION 4 LOT 11 44 48 50 NEAREST TOWN Flower 52 71 MILES FROM TOWN (ENTER 0 IF IN TOWN) 2 M 1 75 76 77 78
--	--	--

B 2 WELL INFORMATION 1 2 3 (SEQ. NO.) 8 MAXIMUM PUMPING RATE (GALLONS PER MINUTE) 500 8 12 AVERAGE DAILY QUANTITY NEEDED (GALLONS PER DAY) 500 14 20	USE FOR WATER (CIRCLE APPROPRIATE BOX) ☒ HOME (SINGLE OR DOUBLE HOUSEHOLD UNIT ONLY) ☐ FARMING, AGRICULTURE, IRRIGATION ☐ INDUSTRIAL, COMMERCIAL, STATE AND FEDERAL GOVERNMENT. ☐ MUNICIPAL WATER SUPPLY ☐ PRIVATE WATER COMPANY ☐ TEST MUST HAVE STATE HEALTH DEPT. APPROVAL	B 4 DIRECTION FROM TOWN (CIRCLE APPROPRIATE BOX) 1 2 3 (SEQ. NO.) 8 ☒ NORTH ☐ EAST ☐ NORTHEAST ☐ SOUTHEAST ☒ SOUTH ☐ WEST ☐ NORTHWEST ☐ SOUTHWEST NEAR WHAT ROAD at 94 ON WHICH SIDE OF ROAD (CIRCLE APPROPRIATE BOX) ☒ NORTH ☐ SOUTH ☐ EAST ☐ WEST 32 32 32 32 DISTANCE FROM ROAD (ENTER DISTANCE AND CIRCLE APPROPRIATE BOX) 100 M 1 34 37 38 39
--	--	---

APPROXIMATE DEPTH OF WELL 150 FEET 24 28 APPROXIMATE DIAMETER OF WELL 6 (NEAREST INCH) METHOD OF DRILLING USED (CIRCLE APPROPRIATE METHOD) ☒ BORED (OR AUGERED) ☐ JETTED ☐ DRIVEN 30-37 ☒ AIR-ROTARY ☐ AIR-PERCUSSION ☐ ROTARY (HYDRAULIC ROTARY) ☒ CABLE ☐ REVERSE-ROTARY ☐ DRIVE-POINT OTHER (DESCRIBE) REPLACEMENT OR DEEPEINED WELLS (CIRCLE APPROPRIATE BOX) ☒ THIS WELL WILL NOT REPLACE AN EXISTING WELL ☐ THIS WELL WILL REPLACE A WELL THAT WILL BE ABANDONED AND SEALED ☐ THIS WELL WILL REPLACE A WELL THAT WILL BE USED AS A STANDBY ☐ THIS WELL WILL DEEPEIN AN EXISTING WELL PERMIT NUMBER OF WELL TO BE REPLACED OR DEEPEINED (IF AVAILABLE)	10/31/79 WELL OK SEE OTHER SIDE Flower at 94
---	---


NOT TO BE FILLED IN BY DRILLER (WRA USE ONLY) APPROPRIATION PERMIT NUMBER FORCE WRITE INITIALS IN BOX CONDITIONS A E N S G W Q C L U 70 71 72 73 74 75 76 77 78 79	HEALTH DEPARTMENT APPROVAL B 4 CONTINUED 1 2 3 (SEQ. NO.) 8 41 Howard AL8819 STATE HEALTH (CIRCLE BOX) COUNTY NAME COUNTY NO. MO. DAY YR. DATE 102279 43 48 Donald W. Monaghan, Sanitarian	BOX NUMBER E 760 N 530 NORTH COORDINATE 50 51 52 53 54 55 EAST COORDINATE 57 58 59 60 61 62 63 ELEVATION AT WELL HEAD (FEET) 65 66 67 68 0/0 5/0
---	--	---

Rt 94 5 miles Past Fire station
on right hand 100 ft off Rd
can see Ry from Road

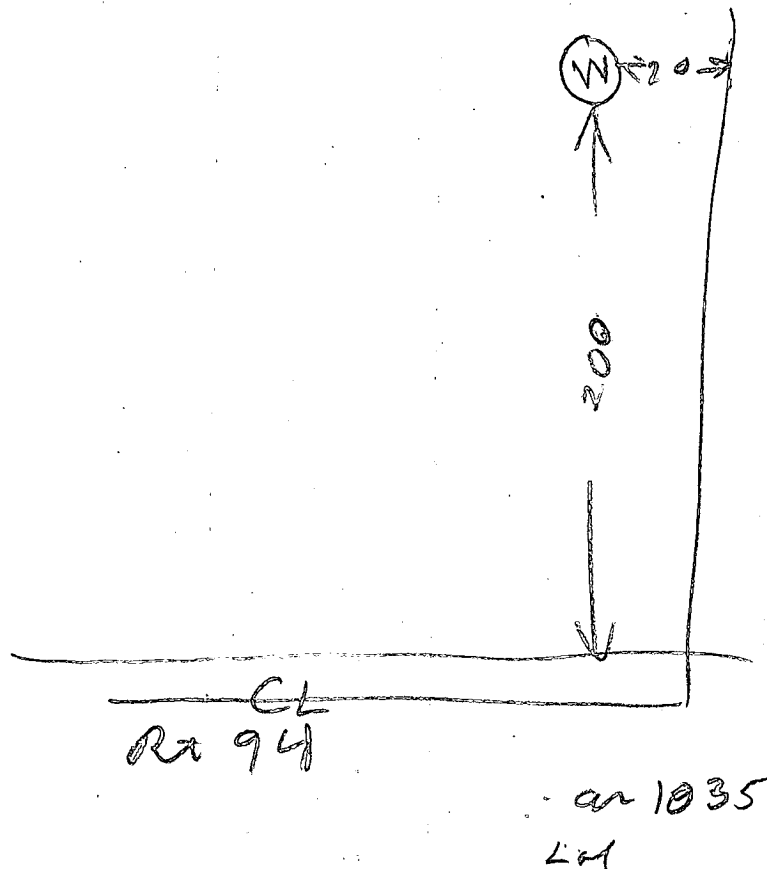

- ① 21 FT casing 1 FT out of ground
- ② 18 ft open hole
- ③ LOCATION OK
- ④ 5 Bag

44959

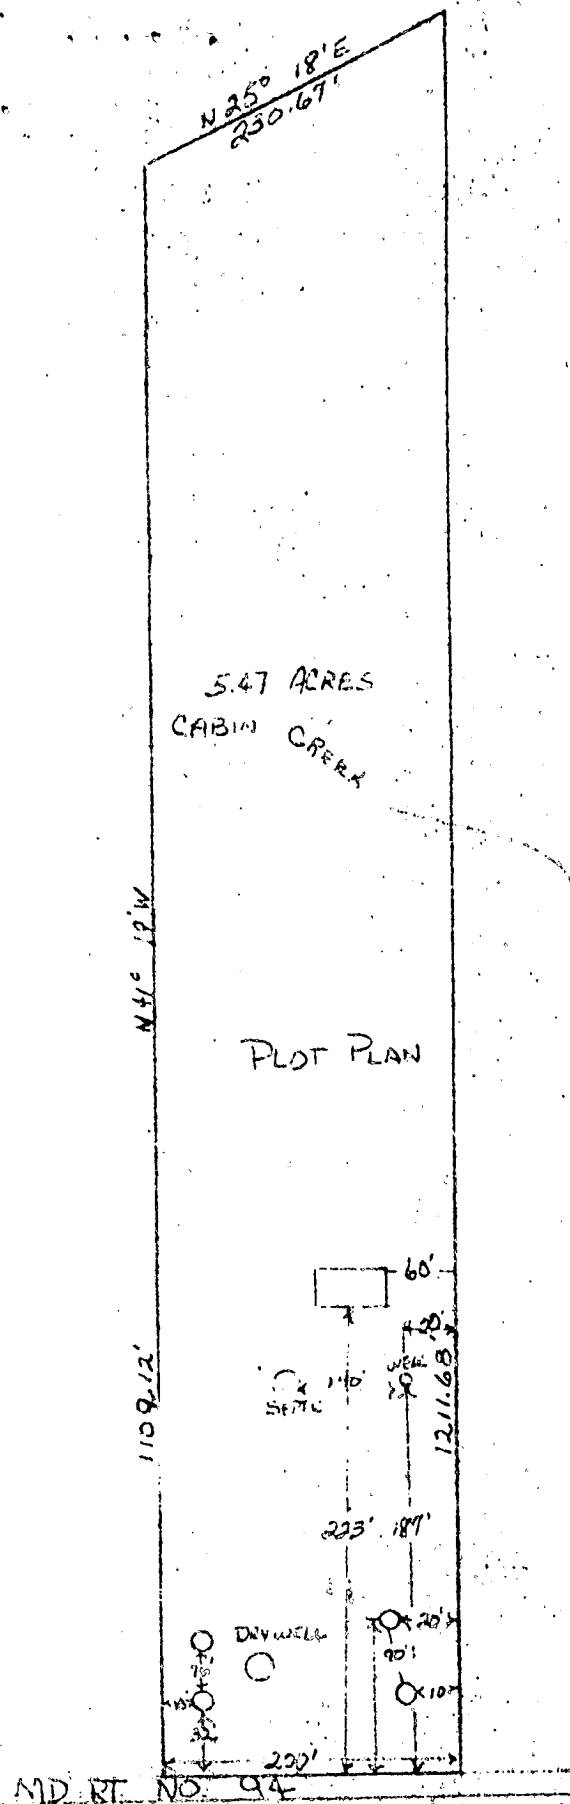


3500 BLOCK Rte 94
LOT 11A. WOODBINE MD.
LIBER OB13 - FOLIO 227

RANGLER HOUSE PLANS FOR
L. BICKETT

LARRY J. & YLEEN BICKETT
LOT 11A, LIBERTY 71, FOLIO 527

3530 RT 94, WOODBINE, MD.

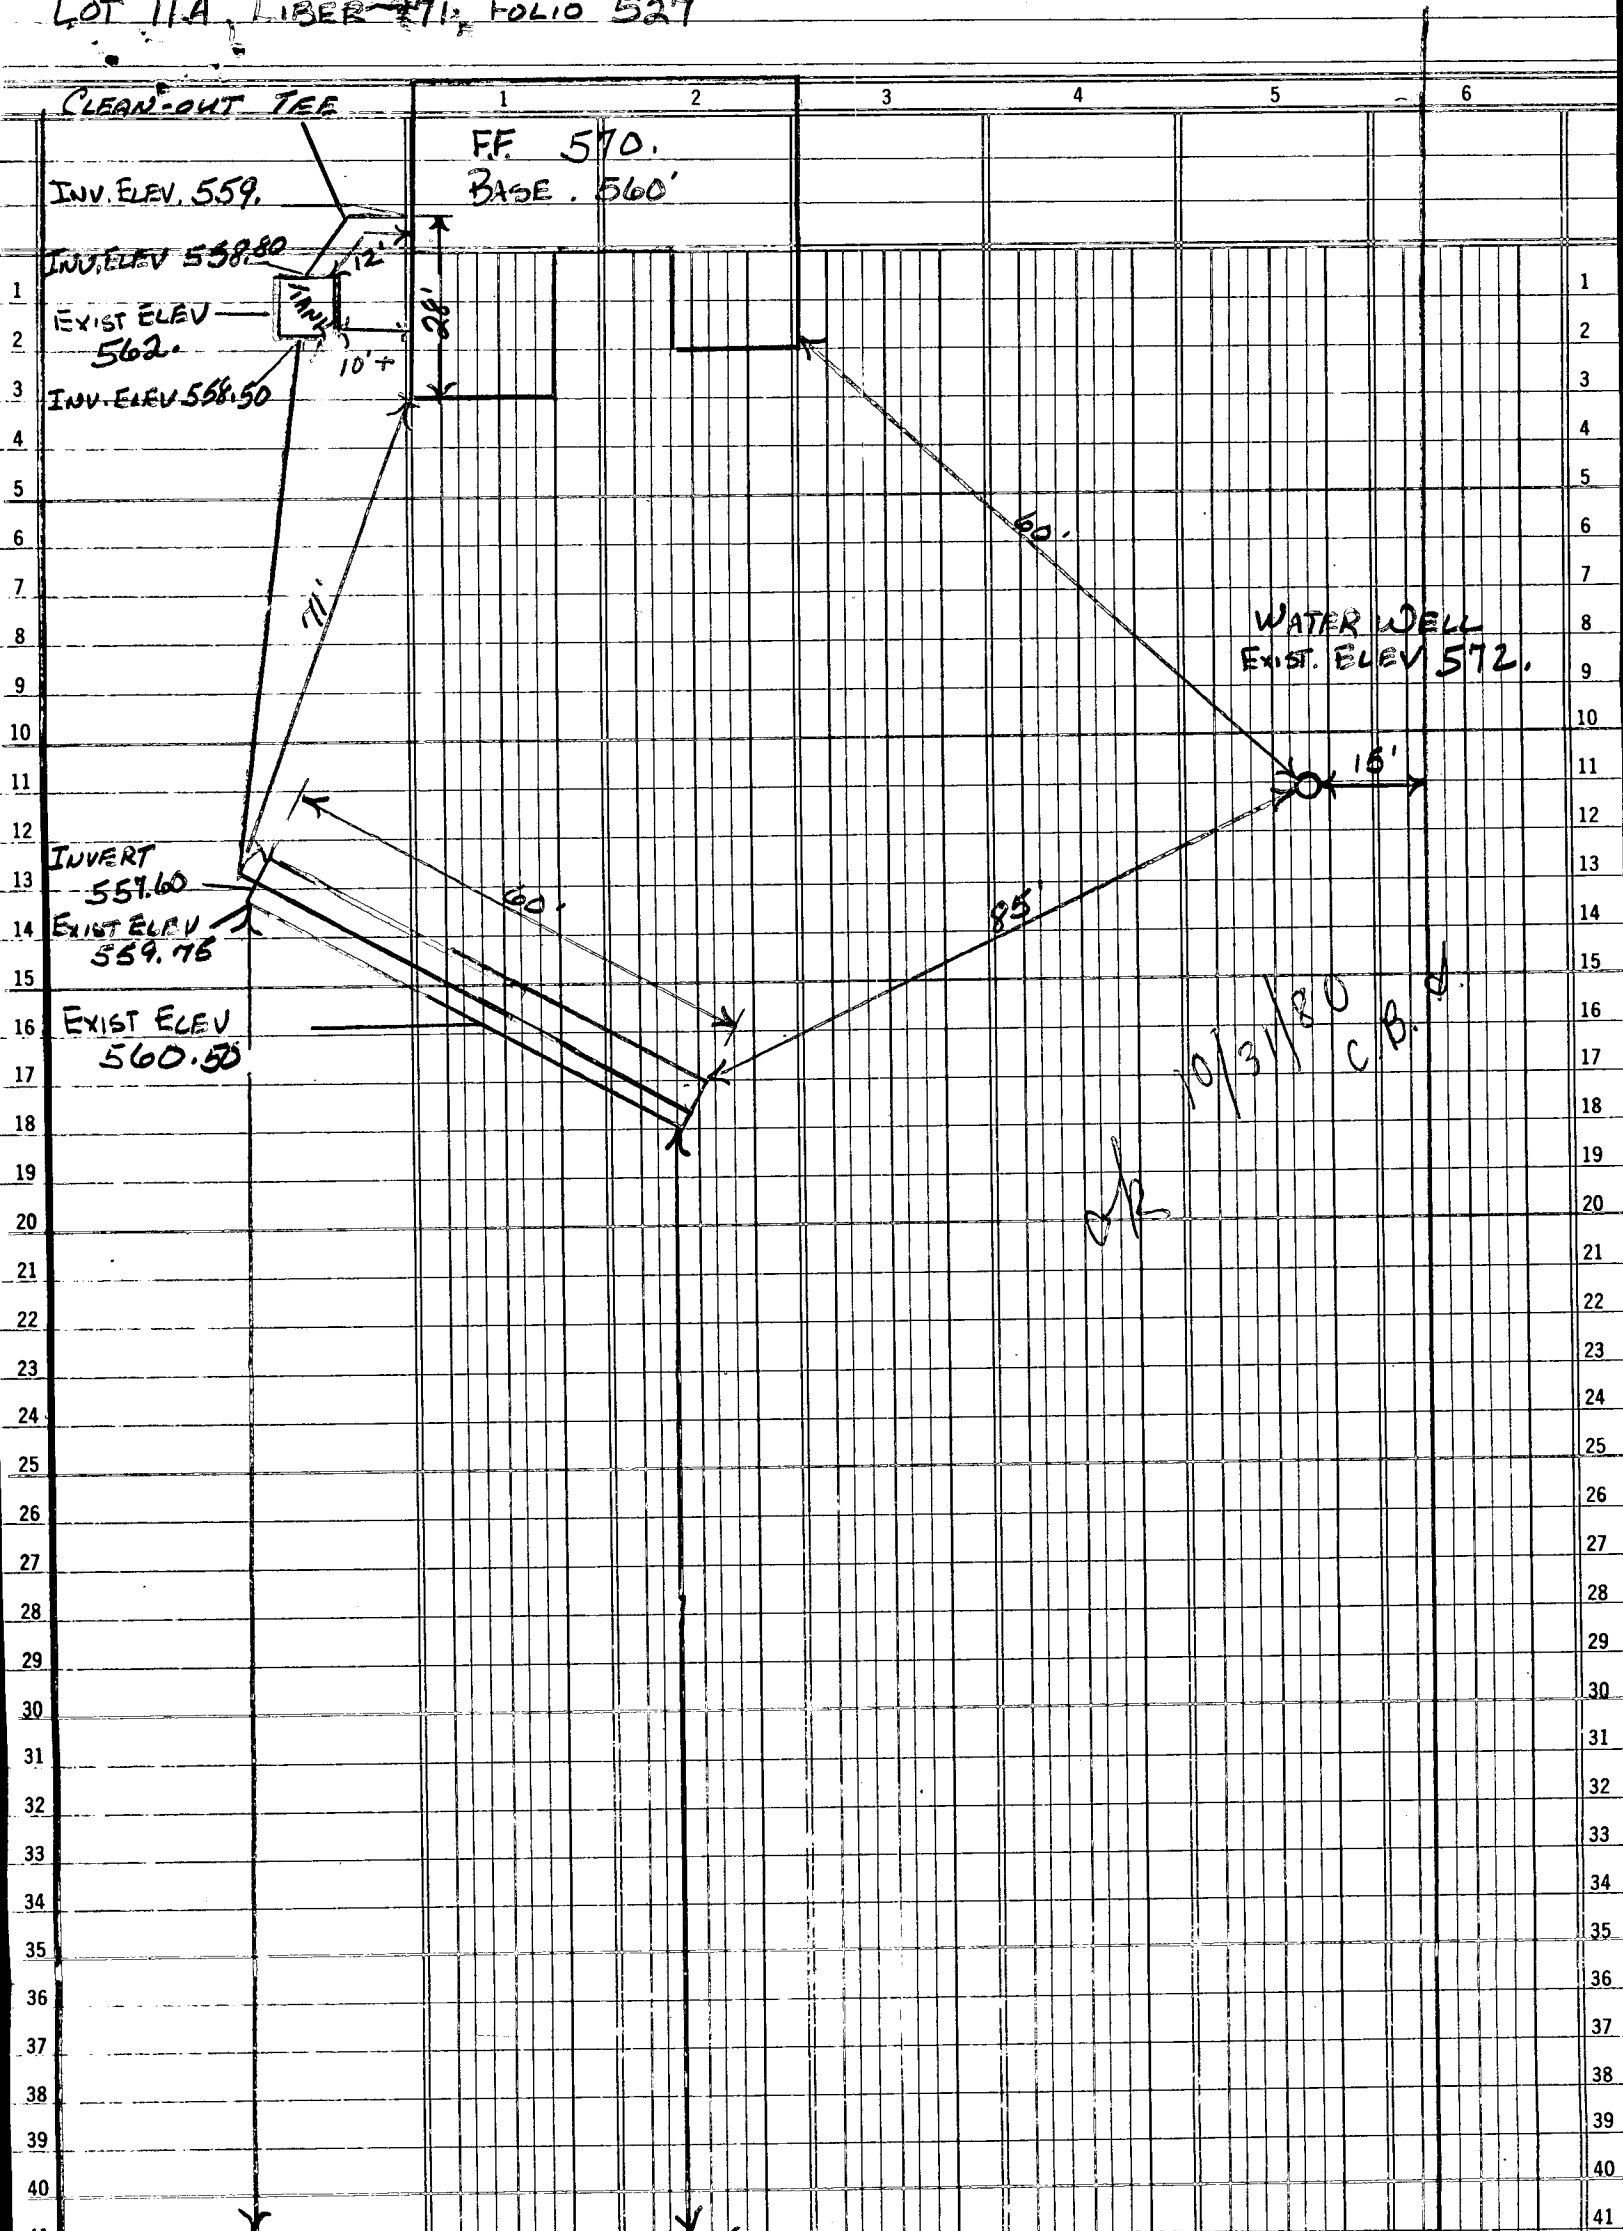

RT 94 - ROAD

I CERTIFY THE ABOVE MEASUREMENTS AND ELEVATIONS ARE ACTUAL
AND CORRECT FOR THIS PROPERTY.

Larry J. Bickett
10/31/80