

Approved 7/30/79

7/30/79
9:30 a.m.

PERMIT

SEWAGE DISPOSAL SYSTEM

MARYLAND STATE DEPARTMENT OF HEALTH*

HOWARD COUNTY

61-473278

ELLICOTT CITY

DISTRICT _____

INDEXED

DATE 7/27/79

P 30028

REPAIR

Cecil's Backhoe Service

IS PERMITTED TO INSTALL ALTER ☒

ADDRESS _____ PHONE _____

SUBDIVISION _____ ROAD 5902 Rustic Lane LOT _____

PROPERTY OWNER McGinnis

ADDRESS 5902 Rustic Lane, Elkridge, Md.

SPECIFICATIONS 3 bedrooms

SEPTIC TANK CAPACITY 1000 GALLONS

DRAIN FIELD _____ DEPTH _____ FEET, BOTTOM AREA _____ SQ. FT.

DEEP TRENCH _____ DEPTH _____ FEET, BOTTOM AREA _____ SQ. FT.

SEEPAGE PITS _____ ABSORBENT SIDE-WALL AREA _____ SQ. FT.

INLET PIPE _____ FT. BELOW ORIGINAL GRADE. MAXIMUM DEPTH _____ FT. BELOW ORIGINAL GRADE

EFFECTIVE DEPTH AT _____ FT. BELOW ORIGINAL GRADE.

LOCATE DISPOSAL AREA _____ FT. FROM _____ LOT LINE AND _____ FT. FROM _____ LOT LINE AS SEEN WHEN
FACING LOT FROM

REPAIR-CALL FOR INSPECTION WHEN GROUND IS OPENED UP SO SANITARIAN CAN

RECOMMEND REPAIR.

PLANS APPROVED BY Palmer F. Wine DATE 7/27/79

COVER NO WORK UNTIL INSPECTED AND APPROVED.

NEITHER THE HOWARD COUNTY COUNCIL NOR THE HEALTH DEPARTMENT IS RESPONSIBLE FOR THE SUCCESSFUL OPERATION OF ANY SYSTEM.

NOTE: IF TRENCH IS USED CALL FOR INSPECTION BEFORE PLACING GRAVEL IN TRENCH.

NOTE: NO DRY WELL SHALL EXCEED 15 FOOT IN DIAMETER.

NOTE: ALL PIPE FROM HOUSE TO DISPOSAL AREA MUST BE CAST IRON.


PERMIT VOID AFTER THREE YEARS.

NOTE: INSTALL STAND PIPE ON SEPTIC TANK AND DRY WELL. STAND PIPES MUST BE 6 INCHES IN DIAMETER. CAST IRON, CONCRETE OR TERRA
COTTA ACCEPTED.

*INSTALLER IS RESPONSIBLE FOR OBTAINING FINAL APPROVAL ON THIS PERMIT.

3171

P 30028

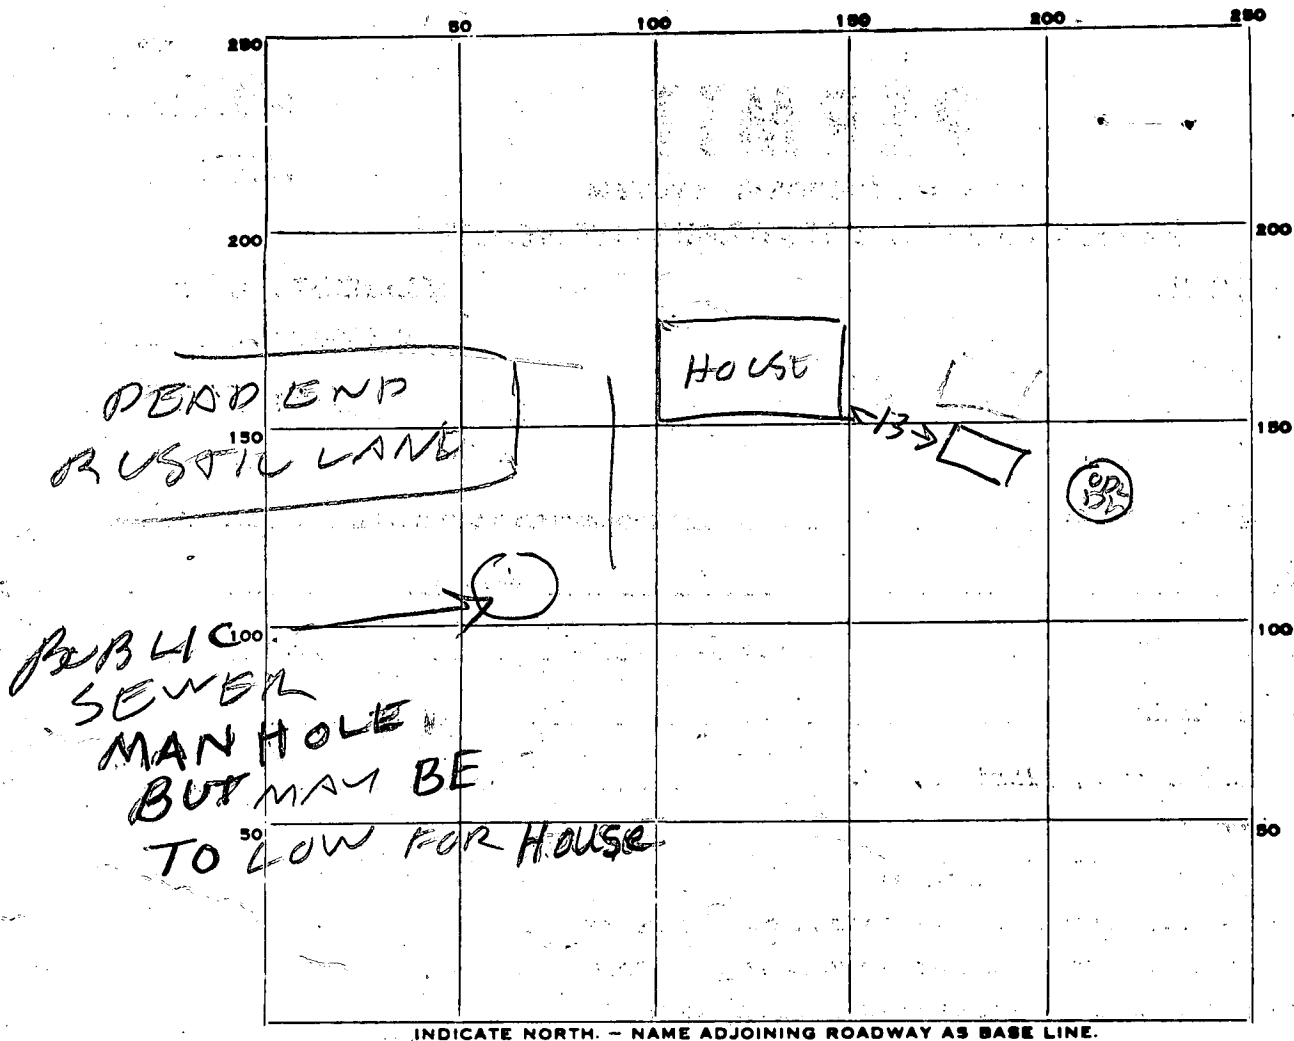

PERMIT CARD _____

SEPTIC TANK, LEVEL METAL
500

CLEANOUTS ST
OIC

DISTRIBUTION BOX, LEVEL _____

TOP 2-3 FT BELOW GRADE

TILE FIELD, DEPTH _____ FT. TRENCH WIDTH _____ FT.

GRAVEL DEPTH _____ IN. TOTAL LENGTH _____ FT.

NUMBER OF TRENCHES _____ TOTAL BOTTOM AREA _____

SEEPAGE PITS, INSIDE DIAMETER _____ FT. DEPTH BELOW INLET _____ FT.

ABSORBENT AREA _____ SQ. FT.

REMARKS _____

DATE SYSTEM APPROVED 7/30/79

INSPECTOR Raymond Hodge

July 25, 1979

Mr. Cecil Crenshaw
5454 Waterloo Road
Ellicott City, Md. 21043

Dear Mr. Crenshaw:

This department has received information that you installed a septic tank on the Arthur McGinnis property located at 5902 Rustic Lane, ElkrIDGE, without a permit.

The investigation of this information showed there was a metal tank installed on this property. This is inddeed a violation of Article 10.03.27, Section .09 of the Regulations Governing Individual Water and Sewerage Systems which states that no installation shall be made without a permit.

To correct this violation, you will have to:

- (1) Secure a permit from this office.
- (2) Open up ground so tank can be inspected.

If this violation is not corrected within ten (10) days from receipt of this letter, this department will not issue you any more permits and will have to cut off any services to you and will instigate legal action against you in District Court for the violation.

Very truly yours,

Donald W. Monaghan, Sanitarian
Water and Sewerage Program

DWM:ds

*Mr. Cecil Crenshaw picked up repair
permit 7/27/79 /cls.*