


## A REPAIR

**DATE** 9/17/79

P 30187

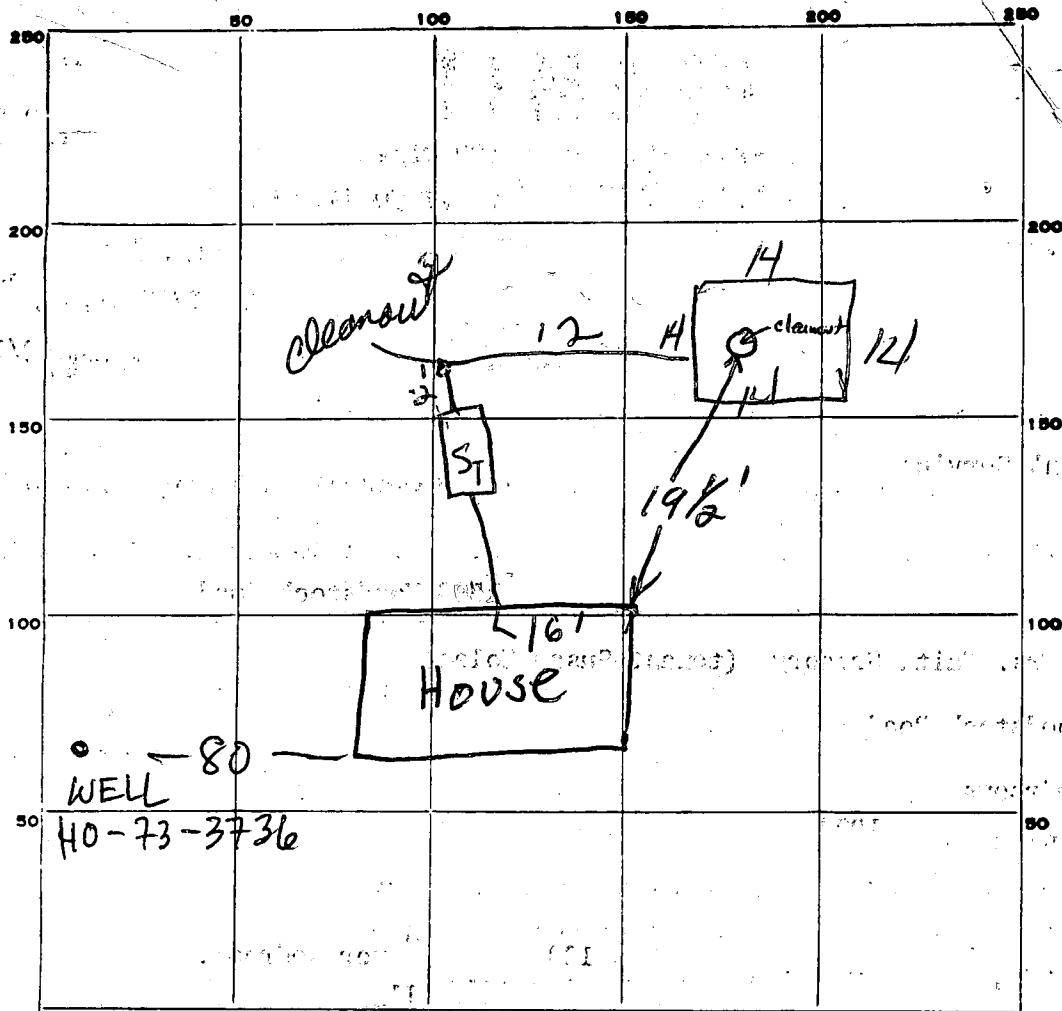

INDICATE NORTH. — NAME ADJOINING ROADWAY AS BASE LINE.

Woodstock Road

PERMIT CARD OK

SEPTIC TANK, LEVEL OK

CLEANOUTS OK

DISTRIBUTION BOX, LEVEL \_\_\_\_\_

TILE FIELD, DEPTH \_\_\_\_\_ FT. TRENCH WIDTH \_\_\_\_\_ FT.

GRAVEL DEPTH \_\_\_\_\_ IN. TOTAL LENGTH \_\_\_\_\_ FT.

NUMBER OF TRENCHES \_\_\_\_\_ TOTAL BOTTOM AREA \_\_\_\_\_

SEEPAGE PITS, INSIDE DIAMETER Perimeter 56 FT. DEPTH BELOW INLET 7 FT.

ABSORBENT AREA 39 2 SQ. FT. - By Well 12 ft below grade actual seepage  
300 - permitted.

REMARKS \_\_\_\_\_

DATE SYSTEM APPROVED

9/25/79

INSPECTOR

DW. Managhe

C 1	4845	SEQUENCE NO. (WRA USE ONLY)	STATE OF MARYLAND WELL COMPLETION REPORT FILL IN THIS FORM COMPLETELY PLEASE PRINT OR TYPE	THIS REPORT MUST BE SUBMITTED WITHIN 30 DAYS AFTER WELL IS COMPLETED COUNTY NUMBER P 30187
-----	------	--------------------------------	---	---

Date Received (WRA use only)	11/10/80 DATE WELL COMPLETED	Depth of Well 140 (TO NEAREST FOOT)	PERMIT NO. FROM "PERMIT TO DRILL WELL" 40-73-3736
---------------------------------	---------------------------------	---	---

OWNER last name GREGORY	first name WILLIAM & FAITH
STREET OR RFD 1708 WOODSTOCK RD. TOWN	
SUBDIVISION EMERGENCY SECTION LOT	

WELL LOG Not required for driven wells		
STATE THE KIND OF FORMATIONS PENETRATED, THEIR COLOR, DEPTH, THICKNESS AND IF WATER BEARING		
DESCRIPTION (Use additional sheets if needed)	FEET FROM TO	Check if water bearing
topsoil	0 2	
brown shale	2 10	
Granite	10 23	
brown shale	23 25	✓
Granite	25 30	
brown shale	30 34	✓
Granite	34 130	
Granite and quartz	130 140	✓

GROUTING RECORD WELL HAS BEEN GROUTED (Circle Appropriate Box)	
YES Y	NO N
TYPE OF GROUTING MATERIAL CEMENT CM BENTONITE CLAY BC	
NO. OF BAGS 8	NO. OF POUNDS 800
GALLONS OF WATER 40	
DEPTH OF GROUT SEAL (to nearest foot) from 0 ft. to 19 ft.	

CASING RECORD		
casing types insert appropriate code below	ST STEEL	CO CONCRETE
	PL PLASTIC	OT OTHER
MAIN CASING TYPE	Nominal diameter top(main)casing (nearest inch)	Total depth of main casing (nearest foot)
ST	6	21

OTHER CASING (if used)	
Each casing diameter inch	depth (feet) from to

SCREEN RECORD		
screen type or openhole insert appropriate code below	ST STEEL	BR BRASS PL PLASTIC
	HO OPEN HOLE	OT OTHER

C 2 (Seq. no.)	
DEPTH (nearest ft.)	
1 40	19 140
2	
3	
SLOT SIZE 1 2 3	
DIAMETER OF SCREEN (NEAREST INCH)	
GRAVEL PACK	

IF WELL DRILLED WAS FLOWING WELL CIRCLE BOX F	
WRA USE ONLY (NOT TO BE FILLED IN BY DRILLER)	
T 70	(E.R.O.S.) 72
TELESCOPE CASING	LOG INDICATOR
W Q 74 75 76 OTHER DATA	

C 3 (seq. no.)		
PUMPING TEST		
HOURS PUMPED (nearest hour)	2	
PUMPING RATE (gal. per min. to nearest gal.) 10		
METHOD USED TO MEASURE PUMPING RATE BUCKET		
WATER LEVEL (distance from land surface)		
BEFORE PUMPING		
WHEN PUMPING		
TYPE OF PUMP USED (for test)		
A air	P piston	T turbine
C centrifugal	R rotary	O other (describe below)
J jet	S submersible	

PUMP INSTALLED	
DRILLER WILL INSTALL PUMP (CIRCLE APPROPRIATE BOX)	YES NO Y N
IF DRILLER INSTALLS PUMP, THIS SECTION MUST BE COMPLETED FOR ALL WELLS EXCEPT HOME USE	
TYPE OF PUMP (WRITE APPROPRIATE LETTER IN BOX - SEE ABOVE: (A, C, J, P, R, S, T, O)	
CAPACITY: GALLONS PER MINUTE (to nearest gallon)	
PUMP HORSE POWER	
PUMP COLUMN LENGTH (nearest ft.)	
CASING HEIGHT (circle appropriate box and enter casing height)	
above	LAND SURFACE
below	2 (nearest foot)

LOCATION OF WELL ON LOT	
SHOW PERMANENT STRUCTURE SUCH AS BUILDING, SEPTIC TANKS, AND/OR LANDMARKS AND INDICATE NOT LESS THAN TWO DISTANCES (MEASUREMENTS TO WELL)	
WOODSTOCK ROAD	
20' to well	
House 80'	

CIRCLE APPROPRIATE BOX	
A	A WELL WAS ABANDONED AND SEALED WHEN THIS WELL WAS COMPLETED
E	ELECTRIC LOG OBTAINED
P	TEST WELL CONVERTED TO PRODUCTION WELL
I HEREBY CERTIFY THAT I HAVE COMPLIED WITH ALL CONDITIONS STATED ON THE ABOVE-CAPTIONED "PERMIT TO DRILL WELL", AND THAT INFORMATION CONTAINED IN THIS REPORT IS TRUE, ACCURATE, AND COMPLETE TO THE BEST OF MY KNOWLEDGE, INFORMATION AND BELIEF.	
DRILLERS IDENT. NO. 40	
DRILLERS SIGNATURE (MUST MATCH SIGNATURE ON APPLICATION)	
SITE SUPERVISOR (sign of driller or journeyman responsible for sitework if different from permittee)	

Repair perc  
8/24/79  
1:30 p.m.

# APPLICATION

SEWAGE DISPOSAL TESTING

STATE OF MARYLAND - DEPARTMENT OF HEALTH AND MENTAL HYGIENE

HOWARD COUNTY HEALTH DEPARTMENT  
ENVIRONMENTAL HEALTH SERVICES

P.O. BOX 476 ELLICOTT, MARYLAND 21043  
TELEPHONE: 992-2330

A \_\_\_\_\_  
P \_\_\_\_\_

DISTRICT 3rd  
DATE 8/23/79

TO: THE COUNTY HEALTH OFFICER  
ELLICOTT CITY, MARYLAND

I HEREBY APPLY FOR THE NECESSARY TEST IN ORDER TO CONSTRUCT (OR RECONSTRUCT) A SEWAGE DISPOSAL SYSTEM.

PROPERTY OWNER Mrs. Faith Gregory  
ADDRESS 713 Bishop Drive, Virginia Beach, Virginia 23455 PHONE Bud Arnold 795-7873

PROPERTY LOCATION:

SUBDIVISION \_\_\_\_\_ LOT NO. \_\_\_\_\_

ROAD AND DESCRIPTION 1708 Woodstock Road (Tenant - Susan Nolan - 465-1323)

SIZE OF LOT ? TYPE BLDG. ? 3 Bedrooms

THE SYSTEM INSTALLED UNDER THIS APPLICATION IS ACCEPTABLE ONLY UNTIL PUBLIC FACILITIES BECOME AVAILABLE.

I FULLY UNDERSTAND THE FEE CONNECTED WITH THE FILING OF THIS PERC TEST APPLICATION IS NON-REFUNDABLE UNDER ANY CIRCUMSTANCES.

SIGNATURE OF APPLICANT /s/ Bud Arnold for Mrs. Faith Gregory

APPROVED BY J. Stanger FOR dry well DATE 8/24/79


REJECTED BY \_\_\_\_\_ FOR \_\_\_\_\_ DATE \_\_\_\_\_

HOLD PENDING FURTHER TESTS \_\_\_\_\_ DATE \_\_\_\_\_

REASONS FOR REJECTION OR HOLDING \_\_\_\_\_

## THIS IS NOT A PERMIT

0-4  
clay  
4-12  
mud,  
loam,

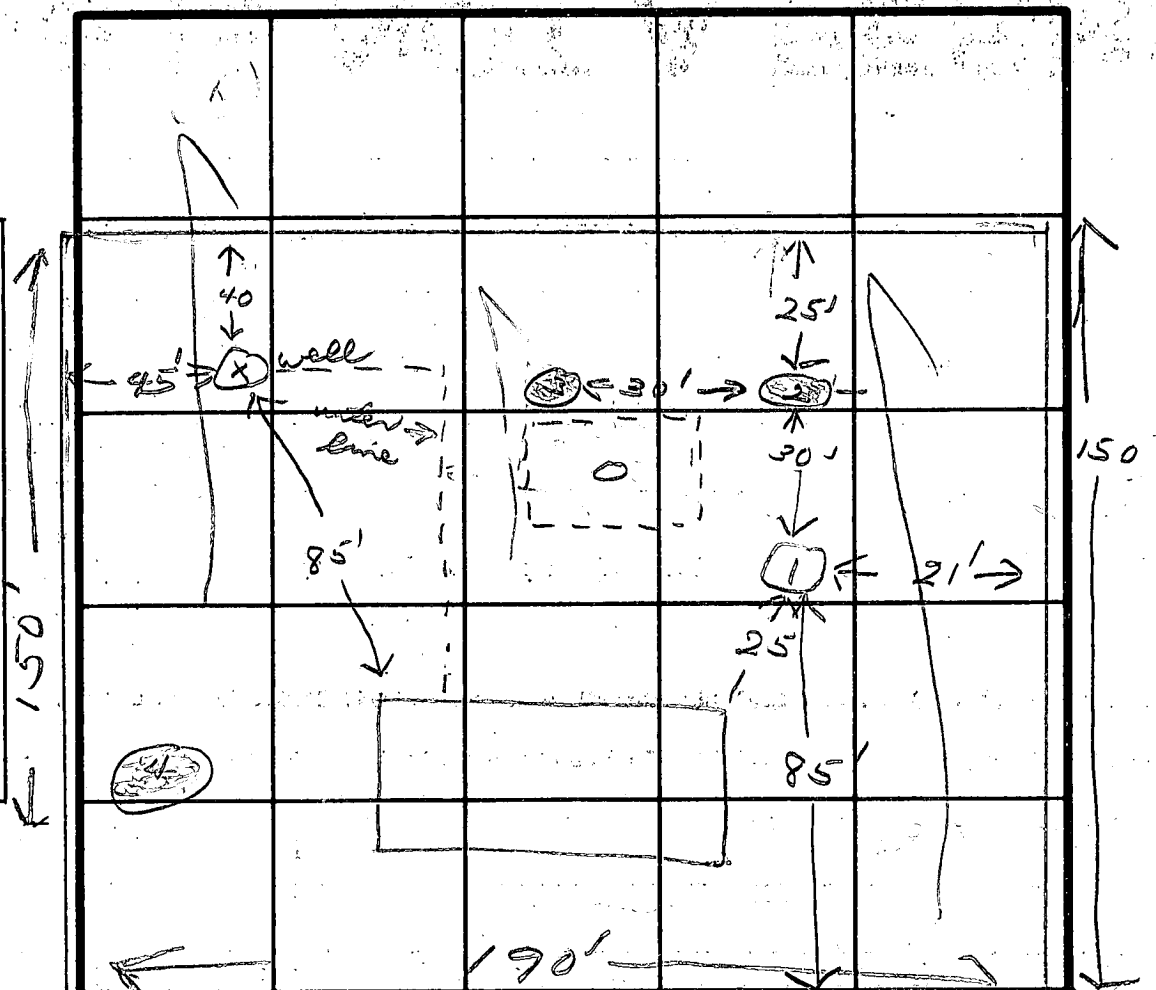

Woodstock Rd

[illegible]

REMARKS

TYPE OF SOIL

TESTED BY

**ALSO PRESENT**

201  
TSO

FILE# Sewage Complaint  
PROPERTY OWNER <sup>Faith</sup> Mrs. Gregory  
P.O. ADDRESS 713 Bishop Drive  
DIRECTIONS TO PROPERTY Virginia Beach, Virginia 23455

DATE REPORTED 7/2/79

INFORMANT Tenants: Susan Nolan 465-1323  
1708 Woodstock Road  
Woodstock, Md.

Mrs. Nolan called in; stated that system is overflowing and draining into the yard. She had Jenkins Bros. out to pump the system out; Mr. Jenkins suggested to her that the system needed repair work and told her to call us. Mrs. Nolan stated that the landlord is aware of the problem but has taken no action to rectify it.

CONDITION FOUND

7/24/79 TSO: No one home. Yard fenced; Doberman did not seem to want company. Postcard to arrange appointment:

Dear Mrs. Nolan:

ACTION TAKEN

On July 24, 1979, I attempted to document the failing septic system you reported to us. However, no one appeared to be home, the yard was fenced, and your Doberman did not seem to want company. Please call me at 992-2330, ~~that~~ to arrange ~~a time~~ an inspection convenient to your schedule.

Very truly yours,  
Tom Gb, Sanitarian  
Bureau of Environmental Health.

7/24/79 T/C from Mrs. Nolan: Appt. for tomorrow A.M.

FINAL DISPOSITION

7/25/79 TSO: definite overflow in backyard. House ~ 50 yrs. old. "Repair Bill 33"