

PERMIT

SEWAGE DISPOSAL SYSTEM

MARYLAND STATE DEPARTMENT OF HEALTH

HOWARD COUNTY

ELLICOTT CITY

DISTRICT 4th

DATE 9/18/79

INDEXED

Herman Sirk

IS PERMITTED TO INSTALL ALTER X

ADDRESS 2555 Jennings Chapel Road, Woodbine, Md. PHONE 489-4724

SUBDIVISION St. Michael's Road ROAD St. Michael's Road LOT LOCATION

PROPERTY OWNER Herman Kramer (ACROSS FROM PARISH HALL
OF ST. MICHAEL'S CHURCH)

ADDRESS _____

SPECIFICATIONS

SEPTIC TANK CAPACITY _____ GALLONS

DRAIN FIELD _____ DEPTH _____ FEET, BOTTOM AREA _____ SQ. FT.

DEEP TRENCH 60' DEPTH 10 FEET, BOTTOM AREA _____ SQ. FT.

SEEPAGE PITS _____ ABSORBENT SIDE-WALL AREA _____ SQ. FT.

INLET PIPE 3 FT. BELOW ORIGINAL GRADE, MAXIMUM DEPTH 10 FT. BELOW ORIGINAL GRADE

EFFECTIVE DEPTH AT 3 FT. BELOW ORIGINAL GRADE.

LOCATE DISPOSAL AREA _____ FT. FROM _____ LOT LINE AND _____ FT. FROM _____ LOT LINE AS SEEN WHEN

FACING LOT FROM COME OFF EXISTING DRY WELL

10/9/79 REPAIR - Call for an appointment when ground is opened up and Sanitarian will

recommend repair system. TRENCH 3' WIDE; 10' DEEP; 60' LONG

2' of STONE UNDER PIPE.

C.B.S.

PLANS APPROVED BY Palmer F. Wine DATE 9/18/79

COVER NO WORK UNTIL INSPECTED AND APPROVED.

NEITHER THE HOWARD COUNTY COUNCIL NOR THE HEALTH DEPARTMENT IS RESPONSIBLE FOR THE SUCCESSFUL OPERATION OF ANY SYSTEM.

NOTE: IF TRENCH IS USED CALL FOR INSPECTION BEFORE PLACING GRAVEL IN TRENCH.

NOTE: NO DRY WELL SHALL EXCEED 15 FOOT IN DIAMETER.


NOTE: ALL PIPE FROM HOUSE TO DISPOSAL AREA MUST BE CAST IRON.

PERMIT VOID AFTER THREE YEARS.

NOTE: INSTALL STAND PIPE ON SEPTIC TANK AND DRY WELL. STAND PIPES MUST BE 6 INCHES IN DIAMETER. CAST IRON, CONCRETE OR TERRA
COTTA ACCEPTED.

*INSTALLER IS RESPONSIBLE FOR OBTAINING FINAL APPROVAL ON THIS PERMIT.

P 30189

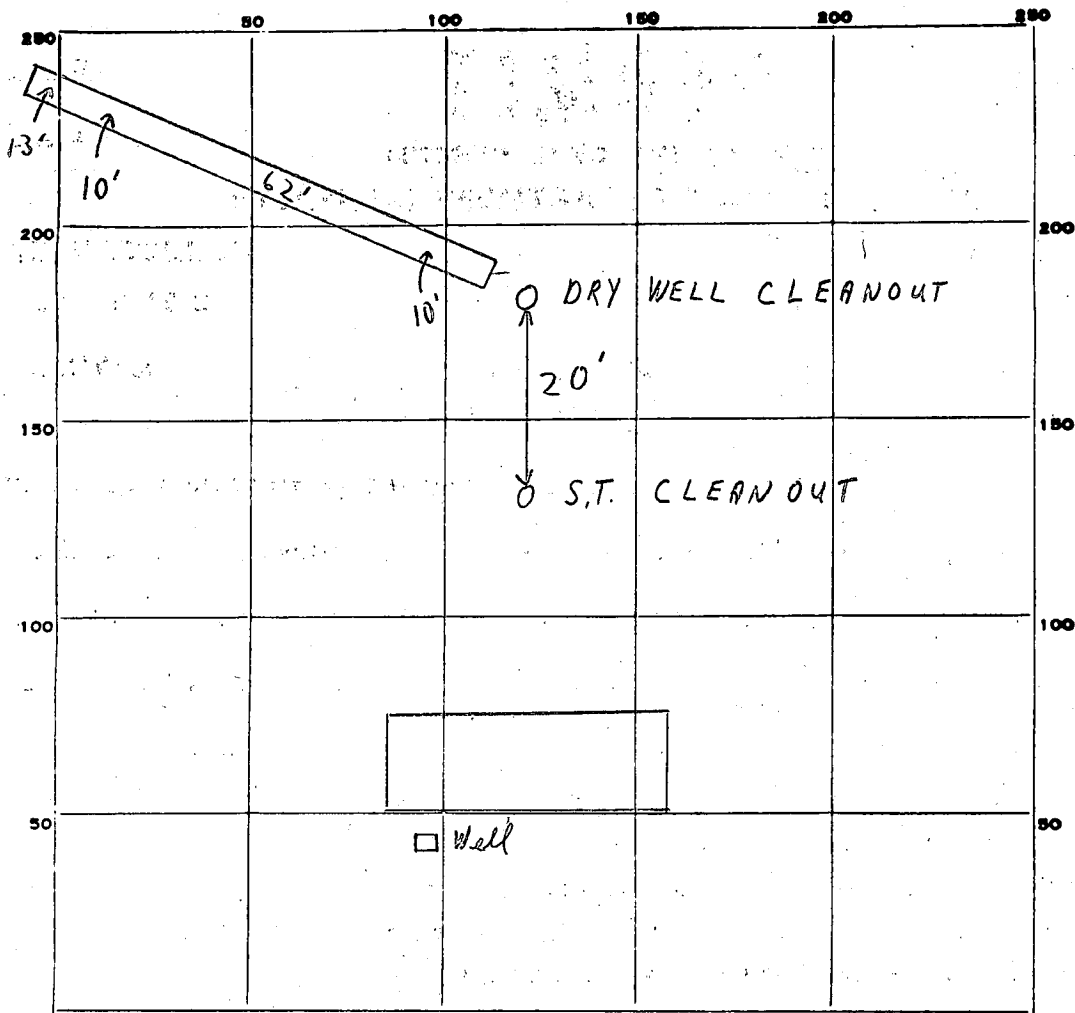

INDICATE NORTH. - NAME ADJOINING ROADWAY AS BASE LINE.

ROAD

PERMIT CARD ☒

SEPTIC TANK, LEVEL _____

CLEANOUTS _____

DISTRIBUTION BOX, LEVEL _____

TILE FIELD, DEPTH 10 FT. TRENCH WIDTH 3-6 FT.

GRAVEL DEPTH 7 FT IN. TOTAL LENGTH 62 68 FT.

NUMBER OF TRENCHES 1 ONE SIDE TOTAL BOTTOM AREA 483

SEEPAGE PITS, INSIDE DIAMETER _____ FT. DEPTH BELOW INLET _____ FT.

ABSORBENT AREA _____ SQ. FT.

REMARKS 10/9/79 DUG TO 13' ON ONE END OF TRENCH; HOLD TRENCH

DEPTH TO 10'

C.B.S.

10/17/79 STONE ADDED TO DITCH

DATE SYSTEM APPROVED

10/17/79

INSPECTOR

Raymond Hodges