

approved 3/6/80

J. Stayer

P 30527

A Repair

PERMIT

SEWAGE DISPOSAL SYSTEM

MARYLAND STATE DEPARTMENT OF HEALTH*

HOWARD COUNTY

ELLICOTT CITY

DISTRICT

DATE 2/14/80

INDEXED

Donald Parlette

IS PERMITTED TO INSTALL ALTER X

ADDRESS 6575 Route 32 21029 PHONE 286-2140

SUBDIVISION ROAD 11961 Simpson Rd. LOT

PROPERTY OWNER George Simpson

ADDRESS 11961 Simpson Road, Clarksville, Md. 21029

SPECIFICATIONS 3 BEDROOMS

SEPTIC TANK CAPACITY GALLONS

DRAIN FIELD DEPTH FEET, BOTTOM AREA SQ. FT.

DEEP TRENCH DEPTH FEET, BOTTOM AREA SQ. FT.

SEEPAGE PITS ABSORBENT SIDE-WALL AREA SQ. FT.

INLET PIPE FT. BELOW ORIGINAL GRADE, MAXIMUM DEPTH FT. BELOW ORIGINAL GRADE

EFFECTIVE DEPTH AT FT. BELOW ORIGINAL GRADE.

LOCATE DISPOSAL AREA FT. FROM LOT LINE AND FT. FROM LOT LINE AS SEEN WHEN
FACING LOT FROM

REPAIR-CALL FOR INSPECTION WHEN GROUND IS OPENED UP SO SANITARIAN CAN RECOMMEND

REPAIR 2/29/80-DEEP DITCH 13FT DEEP 7FT STONE

360 SQFT SIDE WALL AREA BELOW TOP 6FT OF CLAY

(EXAMPLE 7FT STONE, 52FT LONG 13FT DEEP)

PLANS APPROVED BY Palmer F. Wine

DATE 2/14/80

COVER NO WORK UNTIL INSPECTED AND APPROVED.

PLACE DITCH OFF OLD DRAIN FIELD

NEITHER THE HOWARD COUNTY COUNCIL NOR THE HEALTH DEPARTMENT IS RESPONSIBLE FOR THE SUCCESSFUL OPERATION OF ANY SYSTEM.

& RUN TOWARD SIMPSON RD.

NOTE: IF TRENCH IS USED CALL FOR INSPECTION BEFORE PLACING GRAVEL IN TRENCH.

NOTE: NO DRY WELL SHALL EXCEED 15 FOOT IN DIAMETER.

NOTE: ALL PIPE FROM HOUSE TO DISPOSAL AREA MUST BE CAST IRON.

PERMIT VOID AFTER THREE YEARS.

NOTE: INSTALL STAND PIPE ON SEPTIC TANK AND DRY WELL. STAND PIPES MUST BE 6 INCHES IN DIAMETER. CAST IRON, CONCRETE OR TERRA
COTTA ACCEPTED.

*INSTALLER IS RESPONSIBLE FOR OBTAINING FINAL APPROVAL ON THIS PERMIT.

7
30527

Check out
8-1-63

PERMIT

SEWAGE DISPOSAL SYSTEM

Approved
8/1/63
Dun

P 07192

A 07135

MARYLAND STATE DEPARTMENT OF HEALTH

HOWARD COUNTY

ELLICOTT CITY

DISTRICT 5

INDEXED

DATE 7/25/63

INDEXED

Frank Robbins

IS PERMITTED TO INSTALL ☒ ALTER ☐

ADDRESS _____ PHONE _____

A SEWAGE DISPOSAL SYSTEM LOCATED AT Simpson Rd. - behind Hall's Chevrolet Garage.

1/2 mile from Hall Shop Rd.

SUBDIVISION _____ ROAD _____ LOT _____

PROPERTY OWNER Simpson, George

ADDRESS _____

SPECIFICATIONS - - Leaching Bed - 375 sq. ft. bottom area - 5 to 6 ft. deep

DRAIN FIELD _____ DEPTH _____ FEET, BOTTOM AREA _____ SQ. FT.

SEEPAGE PITS _____ ABSORBENT SIDE-WALL AREA _____ SQ. FT.

SEPTIC TANK CAPACITY 750 GALLONS

FOR GARBAGE GRINDER, INCREASE DISPOSAL AREA 22% & TANK CAPACITY 50%.


OTHER ⁵⁵ Place bed 35 to 55 ft. Behind back of house with part of bed directly behind left rear corner of house as seen when facing lot from Simpson Rd.

PLANS APPROVED BY Raymond Hodges DATE 7/16/63

FILL SEPTIC TANK AND DISTRIBUTION BOX WITH WATER BEFORE CALLING FOR AN INSPECTION. COVER NO WORK UNTIL INSPECTED AND APPROVED.

NEITHER THE HOWARD COUNTY COMMISSIONERS NOR THE HEALTH DEPARTMENT IS RESPONSIBLE FOR THE SUCCESSFUL OPERATION OF ANY SYSTEM.

A 07135

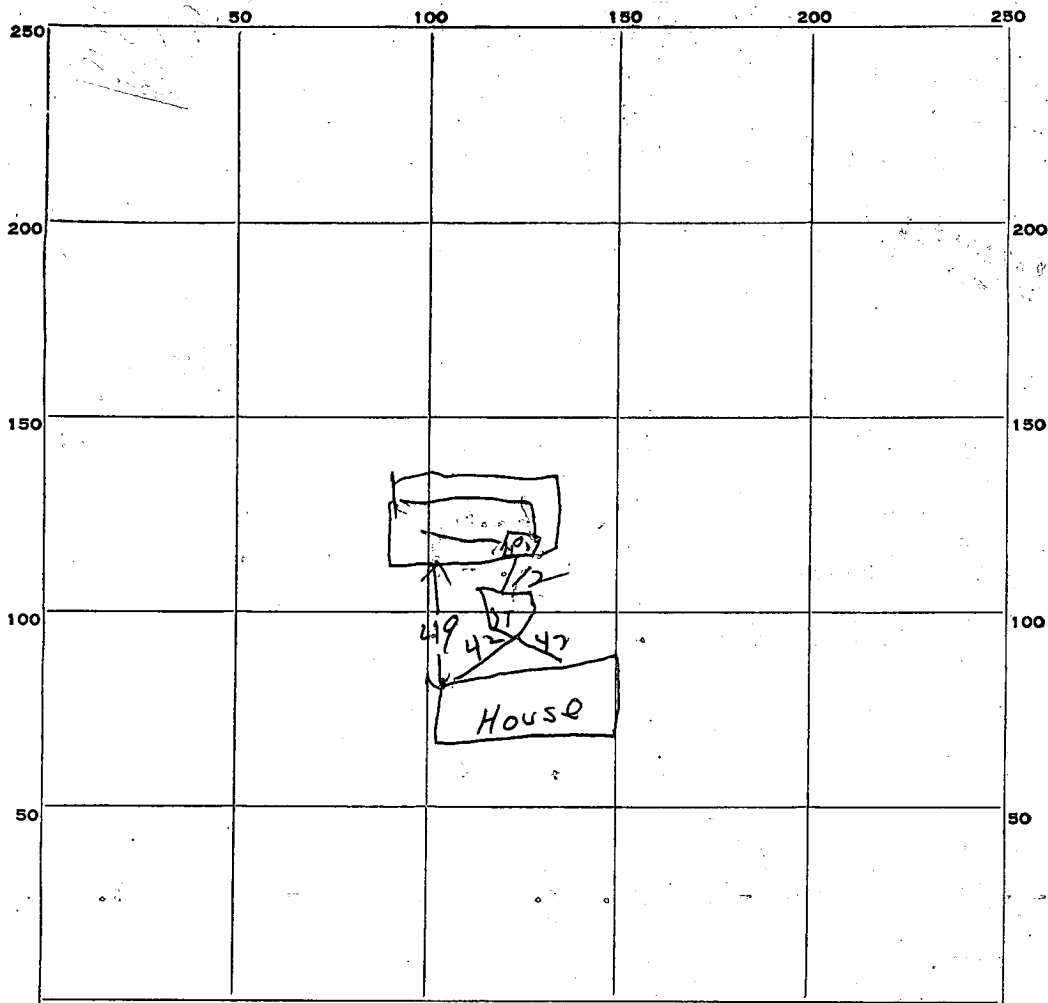

INDICATE NORTH. - NAME ADJOINING ROADWAY AS BASE LINE.

PERMIT CARD OK

SEPTIC TANK, LEVEL OK CLEANOUTS OK

DISTRIBUTION BOX, LEVEL OK

7 Bed TRENCH DEPTH 5 to 6 FT. 7 Bed TRENCH WIDTH 10 FT.

GRAVEL DEPTH 36" IN. 7 Bed TOTAL LENGTH 38 FT.

NUMBER OF TRENCHES _____ TOTAL BOTTOM AREA ~~360~~ 380 sq. ft.

SEEPAGE PITS, INSIDE DIAMETER _____ FT. DEPTH BELOW INLET _____ FT.

ABSORBENT AREA _____ SQ. FT.

REMARKS _____

DATE SYSTEM APPROVED 8/1/63 INSPECTOR W. Monaghan

APPLICATION

SEWAGE DISPOSAL TESTING

A 06565

P _____

MARYLAND STATE DEPARTMENT OF HEALTH

HOWARD COUNTY

ELLICOTT CITY

DISTRICT _____

DATE 4-10-63

*Leaching Bed - 300 sq ft bottom area
installed at a depth of 4 ft to 6 ft
Place the leaching bed in the area 15 ft to
50 ft from the front lot line and 4 ft to 20 ft
from the maple tree near the J.H. Parsons Property*

TO: THE COUNTY HEALTH OFFICER
ELLICOTT CITY, MARYLAND

I, HEREBY, APPLY FOR THE NECESSARY TESTS IN ORDER TO CONSTRUCT (OR RECONSTRUCT) A SEWAGE DISPOSAL SYSTEM.

PROPERTY OWNER

ADDRESS

PHONE

PROPERTY LOCATION:

SUBDIVISION

LOT NO.

ROAD AND DESCRIPTION

OCCUPANT

PHONE

PERSON TO CONSTRUCT SYSTEM

ADDRESS

PHONE

SIZE OF LOT

TYPE BLDG.

NUMBER OF BEDROOMS

IF NOT SINGLE RESIDENCE DESCRIBE

SIGNATURE OF APPLICANT

APPROVED BY

FOR

DATE

REJECTED BY

FOR


DATE

HOLD PENDING FURTHER TESTS

DATE

REASONS FOR REJECTION OR HOLDING

THIS IS NOT A PERMIT

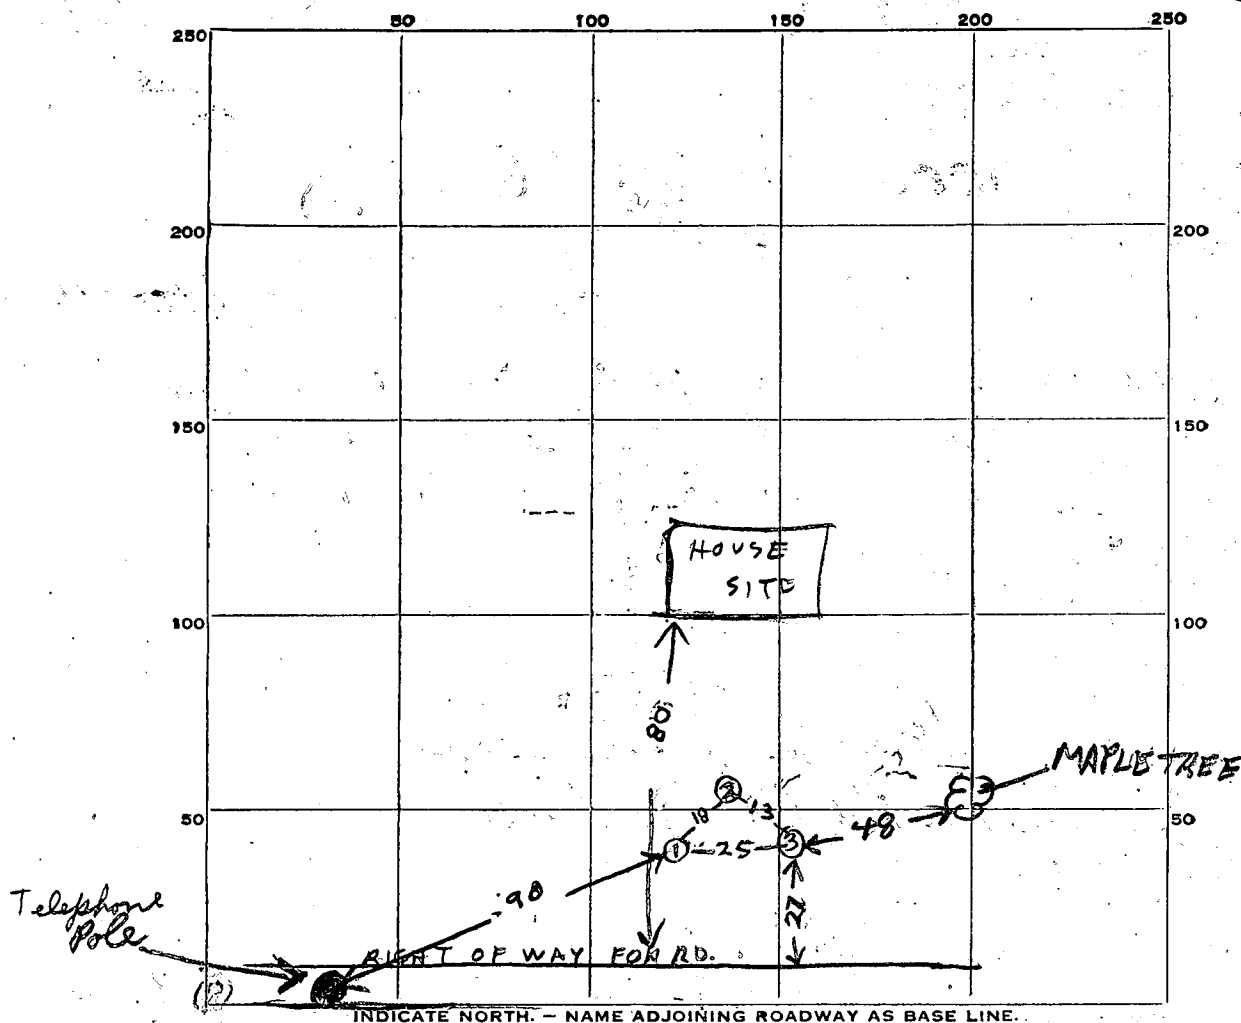

DATE	TEST NO.	DEPTH	PRE-WET		TEST - 1" DROP		TIME
			START	STOP	START	STOP	
4-17-63	1	4	1013	1014	1014	1016	2min
" "	2	4	1019	1021	1021	1025	4
" "	3	4	1024	1031	1031	1043	12
SAME PLACE AS ①	4	9	NO WATER		SAND & SILICA SOIL		

6 MIN
AVERAGE

SOIL AUGER FINDING

TESTED BY

Raymond Hodges

REMARKS

ALSO PRESENT

JW Robbins

LOT NO.

7-16-63
1:00

APPLICATION

SEWAGE DISPOSAL TESTING

Retest A 07/35
P _____

MARYLAND STATE DEPARTMENT OF HEALTH

HOWARD COUNTY 750 Gallon Tank

ELLICOTT CITY

Leaching Bed - 5-6 ft deep 375 sq ft bottom area
DISTRICT 5
DATE 7-11-63

Place the leaching bed 35 ft to 55 ft behind the back of the house with part of the bed directly behind the left rear corner of the house as seen when facing the lot from Simpson Road

TO: THE COUNTY HEALTH OFFICER
ELLICOTT CITY, MARYLAND

I, HEREBY, APPLY FOR THE NECESSARY TESTS IN ORDER TO CONSTRUCT (OR RECONSTRUCT) A SEWAGE DISPOSAL SYSTEM.

PROPERTY OWNER _____

George J. Simpson

ADDRESS _____

PHONE _____

PROPERTY LOCATION:

SUBDIVISION _____

LOT NO. _____

ROAD AND DESCRIPTION

*Simpson Rd. behind Hall's Chevrolet dealer
1/2 mile from Hall Shop Rd.*

OCCUPANT _____

PHONE _____

PERSON TO CONSTRUCT SYSTEM _____

ADDRESS _____

PHONE _____

SIZE OF LOT

45 acres

TYPE BLDG.

3

NUMBER OF BEDROOMS

IF NOT SINGLE RESIDENCE DESCRIBE _____

SIGNATURE OF APPLICANT

Mildred Robbins

APPROVED BY _____

FOR _____

DATE _____

(KIND OF SYSTEM)

REJECTED BY _____

FOR _____

DATE _____


(KIND OF SYSTEM)

HOLD PENDING FURTHER TESTS _____

DATE _____

REASONS FOR REJECTION OR HOLDING _____

THIS IS NOT A PERMIT

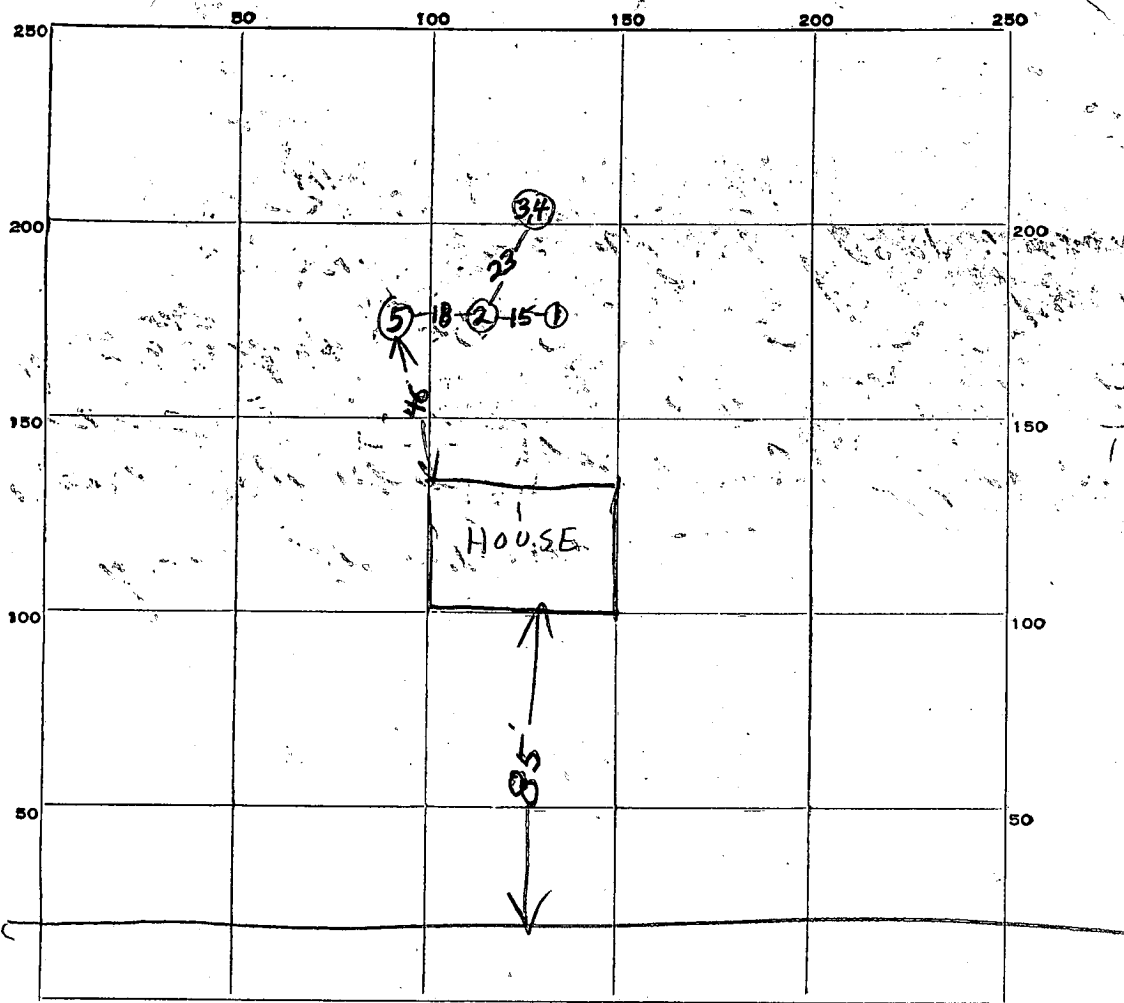

INDICATE NORTH. - NAME ADJOINING ROADWAY AS BASE LINE.

DATE	TEST NO.	DEPTH	PRE-WET		TEST - 1" DROP		TIME
			START	STOP	START	STOP	
7-16-68	1	5	113	115	115	118	3 min
" "	2	5 1/2	126	128	128	131	3 min
" "	3	5 1/2	138	217	217	245	17
" "	4	5 1/2	142	151	151	206	15
" "	5	5	159	214	214	243	29

IN SAME
BIG TEST
HOLE

12 min
average

17
22
29

3
3
29
335
12

15
148

SOIL AUGER FINDING

TESTED BY

Raymond Hodges

REMARKS

Well already installed in front of house

ALSO PRESENT

LOT NO.