

4/8/80
none, please

4/8/80 Fish approved
C.B.V.

PERMIT

SEWAGE DISPOSAL SYSTEM

MARYLAND STATE DEPARTMENT OF HEALTH*

HOWARD COUNTY

ELLICOTT CITY

INDEXED

DISTRICT 2ND.

DATE 3/19/80

P 30599

A REPAIR

Jack Fyock

IS PERMITTED TO INSTALL ALTER X

ADDRESS 13775 Triadelphia Road

PHONE 286-2939

SUBDIVISION Columbia, Hills

ROAD Sybert Drive

LOT

PROPERTY OWNER Tim Casgar

ADDRESS Sybert Drive

SPECIFICATIONS

SEPTIC TANK CAPACITY 1000 GALLONS (2 Bedroom - cottage existing)

DRAIN FIELD - DEPTH - FEET, BOTTOM AREA - SQ. FT.

DEEP TRENCH 11' DEPTH 65 FEET, BOTTOM AREA - SQ. FT.

SEEPAGE PITS - ABSORBENT SIDE-WALL AREA 360⁺ SQ. FT.

INLET PIPE 3 1/2 FT. BELOW ORIGINAL GRADE, MAXIMUM DEPTH 11 FT. BELOW ORIGINAL GRADE

EFFECTIVE DEPTH AT 3 1/2 FT. BELOW ORIGINAL GRADE.

LOCATE DISPOSAL AREA - FT. FROM - LOT LINE AND - FT. FROM - LOT LINE AS SEEN WHEN
FACING LOT FROM (PER DRAWING)

REPAIR - CALL FOR INSPECTION WHEN GROUND IS OPENED UP SO SANITARIAN CAN RECOMMEND

REPAIR.

PLANS APPROVED BY Palmer F. Wine

DATE 3/19/80

COVER NO WORK UNTIL INSPECTED AND APPROVED.

NEITHER THE HOWARD COUNTY COUNCIL NOR THE HEALTH DEPARTMENT IS RESPONSIBLE FOR THE SUCCESSFUL OPERATION OF ANY SYSTEM.

NOTE: IF TRENCH IS USED CALL FOR INSPECTION BEFORE PLACING GRAVEL IN TRENCH.

NOTE: NO DRY WELL SHALL EXCEED 15 FOOT IN DIAMETER.

NOTE: ALL PIPE FROM HOUSE TO DISPOSAL AREA MUST BE CAST IRON.


PERMIT VOID AFTER THREE YEARS.

NOTE: INSTALL STAND PIPE ON SEPTIC TANK AND DRY WELL. STAND PIPES MUST BE 6 INCHES IN DIAMETER. CAST IRON, CONCRETE OR TERRA
COTTA ACCEPTED.

REG. PERMIT SIGNED
AND RETURNED 6/16/80
Serial # 43403

P 30599

*INSTALLER IS RESPONSIBLE FOR OBTAINING FINAL APPROVAL ON THIS PERMIT.

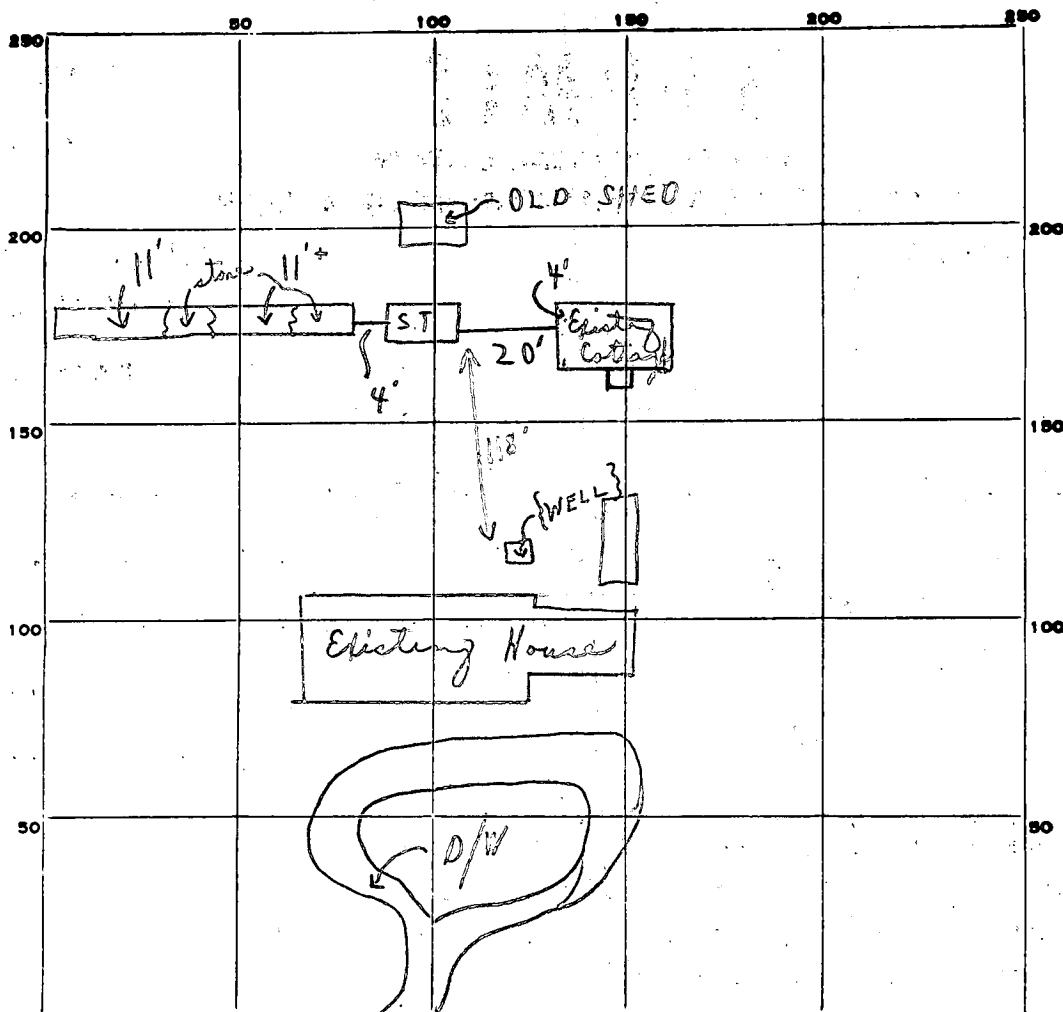

INDICATE NORTH - NAME ADJOINING ROADWAY AS BASE LINE.

SYBERT DRIVE

PERMIT CARD ☒

S.T.

SEPTIC TANK, LEVEL ☒

CLEANOUTS ☒

DISTRIBUTION BOX, LEVEL _____

TILE FIELD, DEPTH 11' avg FT. TRENCH WIDTH 2 FT.

GRAVEL DEPTH 7.5' IN. TOTAL LENGTH 65' FT.

NUMBER OF TRENCHES 1 TOTAL BOTTOM AREA _____

SEEPAGE PITS, INSIDE DIAMETER _____ FT. DEPTH BELOW INLET _____ FT.

ABSORBENT AREA 487 SQ. FT.

REMARKS 4/8/80 Trench ok for stone; SYSTEM - COMPLETE.

C.B. ✓



DATE SYSTEM APPROVED

4/8/80

INSPECTOR

C.B. Stricker

S 57° 28' 48" E 320.00

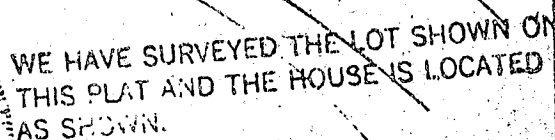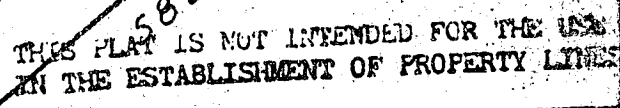

David C. Wilkin

~~DON LYNCH ASSOC. INC.~~
~~PENTHOUSE UNIT 1706~~
~~28 ALLEGHENY AVE.~~
~~TOWSON MD. 21204~~