

4/3/80
1:00 PM
if possible

APPROVED
4/3/80 RH
P 30602
A REPAIR

PERMIT

SEWAGE DISPOSAL SYSTEM

MARYLAND STATE DEPARTMENT OF HEALTH*

HOWARD COUNTY

INDEXED

ELLICOTT CITY

DISTRICT 2ND.

DATE 3/26/80

Jenkins Bros.

IS PERMITTED TO INSTALL ALTER X

ADDRESS 10439 Frederick Road, Ellicott City, Md. PHONE 465-6646

SUBDIVISION ROAD 7631 Columbia Pike LOT

PROPERTY OWNER William Johnson P

ADDRESS 7031 Columbia, Pike, Simpsomville, Md.

FROM Intersection of Rt 29 & Johns Hopkins Rd. Yellow House
SPECIFICATIONS Go Toward EC Turn on 1st or 2nd driveway on right

SEPTIC TANK CAPACITY _____ GALLONS

DRAIN FIELD _____ DEPTH _____ FEET. BOTTOM AREA _____ SQ. FT.

DEEP TRENCH _____ DEPTH _____ FEET. BOTTOM AREA _____ SQ. FT.

SEEPAGE PITS _____ ABSORBENT SIDE-WALL AREA _____ SQ. FT.

INLET PIPE _____ FT. BELOW ORIGINAL GRADE. MAXIMUM DEPTH _____ FT. BELOW ORIGINAL GRADE

EFFECTIVE DEPTH AT _____ FT. BELOW ORIGINAL GRADE.

LOCATE DISPOSAL AREA _____ FT. FROM _____ LOT LINE AND _____ FT. FROM _____ LOT LINE AS SEEN WHEN

FACING LOT FROM

REPAIR - CALL FOR INSPECTION WHEN GROUND IS OPENED UP SO SANITARIAN CAN RECOMMEND

REPAIR DRYWELL - 15x15 feet - Inlet 4ft. to 4 1/2 ft. and Maximum depth 10 1/2 ft. in
hole 1 above ~~dry~~ to limited repair area. 2/29/80

PLANS APPROVED BY Palmer F. Wine DATE 3/26/80

COVER NO WORK UNTIL INSPECTED AND APPROVED.

NEITHER THE HOWARD COUNTY COUNCIL NOR THE HEALTH DEPARTMENT IS RESPONSIBLE FOR THE SUCCESSFUL OPERATION OF ANY SYSTEM.

NOTE: IF TRENCH IS USED CALL FOR INSPECTION BEFORE PLACING GRAVEL IN TRENCH.

NOTE: NO DRY WELL SHALL EXCEED 15 FOOT IN DIAMETER.


NOTE: ALL PIPE FROM HOUSE TO DISPOSAL AREA MUST BE CAST IRON.

PERMIT VOID AFTER THREE YEARS.

NOTE: INSTALL STAND PIPE ON SEPTIC TANK AND DRY WELL. STAND PIPES MUST BE 6 INCHES IN DIAMETER. CAST IRON, CONCRETE OR TERRA
COTTA ACCEPTED.

*INSTALLER IS RESPONSIBLE FOR OBTAINING FINAL APPROVAL ON THIS PERMIT.

30602

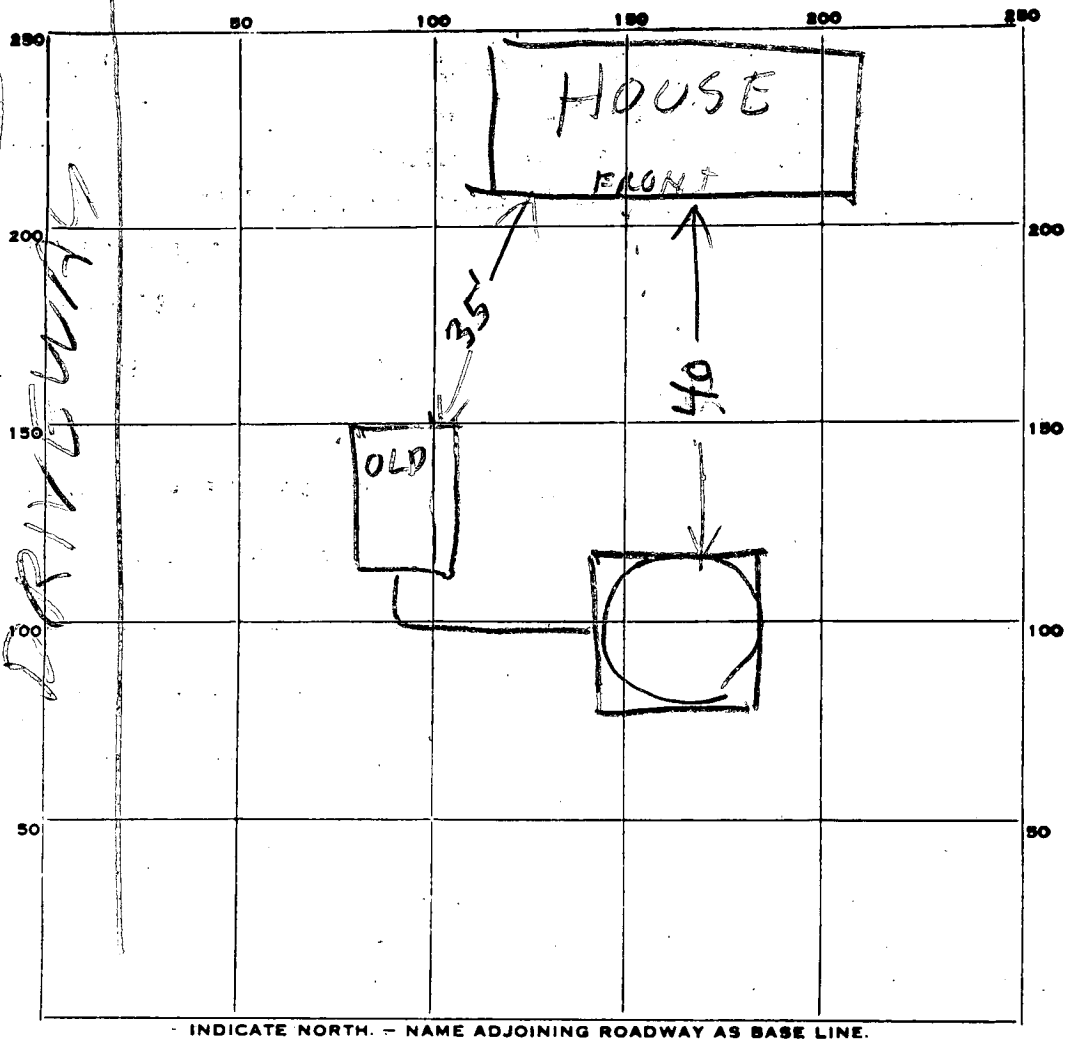

PERMIT CARD YES

SEPTIC TANK, LEVEL OLD TANK

CLEANOUTS

ST.	DW
OK	OK

DISTRIBUTION BOX, LEVEL _____

TILE FIELD, DEPTH _____ FT. TRENCH WIDTH _____ FT.

GRAVEL DEPTH _____ IN. TOTAL LENGTH _____ FT.

NUMBER OF TRENCHES _____ TOTAL BOTTOM AREA _____

SEEPAGE PITS, INSIDE DIAMETER 63 FT. DEPTH BELOW INLET 6 FT.

ABSORBENT AREA _____ SQ. FT.


REMARKS 4/3/80 DW INLET 5FT BELOW
GRADE. WELL IN BACK OF HOUSE,
OLD T.F. WORKED 20 YEARS

DATE SYSTEM APPROVED

4/3/80

INSPECTOR

Raymond Hodges

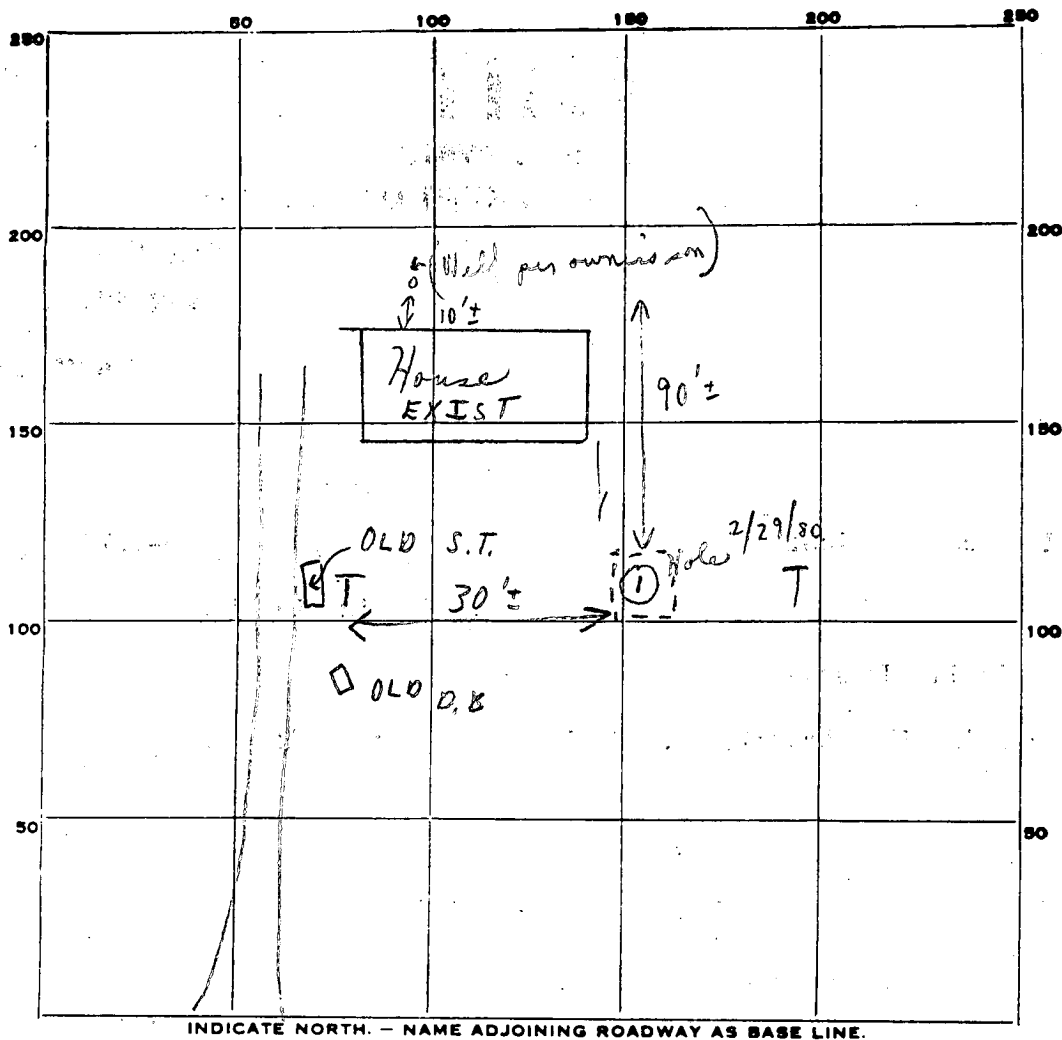

PERMIT CARD ☒

SEPTIC TANK, LEVEL _____

CLEANOUTS _____

DISTRIBUTION BOX, LEVEL _____

TILE FIELD, DEPTH _____ FT. TRENCH WIDTH _____ FT.

GRAVEL DEPTH _____ IN. TOTAL LENGTH _____ FT.

NUMBER OF TRENCHES _____ TOTAL BOTTOM AREA _____

SEEPAGE PITS, INSIDE DIAMETER _____ FT. DEPTH BELOW INLET _____ FT.

ABSORBENT AREA _____ SQ. FT.

REMARKS 2/29/80 CHECKED GROUND - DRY WELL 15X15 INLET @ 1' AND MAXIMUM DEPTH 10 1/2' IN HOLE ① ABOVE DUE TO LIMITED REPAIR AREA. [] Future dry well.

DATE SYSTEM APPROVED _____ INSPECTOR _____