

10/23/80
house connection

PERMIT

SEWAGE DISPOSAL SYSTEM

MARYLAND STATE DEPARTMENT OF HEALTH

7/18/80
p.m. please

Howard County

INDEXED

05-381649

approved 10/23/80
Stager

30753
P 3070
A 30170

ELLICOTT CITY

DISTRICT 5th.

DATE 7/2/80

Oaskar Schulz

IS PERMITTED TO INSTALL ☒ ALTER

ADDRESS 6610 Blackwatch Lane

PHONE 988-9098

SUBDIVISION Highland Lake

ROAD 6615 Prestwick Drive

LOT 23, Sec. 1

PROPERTY OWNER Oaskar Schulz

ADDRESS

SPECIFICATIONS 4 Bedrooms

SEPTIC TANK CAPACITY 1250 GALLONS

DRAIN FIELD DEPTH FEET, BOTTOM AREA SQ. FT.

DEEP TRENCH DEPTH FEET, BOTTOM AREA SQ. FT.

SEEPAGE PITS ABSORBENT SIDE-WALL AREA SQ. FT.

INLET PIPE FT. BELOW ORIGINAL GRADE, MAXIMUM DEPTH FT. BELOW ORIGINAL GRADE

EFFECTIVE DEPTH AT FT. BELOW ORIGINAL GRADE.

LOCATE DISPOSAL AREA FT. FROM LOT LINE AND FT. FROM LOT LINE AS SEEN WHEN

FACING LOT FROM

TRENCHES: 3 trenches - each trench to be 50 ft. long - 8 ft. deep - below original grade with 1 ft. of stone. under pipe. Invert to trenches 3 ft. below original grade. Trenches to follow contour of ground and be inspected before gravel is installed. Begin first trench 25 ft. from front lot line and 117 ft. from left side. Trenches to be 15 ft. apart - center to center. Remainder of trenches to go ~~XXXXX~~ behind trench.

BLDG. PERMIT SIGNED
AND RETURNED 8/4/80

Serial #43957

PLANS APPROVED BY Donald W. Monaghan

DATE 7/2/80

COVER NO WORK UNTIL INSPECTED AND APPROVED.

NEITHER THE HOWARD COUNTY COUNCIL NOR THE HEALTH DEPARTMENT IS RESPONSIBLE FOR THE SEWAGE DISPOSAL SYSTEM.

NOTE: IF TRENCH IS USED CALL FOR INSPECTION BEFORE PLACING GRAVEL IN TRENCH.

NOTE: NO DRY WELL SHALL EXCEED 15 FOOT IN DIAMETER.

NOTE: ALL PIPE FROM HOUSE TO DISPOSAL AREA MUST BE CAST IRON.

PERMIT VOID AFTER THREE YEARS.

NOTE: INSTALL STAND PIPE ON SEPTIC TANK AND DRY WELL. STAND PIPES MUST BE 6 INCHES IN DIAMETER. CAST IRON, CONCRETE OR TERRA COTTA ACCEPTED.

*INSTALLER IS RESPONSIBLE FOR OBTAINING FINAL APPROVAL ON THIS PERMIT.


HD - 23

BLDG. PERMIT SIGNED
AND RETURNED 9/16/84

Serial # 58527

Pool.

A 30170

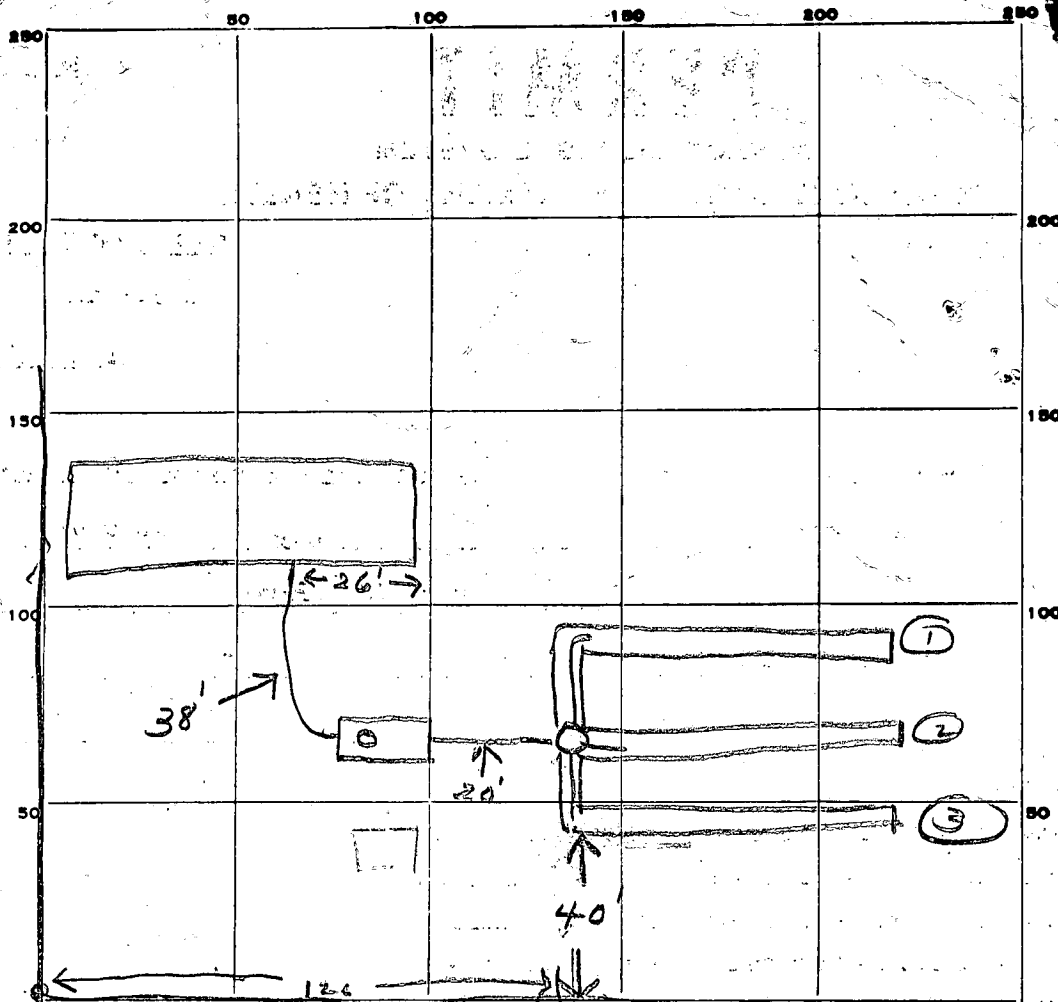

INDICATE NORTH - NAME ADJOINING ROADWAY AS BASE LINE.

PRESTWICK DR

PERMIT CARD

SEPTIC TANK, LEVEL OK

CLEANOUTS ST

DISTRIBUTION BOX, LEVEL ✓

TILE FIELD, DEPTH 8 FT. TRENCH WIDTH 2 FT.

GRAVEL DEPTH 5' IN. TOTAL LENGTH 150 FT.

NUMBER OF TRENCHES 3 TOTAL BOTTOM AREA 750

SEEPAGE PITS, INSIDE DIAMETER _____ FT. DEPTH BELOW INLET _____ FT.

ABSORBENT AREA 750 SQ. FT.

REMARKS 7/17/80 - MIDDLE DITCH STARTED 18 FT LONG 10 FT DEEP

BOTH HIT ROCK MAY HAVE TO MAKE DITCH LONGER & LESS DEEP RH

7/18/80 OK to add gravel in trenches JS

7/21/80 OK to cover all work to septic.

Call when house connection made JS & SK

10/23/80 OK to cover all work. SK & JS

DATE SYSTEM APPROVED 10/23/80

INSPECTOR

Stayer

William E. Doyle

LAND SURVEYOR 8440


5312 EMERALD DRIVE SYKESVILLE MARYLAND 21784 PHONE (301) 795-2210

DRYWELL DATA

INV. IN DIST. BOX 504.50 → 508.00
INV. OUT SEPTICTANK 504.85 → 508.35
INV. IN SEPTIC TANK 505.10 → 508.68
INV. OUT DWELLING 505.60 → 509.70
FIRST FLOOR ELEV. 509.05
BASEMENT ELEV. 501.05
WELL ELEV. 497.80
No BEDROOMS 4
ACREAGE 3.0206 Ac


PRESTWICK DRIVE
LOT 23
SECTION 1
HIGHLAND LAKE
HOWARD COUNTY
HIGHLAND, MARYLAND

NOTE: NO PLUMBING IN BASEMENT

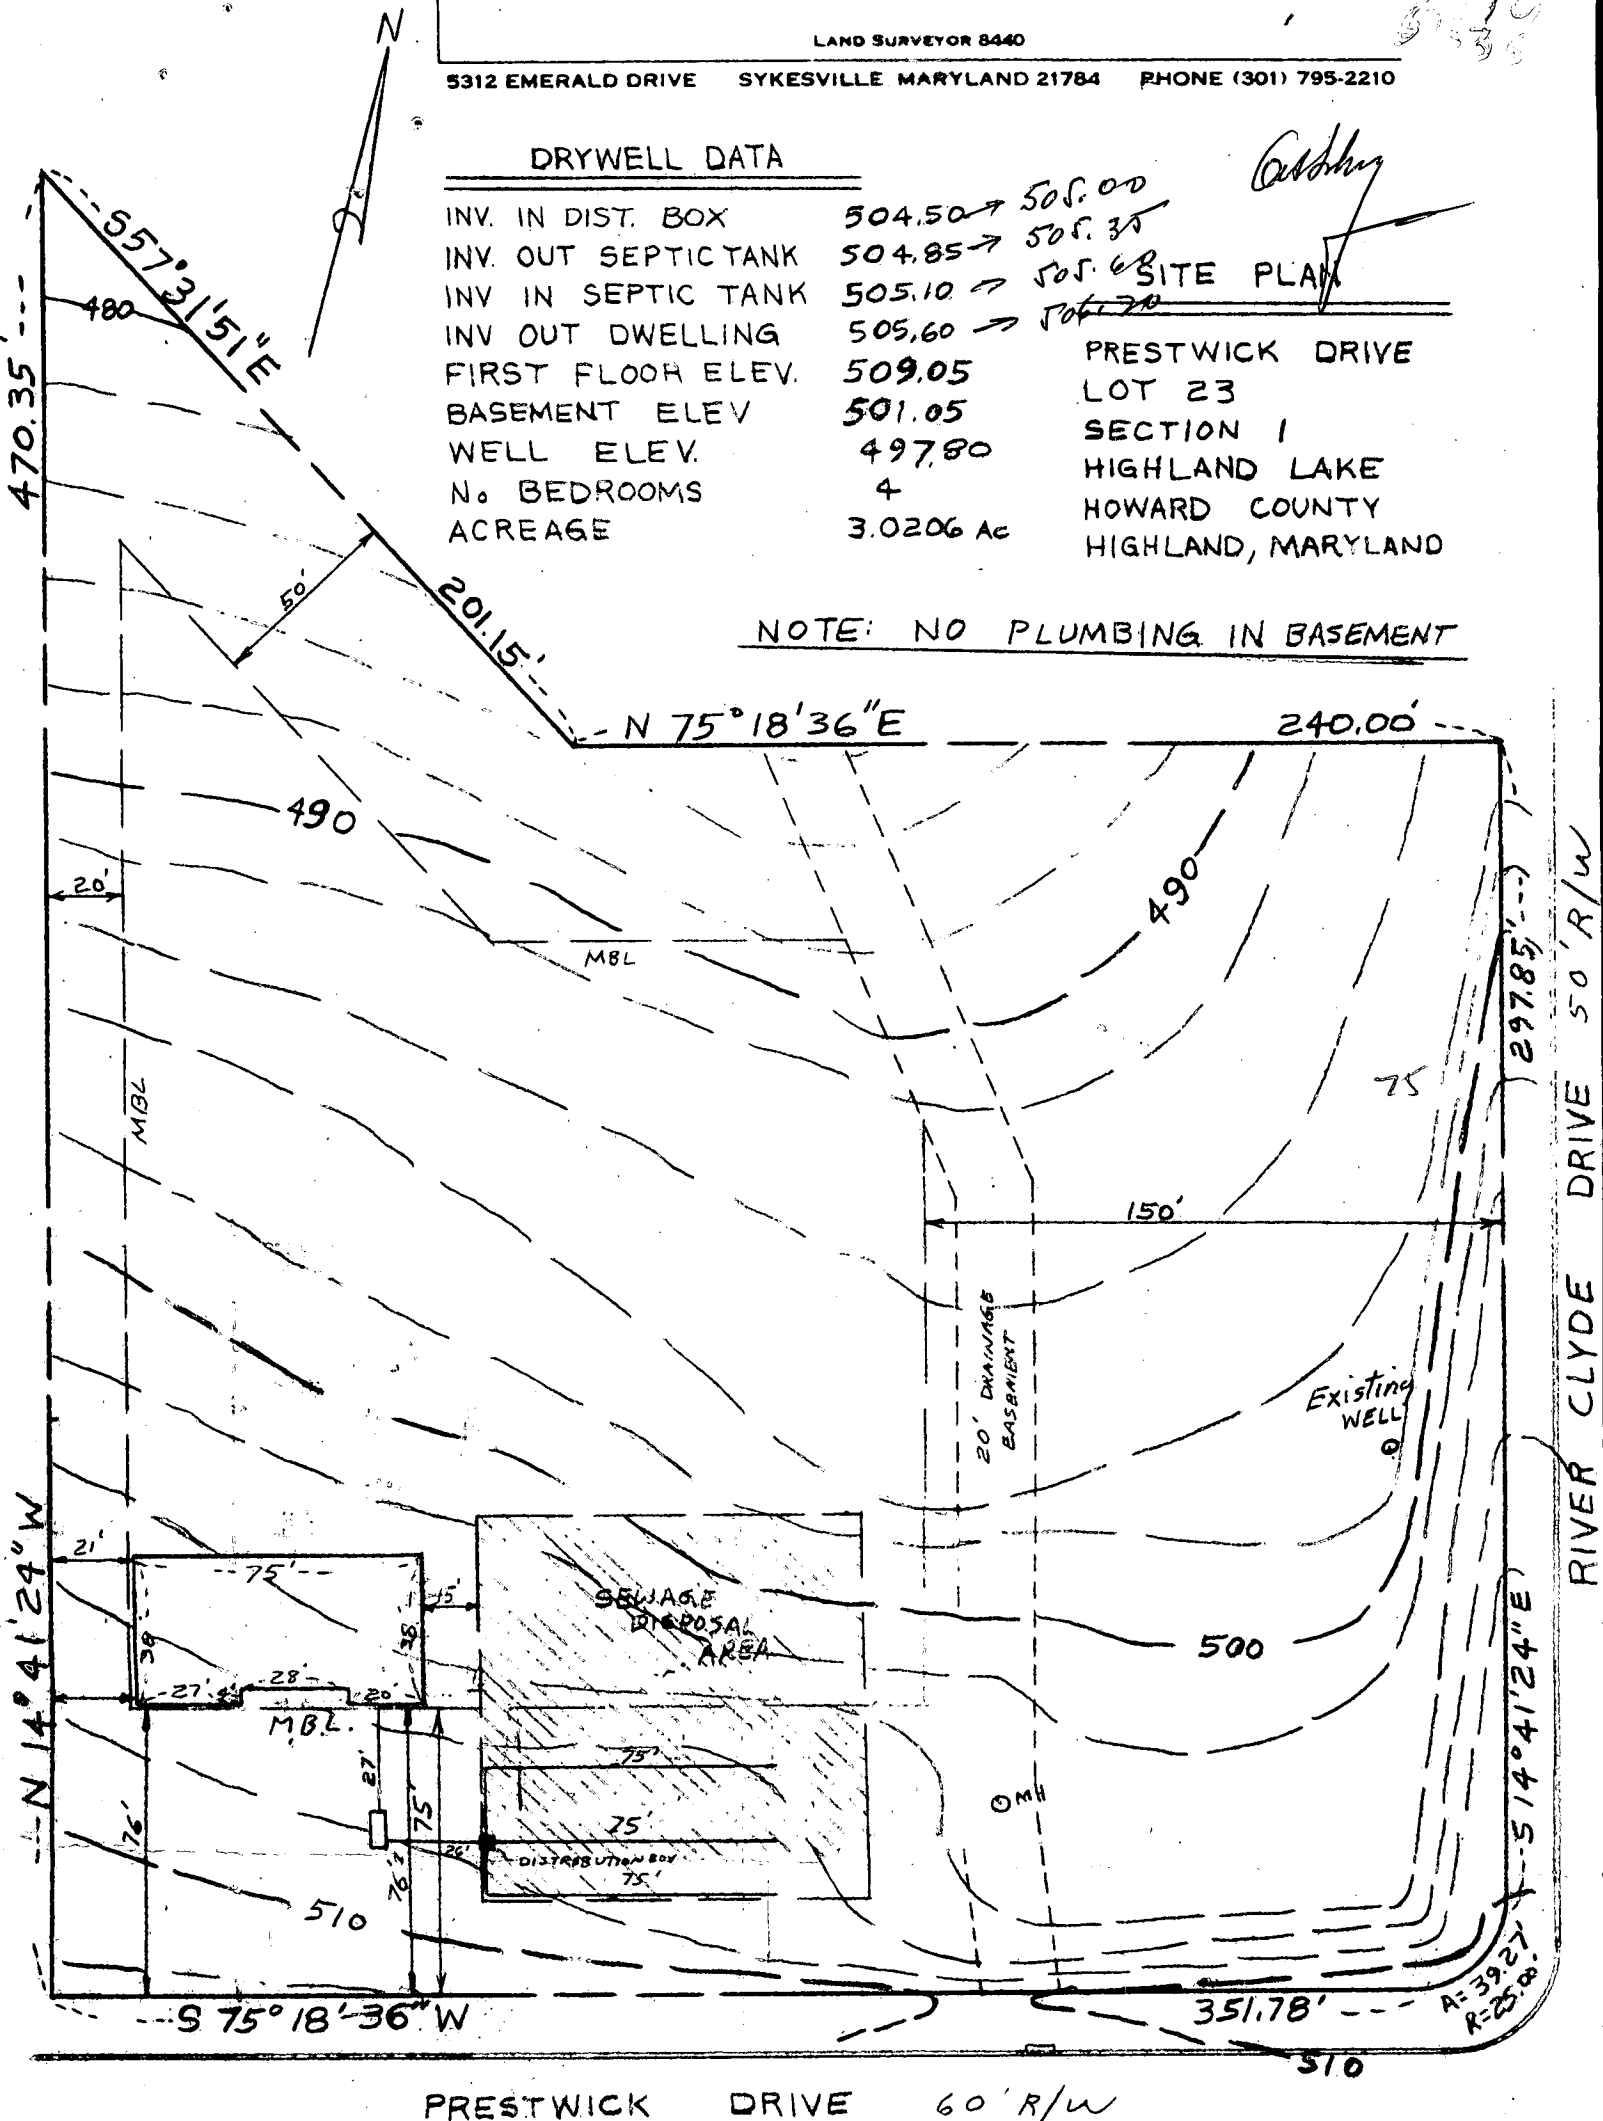

I CERTIFY THE ABOVE MEASUREMENTS AND ELEVATIONS ARE ACTUAL AND CORRECT FOR THIS PROPERTY.

SIGNED William E. Doyle

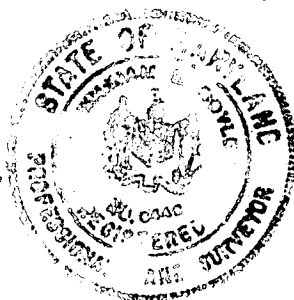

SCALE: 1" = 50'

DRAWN NOV 17 1979
REVISED JAN 5, 1980
REVISED JUNE 30, 1980

FILE NO. 369

STATE OF MARYLAND WATER RESOURCES ADMINISTRATION TAWES STATE OFFICE BLDG., ANNAPOLIS, MARYLAND 21401 APPLICATION FOR PERMIT TO DRILL WELL		WRA PERMIT NUMBER HO-73-3398 FILL IN THIS FORM COMPLETELY
B 1 7945 1 2 3 (SEQ. NO.) 6 (THIS NUMBER IS TO BE PUNCHED IN COLS. 3-6 ON ALL CARDS) SEQUENCE NO. (WRA USE ONLY)		
DATE RECEIVED (WRA USE ONLY) 1/30 11/9/79 OWNER Oskar Schultz, Inc. COL 15 LAST NAME STREET OR RFD 115 Roosevelt Rd. COL 36 POST OFFICE Sykesville, Md. 21784 COL 57 FIRST NAME To be person COL. 34 COL. 55 COL. 76		
B 1 CONTINUED 1 2 3 (SEQ. NO.) 6 DATE April 9, 1979 LICENSE NUMBER 64 77 80 FIRST NAME William W. Reichart DRILLER LAST NAME SIGNATURE <i>W. W. Reichart</i> DRILLER INFORMATION		B 3 1 2 3 (SEQ. NO.) 6 COUNTY Howard 8 (DO NOT ABBREVIATE COUNTY NAME) 21 SUBDIVISION Highland Lake 23 42 SECTION 44 46 LOT 23 50 NEAREST TOWN Clarksville 52 71 MILES FROM TOWN (ENTER 0 IF IN TOWN) 4 73 76 77 78 LOCATION OF WELL
B 2 1 2 3 (SEQ. NO.) 6 MAXIMUM PUMPING RATE (GALLONS PER MINUTE) 5-1 8 12 AVERAGE DAILY QUANTITY NEEDED (GALLONS PER DAY) 500 14 20 USE FOR WATER (CIRCLE APPROPRIATE BOX) ☒ D HOME (SINGLE OR DOUBLE HOUSEHOLD UNIT ONLY) ☐ F FARMING, AGRICULTURE, IRRIGATION ☐ I INDUSTRIAL, COMMERCIAL, STATE AND FEDERAL GOVERNMENT. ☐ M MUNICIPAL WATER SUPPLY ☐ P PRIVATE WATER COMPANY ☐ T TEST MUST HAVE STATE HEALTH DEPT. APPROVAL WELL INFORMATION		B 4 1 2 3 (SEQ. NO.) 6 ☒ N NORTH ☐ S SOUTH ☐ E EAST ☐ W WEST ☐ NE NORTHEAST ☐ NW NORTHWEST ☐ SE SOUTHEAST ☒ SW SOUTHWEST NEAR WHAT ROAD Trestle Drive ON WHICH SIDE OF ROAD (CIRCLE APPROPRIATE BOX) ☐ N NORTH ☐ S SOUTH ☐ E EAST ☒ W WEST DISTANCE FROM ROAD (ENTER DISTANCE AND CIRCLE APPROPRIATE BOX) 34 37 38 39 DIRECTION FROM TOWN (CIRCLE APPROPRIATE BOX)
APPROXIMATE DEPTH OF WELL 300 24 28 FEET APPROXIMATE DIAMETER OF WELL 6 (NEAREST INCH) METHOD OF DRILLING USED (CIRCLE APPROPRIATE METHOD) ☒ BORED (OR AUGERED) ☐ JETTED ☐ DIVEN ☒ AIR-ROTARY ☐ AIR-PERCUSSION ☐ ROTARY (HYDRAULIC ROTARY) ☐ CABLE ☐ REVERSE-ROTARY ☐ DRIVE-POINT OTHER (DESCRIBE) REPLACEMENT OR DEEPENED WELLS (CIRCLE APPROPRIATE BOX) ☐ N THIS WELL WILL NOT REPLACE AN EXISTING WELL ☐ Y THIS WELL WILL REPLACE A WELL THAT WILL BE ABANDONED AND SEALED ☐ S THIS WELL WILL REPLACE A WELL THAT WILL BE USED AS A STANDBY ☐ D THIS WELL WILL DEEPEAN AN EXISTING WELL PERMIT NUMBER OF WELL TO BE REPLACED OR DEEPEANED (IF AVAILABLE)		APPROPRIATION PERMIT NUMBER 54 69 ENGINEER REVIEW DISTRICT NO. 65 FORCE 67 68 WRITE INITIALS IN BOX CONDITIONS 70 71 72 73 74 75 76 77 78 79 HEALTH DEPARTMENT APPROVAL
B 4 CONTINUED 1 2 3 (SEQ. NO.) 6 STATE HEALTH (CIRCLE BOX) S MO. DAY YR. 11/9/79 DATE 43 48 Donald W. Monahan, Sanitarian APPROVED BY HEALTH DEPARTMENT APPROVAL		NORTH COORDINATE 1000000 50 51 52 53 54 55 EAST COORDINATE 0810000 57 58 59 60 61 62 63 ELEVATION AT WELL HEAD (FEET) 65 66 67 68 69 70 WELL LOCATION MAP
B 5 1 2 3 (SEQ. NO.) 6 SPECIAL CONDITIONS 8-83 WRA USE ONLY		WELL LOCATION MAP WELL INFORMATION

Handwritten notes and sketch:

Clarksville
Type II
(12 Run out of cement)
2:10-2:30
11/9/79
14 Bags of cement
33' Well
35' E
W. 800 Case
480
P.W.D.
P.W.D.
O/S
O/S
No other papers with this sketch
Well on corner lot near intersection

Handwritten notes at the bottom:

A 23975
HEALTH 1 1/2" casing out of ground 63

C 1 3753	SEQUENCE NO. (WRA USE ONLY)	STATE OF MARYLAND WATER RESOURCES ADMINISTRATION TAWES STATE OFFICE BLDG., ANNAPOLIS, MD. 21401 WELL COMPLETION REPORT		THIS REPORT MUST BE SUBMITTED WITHIN 30 DAYS AFTER WELL COMPLETION FILL IN THIS FORM COMPLETELY COUNTY NUMBER
DATE RECEIVED (WRA USE ONLY) MAY 9 1979 DATE WELL COMPLETED		DEPTH OF WELL 150 (TO NEAREST FOOT)	PERMIT NO. FROM "PERMIT TO DRILL WELL" HD-73-339A 28 29 30 31 32 33 34 35 36 37	
OWNER LAST NAME <u>Askar Schultz Inc.</u> STREET OR RFD <u>115 Roosevelt Rd.</u>		FIRST NAME <u>Shesville MD 51784</u> POST OFFICE		

WELL LOG			GROUTING RECORD			PUMPING TEST																																
STATE THE KIND OF FORMATIONS PENETRATED, THEIR COLOR, DEPTH, THICKNESS AND IF WATER BEARING <table border="1" style="width:100%; border-collapse: collapse;"> <thead> <tr> <th rowspan="2">DESCRIPTION (USE ADDITIONAL SHEETS IF NECESSARY)</th> <th colspan="2">FEET</th> <th rowspan="2">CHECK IF WATER BEARING</th> </tr> <tr> <th>FROM</th> <th>TO</th> </tr> </thead> <tbody> <tr> <td>rolling ground gravel</td> <td>0</td> <td>29'</td> <td></td> </tr> <tr> <td>schist</td> <td>29'</td> <td>38'</td> <td></td> </tr> <tr> <td>water</td> <td></td> <td></td> <td>✓</td> </tr> <tr> <td>schist</td> <td>38'</td> <td>122'</td> <td></td> </tr> <tr> <td>water</td> <td></td> <td></td> <td>✓</td> </tr> <tr> <td>schist</td> <td>122'</td> <td>150'</td> <td></td> </tr> </tbody> </table>			DESCRIPTION (USE ADDITIONAL SHEETS IF NECESSARY)	FEET		CHECK IF WATER BEARING	FROM	TO	rolling ground gravel	0	29'		schist	29'	38'		water			✓	schist	38'	122'		water			✓	schist	122'	150'		WELL HAS BEEN GROUTED: YES ☒ NO ☐ TYPE OF GROUTING MATERIAL (CIRCLE BOX) CEMENT ☒ BENTONITE-CLAY ☐ NO. OF BAGS <u>74</u> NO. OF POUNDS <u>1344</u> GALLONS OF WATER <u>98</u> DEPTH OF GROUT SEAL (TO NEAREST FOOT) FROM <u>0</u> FT. TO <u>34</u> FT. (ENTER 0 IF FROM SURFACE)			C 3 1 2 3 (SEQ. NO.) 6 HOURS PUMPED (TO NEAREST HOUR) <u>1</u> PUMPING RATE (GALLONS PER MINUTE TO NEAREST GALLON) <u>5</u> METHOD USED TO MEASURE PUMPING RATE <u>Air</u> WATER LEVEL: (DISTANCE FROM LAND SURFACE) BEFORE PUMPING <u>35</u> (NEAREST FOOT) WHEN PUMPING <u>150</u> (NEAREST FOOT) TYPE OF PUMPED USED (CIRCLE APPROPRIATE BOX) ☒ AIR ☐ PISTON ☐ TURBINE ☐ CENTRIFUGAL ☐ ROTARY ☐ OTHER (DESCRIBE BELOW) ☐ JET ☐ SUBMERSIBLE		
DESCRIPTION (USE ADDITIONAL SHEETS IF NECESSARY)	FEET			CHECK IF WATER BEARING																																		
	FROM	TO																																				
rolling ground gravel	0	29'																																				
schist	29'	38'																																				
water			✓																																			
schist	38'	122'																																				
water			✓																																			
schist	122'	150'																																				
CASING RECORD INSERT APPROPRIATE CODE BELOW MAIN CASING TYPE ☒ ST <u>6</u> <u>34</u> NOMINAL DIAMETER TOP (MAIN) CASING (NEAREST INCH) TOTAL DEPTH OF MAIN CASING (NEAREST FOOT)			OTHER CASING (IF USED) DIAMETER (INCH) FROM TO DEPTH (FEET) FROM TO			PUMP INSTALLED TYPE OF PUMP (WRITE APPROPRIATE LETTER IN BOX - SEE ABOVE: A, C, J, P, R, S, T, O) ☒ YES ☐ NO DRILLER WILL INSTALL PUMP (CIRCLE APPROPRIATE BOX) CAPACITY: GALLONS PER MINUTE (TO NEAREST GALLON) <u>35</u> PUMP HORSE POWER <u>37</u> PUMP COLUMN LENGTH (NEAREST FOOT) <u>43</u>																																
SCREEN TYPE OR OPEN HOLE INSERT APPROPRIATE CODE BELOW SCREEN TYPE ☒ ST ☐ BR ☐ HO STEEL BRASS OPEN HOLE OR BRONZE PLASTIC OTHER			SCREEN RECORD C 2 1 2 3 (SEQ. NO.) 6 DEPTH (NEAREST WHOLE FOOT) FROM <u>34</u> TO <u>150</u> .8 9 11 15 17 21 23 24 26 30 32 36 38 39 41 45 47 51 SLOTSIZE 1. 2. 3.			CASING HEIGHT (CIRCLE APPROPRIATE BOX AND ENTER CASING HEIGHT) ☒ ABOVE ☐ BELOW LAND SURFACE (NEAREST FOOT) 49 50 51																																

CIRCLE APPROPRIATE BOXES

☐ A WELL WAS ABANDONED AND SEALED WHEN THIS WELL WAS COMPLETED

☐ E ELECTRIC LOG OBTAINED

☐ P TEST WELL CONVERTED TO PRODUCTION WELL

I HEREBY CERTIFY THAT I HAVE COMPLIED WITH ALL CONDITIONS STATED ON THE ABOVE-CAPTIONED "PERMIT TO DRILL WELL", AND THAT INFORMATION CONTAINED IN THIS REPORT IS TRUE, ACCURATE, AND COMPLETE TO THE BEST OF MY KNOWLEDGE, INFORMATION AND BELIEF.

DRILLERS NAME
 (PLEASE PRINT) Don W Reichart
 SIGNATURE Don W Reichart

WRA USE ONLY (NOT TO BE FILLED IN BY DRILLER)

TELESCOPE CASING ☐ LOG INDICATOR ☐ OTHER DATA AVAILABLE ☐

DIAMETER OF SCREEN 56 (NEAREST INCH)
 FROM 60 TO

GRAVEL PACK ☐

IF WELL DRILLED WAS A FLOWING WELL CIRCLE BOX ☐

LOCATION OF WELL ON LOT

SHOW PERMANENT STRUCTURE SUCH AS BUILDINGS, SEPTIC TANKS, AND/OR OTHER LAND MARKS AND INDICATE NOT LESS THAN TWO DISTANCES (MEASUREMENTS TO WELL).

APPLICATION

SEWAGE DISPOSAL TESTING

A 30170

STATE OF MARYLAND - DEPARTMENT OF HEALTH AND MENTAL HYGIENE

P

HOWARD COUNTY HEALTH DEPARTMENT
ENVIRONMENTAL HEALTH SERVICES

P.O. BOX 476 ELLICOTT, MARYLAND-21043
TELEPHONE: 992-2330

Septic Tank - 1200 gal.

DISTRICT 5th

TO: THE COUNTY HEALTH OFFICER
ELLICOTT CITY, MARYLAND

I, HEREBY, APPLY FOR THE NECESSARY TEST IN ORDER TO CONSTRUCT (OR RECONSTRUCT) A SEWAGE DISPOSAL SYSTEM.

PROPERTY OWNER Oskar Schulz

ADDRESS

145 ROOSEVELT Rd

PHONE

988-9098

PROPERTY LOCATION:

6410 Blackwatch Lane
Highland, Md 20777

SUBDIVISION Highland Lake

LOT NO. 23

ROAD AND DESCRIPTION

SIZE OF LOT

TYPE BLDG. 3 or 4 bedrooms

THE SYSTEM INSTALLED UNDER THIS APPLICATION IS ACCEPTABLE ONLY UNTIL PUBLIC FACILITIES BECOME AVAILABLE.

I FULLY UNDERSTAND THE FEE CONNECTED WITH THE FILING OF THIS PERC TEST APPLICATION IS NON-REFUNDABLE UNDER

ANY CIRCUMSTANCES.

SIGNATURE OF APPLICANT /s/ Oskar Schulz

APPROVED BY

FOR

DATE

REJECTED BY

FOR

DATE

HOLD PENDING FURTHER TESTS

DATE



REASONS FOR REJECTION OR HOLDING

9/21/79 HOLD FOR REVIEW WATER R/L

9/28/79 DM SAID IT FAILED RH

COPY MAILED TO O. SCHULZ

THIS IS NOT A PERMIT

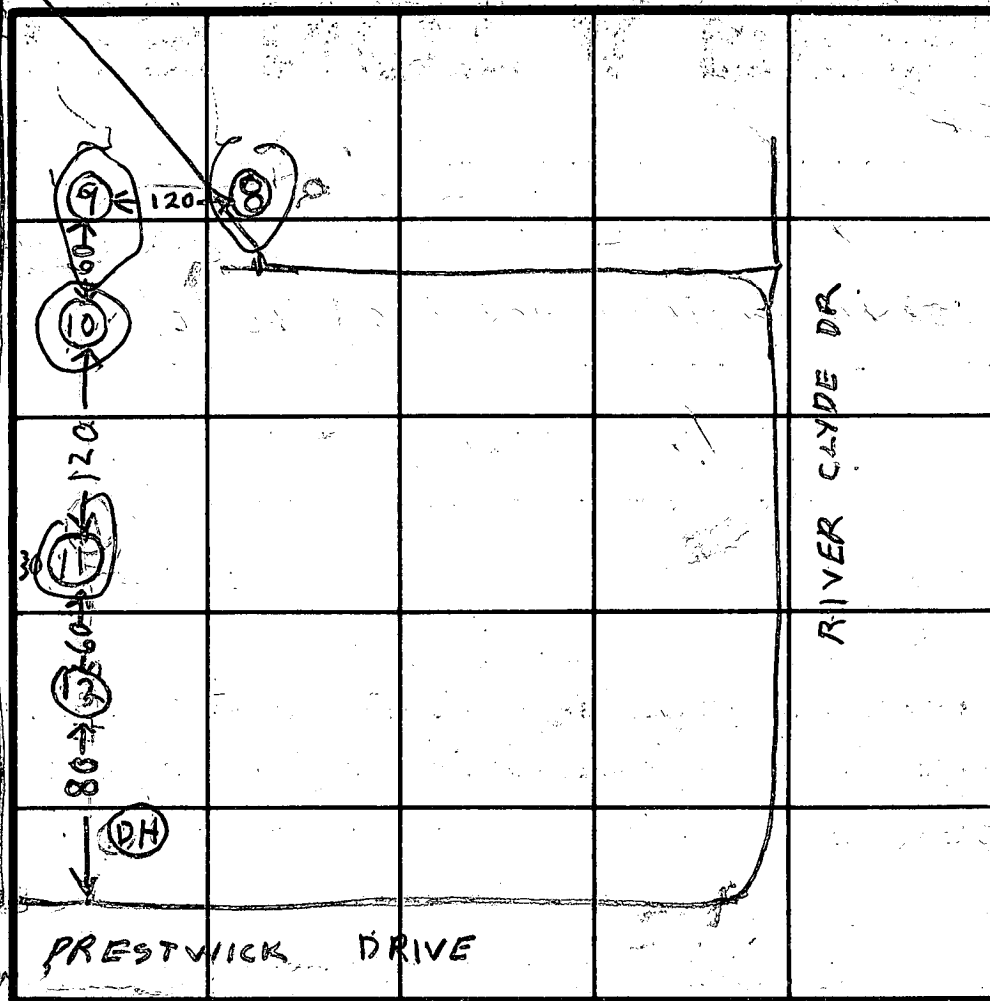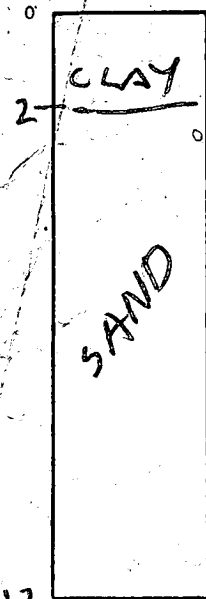

PRESTWICK DRIVE

INDICATE NORTH - NAME ADJOINING ROADWAY AS BASE LINE.

⑨ = LOWEST

DATE	TEST NO.	DEPTH	PRE-WET		TEST - 1" DROP		TIME
			START	STOP	START	STOP	
9/20/79	* 8 V	7 1/2	TOP 3 FT CLAY		BOT 4 1/2	SANDY	
			WATER		7 FT		
	9 V	12	WATER		11		
	9 D	7	1128	1130	1130	1132	2
	9 S	3 1/2	1129	1200	little per	FAIL	
	10 V	11	TOP 3 FT CLAY		BOT 8	FT SAND	
			WATER 10 FT				
	11 V	13	WATER		12 FT		
	11 S	5 1/2	149	135	little per	FAIL	
	12 S	5	121	122	122	124	2
	12 D	9 1/2	128	130	130	133	3
	12 V	12	SEE	SOIL	PROFILE		
			NOT TESTED	SUF7	SAND	DR1	

(17) = DRY HOLE DUG 400 FT FOR WATER WELL

REMARKS ~~A~~ DUG ON WIRING LOT

TYPE OF SOIL

TESTED BY RAYMOND HODGES

ALSO PRESENT OSKAR SCHULZ INC
DOYLE EXCAVATING

APPLICATION

A 23975

SEWAGE DISPOSAL TESTING

P _____

STATE OF MARYLAND - DEPARTMENT OF HEALTH AND MENTAL HYGIENE

HOWARD COUNTY HEALTH DEPARTMENT
ENVIRONMENTAL HEALTH SERVICES

DISTRICT Fifth

P. O. BOX 476, ELLICOTT CITY, MARYLAND 21043
TELEPHONE: 465-5000, EXT. 356

DATE 9/15/76

TO: THE COUNTY HEALTH OFFICER
ELLICOTT CITY, MARYLAND

I, HEREBY, APPLY FOR THE NECESSARY TEST IN ORDER TO CONSTRUCT (OR RECONSTRUCT) A SEWAGE DISPOSAL SYSTEM.

PROPERTY OWNER Mr. Walter Bucher

ADDRESS Highland Partnership
8777 First Avenue PHONE (8) 588 3100
Silver Spring, MD 20901

PROPERTY LOCATION:

SUBDIVISION Highland Lake LOT NO. New 24 New 24

ROAD AND DESCRIPTION Dundee Ct.

SIZE OF LOT one acre m/l TYPE BLDG. 3 or 4 bedroom
NUMBER OF BEDROOMS

IF NOT SINGLE RESIDENCE DESCRIBE _____

THE SYSTEM INSTALLED UNDER THIS APPLICATION IS ACCEPTABLE ONLY UNTIL PUBLIC FACILITIES BECOME AVAILABLE.

SIGNATURE OF APPLICANT /s/ Mr. Walter Bucher

APPROVED BY _____ FOR _____ DATE _____
(KIND OF SYSTEM)

REJECTED BY _____ FOR _____ DATE _____
(KIND OF SYSTEM)

HOLD PENDING FURTHER TESTS _____ DATE _____

REASONS FOR REJECTION OR HOLDING _____

THIS IS NOT A PERMIT

APPLICATION

A 19710

SEWAGE DISPOSAL TESTING

P _____

STATE OF MARYLAND - DEPARTMENT OF HEALTH AND MENTAL HYGIENE

5th

HOWARD COUNTY HEALTH DEPARTMENT
ENVIRONMENTAL HEALTH SERVICES

DISTRICT _____

P. O. BOX 476, ELLICOTT CITY, MARYLAND 21043
TELEPHONE: 465-5000, EXT. 356

DATE 2-25-74

TO: THE COUNTY HEALTH OFFICER
ELLICOTT CITY, MARYLAND

I, HEREBY, APPLY FOR THE NECESSARY TEST IN ORDER TO CONSTRUCT (OR RECONSTRUCT) A SEWAGE DISPOSAL SYSTEM.

PROPERTY OWNER Apple Development Company, Inc.

ADDRESS Box 145-A-RFD #1, Ijamsville, Md. PHONE 301/874-2835

PROPERTY LOCATION:

SUBDIVISION Henry K. Owings Property LOT NO. Lot 85-Phase 1

ROAD AND DESCRIPTION Road "E"

SIZE OF LOT 33,000 +/- TYPE BLDG. 3-4 B.R.

NUMBER OF BEDROOMS

IF NOT SINGLE RESIDENCE DESCRIBE N/A

THE SYSTEM INSTALLED UNDER THIS APPLICATION IS ACCEPTABLE ONLY UNTIL PUBLIC FACILITIES BECOME AVAILABLE.

SIGNATURE OF APPLICANT Robert A. Kuhn


APPROVED BY _____ FOR _____ DATE _____
(KIND OF SYSTEM)

REJECTED BY _____ FOR _____ DATE _____
(KIND OF SYSTEM)

HOLD PENDING FURTHER TESTS _____ DATE _____

REASONS FOR REJECTION OR HOLDING _____

THIS IS NOT A PERMIT

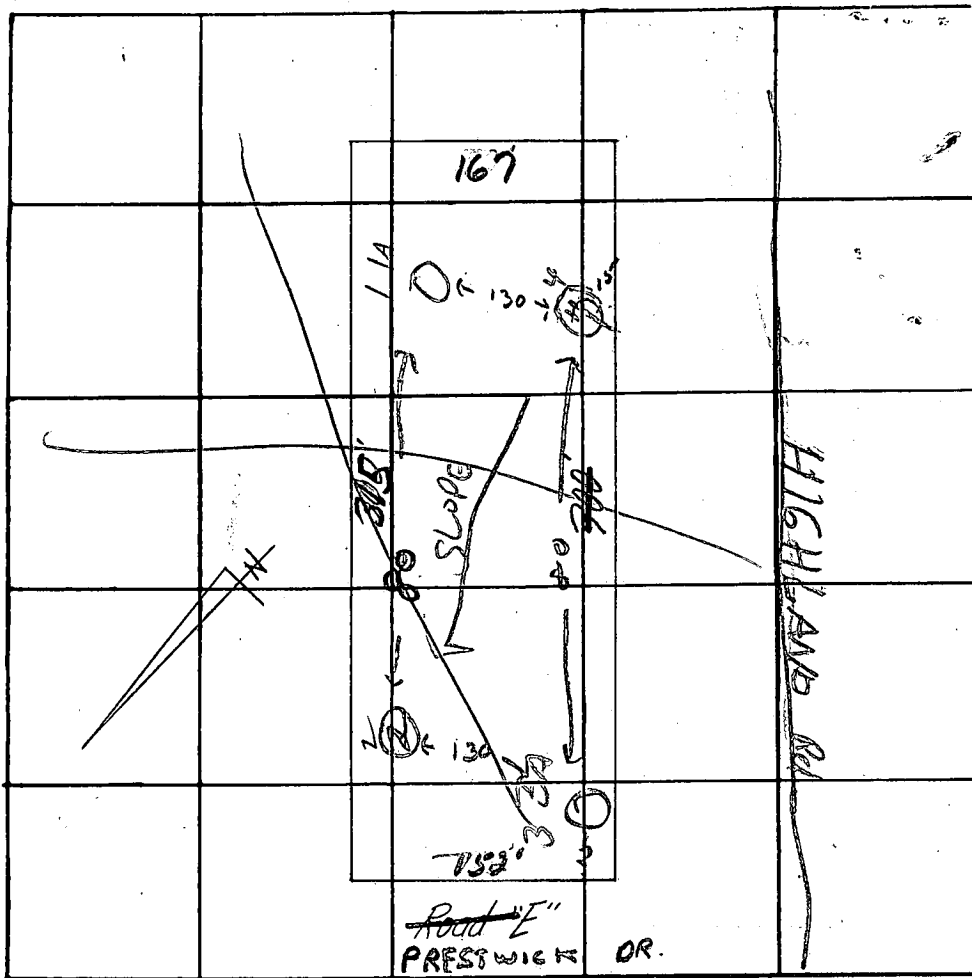

INDICATE NORTH. - NAME ADJOINING ROADWAY AS BASE LINE.

~~Lot 185~~
~~# 24~~
 Part of
23

DATE	TEST NO.	DEPTH	PRE-WET		TEST - 1" DROP		TIME
			START	STOP	START	STOP	
	1	11 1/2'	226	228	228	233	5
	1A	4'	228	230	230	245	15
	2	10'	SANDY	OK			
	3	5'	223	225	225	230	3
	3A	11'	224	226	226	231	6
	4	10 1/2'	SANDY	SOIL OK			

25
 15
 5
 6
 31
 4131
 8 min
 Under 4'

REMARKS CERTIFY ALL HOLES

TYPE OF SOIL _____

TESTED BY _____ ALSO PRESENT: _____

LOT 23 SECTION 1
HARRIS LAKE
HOWARD CO.

SCALE: 1" = 30'

PROPOSED FENCE
SCUMMER

PROPOSED POOL

4/16/84
Sketch OK for
S.S.

10,000
SEAL. ELEVATION
FULL

U.S. PATENT CO.

RESIDENCE


Proctor
Rt 216
Hobbs
Rd.

Pierce

Rt 32

1000
ft

22

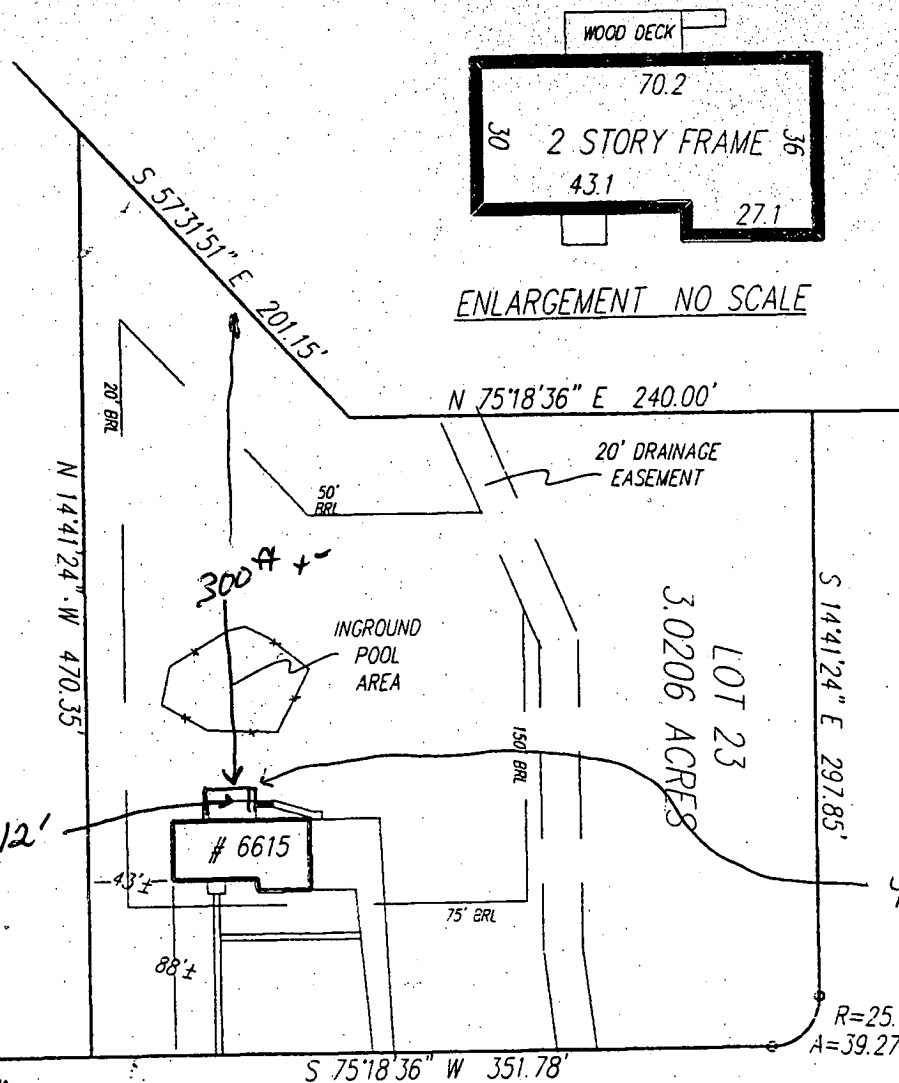

PRESTWICK DRIVE
(60' R\W)

800 141 507

This is to certify that I have surveyed the property known as LOT 23 6615 PRESTWICK DRIVE sheet of recorded PLAT NO. 3810 among the Land Records of Howard County, Maryland for the purpose of locating the improvements thereon.

SUBJECT PROPERTY IS SHOWN IN ZONE C ON THE NATIONAL FLOOD INSURANCE PROGRAM FLOOD INSURANCE RATE MAP OF HOWARD COUNTY, MARYLAND. PANEL # 32 OF 45 COMMUNITY PANEL # 240044-0032B EFFECTIVE DATE: DECEMBER 4, 1986

LOCATION SURVEY
6615 PRESTWICK DRIVE
HIGHLAND LAKE
5TH ELECTION DISTRICT
HOWARD COUNTY, MARYLAND

NTT Associates, Inc.

16205 Old Frederick Road
Mt. Airy, Maryland 21771
Ph. (410)442-2031
Fax No. (410)442-1315

Scale: 1"=100'

Date: MARCH 1, 1995

Field By: JLM

Drawn By: JLM

Drawing # 95729ANN

- 1) This location for title purposes only, no title report furnished, not to be used for determining property lines, building fences or other improvements.
- 2) Property corner markers NOT found, or guaranteed by this location.
- 3) B.R.L. information, if shown was obtained from existing record plat or local agencies and is not guaranteed by NTT, INC.
- 4) Building line and/or Flood Zone information is subject to the interpretation of the originator.
- 5) NTT, Inc. does not certify to unshown or unrecorded encroachments or overlaps.