

4/3/81
after 12 noon
please

PERMIT

SEWAGE DISPOSAL SYSTEM

MARYLAND STATE DEPARTMENT OF HEALTH

HOWARD COUNTY

ELLICOTT CITY

DISTRICT 3rd

DATE 3/12/81

INDEXED

Mr. D. Glover

IS PERMITTED TO INSTALL ☒ ALTER

ADDRESS 4334 Louisville Road, Finksburg, Maryland 21048

PHONE

SUBDIVISION ROAD 1730 Route 32

LOT

PROPERTY OWNER Dr. Nace Buyukunsal

ADDRESS 6850 Sykesville Road, Sykesville, Maryland

SPECIFICATIONS 3 Bedrooms

SEPTIC TANK CAPACITY 1000 GALLONS

DRAIN FIELD DEPTH FEET, BOTTOM AREA SQ. FT.

DEEP TRENCH DEPTH FEET, BOTTOM AREA SQ. FT.

SEEPAGE PITS ☒ ABSORBENT SIDE-WALL AREA 150 SQ. FT. Per bedroom

INLET PIPE 5 FT. BELOW ORIGINAL GRADE. MAXIMUM DEPTH 13 FT. BELOW ORIGINAL GRADE

EFFECTIVE DEPTH AT FT. BELOW ORIGINAL GRADE.

LOCATE DISPOSAL AREA 71 FT. FROM Back LOT LINE AND 20 FT. FROM left LOT LINE AS SEEN WHEN

FACING LOT FROM Rt. 32.

Okay to add a ditch off dry well to obtain necessary absorbent area if needed.

LEAVE 5 FT. EARTH BUFFER BETWEEN TRENCH AND DRY WELL. TRENCH TO FOLLOW CONTOUR OF THE LAND. Call for 2 inspections before and after gravel is installed.

3/30/81 FF SAID CHANGE SPES TO ONLY 11 FT DEEP

SUGGEST AN 5 FT SQ. DRY WELL 1 FT DEEP WITH

PLANS APPROVED BY Raymond Hodges

DATE 1/28/80

COVER NO WORK UNTIL INSPECTED AND APPROVED.

A - DITCH OFF D.W. RID

NEITHER THE HOWARD COUNTY COUNCIL NOR THE HEALTH DEPARTMENT IS RESPONSIBLE FOR THE SUCCESSFUL OPERATION OF ANY SYSTEM.

NOTE: IF TRENCH IS USED CALL FOR INSPECTION BEFORE PLACING GRAVEL IN TRENCH.

NOTE: NO DRY WELL SHALL EXCEED 15 FOOT IN DIAMETER.

NOTE: ALL PIPE FROM HOUSE TO DISPOSAL AREA MUST BE CAST IRON.

PERMIT VOID AFTER THREE YEARS.

NOTE: INSTALL STAND PIPE ON SEPTIC TANK AND DRY WELL. STAND PIPES MUST BE 6 INCHES IN DIAMETER. CAST IRON, CONCRETE OR TERRA COTTA ACCEPTED.

BLDG. PERMIT SIGNED
AND RETURNED 6/24/91
Serial # 38689
Sunwon

*INSTALLER IS RESPONSIBLE FOR OBTAINING FINAL APPROVAL ON THIS PERMIT.


HD - 23

BLDG. PERMIT SIGNED
AND RETURNED 3/13/2002
800 13480
IG POOL 18X36

BLDG. PERMIT SIGNED
AND RETURNED 7/5/84
Serial # 59723
Shed

A 30499

SIDE

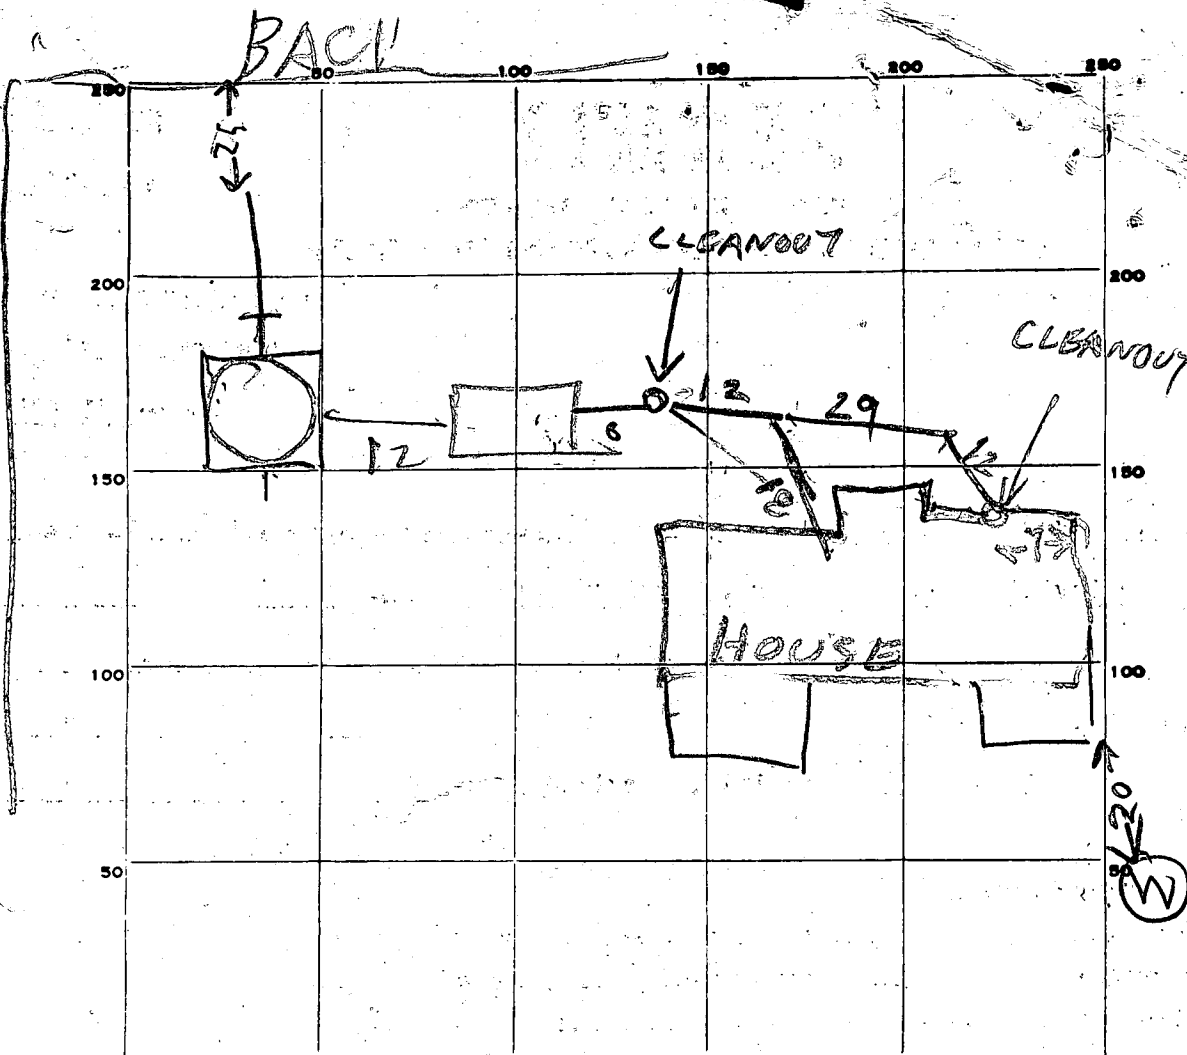

INDICATE NORTH NAME ADJOINING ROADWAY AS BASE LINE

ROUTE 32

PERMIT CARD

SEPTIC TANK, LEVEL OK 1000

CLEANOUTS

ST	DW	SEWER
OK	OK	OK

DISTRIBUTION BOX, LEVEL

TILE FIELD, DEPTH 9 FT. TRENCH WIDTH 3 FT.

GRAVEL DEPTH 4 1/2 IN. TOTAL LENGTH 31 FT.

NUMBER OF TRENCHES 12 TOTAL BOTTOM AREA 139 ONE SIDE

SEEPAGE PITS, INSIDE DIAMETER 62 FT. DEPTH BELOW INLET 7.5 FT.

ABSORBENT AREA 465 SQ. FT.

REMARKS 4/3/81 - DW INLET 4 1/2 FT B.O.G. DITCH

INLET 4 FT B.O.G BUT LOWER THAN DW INLET

604 SQ FT DW & DITCH TOTAL

450 SQ FT REQUIRED

DATE SYSTEM APPROVED

4/3/81

INSPECTOR

Raymond Hodge

APPLICATION

A 22856

P _____

SEWAGE DISPOSAL TESTING

STATE OF MARYLAND - DEPARTMENT OF HEALTH AND MENTAL HYGIENE

HOWARD COUNTY HEALTH DEPARTMENT
ENVIRONMENTAL HEALTH SERVICES

DISTRICT 3

P. O. BOX 476, ELLICOTT CITY, MARYLAND 21043
TELEPHONE: 465-5000, EXT. 356

DATE 2/23/76

2/27/76
9:30
Recorded

3 B.R. 1000 gal. septic tank | 4 B.R. 1250 gal. septic tank

Drywell & trench system to have 180 sq. ft. effective sidewall absorption area per bedroom to begin below the first 4 1/2 ft. of non-porous soil. Maximum depth permitted for system is 11 1/2 ft. below original grade. Place the drywell 105 ft. from the front lot line and 25 ft. from the left side line, as seen when facing the property from Rte 32. Start the trench after a 5 ft. earth buffer and run it on level ground the necessary distance. NOTE: Call for inspection of trench before gravel is installed.

TO: THE COUNTY HEALTH OFFICER
ELLICOTT CITY, MARYLAND

I, HEREBY, APPLY FOR THE NECESSARY TEST IN ORDER TO CONSTRUCT (OR RECONSTRUCT) A SEWAGE DISPOSAL SYSTEM.

PROPERTY OWNER State Roads Commission HARRY SANDOSKY, Sr. Serial No. 42009ADDRESS 2566 Main Street, Sykesville, Md 21784 PHONE Sandusky Cont. 795-2510PROPERTY LOCATION: HOUSE TORN DOWN

SUBDIVISION _____ LOT NO. _____

ROAD AND DESCRIPTION Route 32 - ~~pink house~~ approx. 2nd house on left past
Old Frederick Road - sits up on high bank - almost
on road)SIZE OF LOT 0.973 acres TYPE BLDG. Old house to be torn down
3 or 4IF NOT SINGLE RESIDENCE DESCRIBE _____
(Single Fmly. Dwllg.)


THE SYSTEM INSTALLED UNDER THIS APPLICATION IS ACCEPTABLE ONLY UNTIL PUBLIC FACILITIES BECOME AVAILABLE.

SIGNATURE OF APPLICANT /s/ W. R. HansenAPPROVED BY Frank Skinner FOR drywell & trench DATE 7/13/76
(KIND OF SYSTEM)REJECTED BY _____ FOR _____ DATE _____
(KIND OF SYSTEM)

HOLD PENDING FURTHER TESTS _____ DATE _____

REASONS FOR REJECTION OR HOLDING 3/1/76 Perc O.K. F.R.S.

THIS IS NOT A PERMIT

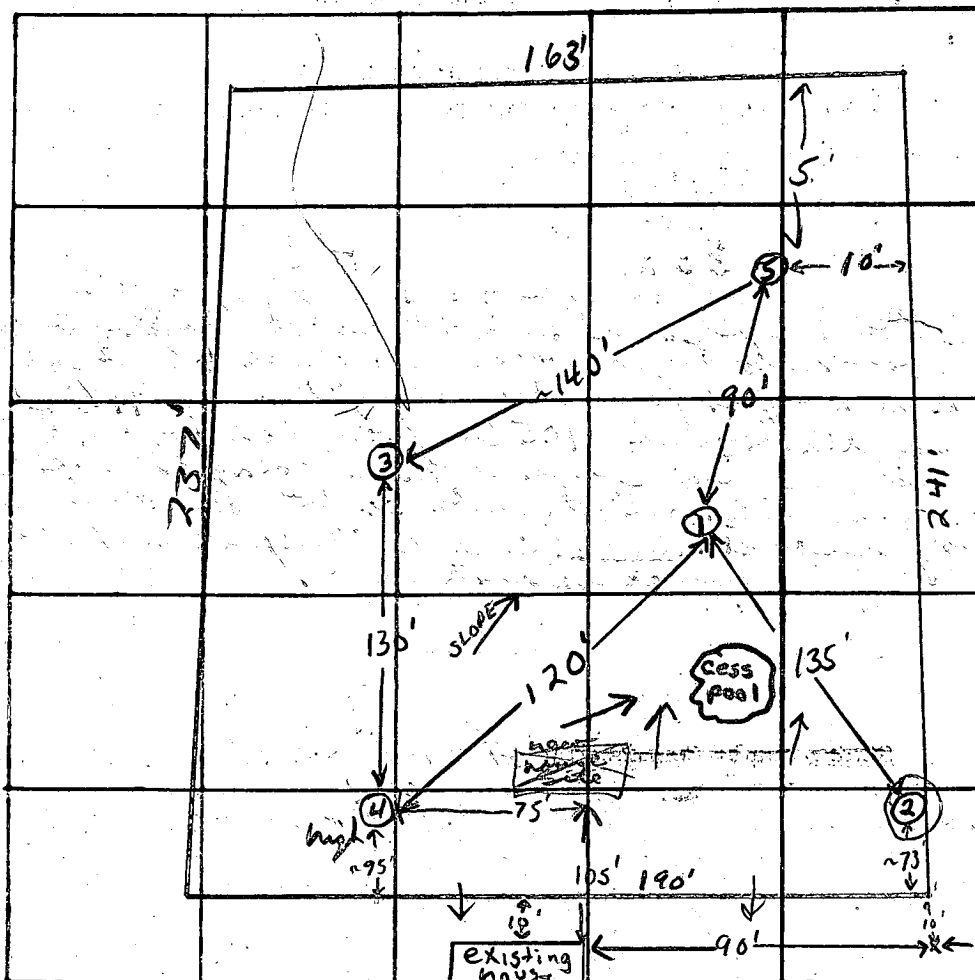

INDICATE NORTH. NAME ADJOINING ROADWAY AS BASE LINE.

Rte. 32

DATE	TEST NO.	DEPTH	PRE-WET START	PRE-WET STOP	TEST - 1" DROP START	TEST - 1" DROP STOP	TIME
2/27/76	1	5'	12:11	12:14	12:19	12:29	10min
	1A	13'	10:24	10:38	10:38	11:00	22min
	2	12 1/2'	11:09	11:32	11:32	pulled plug 12:07 3/4" drop	
	2A	11 1/2'	12:35	12:55	12:55	pulled plug 1:30 1/2" drop	
	3	12 1/2'	11:45	11:55	11:55	12:15	20min
	3A	5 1/2'	12:50	1:25	no time		
	3B	6 1/2'	1:48	2:08	2:08	2:28	20min
	4 high	6'	1:18	1:21	1:21	1:28	7min
	4A	12 1/2'	1:39	1:47	1:47	2:05	18min
	5 low	12'	Clay to 4', silty sandy loam below				

REMARKS

1' to 2' drop from (4) to (3); (4) porous at ~4 1/2'

TYPE OF SOIL

silty loam below top 5' clay & clay loam

TESTED BY

F.S.

ALSO PRESENT:

R. Tresselt, Hanson & Son

APPLICATION

SEWAGE DISPOSAL TESTING

STATE OF MARYLAND - DEPARTMENT OF HEALTH AND MENTAL HYGIENE

A 30499

P

HOWARD COUNTY HEALTH DEPARTMENT
ENVIRONMENTAL HEALTH SERVICES

P.O. BOX 476 ELLICOTT, MARYLAND 21043
TELEPHONE: 992-2330

3BR 1000 GAL
4BR 1250 GAL

DISTRICT

3rd

DATE 1/22/80

DRY WELL 150 SQFT SIDEWALL

AREA PER BEDROOM

DRY WELL INLET TO BE 5 FT DEEP

" " BOTTOM TO BE 13 FT DEEP

PLACE D.W. 71 FT FROM THE BACK LOT

TO: THE COUNTY HEALTH OFFICER LINE 8 20 FT FROM THE LEFT
ELLICOTT CITY, MARYLAND

I HEREBY APPLY FOR THE NECESSARY TEST IN ORDER TO CONSTRUCT (OR RECONSTRUCT) A SEWAGE DISPOSAL SYSTEM.

WHEN FACING THE LOT FROM RT 32

PROPERTY OWNER

Harry Sandosky, Jr.

DR. BYYUKUNSAI

795-2130

6850 Sykesville Road, Sykesville, Md. or 795-5060

ADDRESS

7566 Main Street, Sykesville, Md.

PHONE

Sandosky Contractors

795-2510

PROPERTY LOCATION:

OK TO ADD A DITCH OFF DW TO OBTAIN NECESSARY ABSORBENT

BURNT DOWN AREA IF NEEDED

SUBDIVISION

1730

LOT NO.

ROAD AND DESCRIPTION

Route 32 - (pink house approx. 2nd house on left past Old Frederick Road-

sits up on high bank-almost on road).

SIZE OF LOT

0.973 acres

TYPE BLDG.

3 or 4 bedrooms

THE SYSTEM INSTALLED UNDER THIS APPLICATION IS ACCEPTABLE ONLY UNTIL PUBLIC FACILITIES BECOME AVAILABLE.

I FULLY UNDERSTAND THE FEE CONNECTED WITH THE FILING OF THIS PERC TEST APPLICATION IS NON-REFUNDABLE UNDER

ANY CIRCUMSTANCES.

BLDG. PERMIT SIGNED

AND RETURNED

4/9/80

SIGNATURE OF APPLICANT

APPROVED BY

Raymond A. Hodges

FOR

DRY WELL

DATE

1/22/80

REJECTED BY

FOR



DATE

HOLD PENDING FURTHER TESTS

DATE

REASONS FOR REJECTION OR HOLDING

THIS IS NOT A PERMIT

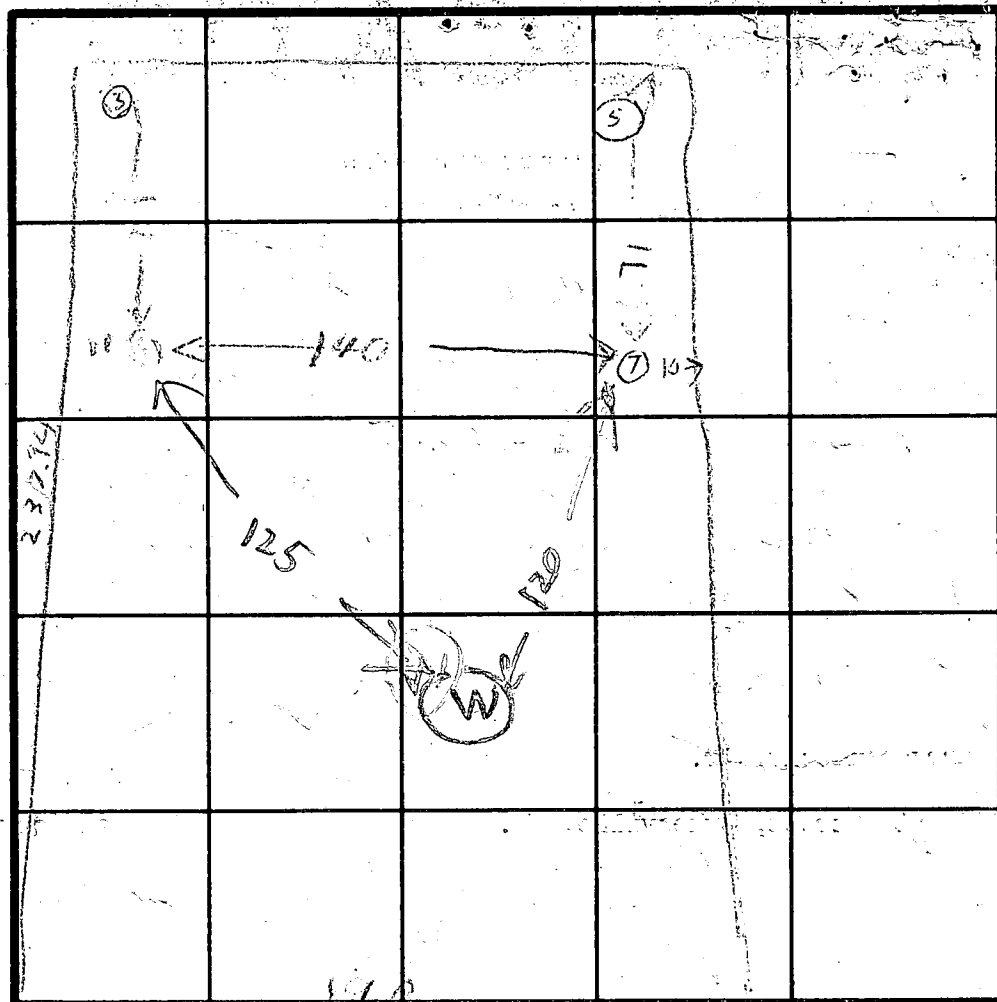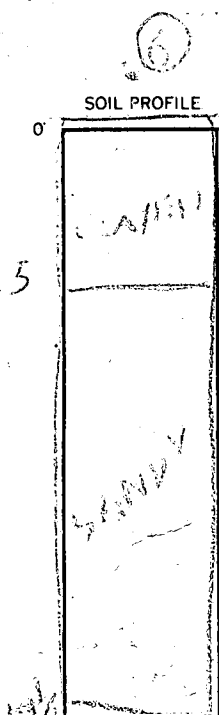

INDICATE NORTH NAME ADJOINING ROADWAY AS BASE LINE

ROUTE 32

DATE	TEST NO.	DEPTH	PRE-WET		TEST - 1" DROP		TIME
			START	STOP	START	STOP	
11/11/11	B/M	8 1/2	216	324	224	230	1.1
	6 S	4	221	302	LITTLE B. RE		
	6V	12 1/2	SEE	SOIL	PROFILE		
	7M	9	255	303	303	310	1
	7S	4 1/2	257	303	303	310	7
	7V	12	TOP	311	CERTIFIED		
			BOT	311	SANDY DR		
	6LV	14 1/2	SEE	SOIL	PROFILE		
	6ES	3 1/2	322	325	322	325	1.1

REMARKS

TYPE OF SOIL

TESTED BY B. HODGES

PACKING REINHARDT

ALSO PRESENT

SANDY KEY


COPY TO REIN HODGES

LEON A. PODOLAK AND ASSOCIATES

SURVEYING AND CIVIL ENGINEERING

63 EAST MAIN STREET, P.O. BOX 266
WESTMINSTER, MARYLAND 21157
TELEPHONES: WESTMINSTER 848-2229 BALTIMORE 876-1226

SYDNEY RICHMAN
LIBER 259 FOLIO 580

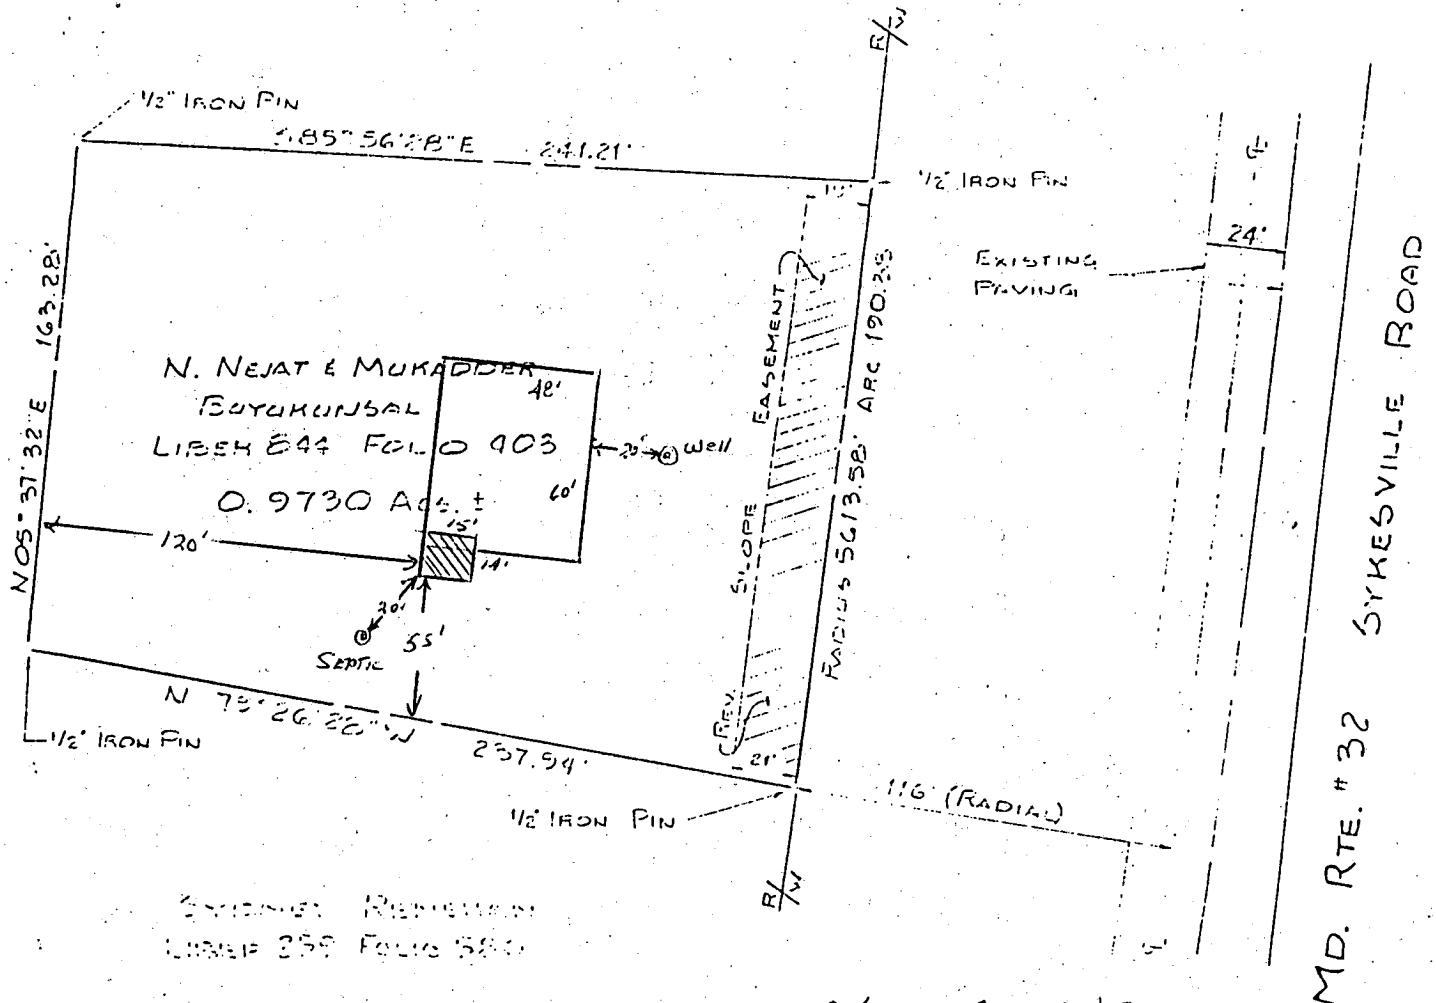

SYDNEY RICHMAN
LIBER 259 FOLIO 580

CURVE DATA
RAD. - 5613.58'
ARC. - 190.35'
TAN. - 95.20
CHORD - 190.37
BEARING - S 06° 50' 53" W

PLANS 012
6/26/91 - RH
OUTLINE SURVEY
OF
N. NEJAT BUYUKUNSAI
PROPERTY

ON MD. RTE. 32 NEAR SYKESVILLE
3rd ELECT. DIST. HOWARD COUNTY



Leon A. Podolak

LEON A. PODOLAK PROF. L.S. # 4793


SCALE: 1" = 60'
DATE: AUGUST 13, 1979

4471

C 1	2998	SEQUENCE NO. (WRA USE ONLY)	STATE OF MARYLAND WATER RESOURCES ADMINISTRATION TAWES STATE OFFICE BLDG., ANNAPOLIS, MD. 21401		THIS REPORT MUST BE SUBMITTED WITHIN 30 DAYS AFTER WELL COMPLETION
1 2 3 (SEQ. NO.) 6		WELL COMPLETION REPORT		FILL IN THIS FORM COMPLETELY	
DATE RECEIVED (WRA USE ONLY) 3/20/80		DEPTH OF WELL 180		PERMIT NO. FROM "PERMIT TO DRILL WELL" 40-73-3318	
DATE WELL COMPLETED 8-13-81		22 (TO NEAREST FOOT) 26		28 29 30 31 32 33 34 35 36 37	
OWNER SANDOCKY HARRY		STREET OR RFD MAIN ST.		POST OFFICE SYKESVILLE 21784	
WELL DESCRIPTION					
WELL LOG					
STATE THE KIND OF FORMATIONS PENETRATED, THEIR COLOR, DEPTH, THICKNESS AND IF WATER BEARING					
DESCRIPTION (USE ADDITIONAL SHEETS IF NECESSARY)	FEET FROM	TO	CHECK IF WATER BEARING		
topsoil	0	2			
Red clay	2	5			
brown shale	5	23			
brown slate	23	55			
sandstone	55	63			
brown slate	63	80			
sandstone	80	86			
mica	86	89			
sandstone	89	93			
mica	93	96			
Quartz	96	97			
sandstone	97	99			
mica	99	124			
sandstone	124	130			
mica	130	180			
GROUTING RECORD					
WELL HAS BEEN GROUTED (CIRCLE APPROPRIATE BOX) YES ☒ NO ☐					
TYPE OF GROUTING MATERIAL (CIRCLE BOX): CEMENT ☒ BENTONITE CLAY ☐					
NO. OF BAGS 24 NO. OF POUNDS 2400					
GALLONS OF WATER 120					
DEPTH OF GROUT SEAL (TO NEAREST FOOT)					
FROM 0 FT. TO 64 FT. (ENTER 0 IF FROM SURFACE)					
CASING RECORD					
CASING TYPES: INSERT APPROPRIATE CODE BELOW					
STEEL ☐ CONCRETE ☐					
PLASTIC ☐ OTHER ☐					
MAIN CASING TYPE 5 NOMINAL DIAMETER TOP (MAIN) CASING (NEAREST INCH) 6 TOTAL DEPTH OF MAIN CASING (NEAREST FOOT) 91					
OTHER CASING (IF USED)					
DIAMETER (INCH) DEPTH (FEET) FROM TO					
SCREEN TYPE OR OPEN HOLE: INSERT APPROPRIATE CODE BELOW					
STEEL ☐ BRASS OR BRONZE ☐ OPEN HOLE ☐					
PLASTIC ☐ OTHER ☐					
SCREEN RECORD					
C 2 (SEQ. NO.) 6					
DEPTH (NEAREST WHOLE FOOT) FROM 89 TO 180					
1 2 3 100					
SLOT SIZE 1. 2. 3.					
DIAMETER OF SCREEN 56 (NEAREST INCH) FROM 56 TO 60					
GRAVEL PACK					
IF WELL DRILLED, WAS A FLOWING WELL? CIRCLE BOX 68 ☐					
WRA USE ONLY (NOT TO BE FILLED IN BY DRILLER) (E.R.O.S.) W.O.					
70 71 72 73 74 75 76 77 78 79 80 81 82 83 84 85 86 87 88 89 90 91 92 93 94 95 96 97 98 99 100					
TELESCOPE CASING LOG INDICATOR OTHER DATA AVAILABLE					
PUMPING TEST					
HOURS PUMPED (TO NEAREST HOUR) 2					
PUMPING RATE (GALLONS PER MINUTE TO NEAREST GALLON) 4					
METHOD USED TO MEASURE PUMPING RATE bucket					
WATER LEVEL: (DISTANCE FROM LAND SURFACE)					
BEFORE PUMPING 40 (NEAREST FOOT) 17 20					
WHEN PUMPING 180 (NEAREST FOOT) 22 25					
TYPE OF PUMPED USED (CIRCLE APPROPRIATE BOX) (FOR PUMPING TEST)					
AIR ☐ PISTON ☐ TURBINE ☐					
CENTRIFUGAL ☐ ROTARY ☐ OTHER (DESCRIBE BELOW) ☐					
JET ☐ SUBMERSIBLE ☐					
PUMP INSTALLED					
TYPE OF PUMP (WRITE APPROPRIATE LETTER IN BOX - SEE ABOVE: A, C, J, P, R, S, T, O) 29					
DRILLER WILL INSTALL PUMP (CIRCLE APPROPRIATE BOX) YES ☐ NO ☐					
CAPACITY: GALLONS PER MINUTE (TO NEAREST GALLON) 31 35					
PUMP HORSE POWER 37 41					
PUMP COLUMN LENGTH (NEAREST FOOT) 43 47					
CASING HEIGHT: (CIRCLE APPROPRIATE BOX AND ENTER CASING HEIGHT)					
ABOVE ☐ BELOW ☐ LAND SURFACE 2 (NEAREST FOOT) 49 50 51					
LOCATION OF WELL ON LOT					
SHOW PERMANENT STRUCTURE SUCH AS BUILDINGS, SEPTIC TANKS, AND/OR OTHER LAND MARKS AND INDICATE NOT LESS THAN TWO DISTANCES (MEASUREMENTS TO WELL).					
CIRCLE APPROPRIATE BOXES					
A A WELL WAS ABANDONED AND SEALED WHEN THIS WELL WAS COMPLETED					
E ELECTRIC LOG OBTAINED					
P TEST WELL CONVERTED TO PRODUCTION WELL					
I HEREBY CERTIFY THAT I HAVE COMPLIED WITH ALL CONDITIONS STATED ON THE ABOVE-CAPTIONED "PERMIT TO DRILL WELL", AND THAT INFORMATION CONTAINED IN THIS REPORT IS TRUE, ACCURATE, AND COMPLETE TO THE BEST OF MY KNOWLEDGE, INFORMATION AND BELIEF.					
DRILLERS NAME					
(PLEASE PRINT) GEORGE F. EASTERDAY					
SIGNATURE Jimmy M. Easterday					

Henry Soudersky 4)

NORTH

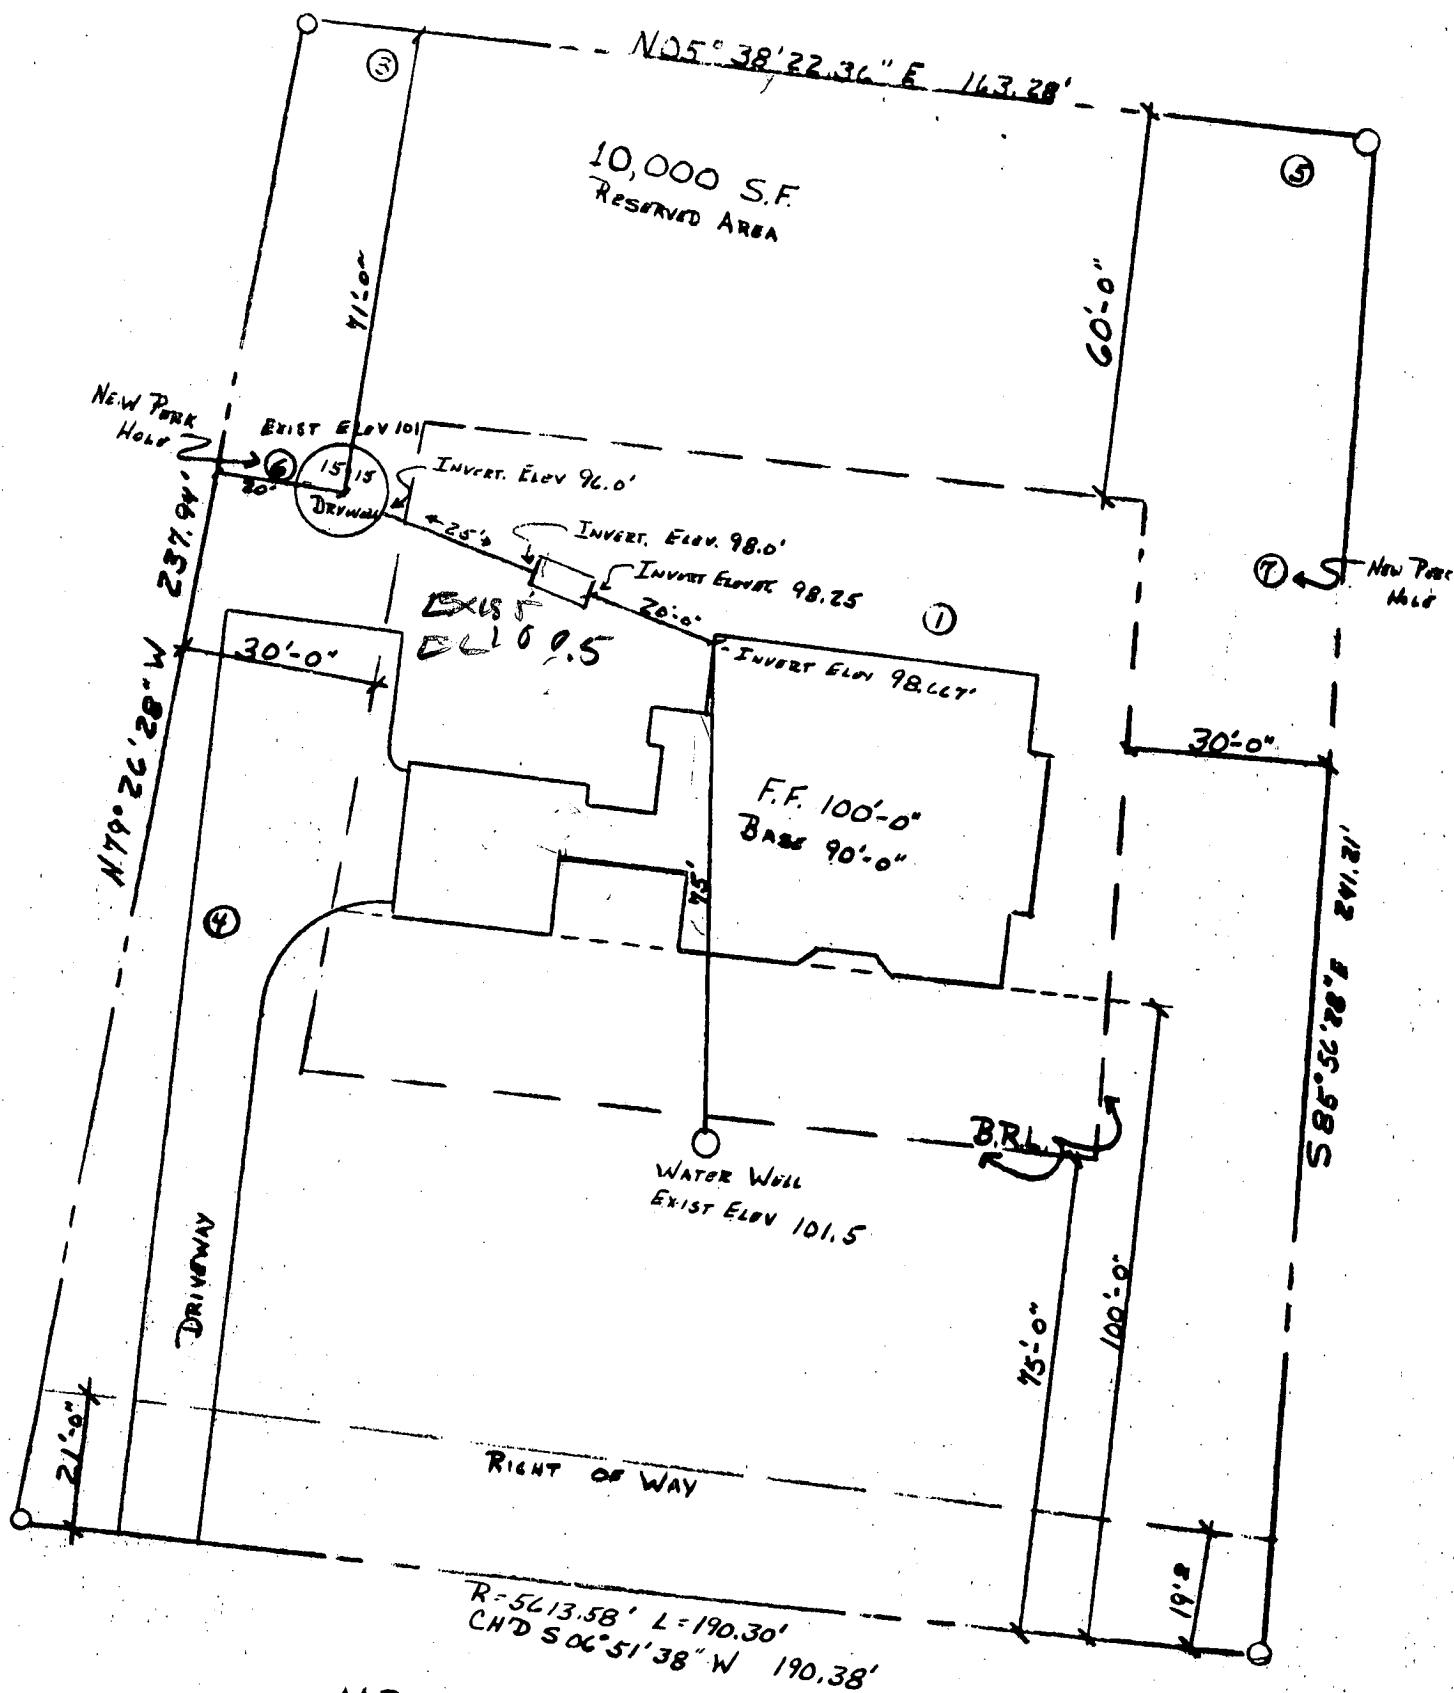

MD. RTE. 32

SITE PLAN

SCALE : $\frac{1}{30} = 1' \frac{0}{2}$

DR. BUYUKUNSAI
HOWARD CO., MD.

RH SAID PLANSOR / 15180 JIM SAID
PLANSOR 2/21/80

DEPARTMENT OF INSPECTIONS, LICENSES AND PERMITS
3430 COURT HOUSE DRIVE
ELLICOTT CITY, MD 21043
PERMITS (410)313-2455 INSPECTIONS (410)313-1810
AUTOMATED INFORMATION (410) 313-3800

HOWARD COUNTY
PERMIT APPLICATION

PERMIT NUMBER
B0034801

Building Address 1730 West Friendship Rd.
Sykesville MD 21784
Suite/Apt. #: _____ SDP/WP/Petition #: _____
Census Tract _____ Subdivision _____
Section _____ Area _____ Lot _____
Tax Map _____ Parcel _____ Grid _____
Zoning _____ Map Coordinates SAS Lot size _____

Property Owner's Name Mike & Pam Allen
Address 1730 West Friendship Rd.
City Sykesville State MD. Zip Code 21784
Home Phone 410-442-3744 Work Phone 410-655-8836
Applicant's Name & Mailing Address, (if other than stated hereon): _____
Phone _____ Fax _____

Existing Use SFD
Proposed Use Same
Estimated Construction Cost \$ 23,000
Description of Work INSTALL A 18x36 inground
concrete pool 3'-6" x 6'-0" DEPLETED
FLY BY TRUCK

Contractor Company Custom Pools by McDade
Contact Person Sam Hall
Address 21305 Ridge Rd.
City Freeland State MD. Zip Code 21053
License No. 33824
Phone 410-329-6415 Fax 410-329-2217

Occupant or Tenant _____
Contact Name _____
Address _____
City _____ State _____ Zip Code _____
Phone _____ Fax _____

Engineer or Architect Company _____
Contact Person _____
Address _____
City _____ State _____ Zip Code _____
Phone _____ Fax _____

BUILDING DESCRIPTION - <u>COMMERCIAL</u>		BUILDING DESCRIPTION - <u>RESIDENTIAL</u>	
<u>Building Characteristics</u> Height: _____ No. of stories: _____ Gross area, sq. ft. per floor: _____ Use group: _____ Construction type: ____ Reinforced Concrete ____ Structural Steel ____ Masonry ____ Wood Frame ____ State Certified Modular	<u>Utilities</u> Water Supply: ____ Public ____ Private Sewage Disposal: ____ Public ____ Private Electric Yes ☐ No ☐ Gas Yes ☐ No ☐ Heating System: Electric ☐ Oil ☐ Natural Gas ☐ Propane Gas ☐ Sprinkler system: N/A ☐ ____ Full ____ Partial ____ Other Suppression ____ # of Heads	<u>Building Characteristics</u> SF Dwelling ☒ SF Townhouse ☐ <u>Depth</u> <u>Width</u> 1st floor: _____ 2nd floor: _____ Basement: _____ Finished Basement ☐ Unfinished Basement ☐ Crawl space ☐ Slab on Grade ☐ No. of Bedrooms _____ Multi-family dwellings: No. of efficiency units: _____ No. of 1 BR units: _____ No. of 2 BR units: _____ No. of 3 BR units: _____ Other Structure: _____ Dimensions: _____ Footings: _____ Roof: _____ ____ State Certified Modular ____ Manufactured Home	<u>Utilities</u> Water Supply: ____ Public ☒ Private Sewage Disposal: ____ Public ☒ Private Electric Yes ☐ No ☐ Gas Yes ☐ No ☐ Heating System: Electric ☐ Oil ☐ Natural Gas ☐ Propane Gas ☐ Sprinkler system: N/A ☐ ____ NFPA #13D ____ NFPA #13R ____ Other:

THE UNDERSIGNED HEREBY CERTIFIES AND AGREES AS FOLLOWS: (1) THAT HE/SHE IS AUTHORIZED TO MAKE THIS APPLICATION; (2) THAT THE INFORMATION IS CORRECT; (3) THAT HE/SHE WILL COMPLY WITH ALL REGULATIONS OF HOWARD COUNTY WHICH ARE APPLICABLE THERETO; (4) THAT HE/SHE WILL PERFORM NO WORK ON THE ABOVE REFERENCED PROPERTY NOT SPECIFICALLY DESCRIBED IN THIS APPLICATION; (5) THAT HE/SHE GRANTS COUNTY OFFICIALS THE RIGHT TO ENTER ONTO THIS PROPERTY FOR THE PURPOSES OF INSPECTING THE WORK PERMITTED AND POSTING NOTICES.

Samuel F. Hall
Applicant's Signature
Vice pres. Custom Pools by McDade
Title/Company

SAMUEL F. HALL
Print Name
3-13-02
Date

Checks payable to: **DIRECTOR OF FINANCE OF HOWARD COUNTY**
** PLEASE WRITE NEATLY AND LEGIBLY. **

AGENCY
Land Development, DPZ
State Highways
Building Official
Dev. Engineering, DPZ
Health
Fire Protection
Is Sediment Control approval required prior to issuance?
YES ☐ NO ☐
CONTINGENCY CONSTRUCTION START: ☐
ONE STOP SHOP: ☐

DATE
3/13/02
3/13/02

SIGNATURE APPROVAL
[Signature]
[Signature]

DPZ SETBACK INFORMATION
Front: _____
Rear: _____
Side: _____
Side St. _____
All minimum setbacks met?
YES ☐ NO ☐
Is Entrance Permit required?
YES ☐ NO ☐
Historic District?
YES ☐ NO ☐
Lot Coverage for New Town Zone _____
SDP/Red-line approval date _____


PROPERTY ID# 53860
Filing fee \$ _____
Permit fee \$ 250
Excise tax \$ _____
Add'l per. fee \$ _____
TOTAL FEES \$ 250
Sub-total paid \$ _____
Balance due \$ _____
Check # 4182
Validation # 46521
Accepted by [Signature]

Distribution of Copies: White: Building Official Green: LDD, DPZ Yellow: DED, DPZ Pink: Health Gold: SHA

T:\forms\PERMIT.FRM Rev: 5/17/00

NOTES

1. THIS DRAWING IS OF BENEFIT TO A CONSUMER ONLY INsofar AS IT IS REQUIRED BY A LENDER OR A TITLE INSURANCE COMPANY OR ITS AGENT IN CONNECTION WITH CONTEMPORARY FINANCING OR REFINANCING.
2. THE DRAWING IS NOT TO BE RELIED UPON FOR THE ESTABLISHMENT OF LOCATION OF FENCES, GARAGES, BUILDINGS OR OTHER EXISTING OR FUTURE IMPROVEMENTS.
3. THE DRAWING DOES NOT PROVIDE FOR THE ACCURATE IDENTIFICATION OF PROPERTY BOUNDARY LINES, BUT SUCH IDENTIFICATION MAY NOT BE REQUIRED FOR THE TRANSFER OF TITLE OR SECURING FINANCING OR REFINANCING.
4. ALL BUILDINGS, STRUCTURES AND OTHER IMPROVEMENTS SHOWN HEREON ARE IN APPROXIMATE RELATION TO THE APPARENT BOUNDARY LINES.
5. LEVEL OF ACCURACY OF APPARENT SETBACK DISTANCES - 1:50

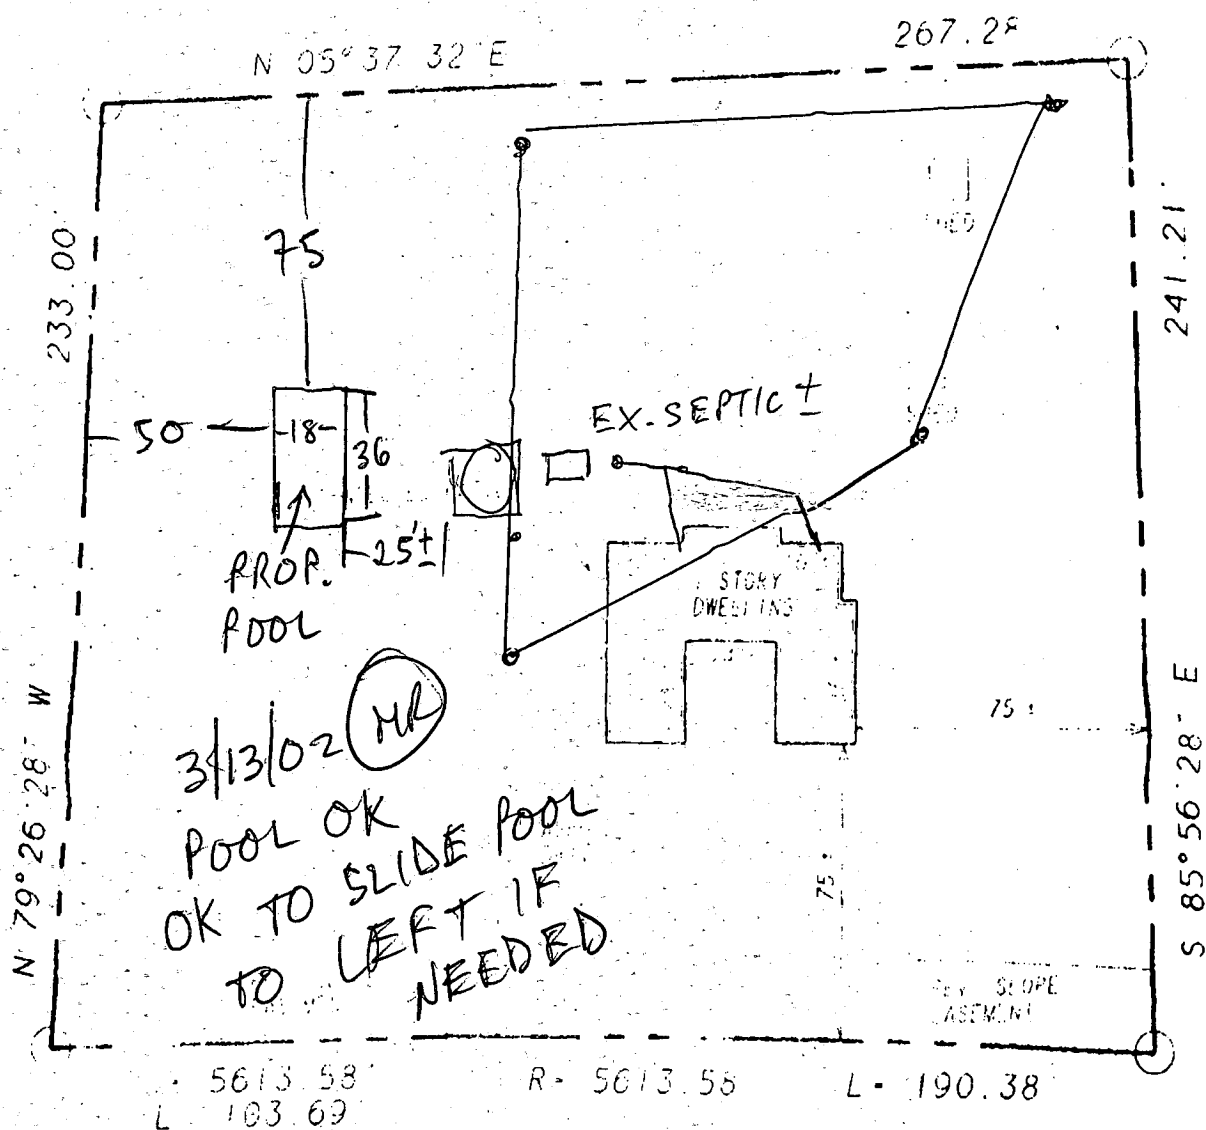

WEST FRIENDSHIP ROAD
ALSO KNOWN AS MD ROUTE 30

I HEREBY CERTIFY TO THE BEST OF MY KNOWLEDGE AND BELIEF THE CHALLENGES SHOWN ON THIS DRAWING LIES WITHIN THE LOT LINES SHOWN AS COMPILED FROM TITLE OR OTHER SOURCES. OTHER IMPROVEMENTS SHOWN ARE FOR PICTORIAL PURPOSES ONLY. THIS DRAWING IS NOT A BOUNDARY SURVEY AND HAS BEEN PREPARED EXCLUSIVELY FOR TITLE PURPOSES ONLY. PREPARED WITHOUT THE BENEFIT OF A TITLE REPORT.

BEING THAT PARCELS 1 & 2 OF GEO. 17 DEED LIBERED IN BOOK 10110 PAGE 710 RECORDED IN THE LAND RECORDS OFFICE OF HOWARD COUNTY, MD.

THIS PARCEL IS NOT IN A FLOOD HAZARD ZONE PER THE FEMA MAPS.

REG NO 505

LOCATION DRAWING

1730 WEST FRIENDSHIP ROAD

HASTINGS SURVEYING

SCALE

1" = 50'

CA

01-06-92