as posite

PERMIT

SEWAGE DISPOSAL SYSTEM

Repair

MARYLAND STATE DEPARTMENT OF HEALTH'

HOWARD COUNTY

INDEXED

ELLICOTT CITY
DISTRICT 5th

DATE 6/2/80

Jack Fyock _IS PERMITTED TO INSTALL___ 13775 Triadelphia Road, Glenelg, Md. 21737 PHONE 988-9270 _____ROAD_Stabean Drive - off LOT 8 Murphy Road - last house on left hand side PROPERTY OWNER____Bob Westland Stabean Drive, Laurel, Md. 20810 SPECIFICATIONS SEPTIC TANK CAPACITY _____GALLONS DRAIN FIELD _____ DEPTH _____ FEET, BOTTOM AREA ___ ___ DEPTH ______ FEET, BOTTOM AREA _____ SQ. FT. _ABSORBENT SIDE-WALL AREA ______ SQ. FT. INLET PIPE _____ FT. BELOW ORIGINAL GRADE. MAXIMUM DEPTH _____ FT. BELOW ORIGINAL GRADE __ FT. BELOW ORIGINAL GRADE. LOCATE DISPOSAL AREA ___ ___ FT. FROM _____ LOT LINE AND _____ FT. FROM _____ LOT LINE AS SEEN WHEN **FACING LOT FROM** REPAIR - Call for an appointment when ground is opened up and Sanitarian will recommend the repair system. Palmer F. Wine PLANS APPROVED BY _ COVER NO WORK UNTIL INSPECTED AND APPROVED.

NEITHER THE HOWARD COUNTY COUNCIL NOR THE HEALTH DEPARTMENT IS RESPONSIBLE FOR THE SUCCESSFUL OPERATION OF ANY SYSTEM.

NOTE: IF TRENCH IS USED CALL FOR INSPECTION BEFORE PLACING GRAVEL IN TRENCH.

NOTE: NO DRY WELL SHALL EXCEED 15 FOOT IN DIAMETER.

E: ALL PIPE FROM HOUSE TO DISPOSAL AREA MUST BE CAST IRON.


PERMIT VOID AFTER THREE YEARS.

NOTE: INSTALL STAND PIPE ON SEPTIC TANK AND DRY WELL. STAND PIPES MUST BE 6 INCHES IN DIAMETER. CAST IRON, CONCRETE OR TERRA

COTTA ACCEPTED.

*INSTALLER IS RESPONSIBLE FOR OBTAINING FINAL APPROVAL ON THIS PERMIT.

A-30705

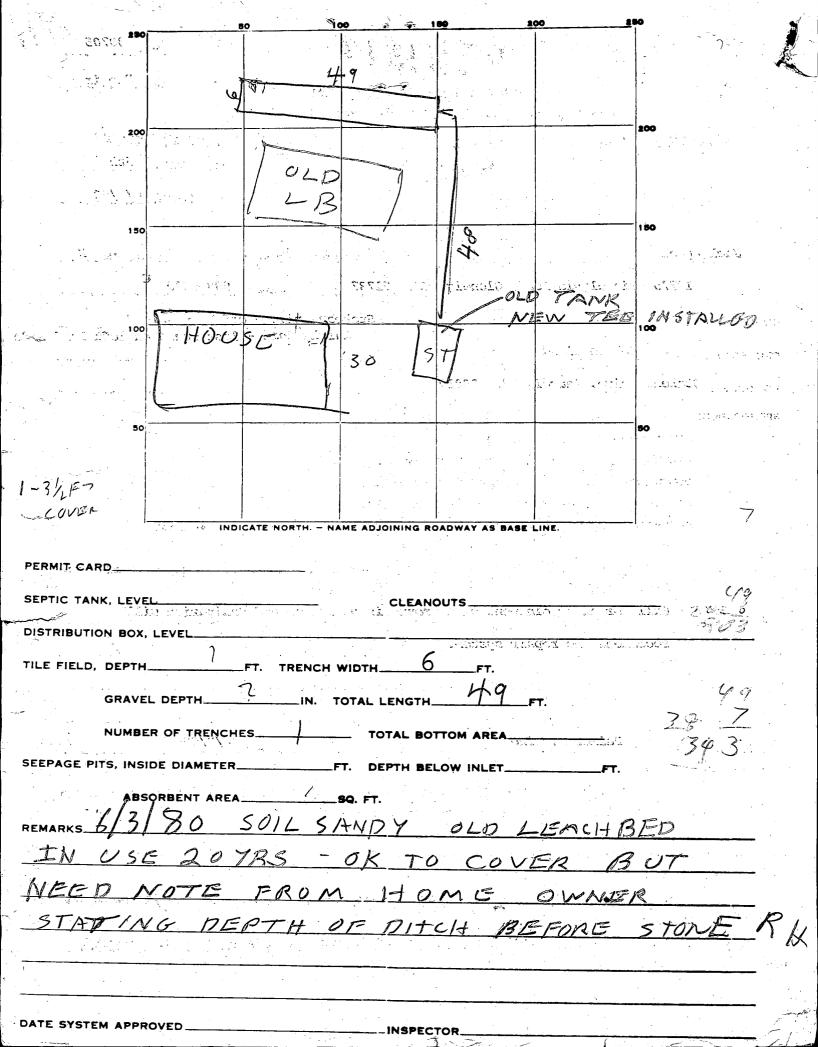

STABEANDE P30705 on Jame 2, 1980, I verified that the trench dug by Jack Typek's employee was 7 feet en depth before gravel was added. Susteme Westlerd 8160 Stabean Dr. Fulton, md.