

# PERMIT

SEWAGE DISPOSAL SYSTEM

MARYLAND STATE DEPARTMENT OF HEALTH

HOWARD COUNTY

ELLICOTT CITY

DISTRICT 4th

DATE 7/1/80

P 30750

A Repair

INDEXED

04-310357

Orville R. Blanton

IS PERMITTED TO INSTALL ALTER 2

ADDRESS 1044 St. Michael's Road, Mt. Airy, Md. 21771 PHONE 831-7910

SUBDIVISION \_\_\_\_\_ ROAD 1044 St. Michaels Road LOT \_\_\_\_\_

PROPERTY OWNER Mr. Orville R. Blanton

ADDRESS same as above

## SPECIFICATIONS

SEPTIC TANK CAPACITY \_\_\_\_\_ GALLONS

DRAIN FIELD \_\_\_\_\_ DEPTH \_\_\_\_\_ FEET, BOTTOM AREA \_\_\_\_\_ SQ. FT.

DEEP TRENCH \_\_\_\_\_ DEPTH \_\_\_\_\_ FEET, BOTTOM AREA \_\_\_\_\_ SQ. FT.

SEEPAGE PITS \_\_\_\_\_ ABSORBENT SIDE-WALL AREA \_\_\_\_\_ SQ. FT.

INLET PIPE \_\_\_\_\_ FT. BELOW ORIGINAL GRADE. MAXIMUM DEPTH \_\_\_\_\_ FT. BELOW ORIGINAL GRADE

EFFECTIVE DEPTH AT \_\_\_\_\_ FT. BELOW ORIGINAL GRADE.

LOCATE DISPOSAL AREA \_\_\_\_\_ FT. FROM \_\_\_\_\_ LOT LINE AND \_\_\_\_\_ FT. FROM \_\_\_\_\_ LOT LINE AS SEEN WHEN

FACING LOT FROM

REPAIR - Call for an appointment when ground is opened up and Sanitarian will

recommend the repair system.

7/3/80

Due to previous tests of 9/13/74 of R.M.

Recommend (1) Trench (A) 50' long, 9' deep with 5' of gravel under pipe; (B) parallel to existing trench not installed in 1975. (C) 1/5' between trenches. 2 inspections of trench before and after stone installed. (2) Place as shown in line off existing tank 5' from

PLANS APPROVED BY Palmer F. Wine

DATE 7/1/80

COVER NO WORK UNTIL INSPECTED AND APPROVED

Cast iron &/or approved plastic to new trench where approved perforated pipe is to be installed.

NEITHER THE HOWARD COUNTY COUNCIL NOR THE HEALTH DEPARTMENT IS RESPONSIBLE FOR THE SUCCESSFUL OPERATION OF ANY SYSTEM.

(\*) NOTE: IF TRENCH IS USED CALL FOR INSPECTION BEFORE PLACING GRAVEL IN TRENCH. C.B.V. See back of permit card @ site.

NOTE: NO DRY WELL SHALL EXCEED 15 FOOT IN DIAMETER.

(\*) NOTE: ALL PIPE FROM HOUSE TO DISPOSAL AREA MUST BE CAST IRON.

PERMIT VOID AFTER THREE YEARS.

NOTE: INSTALL STAND PIPE ON SEPTIC TANK AND DRY WELL. STAND PIPES MUST BE 6 INCHES IN DIAMETER. CAST IRON, CONCRETE OR TERRA

COTTA ACCEPTED.

\*INSTALLER IS RESPONSIBLE FOR OBTAINING FINAL APPROVAL ON THIS PERMIT.


HD - 23

BLDG. PERMIT SIGNED

AND RETURNED 9/5/80

Serial # 43567  
Addition to Bedroom

P-30750

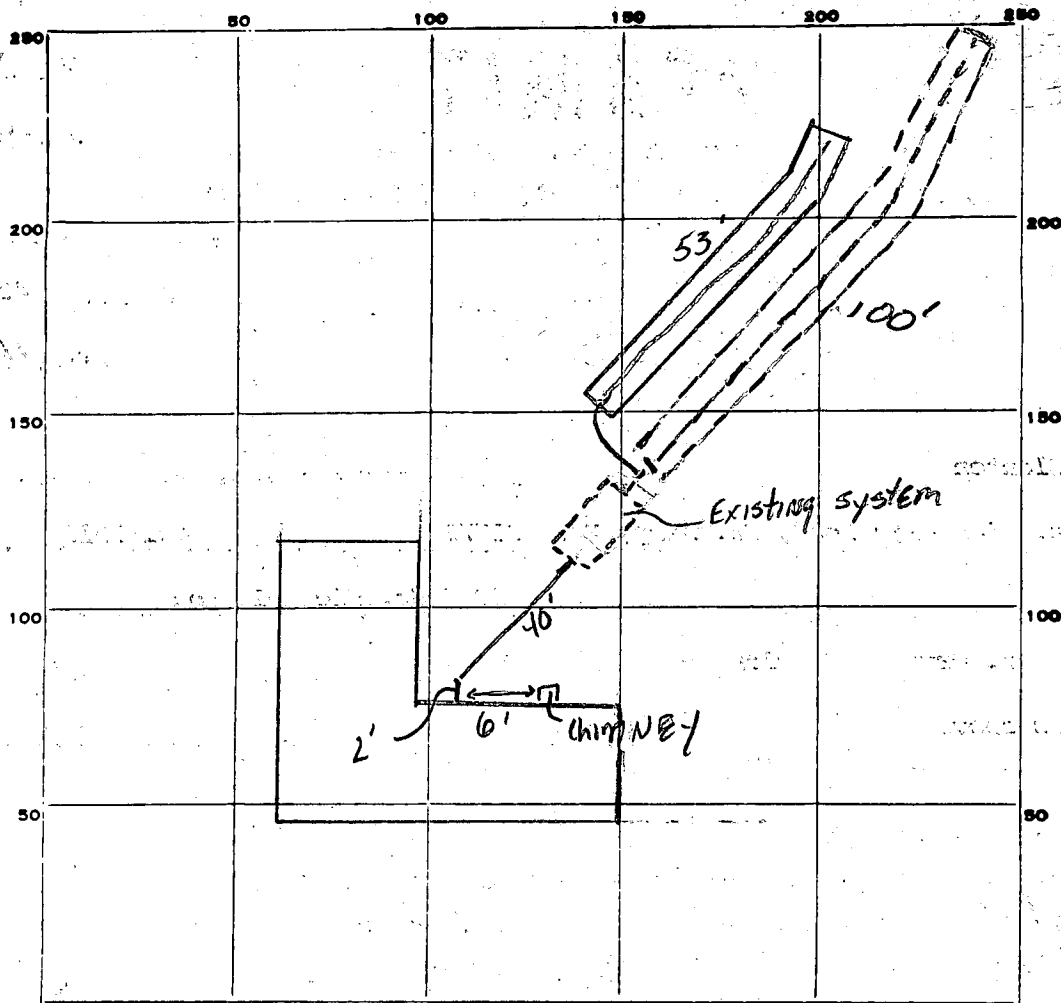

INDICATE NORTH. — NAME ADJOINING ROADWAY AS BASE LINE.

PERMIT CARD ☒

SEPTIC TANK, LEVEL \_\_\_\_\_

CLEANOUTS \_\_\_\_\_

DISTRIBUTION BOX, LEVEL \_\_\_\_\_

TILE FIELD, DEPTH 9' FT. TRENCH WIDTH 2 1/2' FT.

GRAVEL DEPTH 5 IN. TOTAL LENGTH 53 FT.

NUMBER OF TRENCHES 1 TOTAL BOTTOM AREA 265

SEEPAGE PITS, INSIDE DIAMETER \_\_\_\_\_ FT. DEPTH BELOW INLET \_\_\_\_\_ FT.

ABSORBENT AREA 265 SQ. FT.

REMARKS 7/3/80 STOPPED - LEFT INSTRUCTIONS ON CARD FOR REPAIR.

7-11-80 OK To add gravel to trench. GR & S C.B.S. & T.O.

7/15/80 OK to cover all work. JF

DATE SYSTEM APPROVED

7/15/80

INSPECTOR

J. Stager