

4/12/72
PERMIT

SEWAGE DISPOSAL SYSTEM

MARYLAND STATE DEPARTMENT OF HEALTH

HOWARD COUNTY

ELLICOTT CITY

DISTRICT 2nd

DATE 4/1/72

INDEXED
02-234823

Mansco Construction Company

IS PERMITTED TO INSTALL X ALTER

ADDRESS 2111 Rockwell Avenue, Catonsville, Md.

PHONE 788-5767

SEWAGE DISPOSAL SYSTEM LOCATED AT

DIVISION

Holling Bridge

ROAD

5448 Holling Bridge Road

LOT 2

PROPERTY OWNER

William S. Clark

Robert & Sue Palmer

DRESS

SPECIFICATIONS 3 bedrooms

BUDG. PERMIT NO.

AND RETURNED 2/5/72

Serial # 53009

DRAIN FIELD DEPTH FEET, BOTTOM AREA

SQ. FT.

SEEPAGE PITS ABSORBENT SIDE-WALL AREA

SQ. FT.

SEPTIC TANK CAPACITY 1000

GALLONS

FOR GARBAGE GRINDER, INCREASE DISPOSAL AREA 22% & TANK CAPACITY 80%.

OTHER DRY WELL-450 sq. feet sidewalk area below the inlet with the inlet installed

5 feet below original grade and the bottom of the dry well installed 11 feet

below original grade. Place the dry well 25 feet from the back lot line and 75

feet from the right side of the lot as seen when facing the lot from Old Frederick

Road. Reserve another area for a future dry well. Place this area 30 feet from the

back lot line and 67 feet from the right side of the lot as seen when facing the lot

from Old Frederick Road. If water is encountered, stop work right away and call the

Health Department.

NOTE: ALL PIPE FROM HOUSE TO DISPOSAL AREA MUST BE CAST IRON. PERMIT VOID AFTER

THREE YEARS.

DATE 4/13/72

SEPTIC TANK AND DISTRIBUTION BOX WITH WATER BEFORE CALLING FOR AN INSPECTION. COVER NO WORK

UNTIL INSPECTED AND APPROVED.

NOTE: INSTALL STAND PIPES ON SEPTIC TANK AND DRY WELL. STAND PIPES MUST BE 6 INCHES

OTHER THE HOWARD COUNTY COMMISSIONERS NOR THE HEALTH DEPARTMENT IS RESPONSIBLE FOR THE

UNSUCCESSFUL OPERATION OF ANY SYSTEM.

IN DIAMETER. CAST IRON, CONCRETE OR TERRA COTTA ACCEPTED.

BUDG. PERMIT SIGNED

AND RETURNED 4/1/72

Serial # 17533


BP # 22241
storage shed

garage & patio
enclosure

ALC/182

25523

Rolling Ridge Ct

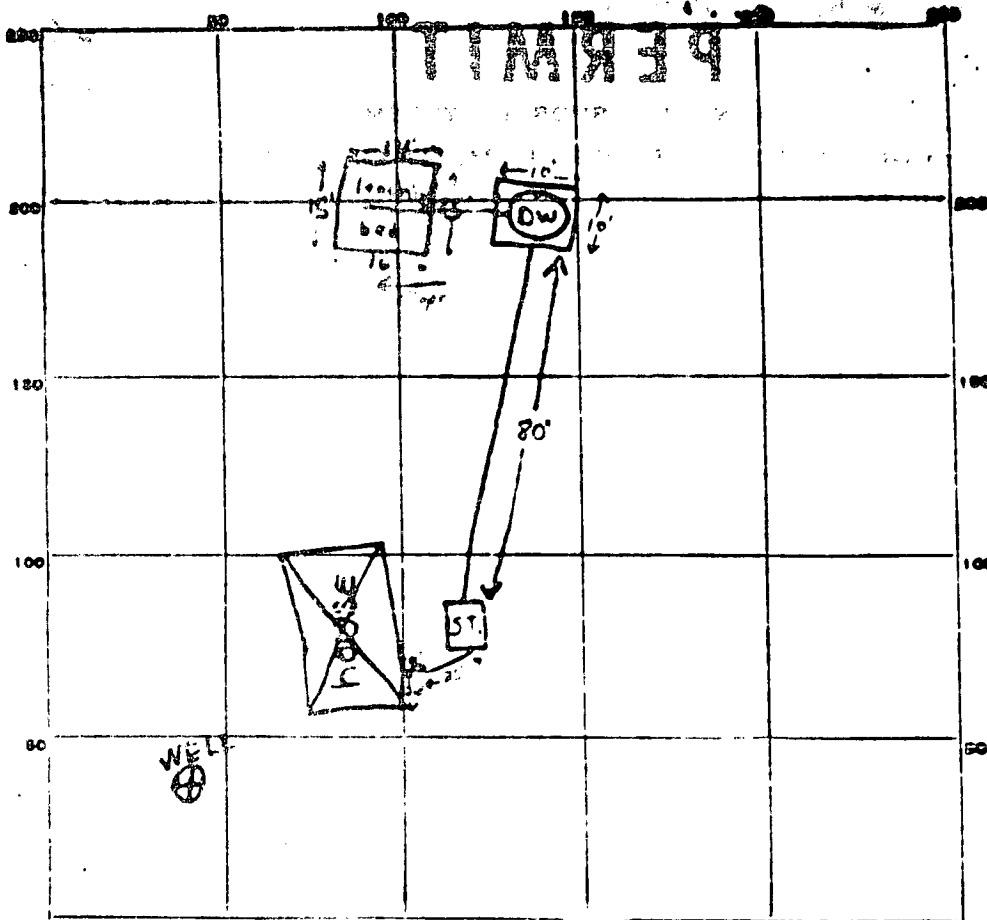

INDICATE NORTH - NAME ADJOINING ROADWAY AS BASE LINE

PERMIT CARD

✓ Squid pump call work

SEPTIC TANK, LEVEL

✓ 100'

CLEANOUTS

ST	D.W.
✓	✓

DISTRIBUTION BOX, LEVEL

100'

TILE FIELD, DEPTH

8

FT. TRENCH WIDTH

~15

FT.

GRAVEL DEPTH

4

IN.

TOTAL LENGTH

~15

FT.

NUMBER OF TRENCHES

1

TOTAL SIDEWALL

TOTAL BOTTOM AREA

240

240
240

SEEPAGE PITS, INSIDE DIAMETER

40

FT.

DEPTH BELOW INLET

6

FT.

ABSORBENT AREA

480

SG. FT.

REMARKS

1. 15' x 15' leach bed near house with 15' x 15' x 2' leaching bed to be installed - 3' to 4' gravel below pipe, drainage - 4/12/77 note per for leaching bed - 15' x 15' x 2' 4/12/77 D.K. - location 4' from

APPROVED

4/12/77

INSPECTOR

Frank Skinner

APPLICATION

SEWAGE DISPOSAL TESTING

MARYLAND STATE DEPARTMENT OF HEALTH

HOWARD COUNTY

ELLICOTT CITY

DISTRICT 2

DATE 7/29/71

TO: THE COUNTY HEALTH OFFICER
ELLICOTT CITY, MARYLAND

I, HEREBY, APPLY FOR THE NECESSARY TESTS IN ORDER TO CONSTRUCT (OR RECONSTRUCT) A SEWAGE DISPOSAL SYSTEM.

PROPERTY OWNER Eugene G. Seybold

ADDRESS 2400 Frederick Road, Baltimore, Md. 21228 PHONE 744-4541

PROPERTY LOCATION:

SUBDIVISION _____ LOT NO. 4

ROAD AND DESCRIPTION Old Frederick Road

OCCUPANT _____ PHONE _____

PERSON TO CONSTRUCT SYSTEM _____

ADDRESS _____ PHONE _____

SIZE OF LOT 95' x 228' x 97' x 228' TYPE BLDG. 3 or 4

NUMBER OF BEDROOMS

IF NOT SINGLE RESIDENCE DESCRIBE _____ (Single Fmly. Dwllg.)

SIGNATURE OF APPLICANT Eugene G. Seybold

APPROVED BY _____ FOR _____ DATE _____

(KIND OF SYSTEM)


REJECTED BY _____ FOR _____ DATE _____

(KIND OF SYSTEM)

HOLD PENDING FURTHER TESTS _____ DATE _____

REASONS FOR REJECTION OR HOLDING _____

THIS IS NOT A PERMIT

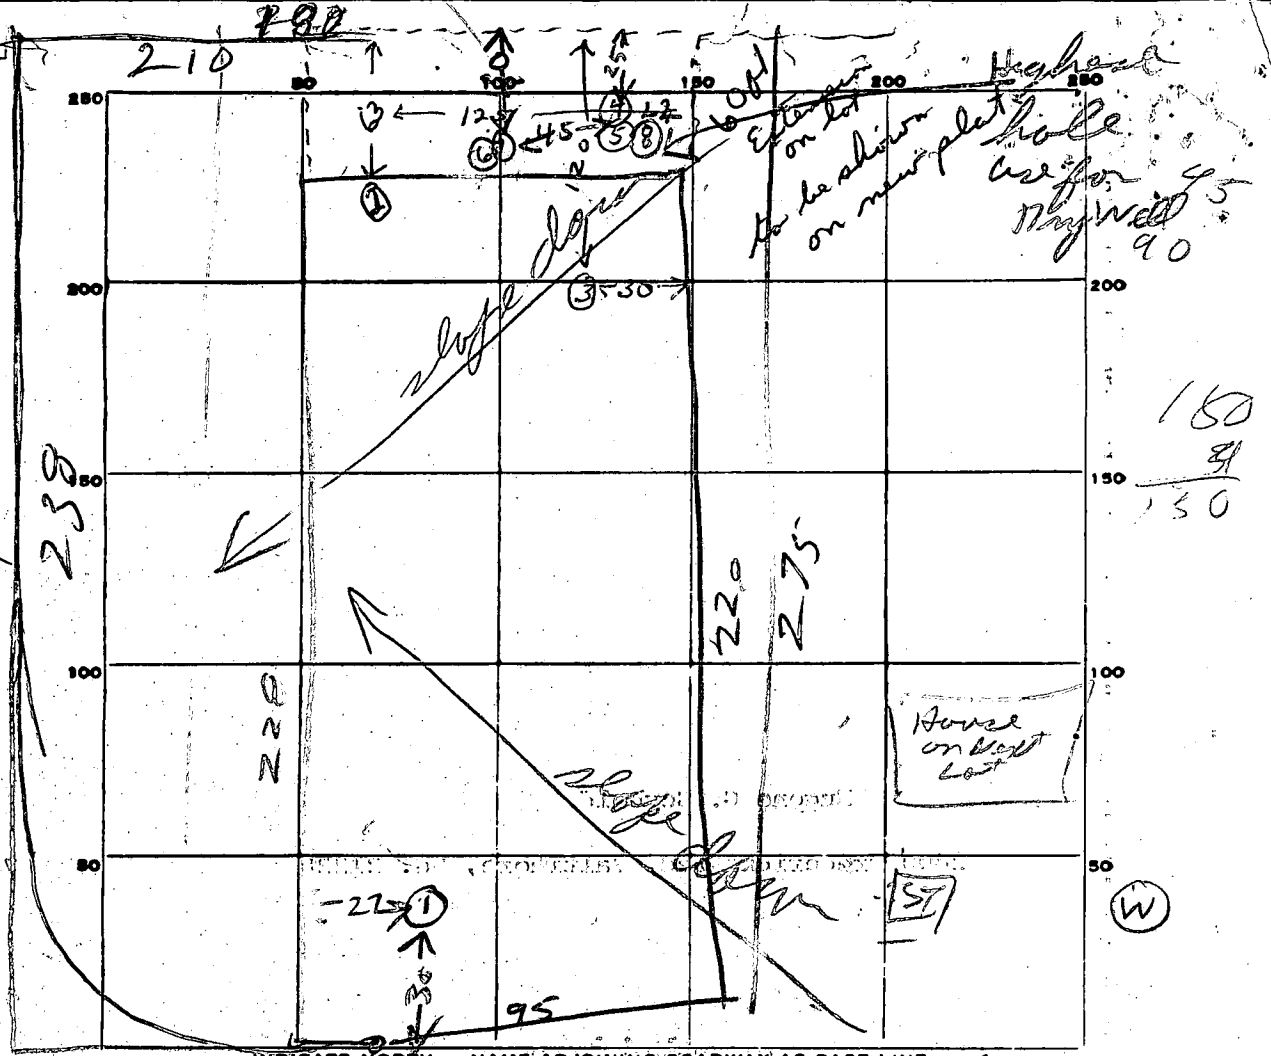

INDICATE NORTH - NAME ADJOINING ROADWAY AS BASE LINE

OLD FRED. RD

ROGERS AVE

DATE	TEST NO.	DEPTH	PRE-WET		TEST - 1" DROP		TIME	
			START	STOP	START	STOP		
8/17/71	1	9 1/2	UNDER GROUND WATER					
			TOP 6 FT CLAYISH					
1/14/71	2	9 ft.	Water					
1/15/71	3	7 ft.	Rock -					
	4	4 1/2	11 13	1 128	11 28	12 05	37	
	5	10 1/2	10 16	11 19	11 19	10 24	5	
	6	4	12 27	12 32	12 32	12 43	11	
	7	10	12 34	12 36	12 36	12 38	4	
	8	5 1/2	12 44	12 49	12 49	12 58	9	

SOIL AUGER FINDING

TESTED BY

B. Rodgers

REMARKS

APPLICATION

SEWAGE DISPOSAL TESTING

MARYLAND STATE DEPARTMENT OF HEALTH

HOWARD COUNTY

ELLICOTT CITY

DISTRICT 2

DATE 7/29/71

TO: THE COUNTY HEALTH OFFICER
ELLICOTT CITY, MARYLAND

I, HEREBY, APPLY FOR THE NECESSARY TESTS IN ORDER TO CONSTRUCT (OR RECONSTRUCT) A SEWAGE DISPOSAL SYSTEM.

PROPERTY OWNER Eugene G. Seybold

ADDRESS 2400 Frederick Road, Baltimore, Md. 21228 PHONE 744-4541

PROPERTY LOCATION:

SUBDIVISION _____ LOT NO. 3 *North end of 2*

ROAD AND DESCRIPTION Old Frederick Road

OCCUPANT _____ PHONE _____

PERSON TO CONSTRUCT SYSTEM _____

ADDRESS _____ PHONE _____

SIZE OF LOT 104' x 228' x 97' x 228' TYPE BLDG. 3 or 4

NUMBER OF BEDROOMS
(Single Fmly. Dwllg.)

IF NOT SINGLE RESIDENCE DESCRIBE _____

SIGNATURE OF APPLICANT Eugene G. Seybold


APPROVED BY _____ FOR _____ DATE _____
(KIND OF SYSTEM)

REJECTED BY _____ FOR _____ DATE _____
(KIND OF SYSTEM)

HOLD PENDING FURTHER TESTS _____ DATE _____

REASONS FOR REJECTION OR HOLDING _____

THIS IS NOT A PERMIT

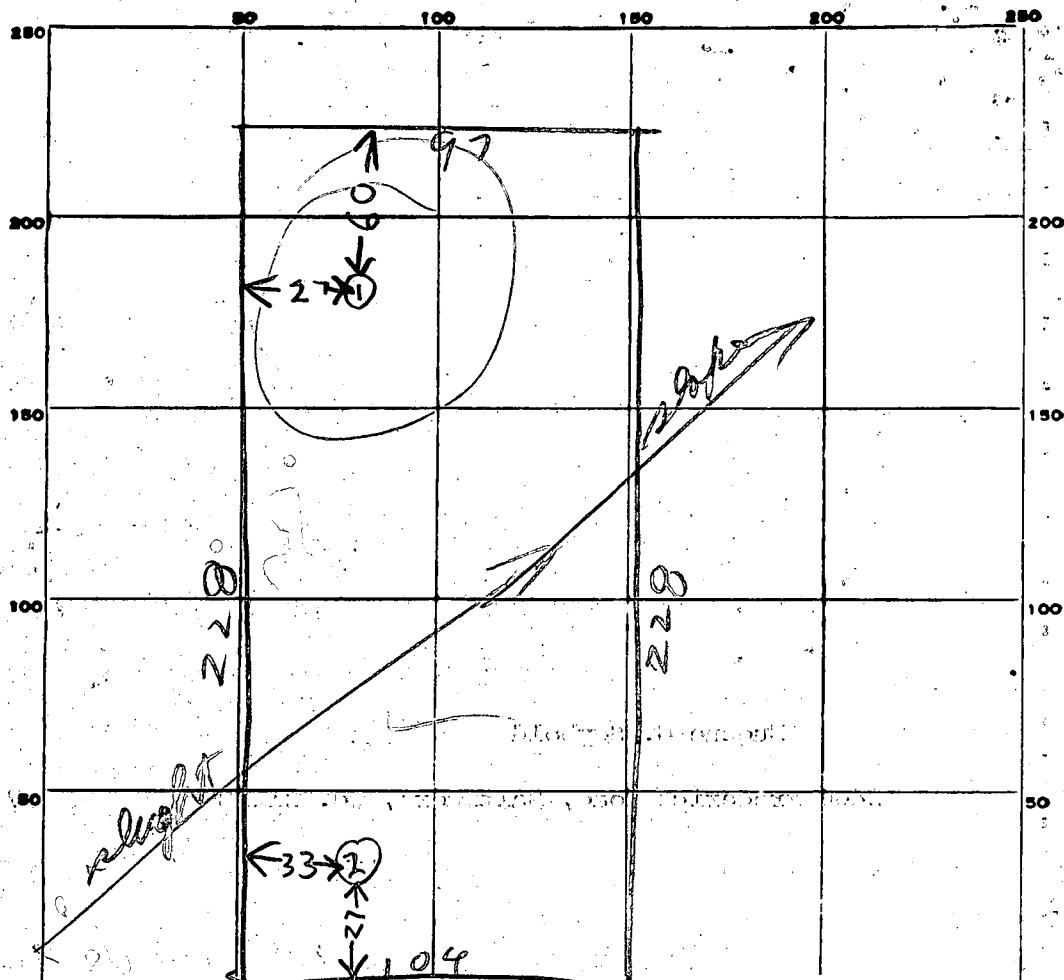

INDICATE NORTH. - NAME ADJOINING ROADWAY AS BASE LINE.

OLD FRED RD TO ROGERS AVE →

DATE	TEST NO.	DEPTH	PRE-WET		TEST - 1" DROP		TIME
			START	STOP	START	STOP	
8/17	1	9	UNDER	GROUND	WATER	7 FT	
	21	11	UNDER	GROUND	WATER	10 FT	
			TOP	5 FT	CLAY		


SOIL AUGER FINDING

TESTED BY

R. Rodger

REMARKS

275-1E

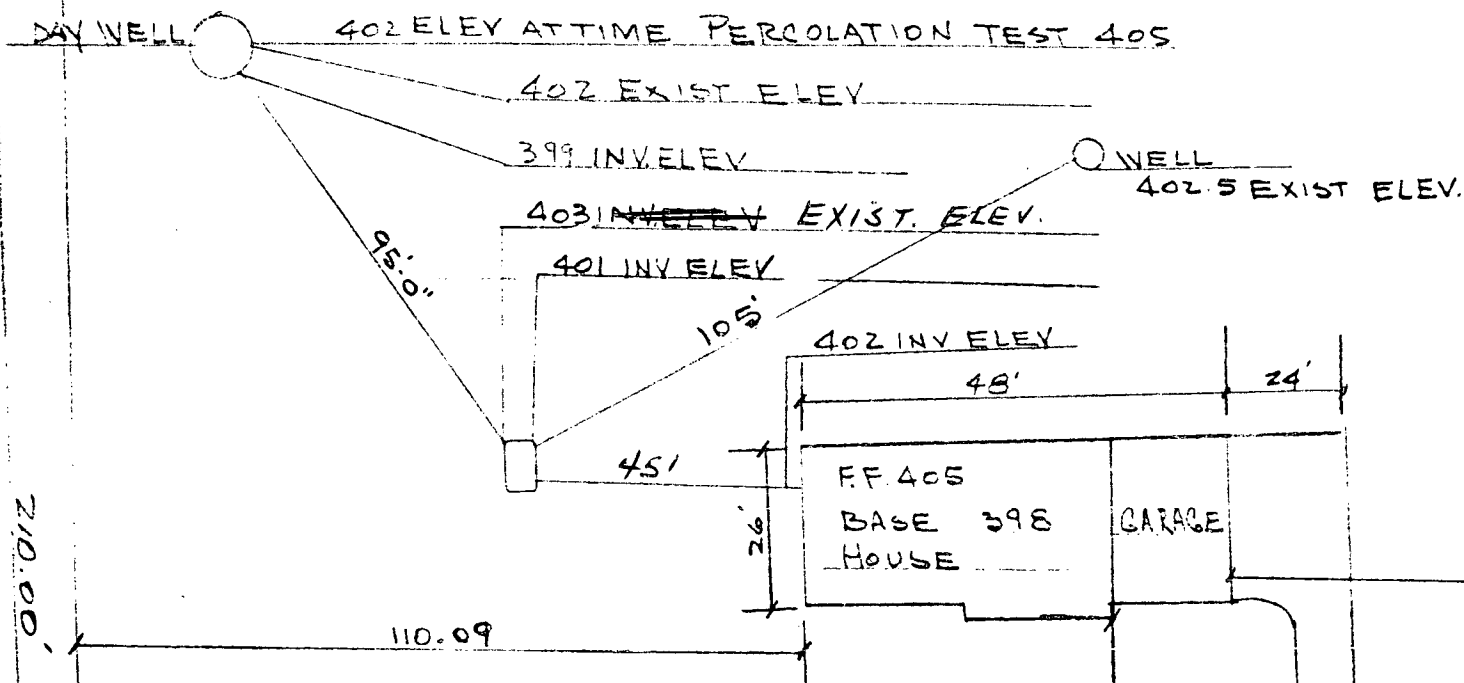

Liber 568
Folio 352
Lot 2 Gene Siebold Property

I certify the above measurements and elevations are
actual and correct for this property.


Melvin Hickman

788-8481


PLANS OK RIT 9/15/76

NOTES

1. PROPERTY SHOWN HEREON LOCATED ON TAX MAP 18 PARCEL 315
2. TITLE REFERENCE C.M.P. 568/35E
3. THE LOTS SHOWN HEREON COMPLY WITH MINIMUM OWNERSHIP WIDTH AND LOT AREA AS REQUIRED BY THE MARYLAND STATE DEPARTMENT OF HEALTH REGULATIONS
4. TOTAL NUMBER OF LOTS 2
5. TOTAL AREA OF TRACT 13.83 AC ±
6. TOTAL AREA LOT 1 & 2 2.323 AC ±

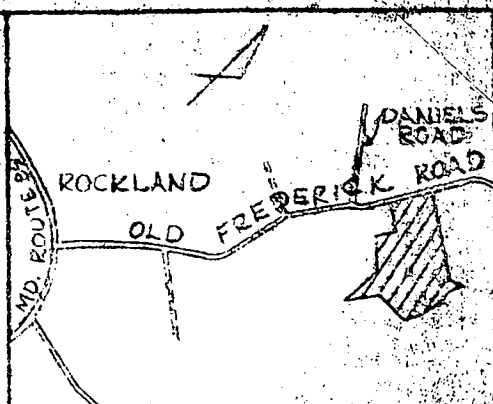

VICINITY MAP
SCALE: 1"=2000'

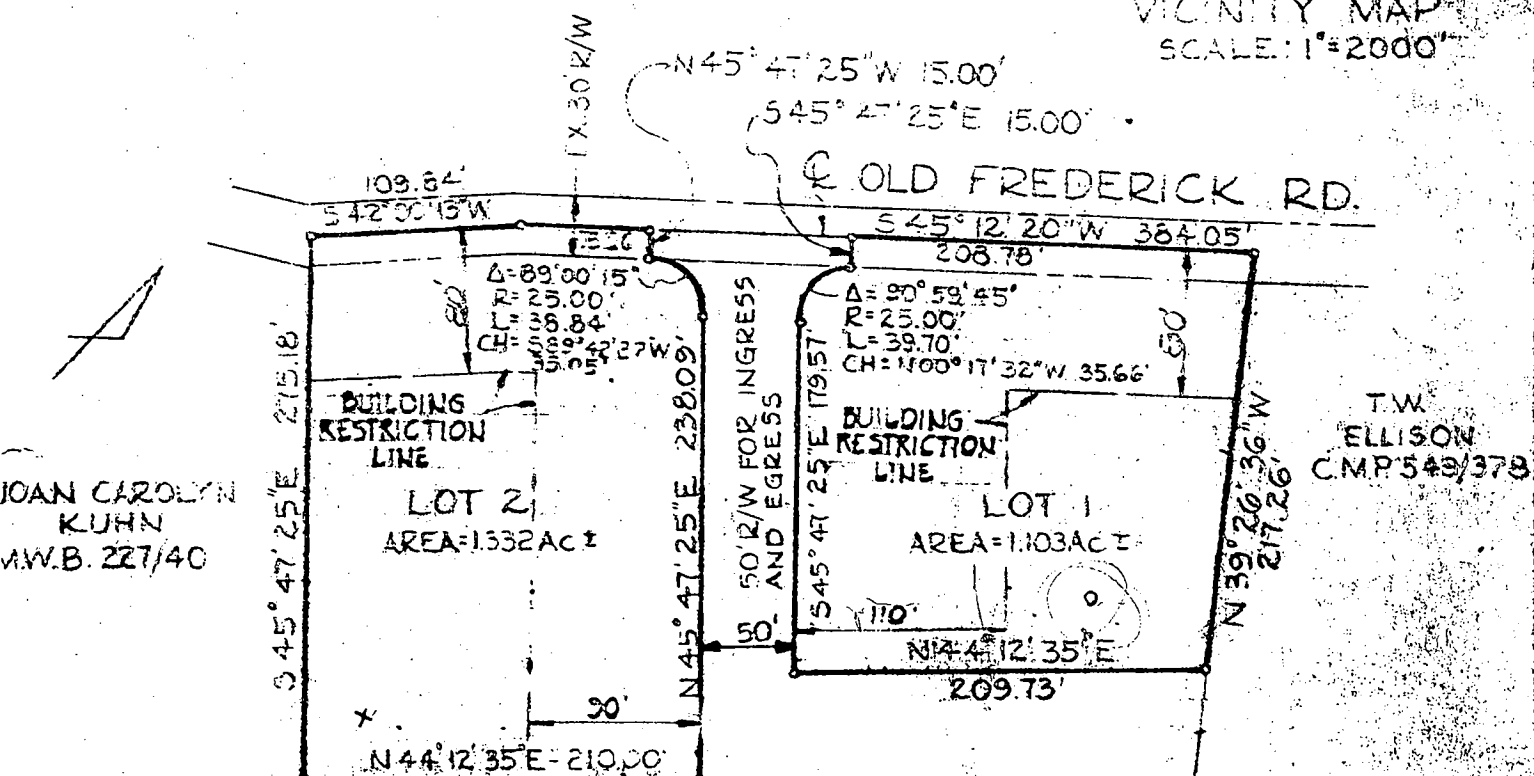

JOAN CAROLYN KUHN
M.W.B. 227/40

T.W. ELLISON
C.M.P. 543/378

PROPERTY OF
EUGENE SEYBOLD
2ND ELECTION DISTRICT
HOWARD COUNTY, MARYLAND
SCALE: 1"=100' NOV 10, 1971

APPROVED: PRIVATE WATER & PRIVATE SEWER

Thomas J. Harriott
COUNTY HEALTH OFFICER

4-13-72
DATE

APPROVED: DIVISION OF LAND DEVELOPMENT
AND TRANSPORTATION PLANNING

Thomas J. Harriott
PLANNING DIRECTOR

4-17-72
DATE



William G. Rasch
WILLIAM G. RASCH REG. NO. 4575
PURDUM & JESCHKE
ENGINEERS & LAND SURVEYORS
3697 PARK AVENUE
ELLICOTT CITY, MARYLAND 21043

OWNERS CERTIFICATE:
I THE UNDERSIGNED OWNER OF THE PROPERTY
SHOWN HEREON, MY HEIRS OR ASSIGNS, ADOPT THIS
PLAN OF SUBDIVISION AND DO HEREBY ESTABLISH
THE BUILDING SETBACK RESTRICTION LINE SHOWN
HEREON IN ORDER TO COMPLY WITH THE GENERAL
PLAN OF HIGHWAYS OF HOWARD COUNTY

Eugene Seybold 11/30/71

STATE OF MARYLAND
WATER RESOURCES ADMINISTRATION
TAWES STATE OFFICE BLDG., ANNAPOLIS, MARYLAND 21401
APPLICATION FOR PERMIT TO DRILL WELL

WRA PERMIT NUMBER
HO-23-1690

FILL IN THIS FORM COMPLETELY

OWNER: CLARK, William
205 HAMMERSHIRE RD.
REISTERTOWN, MD. 21136

DRILLER INFORMATION
DATE: SEPT. 20, 1976
LICENSE NUMBER: 88
A. C. REIDER & SON, INC.
SIGNATURE: [Signature]

WELL INFORMATION
MAXIMUM PUMPING RATE (GALLONS PER MINUTE): 5
AVERAGE DAILY QUANTITY NEEDED (GALLONS PER DAY): 600

USE FOR WATER (CIRCLE APPROPRIATE BOX)
[D] HOME (SINGLE OR DOUBLE HOUSEHOLD UNIT ONLY)
[F] FARMING, AGRICULTURE, IRRIGATION
[I] INDUSTRIAL, COMMERCIAL, STATE AND FEDERAL GOVERNMENT.
[M] MUNICIPAL WATER SUPPLY
[P] PRIVATE WATER COMPANY
[T] TEST

APPROXIMATE DEPTH OF WELL: 150 FEET
APPROXIMATE DIAMETER OF WELL: 6 (NEAREST INCH)

METHOD OF DRILLING USED (CIRCLE APPROPRIATE METHOD)
[BORED (OR AUGERED)] [JETTED] [DRIVEN]
30-37 [AIR-ROTARY] [AIR-PERCUSSION] [ROTARY (HYDRAULIC ROTARY)]
[CABLE] [REVERSE-ROTARY] [DRIVE-POINT]

OTHER (DESCRIBE)

REPLACEMENT OR DEEPEMED WELLS (CIRCLE APPROPRIATE BOX)
[N] THIS WELL WILL NOT REPLACE AN EXISTING WELL
[Y] THIS WELL WILL REPLACE A WELL THAT WILL BE ABANDONED AND SEALED
[S] THIS WELL WILL REPLACE A WELL THAT WILL BE USED AS A STANDBY
[D] THIS WELL WILL DEEPEMED AN EXISTING WELL
PERMIT NUMBER OF WELL TO BE REPLACED OR DEEPEMED (IF AVAILABLE):

NOT TO BE FILLED IN BY DRILLER (WRA USE ONLY)
APPROPRIATION PERMIT NUMBER: 54
ENGINEER REVIEW DISTRICT NO.: 63
FORCE: 67 68
CONDITIONS: 70 71 72 73 74 75 76 77 78 79

HEALTH DEPARTMENT APPROVAL
DATE: 100576
COUNTY NAME: Howard
COUNTY NO.: 1120
APPROVED BY: Donald W. Monaghan, Sanitarian

LOCATION OF WELL
COUNTY: HOWARD
SUBDIVISION: ROLLING RIDGE
SECTION: 23
LOT: 2
NEAREST TOWN: ELLICOTT CITY
MILES FROM TOWN (ENTER 0 IF IN TOWN): 1 1/2

DIRECTION FROM TOWN (CIRCLE APPROPRIATE BOX)
[N] NORTH [E] EAST [NE] NORTHEAST [SE] SOUTHEAST
[S] SOUTH [W] WEST [NW] NORTHWEST [SW] SOUTHWEST
NEAR WHAT ROAD: ROLLING RIDGE CT.
ON WHICH SIDE OF ROAD (CIRCLE APPROPRIATE BOX): [N] NORTH [S] SOUTH [E] EAST [W] WEST
DISTANCE FROM ROAD (ENTER DISTANCE AND CIRCLE APPROPRIATE BOX): 175

Well to be located in Rolling Ridge Lot 2
11-12-76 - not enough open hole
11/17/76
30 ft casing - 1 1/2" outer diam
26 ft open hole
17 bags cement
OK drilling

BOX NUMBER: 52

NORTH COORDINATE: 50 51 52 53 54 55
EAST COORDINATE: 57 58 59 60 61 62 63
ELEVATION AT WELL HEAD (FEET): 65 66 67 68

C 1	2225	SEQUENCE NO. (WRA USE ONLY)
1 2 3 (SEQ. NO.) 6 (THIS NUMBER IS TO BE PUNCHED IN COLS. 3-6 ON ALL CARDS)		

STATE OF MARYLAND
WATER RESOURCES ADMINISTRATION
TAWES STATE OFFICE BLDG., ANNAPOLIS, MD. 21401
WELL COMPLETION REPORT

THIS REPORT MUST BE SUBMITTED WITH-
IN 30 DAYS AFTER WELL COMPLETION

FILL IN THIS FORM COMPLETELY

COUNTY
NUMBER

DATE RECEIVED (WRA USE ONLY)	DATE WELL COMPLETED 11-11-71	DEPTH OF WELL 22 (TO NEAREST FOOT)	PERMIT NO. FROM "PERMIT TO DRILL WELL" 11-11-71
8-13	15 20	22 26	28 29 30 31 32 33 34 35 36 37
DRILLERS IDENTIFICATION NO. 77			

OWNER CLOCK W. H. H. H.	STREET OR RFD 205 HUNTER ST. NW	POST OFFICE REISTERSTOWN
LAST NAME	FIRST NAME	

WELL LOG	GROUTING RECORD	PUMPING TEST
----------	-----------------	--------------

STATE THE KIND OF FORMATIONS PENETRATED, THEIR COLOR, DEPTH, THICKNESS AND IF WATER BEARING

DESCRIPTION (USE ADDITIONAL SHEETS IF NECESSARY)	FEET		CHECK IF WATER BEARING
	FROM	TO	
20		20	
21		21	
22		22	
23		23	
24		24	
25		25	
26		26	
27		27	
28		28	
29		29	
30		30	
31		31	
32		32	
33		33	
34		34	
35		35	
36		36	
37		37	

WELL HAS BEEN GROUTED (CIRCLE APPROPRIATE BOX) YES ☒ NO ☐
 TYPE OF GROUTING MATERIAL (CIRCLE BOX)
 CEMENT ☒ BENTONITE CLAY ☐
 NO. OF BAGS 45 NO. OF POUNDS 46
 GALLONS OF WATER 1
 DEPTH OF GROUT SEAL (TO NEAREST FOOT)
 FROM 48 FT. TO 54 FT.
 (ENTER 0 IF FROM SURFACE)

CASING RECORD
 INSERT APPROPRIATE CODE BELOW
 STEEL ☒ CONCRETE ☐
 PLASTIC ☐ OTHER ☐
 MAIN CASING TYPE 5
 NOMINAL DIAMETER TOP (MAIN) CASING (NEAREST INCH) 1
 TOTAL DEPTH OF MAIN CASING (NEAREST FOOT) 30

OTHER CASING (IF USED)
 DIAMETER (INCH) FROM TO
 DEPTH (FEET) FROM TO

SCREEN RECORD
 INSERT APPROPRIATE CODE BELOW
 STEEL ☒ BRASS OR BRONZE ☐ OPEN HOLE ☐
 PLASTIC ☐ OTHER ☐


C 2
 1 2 3 (SEQ. NO.) 6
 DEPTH (NEAREST WHOLE FOOT)
 FROM TO
 1 8 9 11 13 15 17 19 21
 2 23 24 26 30 32 36
 3 38 39 41 45 47 51
 SLOT SIZE 1. 2. 3.

DIAMETER OF SCREEN 56 (NEAREST INCH)
 FROM TO
 GRAVEL PACK
 IF WELL DRILLED WAS A FLOWING WELL CIRCLE BOX 68 ☐

WRA USE ONLY (NOT TO BE FILLED IN BY DRILLER)
 T 70 ☐ (E.R.O.S.) 72 ☐ W Q 74 75 76
 TELESCOPE CASING LOG INDICATOR OTHER DATA AVAILABLE

PUMPING TEST
 HOURS PUMPED (TO NEAREST HOUR) 6
 PUMPING RATE (GALLONS PER MINUTE TO NEAREST GALLON) 17
 METHOD USED TO MEASURE PUMPING RATE A
 WATER LEVEL: (DISTANCE FROM LAND SURFACE)
 BEFORE PUMPING 42 (NEAREST FOOT)
 WHEN PUMPING 22 (NEAREST FOOT)
 TYPE OF PUMPED USED (CIRCLE APPROPRIATE BOX) (FOR PUMPING TEST)
 AIR ☐ PISTON ☐ TURBINE ☐
 CENTRIFUGAL ☐ ROTARY ☐ OTHER (DESCRIBE BELOW)
 JET ☐ SUBMERSIBLE ☐

PUMP INSTALLED
 TYPE OF PUMP (WRITE APPROPRIATE LETTER IN BOX - SEE ABOVE: A, C, J, P, R, S, T, O)
 DRILLER WILL INSTALL PUMP (CIRCLE APPROPRIATE BOX) YES ☐ NO ☐
 CAPACITY:
 GALLONS PER MINUTE (TO NEAREST GALLON) 31 35
 PUMP HORSE POWER 37 41
 PUMP COLUMN LENGTH (NEAREST FOOT) 43 47
 CASING HEIGHT (CIRCLE APPROPRIATE BOX AND ENTER CASING HEIGHT)
 ABOVE ☐ BELOW ☐
 LAND SURFACE 50 (NEAREST FOOT)

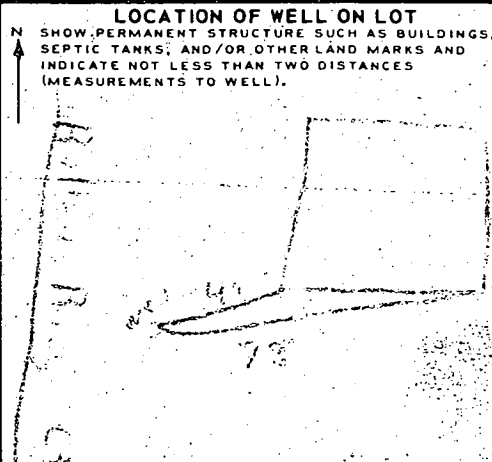LOCATION OF WELL ON LOT
 SHOW PERMANENT STRUCTURE SUCH AS BUILDINGS, SEPTIC TANKS, AND/OR OTHER LAND MARKS AND INDICATE NOT LESS THAN TWO DISTANCES (MEASUREMENTS TO WELL).


CIRCLE APPROPRIATE BOXES
 A A WELL WAS ABANDONED AND SEALED WHEN THIS WELL WAS COMPLETED
 E ELECTRIC LOG OBTAINED
 P TEST WELL CONVERTED TO PRODUCTION WELL

I HEREBY CERTIFY THAT I HAVE COMPLIED WITH ALL CONDITIONS STATED ON THE ABOVE-CAPTIONED "PERMIT TO DRILL WELL", AND THAT INFORMATION CONTAINED IN THIS REPORT IS TRUE, ACCURATE, AND COMPLETE TO THE BEST OF MY KNOWLEDGE, INFORMATION AND BELIEF.

DRILLERS NAME
 (PLEASE PRINT) QUAYN BARKER
 SIGNATURE Quayn Barker


DRILLER

W S CLARK 7/25/88 HOUSE EXTENSION PLAN

PMC Material Handling Systems Division
Colmar

Old Fred. Rd


Allice

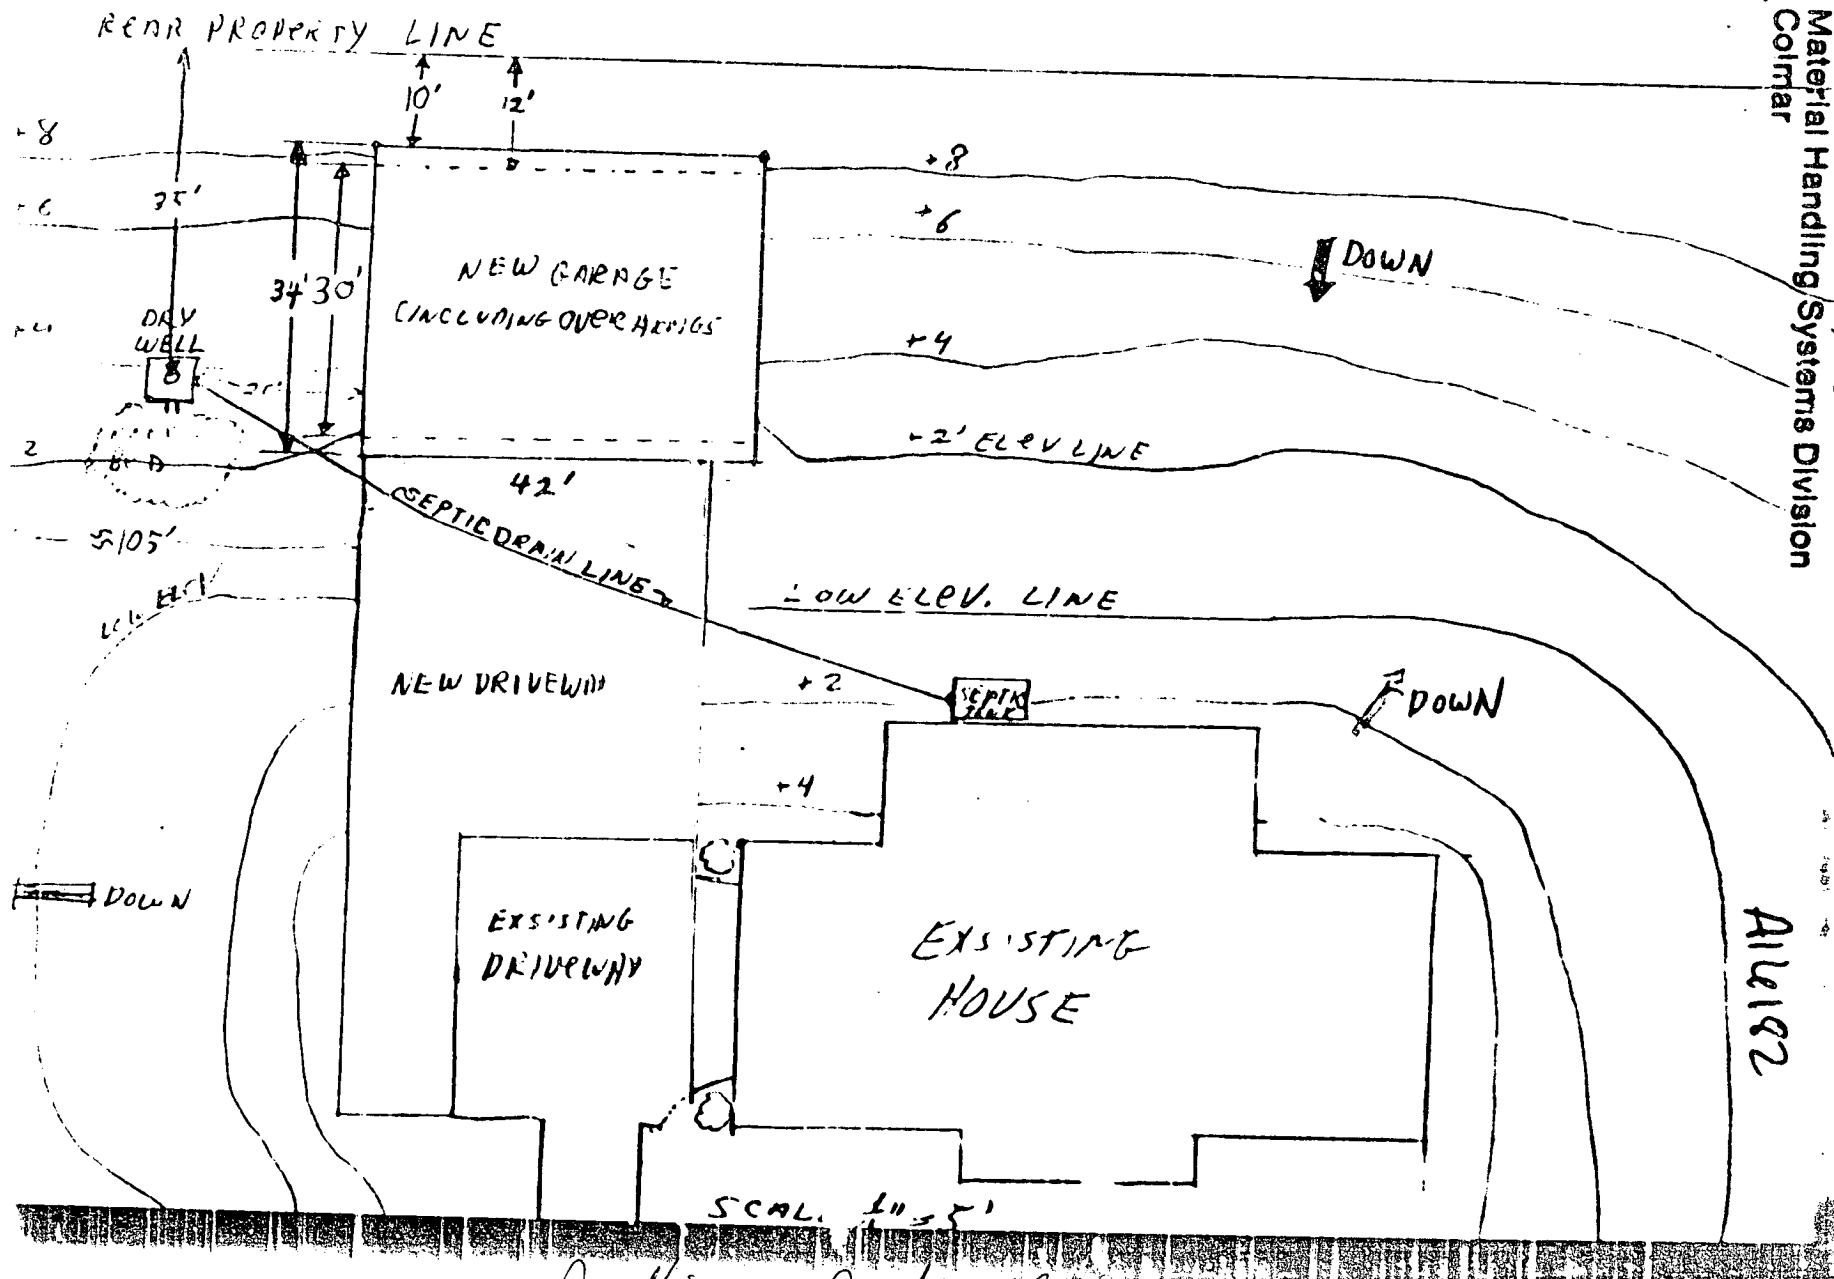

Rolling Ridge Ct

NOTE: THIS PLAT CAN NOT BE USED TO ESTABLISH LOT LINES

CERTIFICATION	SEAL	FIRM <i>ALW 92</i>
"THIS PLAT SHOWS THAT (1) THE IMPROVEMENTS ARE LOCATED AS INDICATED WITHIN OR ON THE PERIMETER OF THE PROPERTY, (2) THERE ARE NO ENCROACHMENTS OF EXISTING IMPROVEMENTS LOCATED ON SAID LAND ONTO ANY EASEMENT THEREON NOR ONTO ANY ADJOINING LAND AND (3) THERE ARE NO ENCROACHMENTS ONTO SAID LAND OF EXISTING IMPROVEMENTS LOCATED ON ADJOINING LAND."		EDWIN J. KIRBY & ASSOC. 22 N. COURT STREET WESTMINSTER, MD. 21157
		SCALE: 1" = 60' DATE: 1/12/76

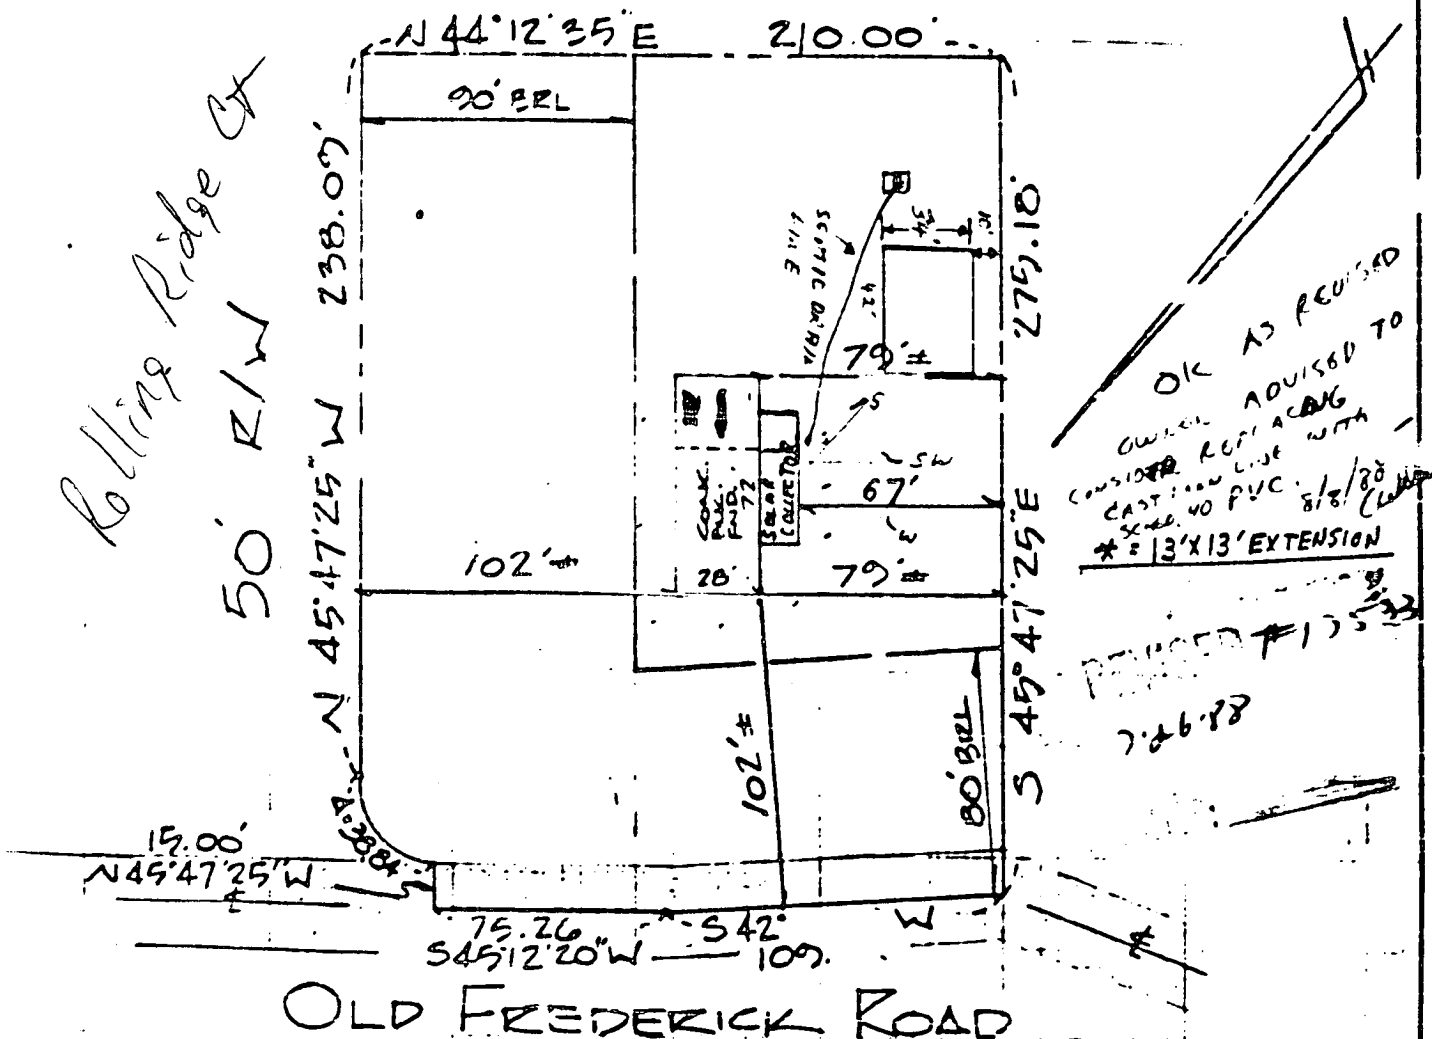

OLD FREDERICK ROAD

Lot 2 Rolling Ridge
Dist. 2 Howard County, Maryland

Property known as:

THIS PLAT CAN NOT BE USED TO ESTABLISH PROPERTY LINES OR CORNERS.

ROLLING RIDGE P.R. 25 F.C.C.
200 ELECTED DISTRICT
+ info - no County, MD

8/8/88
MARK RIFKEN

7/2/98
proposed
garage OK as
shown
(see above)

PROPOSED GARAGE OK
BASED ON PREV. APPROVAL OF 8/8/88

LOCATION SURVEY PLAT
SUBJECT PROPERTY NOT LOCATED IN A FLOOD PLAIN AREA UNLESS OTHERWISE NOTED


CERTIFICATION

This is to certify that I have surveyed
the property known as: 8448

ROLLING RIDGE COURT

for the purpose of locating the im-
provements thereon, and the improvements
are located as shown.

Health
Dept.

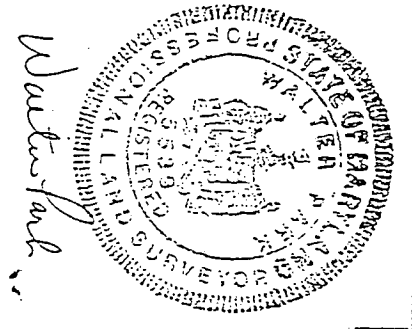


SEAL

SCALE 1" = 40' DATE: 11-26-97

LDE Inc.

9250 Runney Road Suite 106
Columbia, Maryland 21045

(Ball.) 410-715-1070
(Wash.) 301-596-3424
(FAX) 410-715-9540

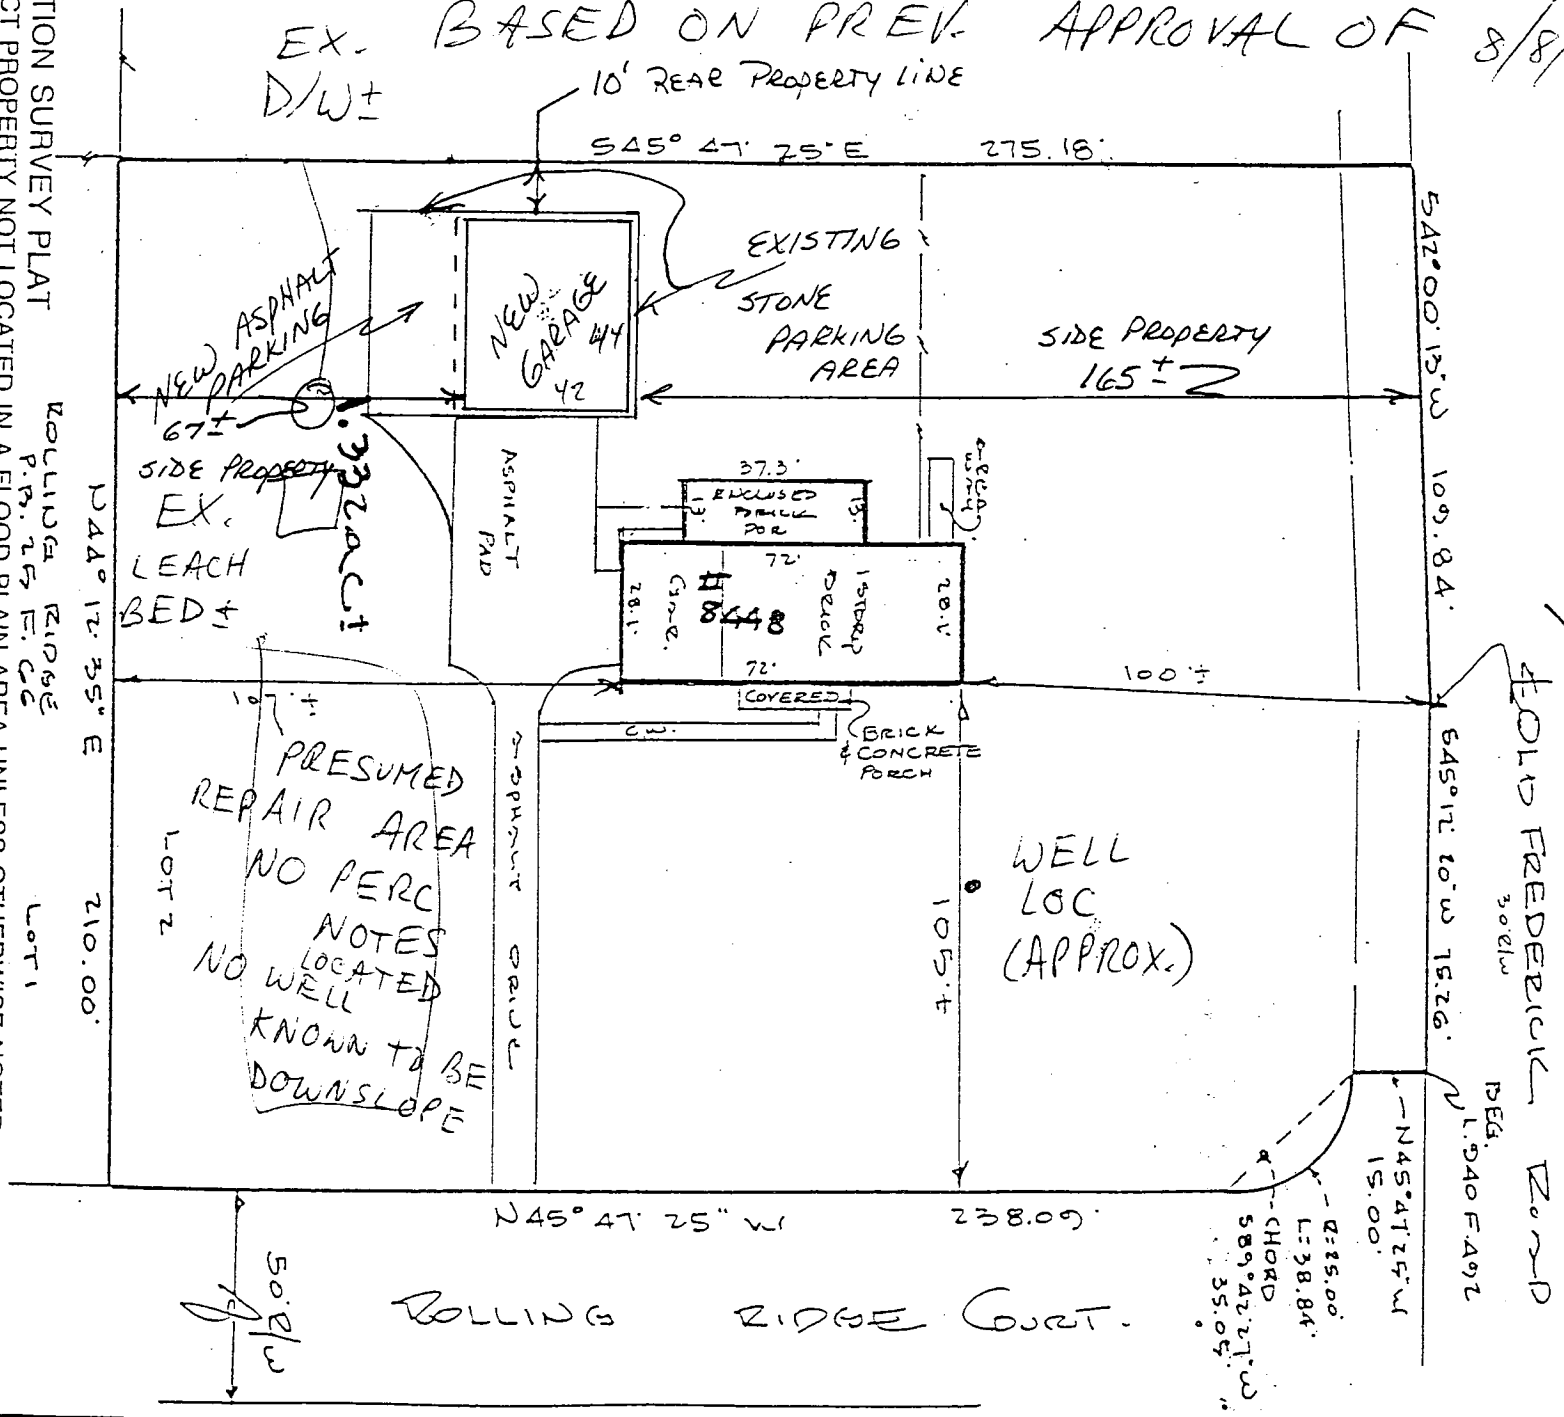

8448 ROLLING RIDGE COURT
GARAGE CONSTRUCTION
GRADING PLAN

1:20 ±

