

6/13/80
after 12:00

PERMIT

SEWAGE DISPOSAL SYSTEM

MARYLAND STATE DEPARTMENT OF HEALTH*

HOWARD COUNTY

04-339002

ELLICOTT CITY

DISTRICT 4th.

DATE 6/13/80

INDEXED

Thomas G. Harris

IS PERMITTED TO INSTALL X ALTER

ADDRESS Box 6, Monkton, Maryland 21111 PHONE 472-4613

SUBDIVISION Robb property ROAD 14416 Route 144 LOT 2

PROPERTY OWNER John Joseph Tanmard, III

ADDRESS 8551 Ramort Drive, Baltimore, Maryland 21236

SPECIFICATIONS 3 Bedrooms

SEPTIC TANK CAPACITY 1000 GALLONS

DRAIN FIELD DEPTH FEET, BOTTOM AREA SQ. FT.

DEEP TRENCH DEPTH FEET, BOTTOM AREA SQ. FT.

Dry Well SEEPAGE PITS X ABSORBENT SIDE-WALL AREA 190 SQ. FT. per bedrooms Total Absorbent sidewall in dry well 288 sq. ft.

INLET PIPE 4 FT. BELOW ORIGINAL GRADE. MAXIMUM DEPTH 10 FT. BELOW ORIGINAL GRADE

EFFECTIVE DEPTH AT FT. BELOW ORIGINAL GRADE.

LOCATE DISPOSAL AREA FT. FROM LOT LINE AND FT. FROM LOT LINE AS SEEN WHEN

FACING LOT FROM

Inlet
TRENCHES - 4 ft. below original grade and maximum depth 10 ft. Start trench 10 ft from dry well edge towards 267.84 lot line and run trench on contour towards 890 ft. lot line. Length of trench in 3 bedrooms - 60 ft. 4 Bedrooms - 110 ft.

NOTE: LEAVE 5 FT. EARTH BUFFER BETWEEN DRY WELL AND TRENCH.

PLANS APPROVED BY David J. O'Neill/D. W. Monaghan DATE 2/27/78

COVER NO WORK UNTIL INSPECTED AND APPROVED.

NEITHER THE HOWARD COUNTY COUNCIL NOR THE HEALTH DEPARTMENT IS RESPONSIBLE FOR THE SUCCESSFUL OPERATION OF ANY SYSTEM.

NOTE: IF TRENCH IS USED CALL FOR INSPECTION BEFORE PLACING GRAVEL IN TRENCH.

NOTE: NO DRY WELL SHALL EXCEED 15 FOOT IN DIAMETER.

NOTE: ALL PIPE FROM HOUSE TO DISPOSAL AREA MUST BE CAST IRON.

PERMIT VOID AFTER THREE YEARS.

NOTE: INSTALL STAND PIPE ON SEPTIC TANK AND DRY WELL. STAND PIPES MUST BE 6 INCHES IN DIAMETER. CAST IRON, CONCRETE OR TERRA COTTA ACCEPTED.

BLDG. PERMIT SIGNED
AND RETURNED 7/17/84
To pool # 60009


*INSTALLER IS RESPONSIBLE FOR OBTAINING FINAL APPROVAL ON THIS PERMIT.

BLDG. PERMIT SIGNED
AND RETURNED 4/6/87

Serial # 9543
Addition - Bedroom - 2 car garage

A 25594

47
6
282
366
282
648

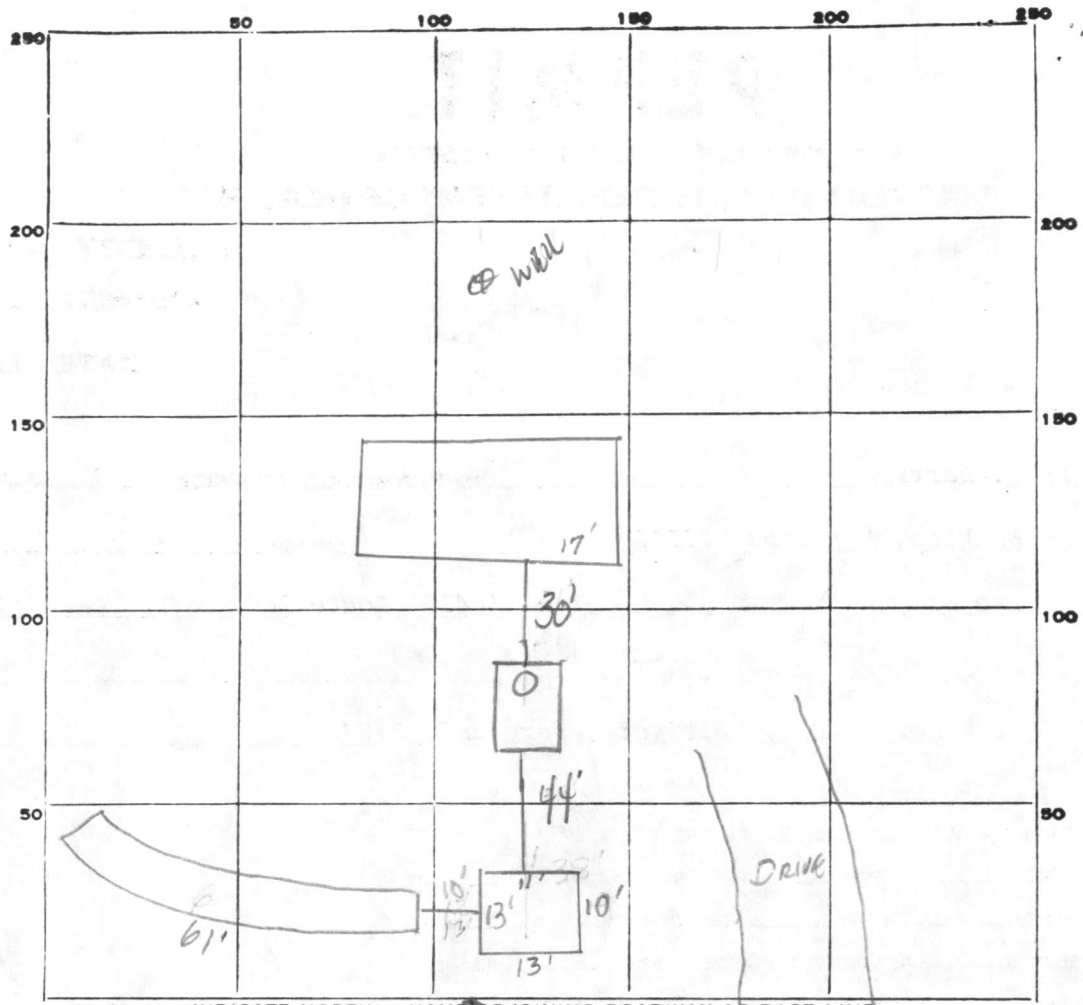

PERMIT CARD ☒

SEPTIC TANK, LEVEL ☒

CLEANOUTS ☒ ST ☒ DW ☒

DISTRIBUTION BOX, LEVEL ☐

TRENCH
TILE FIELD, DEPTH 10 FT. TRENCH WIDTH 2 FT.

GRAVEL DEPTH 6 IN. TOTAL LENGTH 61' FT. SIDEWALK

NUMBER OF TRENCHES 1 TOTAL BOTTOM AREA

DRY WELL PERMITTED 47
SEEPAGE PITS, INSIDE DIAMETER 47 FT. DEPTH BELOW INLET 6 FT. 282 19 FT

ABSORBENT AREA 648 SQ. FT.

REMARKS 6-17-80 OK To add gravel to trench SK + CBS 6-17-80

DATE SYSTEM APPROVED 16-17-80 INSPECTOR Stephen L. Reil

APPLICATION

A 25594

P _____

SEWAGE DISPOSAL TESTING

STATE OF MARYLAND - DEPARTMENT OF HEALTH AND MENTAL HYGIENE

HOWARD COUNTY HEALTH DEPARTMENT
ENVIRONMENTAL HEALTH SERVICESP. O. BOX 476, ELLICOTT CITY, MARYLAND 21043
TELEPHONE: 465-5000, EXT. 356DISTRICT 4thDATE 4/6/77BLDG. PERMIT SIGNED
AND RETURNED 3/20/77
Serial # F-40049TO: THE COUNTY HEALTH OFFICER
ELLICOTT CITY, MARYLAND

I, HEREBY, APPLY FOR THE NECESSARY TEST IN ORDER TO CONSTRUCT (OR RECONSTRUCT) A SEWAGE DISPOSAL SYSTEM.

PROPERTY OWNER ~~Robb property~~ John Joseph Tammard IIIADDRESS 8551 Ramont Dr. PHONE Norman Weller - 795-3282
Balto. Md 21235

PROPERTY LOCATION:

SUBDIVISION _____ LOT NO. 2ROAD AND DESCRIPTION 144th Route 144 - Cooksville, Md -SIZE OF LOT 10.6 acres m/1 ~~6.687 acres~~ TYPE BLDG. 3 or 4 bedrooms
9.492 acres NUMBER OF BEDROOMS

IF NOT SINGLE RESIDENCE DESCRIBE _____

THE SYSTEM INSTALLED UNDER THIS APPLICATION IS ACCEPTABLE ONLY UNTIL PUBLIC FACILITIES BECOME AVAILABLE.

SIGNATURE OF APPLICANT /s/ Norman WellerAPPROVED BY _____ FOR _____ DATE _____
(KIND OF SYSTEM)REJECTED BY _____ FOR _____ DATE _____
(KIND OF SYSTEM)

HOLD PENDING FURTHER TESTS _____ DATE _____

REASONS FOR REJECTION OR HOLDING _____

THIS IS NOT A PERMIT



INDICATE NORTH. - NAME ADJOINING ROADWAY AS BASE LINE

DATE	TEST NO.	DEPTH	PRE-WET		TEST - 1" DROP		TIME
			START	STOP	START	STOP	
5/20	1 S	5	3 ²²	3 ²⁴	3 ²⁴	3 ³⁰	6
	4	13 1/2	3 ²²	3 ³⁶	3 ³⁶	3 ⁵³	17
	2	6	4 ⁵⁵	4 ⁵⁵			
	3 S	4	9 ⁵⁵	10 ⁰⁵	10 ⁰⁵	10 ⁰⁸	4
	4	12	9 ⁵⁵			10 ⁰⁵	7
	7 S	5	10 ¹⁰	10 ³⁰	10 ³⁰	10 ⁵⁵	25
	4	13	10 ⁰⁴	10 ¹¹	10 ¹¹	10 ³¹	10
	8 S	4	10 ¹³	10 ²¹	10 ²¹	10 ³¹	10
	4	12	10 ¹³			10 ⁵⁵	25
	5	6' clay					

REMARKS _____

TYPE OF SOIL _____

TESTED BY ajon

ALSO PRESENT: Robb + S; ✓ 4

THIS AREA DESIGNATES A PRIVATE SEWAGE EASEMENT OF APPROXIMATELY 10,000 SQUARE FEET AS REQUIRED BY THE MARYLAND STATE DEPARTMENT OF HEALTH AND MENTAL HYGIENE FOR INDIVIDUAL SEWAGE DISPOSAL. IMPROVEMENTS OF ANY KIND IN THIS AREA ARE RESTRICTED UNTIL PUBLIC SEWER IS AVAILABLE AND SERVICING ANY RESIDENTIAL STRUCTURE ON THIS BUILDING SITE. THIS EASEMENT SHALL BECOME NULL AND VOID UPON CONNECTION TO A PUBLIC SEWER SYSTEM.


THE LOT SHOWN HEREON COMPLIES WITH THE MINIMUM OWNERSHIP WIDTH AND LOT AREA AS REQUIRED BY THE MARYLAND DEPARTMENT OF HEALTH & MENTAL HYGIENE.

398*0 DESIGNATES FIELD LOCATED PERC HOLES & ELEVATIONS.

APPROVED: FOR PRIVATE WATER & PRIVATE SEWAGE SYSTEMS.

HOWARD COUNTY HEALTH DEPARTMENT

Joyce Byler 3-12-80
 HEALTH OFFICER DATE

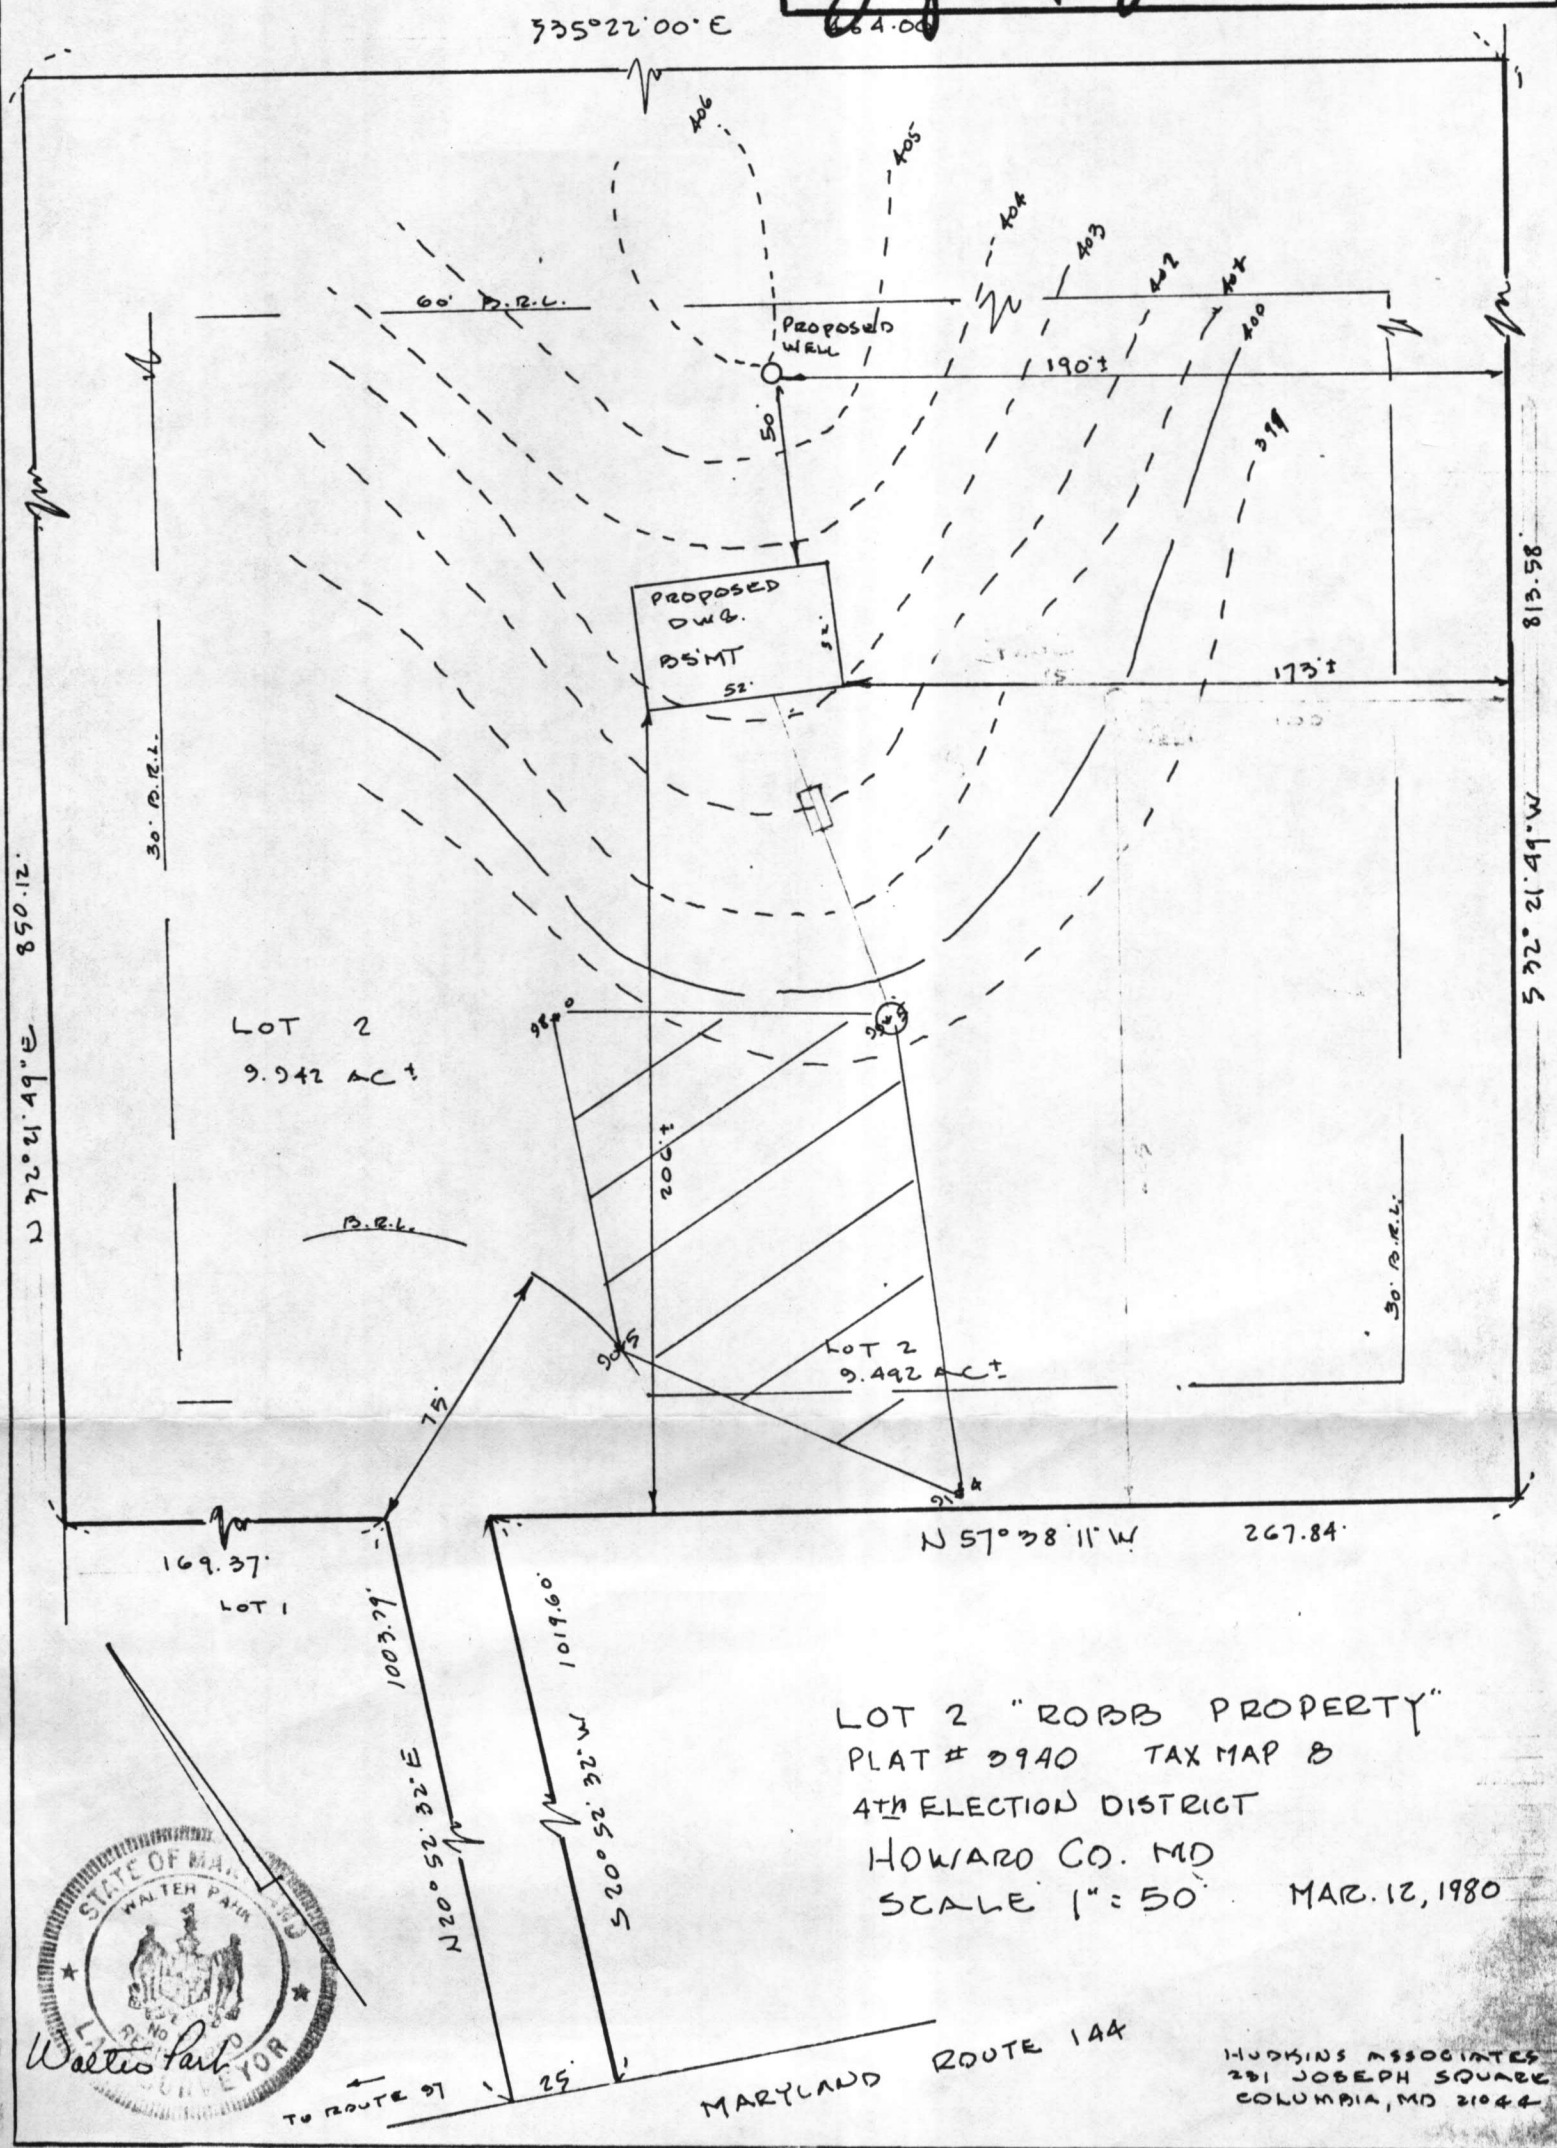

LOT 2 "ROBB PROPERTY"
 PLAT # 9940 TAX MAP B
 4TH ELECTION DISTRICT
 HOWARD CO. MD
 SCALE 1"=50' MAR. 12, 1980

HUDKINS ASSOCIATES
 281 JOSEPH SQUARE
 COLUMBIA, MD 21044

3/20/80

WELL
EXISTING. GR. 406.00
PROPOSED GR. 406.00

DRY WELL
EXISTING. GR. 399.50
PROPOSED GR. 399.50
INVERT GRADE 395.50

SEPTIC TANK
EXISTING. GR. 402.00
PROPOSED GR. 402.00
INVERT IN 396.90
INVERT OUT 396.50

PROPOSED ADDITIONS TO EXISTING DWELLING

INVERT AT HOUSE
397.40

