PERMIT

26016 25906

MARYLAND STATE DEPARTMENT OF HEALTH

HOWARD	COUNTY
1/9/77 1:00	12 cross
7/1911 1:0	1060
" MM".	•
al C	

06-393853

ELLICOTT CITY DISTRICT_6th

DATE 6/7/77

INDEXE

DRAIN FIELD DEPTH FEET, BOTTOM AREA SQ. FT. SEEPAGE PITS ABSORBENT SIDE-WALL AREA SQ. FT. BLDG. PERMIT SIGN AND RETURNED AND RETURNED FOR GARBAGE GRINDER, INCREASE DISPOSAL AREA 22% & TANK CAPACITY BOY TRENCHES - Tow trenches, each 60 ft. long, 2 ft. wide, 12 ft. deep, with 8 of stone under pipe as specified on June 3, 1977 at perc site. (See copy of attached drawing.) NOTE: CALL FOR INSPECTION OF TRENCHES BEFORE PLACING GRAVEL IN TRENCH. NOTE: ALL PIPE WROM HOUSE TO DISPOSAL AREA MUST BE CAST IRON. PERMIT VOID AFTER THREE YEARS. NOTE: INSTALL STAND PIPE ON SEPTIC TANK. STAND PIPES MUST BE 6 INCHES IN DIAM CAST IRON, CONCRETE OR TERRA COTTA ACCEPTED.	PHONE 725-7388 O264 O24
SEWAGE DISPOSAL-SYSTEM LOCATED AT 725024 10125 Stansfield Road ROPERTY OWNER Richard D. Wheeler Same as above DRAIN FIELD DEPTH FEET, BOTTOM AREA SQ. FT. SEEPAGE PITS ABSORBENT SIDE-WALL AREA SQ. FT. BLDG. PERMIT SIGN AND RETURNED AND RETUR	0264 5024
ROPERTY OWNER Richard D. Wheeler ROPERTY OWNER Richard D. Wheeler ROPERSS SAME AS ABOVE DRAIN FIELD DEPTH FEET, BOTTOM AREA SQ. FT. SEEPAGE PITS ABSORBENT SIDE-WALL AREA SQ. FT. BLDG. PERMIT SIGN AND RETURNED AND RETURNED FOR GARBAGE GRINDER, INCREASE DISPOSAL AREA 22% & TANK CAPACITY 50% TRENCHES - Tow trenches, each 60 ft. long, 2 ft. wide, 12 ft. deep, with 8 ft. of stone under pipe as specified on June 3, 1977 at perc site. (See copy of attached drawing.) NOTE: CALL FOR INSPECTION OF TRENCHES BEFORE PLACENING GRAVEL IN TRENCH. NOTE: ALL PIPE FROM HOUSE TO DISPOSAL AREA MUST BE CAST IRON. PERMIT VOID AFTER THREE YEARS. NOTE: INSTALL STAND PIPE ON SEPTIC TANK. STAND PIPES MUST BE 6 INCHES IN DIAM CAST IRON, CONCRETE OR TERRA COTTA ACCEPTED.	5024
ROPERTY OWNER Richard D. Wheeler DDRESS Same as above PECIFICATIONS 3 bedrooms DRAIN FIELD DEPTH FEET, BOTTOM AREA SQ. FT. SEEPAGE PITS ABSORBENT SIDE-WALL AREA SQ. FT. SEEPAGE PITS ABSORBENT SIDE-WALL AREA SQ. FT. SEPTIC TANK CAPACITY 1000 GALLONS SILLA H 137 TRENCHES - Tow trenches, each 60 ft. long, 2 ft. wide, 12 ft. deep, with 8 ft. of stone under pipe as specified on June 3, 1977 at perc site. (See copy of attached drawing.) NOTE: CALL FOR INSPECTION OF TRENCHES BEFORE PLACENING GRAVEL IN TRENCH. NOTE: ALL PIPE WROM HOUSE TO DISPOSAL AREA MUST BE CAST IRON. PERMIT VOID AFTER THREE YEARS. NOTE: INSTALL STAND PIPE ON SEPTIC TANK. STAND PIPES MUST BE 6 INCHES IN DIAM CAST IRON, CONCRETE OR TERRA COTTA ACCEPTED. David J. O'Neill 6/3/77	Stansfield Road LOT
ROPERTY OWNER Richard D. Wheeler DDRESS Same as above PECIFICATIONS 3 bedrooms DRAIN FIELD DEPTH FEET, BOTTOM AREA SQ. FT. SEEPAGE PITS ABSORBENT SIDE-WALL AREA SQ. FT. SEEPAGE PITS ABSORBENT SIDE-WALL AREA SQ. FT. SEPTIC TANK CAPACITY 1000 GALLONS AND RETURNED A SEPTIC TANK CAPACITY SOW FOR GARBAGE GRINDER, INCREASE DISPOSAL AREA 22% & TANK CAPACITY SOW TRENCHES - Tow trenches, each 60 ft. long, 2 ft. wide, 12 ft. deep, with 8 ft. of stone under pipe as specified on June 3, 1977 at perc site. (See copy of attached drawing.) NOTE: CALL FOR INSPECTION OF TRENCHES BEFORE PLACENING GRAVEL IN TRENCH. NOTE: ALL PIPE WROM HOUSE TO DISPOSAL AREA MUST BE CAST IRON. PERMIT VOID AFTER THREE YEARS. NOTE: INSTALL STAND PIPE ON SEPTIC TANK. STAND PIPES MUST BE 6 INCHES IN DIAMCAST IRON, CONCRETE OR TERRA COTTA ACCEPTED. David J. O'Neill 6/3/77	Stansfield Road LOT
DRESS SAINE AS ABOVE PECIFICATIONS 3 bedrooms DRAIN FIELD DEPTH FEET, BOTTOM AREA SQ. FT. SEEPAGE PITS ABSORBENT SIDE-WALL AREA SQ. FT. SEEPAGE PITS ABSORBENT SIDE-WALL AREA SQ. FT. SEPTIC TANK CAPACITY 1000 GALLONS SUMMENT SIGN AND RETURNED TO SEPTIC TANK CAPACITY SOWN AND RETURNED TO SEPTIC TANK CAPACITY SOWN SUMMENT SIGN AND RETURNED TO SEPTIC TANK CAPACITY SOWN SEPTIC TANK CAPACITY SOWN SEPTIC TANK CAPACITY SOWN OF ATTACHMENT STAND PIPE SITE. (See copy of attached drawing.) NOTE: CALL FOR INSPECTION OF TRENCHES BEFORE PLACENG GRAVEL IN TRENCH. NOTE: ALL PIPE FROM HOUSE TO DISPOSAL AREA MUST BE CAST IRON. PERMIT VOID AFTER THREE YEARS. NOTE: INSTALL STAND PIPE ON SEPTIC TANK. STAND PIPES MUST BE 6 INCHES IN DIAM CAST IRON, CONCRETE OR TERRA COTTA ACCEPTED. David J. O'Neill 6/3/77	
DRESS DRAIN FIELD DEPTH FEET, BOTTOM AREA SQ. FT. SEEPAGE PITS ABSORBENT SIDE-WALL AREA SQ. FT. BLDG. PERMIT SIGN AND RETURNED AND RETURNED FOR GARBAGE GRINDER, INCREASE DISPOSAL AREA 22% & TANK CAPACITY 30% TRENCHES - Tow trenches, each 60 ft. long, 2 ft. wide, 12 ft. deep, with 8 of stone under pipe as specified on June 3, 1977 at perc site. (See copy of attached drawing.) NOTE: CALL FOR INSPECTION OF TRENCHES BEFORE PLACENG GRAVEL IN TRENCH. NOTE: ALL PIPE FROM HOUSE TO DISPOSAL AREA MUST BE CAST IRON. PERMIT VOID AFTER THREE YEARS. NOTE: INSTALL STAND PIPE ON SEPTIC TANK. STAND PIPES MUST BE 6 INCHES IN DIAM CAST IRON, CONCRETE OR TERRA COTTA ACCEPTED.	
DRAIN FIELD DEPTH FEET, BOTTOM AREA SQ. FT. SEEPAGE PITS ABSORBENT SIDE-WALL AREA SQ. FT. BLDG. PERMIT SIGN AND RETURNED FOR GARBAGE GRINDER, INCREASE DISPOSAL AREA 22% & TANK CAPACITY BOY TRENCHES - Two trenches, each 60 ft. long, 2 ft. wide, 12 ft. deep, with 8 of stone under pipe as specified on June 3, 1977 at perc site. (See copy of attached drawing.) NOTE: CALL FOR INSPECTION OF TRENCHES BEFORE PLACENING GRAVEL IN TRENCH. NOTE: ALL PIPE FROM HOUSE TO DISPOSAL AREA MUST BE CAST IRON. PERMIT VOID AFTER THREE YEARS. NOTE: INSTALL STAND PIPE ON SEPTIC TANK. STAND PIPES MUST BE 6 INCHES IN DIAM CAST IRON, CONCRETE OR TERRA COTTA ACCEPTED.	
SEPAGE PITS ABSORBENT SIDE-WALL AREA SQ. FT. BLDG. PERMIT SIGN AND RETURNED AND RETURNES AND RETURNED AND RETURNES AND RETURNED AND RETURNES AND RETURNED AND RET	•
SEEPAGE PITS ABSORBENT SIDE-WALL AREA	
SEPTIC TANK CAPACITY 1000 GALLONS FOR GARBAGE GRINDER, INCREASE DISPOSAL AREA 22% & TANK CAPACITY 50% TRENCHES - Tow trenches, each 60 ft. long, 2 ft. wide, 12 ft. deep, with 8 OTHER of stone under pipe as specified on June 3, 1977 at perc site. (See copy of attached drawing.) NOTE: CALL FOR INSPECTION OF TRENCHES BEFORE PLACING GRAVEL IN TRENCH. NOTE: ALL PIPE FROM HOUSE TO DISPOSAL AREA MUST BE CAST IRON. PERMIT VOID AFTER THREE YEARS. NOTE: INSTALL STAND PIPE ON SEPTIC TANK. STAND PIPES MUST BE 6 INCHES IN DIAM CAST IRON, CONCRETE OR TERRA COTTA ACCEPTED. David J. O'Neill 6/3/77	\$Q. FT.
SEPTIC TANK CAPACITY 1000 GALLONS FOR GARBAGE GRINDER, INCREASE DISPOSAL AREA 22% & TANK CAPACITY 50% TRENCHES - Tow trenches, each 60 ft. long, 2 ft. wide, 12 ft. deep, with 8 of stone under pipe as specified on June 3, 1977 at perc site. (See copy of attached drawing.) NOTE: CALL FOR INSPECTION OF TRENCHES BEFORE PLACING GRAVEL IN TRENCH. NOTE: ALL PIPE YROW HOUSE TO DISPOSAL AREA MUST BE CAST IRON. PERMIT VOID AFTER THREE YEARS. NOTE: INSTALL STAND PIPE ON SEPTIC TANK. STAND PIPES MUST BE 6 INCHES IN DIAM CAST IRON, CONCRETE OR TERRA COTTA ACCEPTED. David J. O'Neill 6/3/77	SQ. FT. BLDG. PERMIT SIGNED
FOR GARBAGE GRINDER, INCREASE DISPOSAL AREA 22% & TANK CAPACITY 50% TRENCHES - Tow trenches, each 60 ft. long, 2 ft. wide, 12 ft. deep, with 8 of stone under pipe as specified on June 3, 1977 at perc site. (See copy of attached drawing.) NOTE: CALL FOR INSPECTION OF TRENCHES BEFORE PLACING GRAVEL IN TRENCH. NOTE: ALL PIPE FROM HOUSE TO DISPOSAL AREA MUST BE CAST IRON. PERMIT VOID AFTER THREE YEARS. NOTE: INSTALL STAND PIPE ON SEPTIC TANK. STAND PIPES MUST BE 6 INCHES IN DIAM CAST IRON, CONCRETE OR TERRA COTTA ACCEPTED. David J. O'Neill 6/3/77	AND RETURNED 4//
TRENCHES - Tow trenches, each 60 ft. long, 2 ft. wide, 12 ft. deep, with 8 OTHER ft. of stone under pipe as specified on June 3, 1977 at perc site. (See copy of attached drawing.) NOTE: CALL FOR INSPECTION OF TRENCHES BEFORE PLACING GRAVEL IN TRENCH. NOTE: ALL PIPE FROM HOUSE TO DISPOSAL AREA MUST BE CAST IRON. PERMIT VOID AFTER THREE YEARS. NOTE: INSTALL STAND PIPE ON SEPTIC TANK. STAND PIPES MUST BE 6 INCHES IN DIAM CAST IRON, CONCRETE OR TERRA COTTA ACCEPTED. David J. O'Neill 6/3/77	
TRENCHES - Tow trenches, each 60 ft. long, 2 ft. wide, 12 ft. deep, with 8 ft. of stone under pipe as specified on June 3, 1977 at perc site. (See copy of attached drawing.) NOTE: CALL FOR INSPECTION OF TRENCHES BEFORE PLACING GRAVEL IN TRENCH. NOTE: ALL PIPE FROM HOUSE TO DISPOSAL AREA MUST BE CAST IRON. PERMIT VOID AFTER THREE YEARS. NOTE: INSTALL STAND PIPE ON SEPTIC TANK. STAND PIPES MUST BE 6 INCHES IN DIAM CAST IRON, CONCRETE OR TERRA COTTA ACCEPTED. David J. O'Neill 6/3/77	My Gavaddil
of stone under pipe as specified on June 3, 1977 at perc site. (See copy of attached drawing.) NOTE: CALL FOR INSPECTION OF TRENCHES BEFORE PLACEING GRAVEL IN TRENCH. NOTE: ALL PIPE FROM HOUSE TO DISPOSAL AREA MUST BE CAST IRON. PERMIT VOID AFTER THREE YEARS. NOTE: INSTALL STAND PIPE ON SEPTIC TANK. STAND PIPES MUST BE 6 INCHES IN DIAM CAST IRON, CONCRETE OR TERRA COTTA ACCEPTED. David J. O'Neill 6/3/77	
NOTE: CALL FOR INSPECTION OF TRENCHES BEFORE PLACING GRAVEL IN TRENCH. NOTE: ALL PIPE FROM HOUSE TO DISPOSAL AREA MUST BE CAST IRON. PERMIT VOID AFTER THREE YEARS. NOTE: INSTALL STAND PIPE ON SEPTIC TANK. STAND PIPES MUST BE 6 INCHES IN DIAM CAST IRON, CONCRETE OR TERRA COTTA ACCEPTED. David J. O'Neill 6/3/77	977 at perc site. (See copy
NOTE: CALL FOR INSPECTION OF TRENCHES BEFORE PLACING GRAVEL IN TRENCH. NOTE: ALL PIPE FROM HOUSE TO DISPOSAL AREA MUST BE CAST IRON. PERMIT VOID AFTER THREE YEARS. NOTE: INSTALL STAND PIPE ON SEPTIC TANK. STAND PIPES MUST BE 6 INCHES IN DIAM CAST IRON, CONCRETE OR TERRA COTTA ACCEPTED. David J. O'Neill 6/3/77	
NOTE: ALL PIPE FROM HOUSE TO DISPOSAL AREA MUST BE CAST IRON. PERMIT VOID AFTER THREE YEARS. NOTE: INSTALL STAND PIPE ON SEPTIC TANK. STAND PIPES MUST BE 6 INCHES IN DIAM CAST IRON, CONCRETE OR TERRA COTTA ACCEPTED. David J. O'Neill 6/3/77	CONTRACT TAL CONTRACT
PERMIT VOID AFTER THREE YEARS. NOTE: INSTALL STAND PIPE ON SEPTIC TANK. STAND PIPES MUST BE 6 INCHES IN DIAM CAST IRON, CONCRETE OR TERRA COTTA ACCEPTED. David J. O'Neill 6/3/77	CING GRAVEL IN TRENCH.
NOTE: INSTALL STAND PIPE ON SEPTIC TANK. STAND PIPES MUST BE 6 INCHES IN DIAM CAST IRON, CONCRETE OR TERRA COTTA ACCEPTED. David J. O'Neill 6/3/77	BE GAST TRON.
CAST IRON, CONCRETE OR TERRA COTTA ACCEPTED. David J. O'Neill 6/3/77	PIPES MUST BE 6 INCHES IN DIAMETE
	ω.
	6/3/77
FILL SEPTIC TANK AND DISTRIBUTION BOX WITH WATER BEFORE CAL	


NEITHER THE HOWARD COUNTY COMMISSIONERS NOR THE HEALTH DEPARTMENT IS RESPONSIBLE FOR THE SUCCESSFUL OPERATION OF ANY SYSTEM.

AND RETURNED 5/18/78

Service Ro. 35813

addition to house

63713

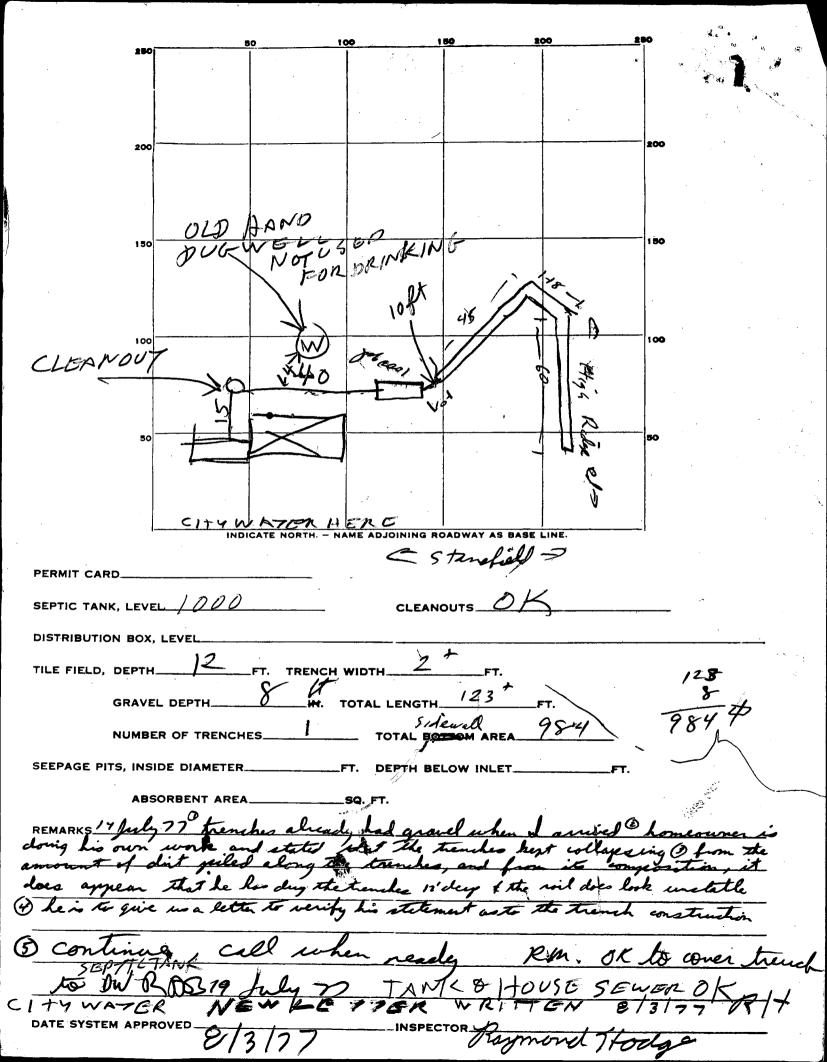

6/3/37 m.

APPLICATION

A 25906

SEWAGE DISPOSAL TESTING

STATE OF MARYLAND - DEPARTMENT OF HEALTH AND MENTAL HYGIENE

HOWARD COUNTY HEALTH DEPARTMENT ENVIRONMENTAL HEALTH SERVICES P. O. BOX 476, ELLICOTT CITY, MARYLAND 21043 DATE $\frac{6 \, \text{LL}}{5/20/77}$

TELEPHONE: 465-5000, EXT. 356

260' traches 12' doep 8' stone as specified to pubelly 6-3-79

TO: THE COUNTY HEALTH OFFICER ELLICOTT CITY, MARYLAND ORDER TO CONSTRUCT (OR RECONSTRUCT) A SEWAGE I HEREBY APPLY FOR THE NECESSARY PROPERTY LOCATION: THE SYSTEM INSTALLED UNDER THIS APPLICATION IS ACCEPTABLE ONLY UNTIL PUBLIC REJECTED BY REASONS FOR REJECTION OF HOLDING.

THIS IS NOT A PERMIT

60

INDICATE NORTH. - NAME ADJOINING ROADWAY AS BABE LINE

		1	PRE-1				T
DATE	TEST NO.	DEPTH	START	STOP	START	STOP	TIME
6/5							
43							
·							
				-		1	
		ł					
	· · · · · · · · · · · · · · · · · · ·	<u> </u>					<u> </u>
					· · · · · · · · · · · · · · · · · · ·	-	
		1					
						· · · · · · · · · · · · · · · · · · ·	
	·						
						<u> </u>	1
{							
1						l	1

REMARKS			
TYPE OF SOIL Sand Straked	in	Clay 4-	7'
		7	15 0000 M
TESTED BY		ALSO PRESENT	:
			W. Lees