

4/13/77
9:30 A.M.
2nd • 10/7/77

PERMIT

File

(Hold for call)

P 25611

A

SEWAGE DISPOSAL SYSTEM

MARYLAND STATE DEPARTMENT OF HEALTH

HOWARD COUNTY

04-321383

ELLICOTT CITY

DISTRICT 4th

DATE 4/7/77

INDEXED

Herman Sirk

IS PERMITTED TO INSTALL _____ ALTER X

ADDRESS 2555 Jennings Chapel Road, Woodbine, Md. 21797 PHONE 489-4724

A SEWAGE DISPOSAL SYSTEM LOCATED AT _____

SUBDIVISION _____ ROAD 16509 Route 144

LOT _____

PROPERTY OWNER Laurence & Martha E. Lemmon

ADDRESS 10533 Gorman Road, Laurel, Md. Phone: 776-5170

SPECIFICATIONS

(3 Bedrooms)

DRAIN FIELD _____ DEPTH _____ FEET, BOTTOM AREA _____ SQ. FT.

SEEPAGE PITS _____ ABSORBENT SIDE-WALL AREA _____ SQ. FT.

New ⊗ SEPTIC TANK CAPACITY 1,000 GALLONS

FOR GARBAGE GRINDER, INCREASE DISPOSAL AREA 22% & TANK CAPACITY 50%.

OTHER REPAIR - Call for inspection when ground is opened up and Sanitarian will

recommend repair system. New 1 = 12' x 13' Dry Well about 3' maximum depth 11' in hole closed to house.
c b d


PLANS APPROVED BY Palmer F. Wine

DATE 4/7/77

FILL SEPTIC TANK AND DISTRIBUTION BOX WITH WATER BEFORE CALLING FOR AN INSPECTION. COVER NO WORK UNTIL INSPECTED AND APPROVED.

NEITHER THE HOWARD COUNTY COMMISSIONERS NOR THE HEALTH DEPARTMENT IS RESPONSIBLE FOR THE SUCCESSFUL OPERATION OF ANY SYSTEM.

P 25611

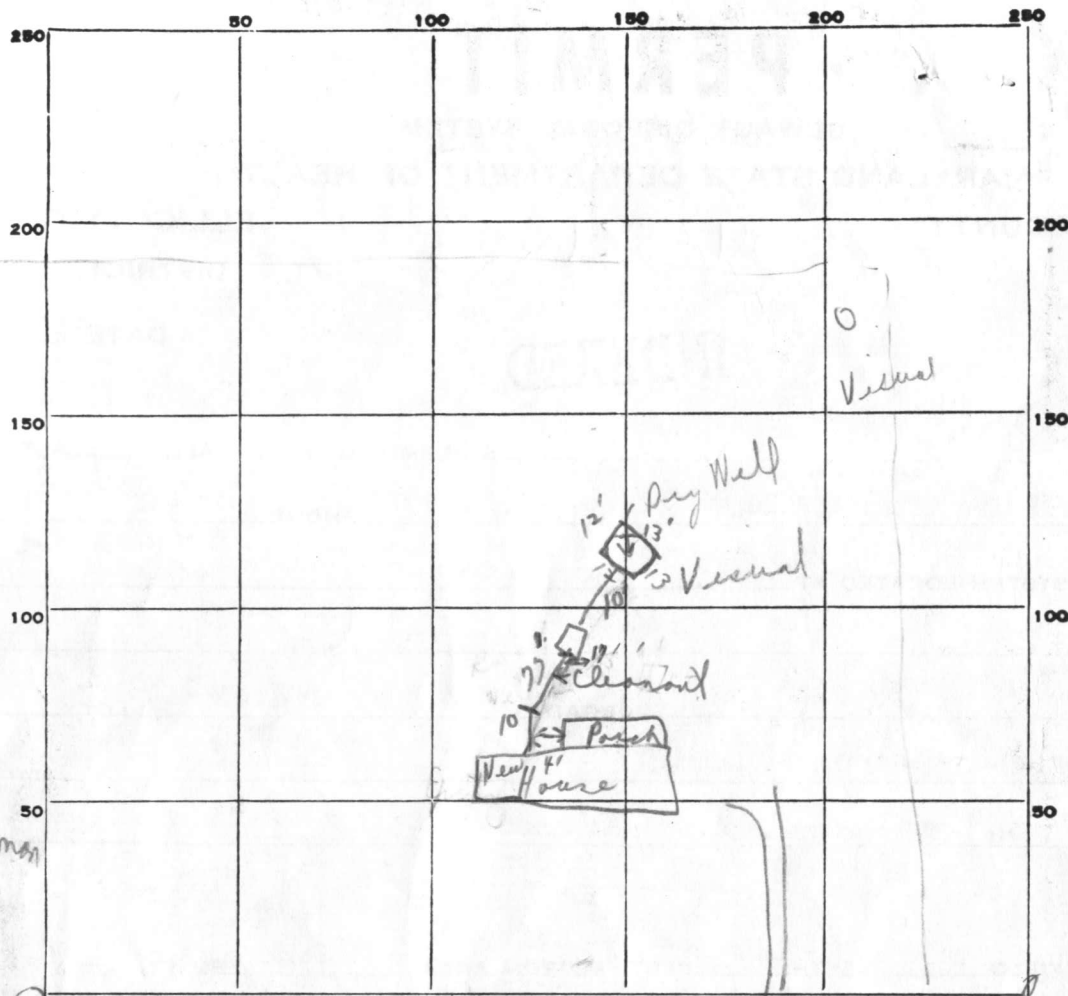

PERMIT CARD

(Not seen)

RP 144

SEPTIC TANK, LEVEL

ok

CLEANOUTS

S.T.

D.W.

ok

ok

DISTRIBUTION BOX, LEVEL

N/A

TILE FIELD, DEPTH

N/A

FT.

TRENCH WIDTH

FT.

GRAVEL DEPTH

1

TOTAL LENGTH

FT.

NUMBER OF TRENCHES

TOTAL BOTTOM AREA

SEEPAGE PITS, INSIDE DIAMETER

50

FT.

DEPTH BELOW INLET

8

FT.

ABSORBENT AREA

400

SQ. FT.

1 - Septic Tank 1000 gallon

REMARKS

4/13/77 Existing House - recommend (1 = 12' x 13' Dry Well)

closed 3' - maximum depth 11' - soil weathered

10/2/77 Note - now new house on site - system in area called for initially

DATE SYSTEM APPROVED

10/2/77

wages above

INSPECTOR

C.B. Sheek

P176


APPROX 1,500 ACRES

72'

P77

R. L. & L. LEMMON

M. PICKET

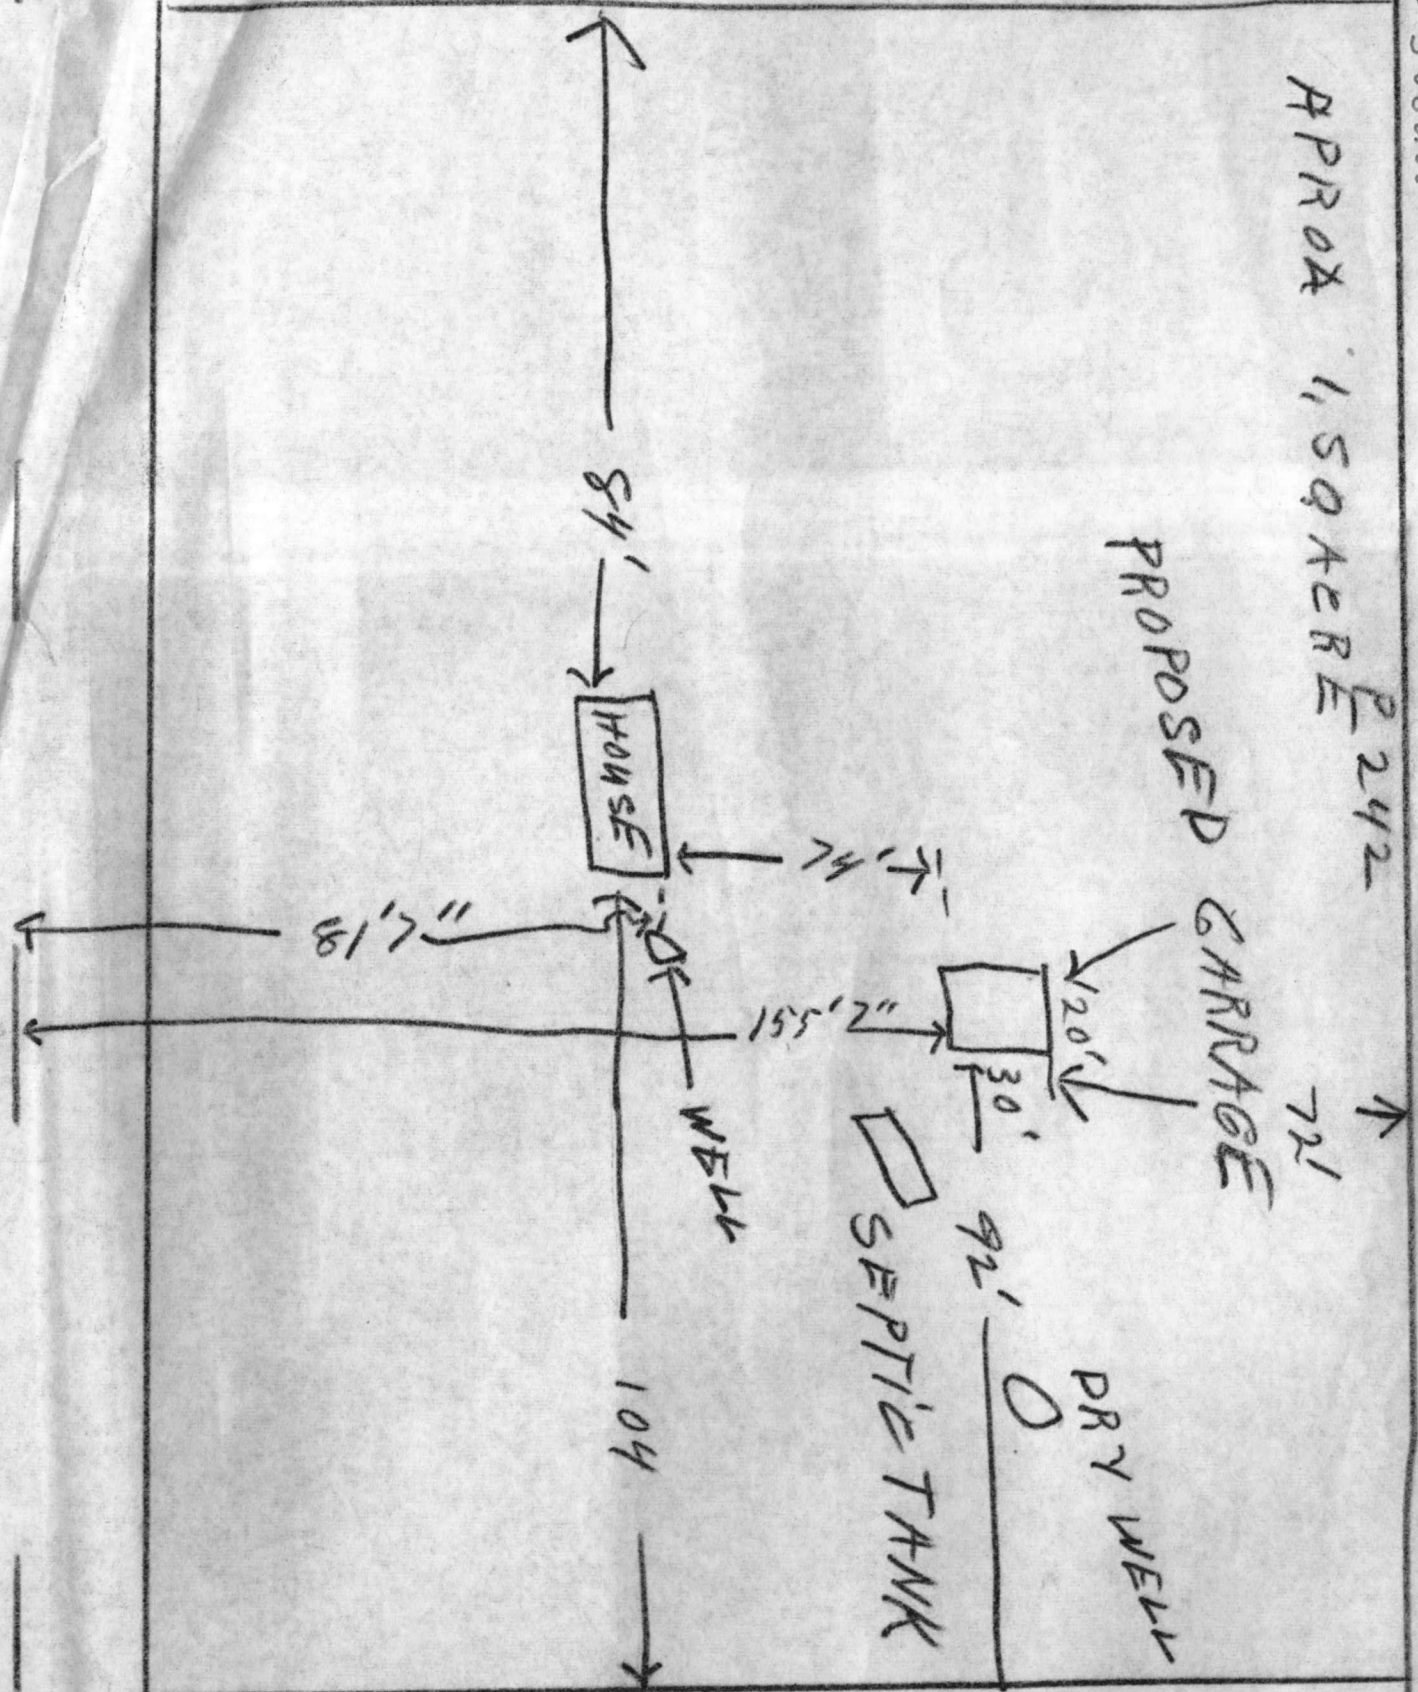

LISBON

POPULAR SPRINGS →