

6/7/77

5/31/77
around 11:00 please

PERMIT

SEWAGE DISPOSAL SYSTEM

MARYLAND STATE DEPARTMENT OF HEALTH

HOWARD COUNTY

ELLICOTT CITY

DISTRICT _____

DATE 5/31/77

INDEXED

Jackins Brothers

IS PERMITTED TO INSTALL _____ ALTER X

ADDRESS Old Frederick Road, Ellicott City, Md. PHONE _____

A SEWAGE DISPOSAL SYSTEM LOCATED AT _____

SUBDIVISION _____ ROAD Thompson Drive LOT _____

PROPERTY OWNER Quesenberry 1st street on right past
Heinhardt's store on Rt. 144

ADDRESS same as above .

SPECIFICATIONS 3 bedrooms

DRAIN FIELD _____ DEPTH _____ FEET, BOTTOM AREA _____ SQ. FT.

SEEPAGE PITS _____ ABSORBENT SIDE-WALL AREA _____ SQ. FT.

SEPTIC TANK CAPACITY 1000 GALLONS

FOR GARBAGE GRINDER, INCREASE DISPOSAL AREA 22% & TANK CAPACITY 50%.

OTHER TRENCH-2 feet wide, 100 feet long, 7 feet deep, gravel from 3 feet to 7 feet.
Cast iron pipe from septic tank to beginning of trench. Trench invert at 3 feet below
grade. Call for inspection of trench before gravel is installed. Trench must be
placed on level ground; any question about location ask Sanitarian.

NOTE: ALL PIPE FROM HOUSE TO DISPOSAL AREA MUST BE CAST IRON. PERMIT VOID AFTER 3 YEARS.

NOTE: INSTALL STAND PIPES ON SEPTIC TANK. STAND PIPES MUST BE 6 INCHES IN DIAMETER.
CAST IRON, CONCRETE OR TERRA COTTA ACCEPTED.


PLANS APPROVED BY Frank Skinner DATE 5/26/77

FILL SEPTIC TANK AND DISTRIBUTION BOX WITH WATER BEFORE CALLING FOR AN INSPECTION. COVER NO WORK
UNTIL INSPECTED AND APPROVED.

NEITHER THE HOWARD COUNTY COMMISSIONERS NOR THE HEALTH DEPARTMENT IS RESPONSIBLE FOR THE
SUCCESSFUL OPERATION OF ANY SYSTEM.

25955

(N)

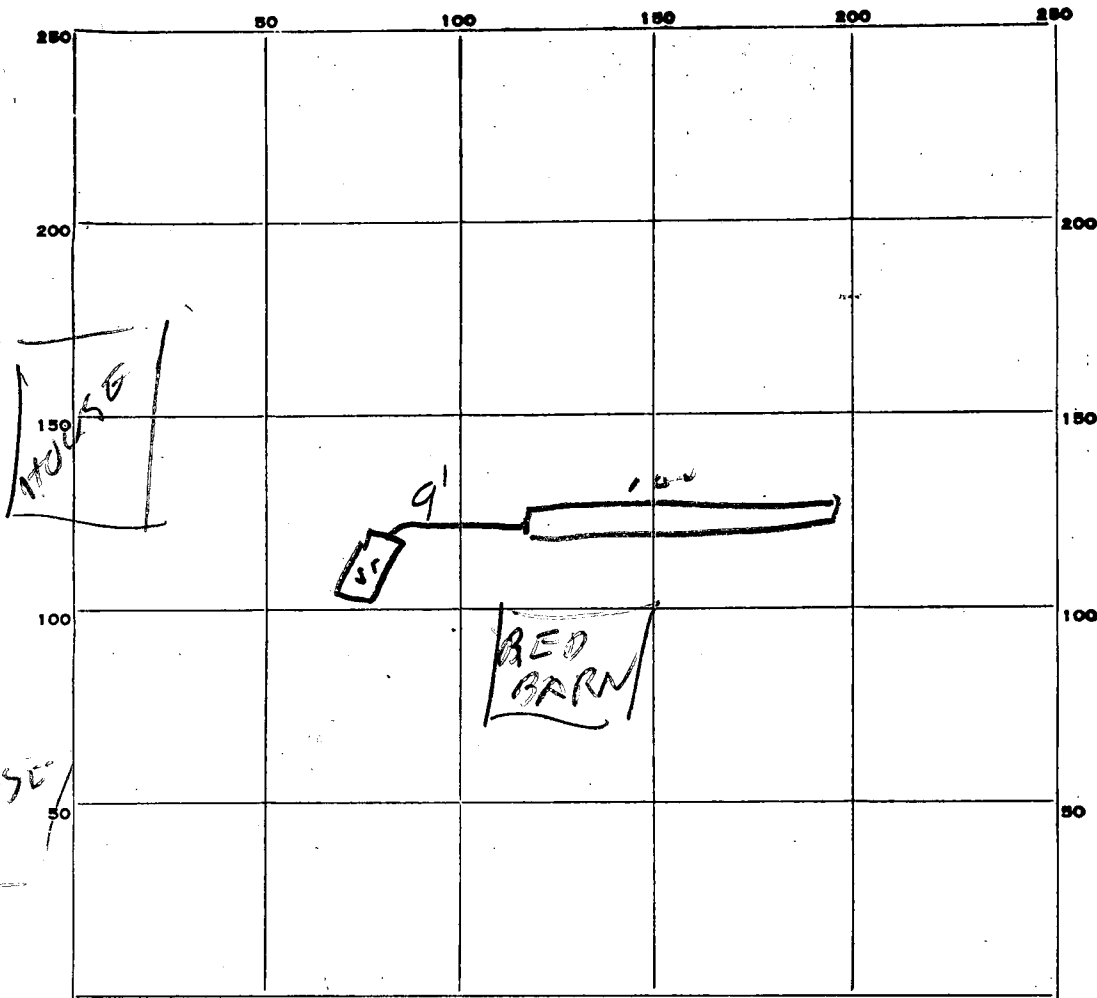

INDICATE NORTH. - NAME ADJOINING ROADWAY AS BASE LINE.

T H O M P S O N A V E

PERMIT CARD OK

SEPTIC TANK, LEVEL old tank

CLEANOUTS _____

DISTRIBUTION BOX, LEVEL _____

TILE FIELD, DEPTH 7 FT. TRENCH WIDTH 2 FT.

GRAVEL DEPTH 4F IN. TOTAL LENGTH 100 FT.

NUMBER OF TRENCHES _____ TOTAL BOTTOM AREA 400 ^{SIDE} ONE SIDE

SEEPAGE PITS, INSIDE DIAMETER _____ FT. DEPTH BELOW INLET _____ FT.

ABSORBENT AREA _____ SQ. FT.

5-3-77
REMARKS

1. cement outlet of tank - put gravel in trench

6/7/77 - STONE ADDED & PIPE CEMENTED (R)

DATE SYSTEM APPROVED

6/7/77

INSPECTOR

Raymond J. Dodge

APPLICATION

SEWAGE DISPOSAL TESTING

STATE OF MARYLAND - DEPARTMENT OF HEALTH AND MENTAL HYGIENE

HOWARD COUNTY HEALTH DEPARTMENT
ENVIRONMENTAL HEALTH SERVICES

P. O. BOX 476, ELLICOTT CITY, MARYLAND 21043
TELEPHONE: 465-5000, EXT. 356

DISTRICT _____

DATE 5/18/77

*26
5/26/77
1:30 PM
Repair pipe*

trench - 2 ft wide, 100 ft. long, 7 ft. deep, gravel from 3' to 7'.
cast iron pipe from septic tank to beginning of trench.
trench invert at 3' below grade. Call for inspection of trench
before gravel is installed. Trench must be placed on level
ground; any question about location ask sanitarian.

TO: THE COUNTY HEALTH OFFICER
ELLICOTT CITY, MARYLAND

I, HEREBY, APPLY FOR THE NECESSARY TEST IN ORDER TO CONSTRUCT (OR RECONSTRUCT) A SEWAGE
DISPOSAL SYSTEM.

PROPERTY OWNER Quesenberry

ADDRESS Thompson Drive PHONE _____

PROPERTY LOCATION:

SUBDIVISION _____ LOT NO. _____

ROAD AND DESCRIPTION go back Thompson Drive until you see an old red barn on the
RIGHT
left hand side. Quesenberry will be directly across from the barn.

SIZE OF LOT _____ TYPE BLDG. 3 or 4
NUMBER OF BEDROOMS

IF NOT SINGLE RESIDENCE DESCRIBE _____

THE SYSTEM INSTALLED UNDER THIS APPLICATION IS ACCEPTABLE ONLY UNTIL PUBLIC
FACILITIES BECOME AVAILABLE.

SIGNATURE OF APPLICANT Jenkins Brothers

APPROVED BY Frank Skinner FOR trench (repair) DATE 5/26/77
(KIND OF SYSTEM)

REJECTED BY _____ FOR _____ DATE _____
(KIND OF SYSTEM)

HOLD PENDING FURTHER TESTS _____ DATE _____

REASONS FOR REJECTION OR HOLDING _____

THIS IS NOT A PERMIT

