

10/19/81

PERMIT

APPROVED
10/19/81
RH

P 31604
A 26194

SEWAGE DISPOSAL SYSTEM

MARYLAND STATE DEPARTMENT OF HEALTH

HOWARD COUNTY

INDEX

05-382769

ELLICOTT CITY

DISTRICT 5th

DATE 8/31/81

Bob Orndorff

IS PERMITTED TO INSTALL X ALTER

ADDRESS 13938 Highland Road, Clarksville, Md. 21029 PHONE 596-9394

SUBDIVISION Hallmark ROAD 7358 Sanner Road LOT 2

PROPERTY OWNER Norman W. Wehland, Jr.

ADDRESS Highland, Md. 20777

SPECIFICATIONS 3 bedrooms

SEPTIC TANK CAPACITY 1000 GALLONS

DRAIN FIELD DEPTH FEET, BOTTOM AREA SQ. FT.

DEEP TRENCH DEPTH FEET, BOTTOM AREA SQ. FT.

SEEPAGE PITS X ABSORBENT SIDE-WALL AREA 120 SQ. FT. per bedroom

INLET PIPE 4 FT. BELOW ORIGINAL GRADE. MAXIMUM DEPTH 10 FT. BELOW ORIGINAL GRADE

EFFECTIVE DEPTH AT FT. BELOW ORIGINAL GRADE.

LOCATE DISPOSAL AREA FT. FROM LOT LINE AND FT. FROM LOT LINE AS SEEN WHEN
FACING LOT FROM

Locate 130 ft from Sanner Rd. 10 ft from left (390 lot line.)

TRENCH: inlet at 14 ft. Max. depth 10 ft. Run on contour towards Rt. lot line (345 ft.)

NOTE: Leave 5 ft. earth buffer between dry well and trench.

PLANS APPROVED BY David J. O'Neill DATE 11/28/77

COVER NO WORK UNTIL INSPECTED AND APPROVED.

NEITHER THE HOWARD COUNTY COUNCIL NOR THE HEALTH DEPARTMENT IS RESPONSIBLE FOR THE SUCCESSFUL OPERATION OF ANY SYSTEM.

NOTE: IF TRENCH IS USED CALL FOR INSPECTION BEFORE PLACING GRAVEL IN TRENCH.

NOTE: NO DRY WELL SHALL EXCEED 15 FOOT IN DIAMETER.

NOTE: ALL PIPE FROM HOUSE TO DISPOSAL AREA MUST BE CAST IRON.

PERMIT VOID AFTER THREE YEARS.


NOTE: INSTALL STAND PIPE ON SEPTIC TANK AND DRY WELL. STAND PIPES MUST BE 6 INCHES IN DIAMETER. CAST IRON, CONCRETE OR TERRA
COTTA ACCEPTED.

*INSTALLER IS RESPONSIBLE FOR OBTAINING FINAL APPROVAL ON THIS PERMIT.

BLDG. PERMIT SIGNED
AND RETURNED 5/23/85

Signal # 53280
Storage Shed EH-2-1079

A26194

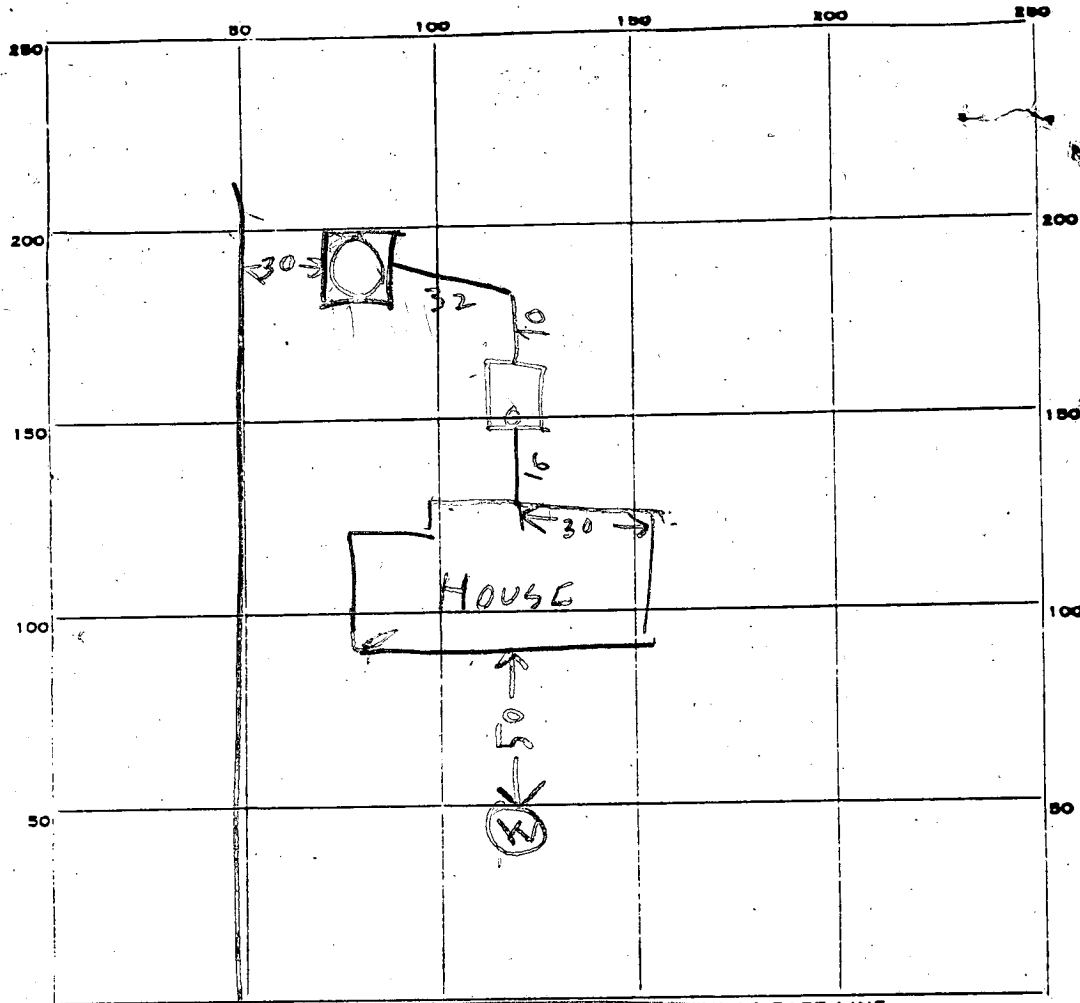

PERMIT CARD NO

SEPTIC TANK, LEVEL OK 1000

CLEANOUTS ST/DW
OK/OK

DISTRIBUTION BOX, LEVEL _____

TILE FIELD, DEPTH _____ FT. TRENCH WIDTH _____ FT.

GRAVEL DEPTH _____ IN. TOTAL LENGTH _____ FT.

NUMBER OF TRENCHES _____ TOTAL BOTTOM AREA _____

SEEPAGE PITS, INSIDE PERIMETER 53 DIAMETER _____ FT. DEPTH BELOW INLET 1 7/8 FT.

ABSORBENT AREA 371 SQ. FT.

REMARKS 10/19/81 LOCATION OK PER PLANS

DW INLET 3 1/2 FT BOG

DATE SYSTEM APPROVED 10/19/81

INSPECTOR Raymond Hodge

Retest
8/9/79
9:30 A.M.

APPLICATION

SEWAGE DISPOSAL TESTING

STATE OF MARYLAND - DEPARTMENT OF HEALTH AND MENTAL HYGIENE

A 30039

P _____

HOWARD COUNTY HEALTH DEPARTMENT
ENVIRONMENTAL HEALTH SERVICES

P.O. BOX 476 ELLICOTT, MARYLAND 21043
TELEPHONE: 992-2330

DISTRICT 5th

DATE 8/1/79

USE ORIGINAL
SPEC 5
8/30/79
RIL

TO: THE COUNTY HEALTH OFFICER
ELLICOTT CITY, MARYLAND

I, HEREBY, APPLY FOR THE NECESSARY TEST IN ORDER TO CONSTRUCT (OR RECONSTRUCT) A SEWAGE DISPOSAL SYSTEM.

PROPERTY OWNER John Mikolasko

ADDRESS 124 Teachers Building, Columbia, Md. 21044 PHONE 995-0212

PROPERTY LOCATION:

SUBDIVISION Hallmark LOT NO. 2, Sec. 1

ROAD AND DESCRIPTION Sanner Road

SIZE OF LOT 1.055 acres m/l TYPE BLDG. 3 or 4 bedrooms

THE SYSTEM INSTALLED UNDER THIS APPLICATION IS ACCEPTABLE ONLY UNTIL PUBLIC FACILITIES BECOME AVAILABLE.

I FULLY UNDERSTAND THE FEE CONNECTED WITH THE FILING OF THIS PERC TEST APPLICATION IS NON-REFUNDABLE UNDER

ANY CIRCUMSTANCES.

SIGNATURE OF APPLICANT /s/ Bruce Burton for John Mikolasko

APPROVED BY _____ FOR _____ DATE _____

REJECTED BY _____ FOR _____ DATE _____

HOLD PENDING FURTHER TESTS _____ DATE _____

REASONS FOR REJECTION OR HOLDING 8/9/79 PERC OK CERT 11-7


NEW TEST HOLE LOCATIONS RIL

copy given to Bruce Burton

THIS IS NOT A PERMIT

SOIL PROFILE

0

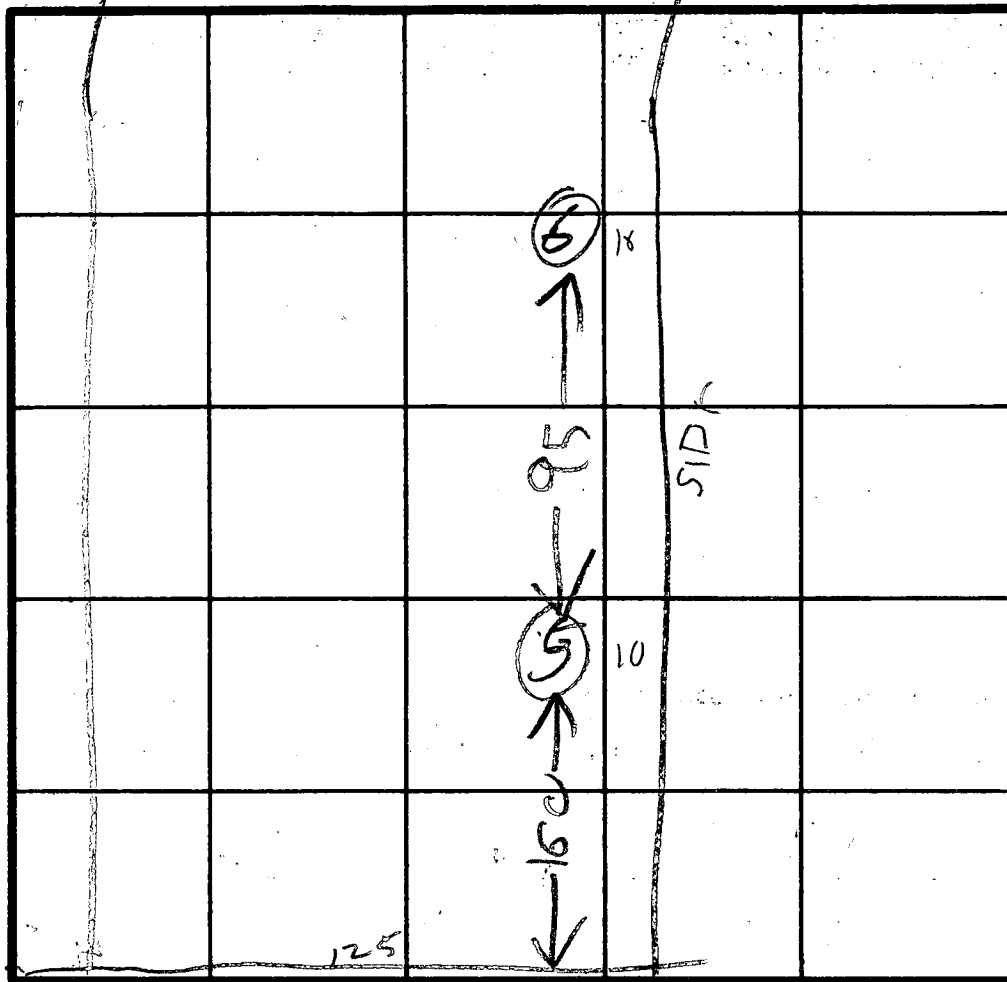

SEE
ATTACHED
PLAT

INDICATE NORTH - NAME ADJOINING ROADWAY AS BASE LINE.

SPANNER RD

DATE	TEST NO.	DEPTH	PRE-WET		TEST - 1" DROP		TIME
			START	STOP	START	STOP	
8/9/79	5S	4 1/2	1001	1018	1018	1040	22
8/9/79	5D	13	1002	1009	1009	1029	20
8/9/79	6S	4 1/2	1016	1024	1024	FAIL	
8/9/79	6D	13 1/2	1016	1020	1020	1029	9
8/9/79	6M	5 1/2	1048	1049	1049	1051	2

REMARKS

TYPE OF SOIL

TESTED BY

BH

ALSO PRESENT B. BURTON, J. MIKOLASCO

Mikolasko

owner

DAO No. 111291 72
prepared by

LOT NUMBER 2

Absorbant Area/bedroom 120

SEPTIC TANK 1000 gal 1250 gal 1500 gal
3 bdrms 4 bdrms 5 bdrms

☒ DRY WELL 4'
inlet

10'
Max. depth

288
Abs. Area

Located 130' From Sanner Rd 10' From left (390' lot line.)

☒ TRENCH 4'
Inlet

10'
Max. depth

# bedrooms	Length	Abs. Area
<u>3</u>	<u>25</u>	<u> </u>
<u>4</u>	<u>50</u>	<u> </u>

To Run on contour towards Rt lot line (395').

If dry well and trench are used leave a 5' earth buffer between them.
If septic tank is 3' or more below grade, use manhole type cleanout to grade.
If more than one trench is used space them parallel, twice their depth apart.
Call office for inspection of trench before placing stone in trench.
All pipe from house to disposal area cast iron.
Install standpipe (6" min.) on septic tank and dry well. Cast iron, concrete, terra cotta ok. Trench distribution lines may be clay, asbestos cement, orangeburg type, open joint cast iron or heavy duty plastic. (Commercial standard Cc228-61).

APPLICATION

A 26194

P _____

SEWAGE DISPOSAL TESTING

STATE OF MARYLAND - DEPARTMENT OF HEALTH AND MENTAL HYGIENE

HOWARD COUNTY HEALTH DEPARTMENT
ENVIRONMENTAL HEALTH SERVICESP. O. BOX 476, ELLICOTT CITY, MARYLAND 21043
TELEPHONE: 465-5000, EXT. 356DISTRICT 5THDATE JUNE 22, 1977BLDG. PERMIT SIGNED
AND RETURNED 5/13/81Serial # 46470TO: THE COUNTY HEALTH OFFICER
ELLICOTT CITY, MARYLANDI, HEREBY, APPLY FOR THE NECESSARY TEST IN ORDER TO CONSTRUCT (OR RECONSTRUCT) A SEWAGE
DISPOSAL SYSTEM.PROPERTY OWNER DONALD SIMPSON Norman W. Wehland Jr.ADDRESS JOHNS HOPKINS ROAD CLARKSVILLE MARYLAND PHONE 725-2847286-2884

PROPERTY LOCATION:

7358 SUBDIVISION HALLMARK SECTION 1 LOT NO. 2# 7358 ROAD AND DESCRIPTION SANNER ROADSIZE OF LOT 40,000 ^{sq} TYPE BLDG. 30R4

NUMBER OF BEDROOMS

IF NOT SINGLE RESIDENCE DESCRIBE _____

THE SYSTEM INSTALLED UNDER THIS APPLICATION IS ACCEPTABLE ONLY UNTIL PUBLIC
FACILITIES BECOME AVAILABLE.SIGNATURE OF APPLICANT Charles J. Conrad BLDG. PERMIT SIGNED
AND RETURNED 9/22/78APPROVED BY DJO McIl FOR DW + Treach DATE 11/28/75

(KIND OF SYSTEM)

REJECTED BY _____ FOR _____ DATE _____

(KIND OF SYSTEM)


HOLD PENDING FURTHER TESTS _____ DATE _____

REASONS FOR REJECTION OR HOLDING _____

B.P. # 36787

THIS IS NOT A PERMIT

10722

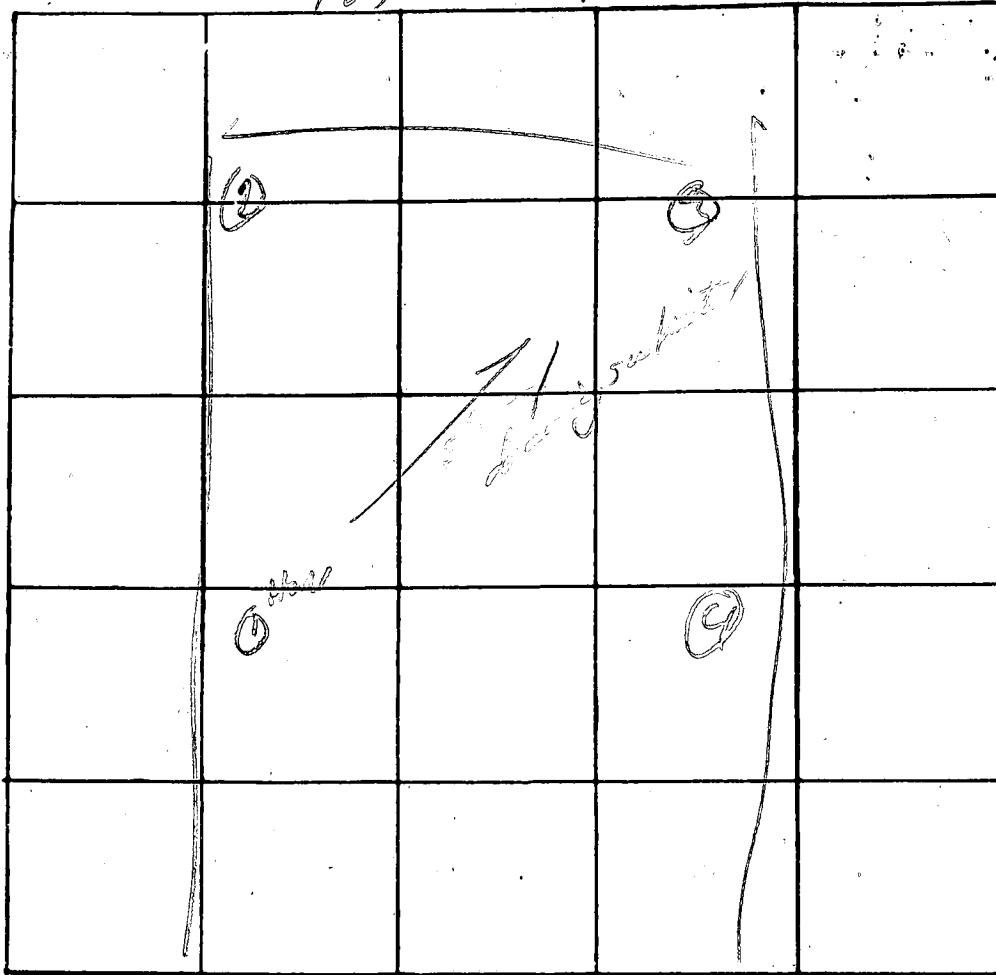

✓ 0.4

INDICATE NORTH. - NAME ADJOINING ROADWAY AS BASE LINE

SAN AN


4' 5X

DATE	TEST NO.	DEPTH	PRE-WET		TEST - 1" DROP		TIME
			START	STOP	START	STOP	
7/13	1s	4 1/2	236	238	238	341	9
	d	13'	236			240	2
	2s	3	238	345	345	251	9
	d	13	238	340	340	345	5
	3s	3	240	242		345	3
	d	13'	240	248	ORANGE		16
	4	UTM	B-13' 0"				

REMARKS _____

TYPE OF SOIL _____

TESTED BY ADON ALSO PRESENT: CROVO Britney

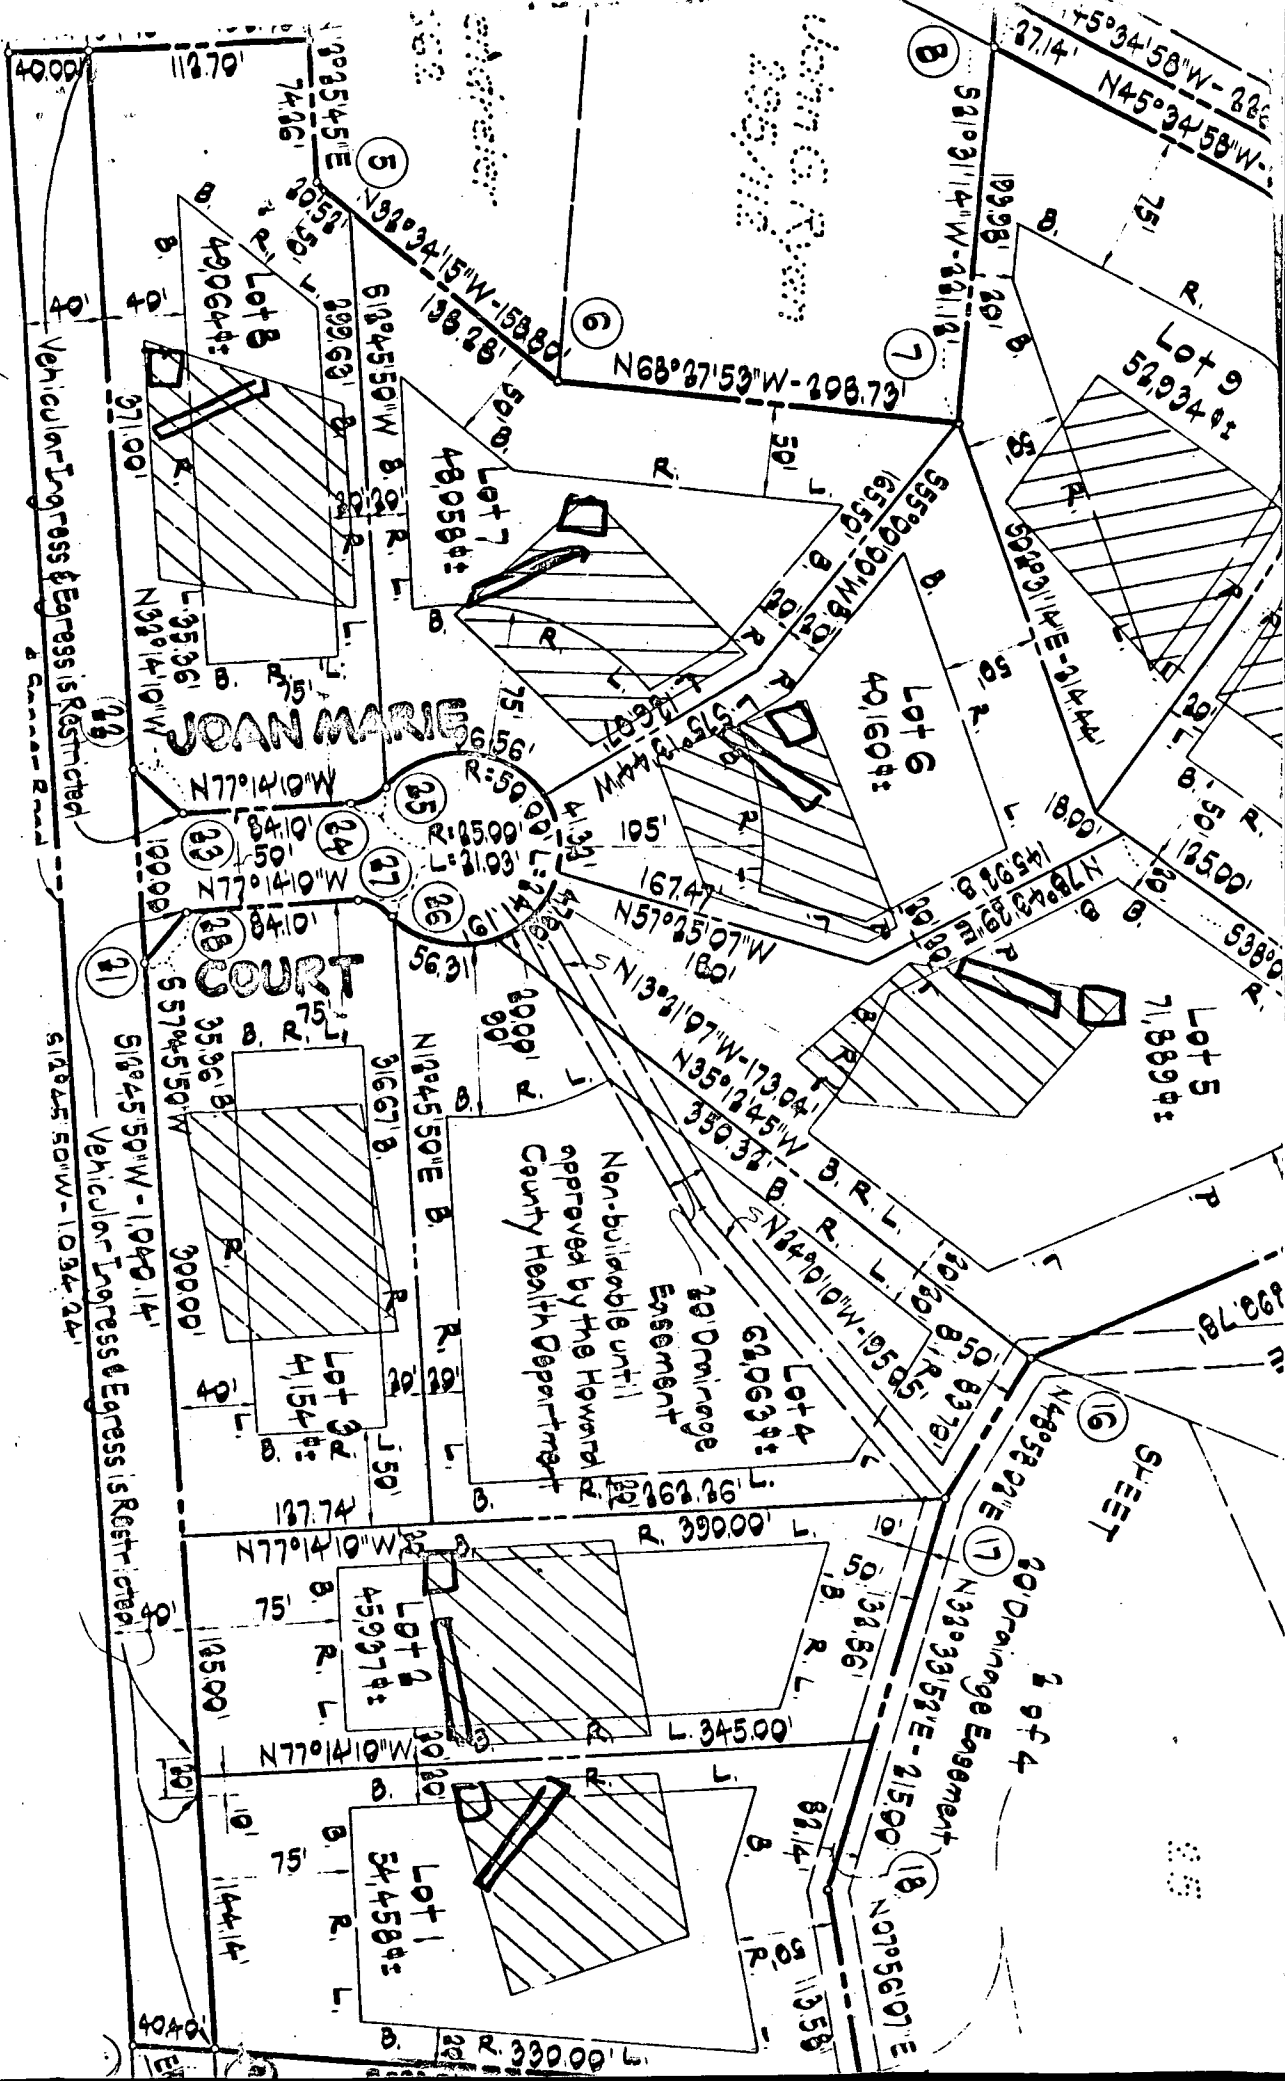

DNR-131 (7-77)										EMERGENCY NO. (If any) -										STATE OF MARYLAND WATER RESOURCES ADMINISTRATION TAWES STATE OFFICE BLDG., ANNAPOLIS, MARYLAND 21401 APPLICATION FOR PERMIT TO DRILL WELL										WRA PERMIT NUMBER HC-25-2046 FILL IN THIS FORM COMPLETELY									
B 1 2414 SEQUENCE NO. (WRA USE ONLY) 1 2 3 (SEQ. NO.) 6 (THIS NUMBER IS TO BE PUNCHED IN COLS. 3-6 ON ALL CARDS)										DATE RECEIVED (WRA USE ONLY) 7/5/78 1:30 P.M.										OWNER COL 15 LAST NAME Mikolaski COL 36 2205 STREET OR RFD Hoxby Rd. COL 57 Timonium MD. POST OFFICE										FIRST NAME John COL 34 COL 55 COL 76									
B 1 CONTINUED 1 2 3 (SEQ. NO.) 6 DATE March 7, 1978 LICENSE NUMBER 238 77 80 Joseph L. Mayne FIRST NAME DRILLER LAST NAME SIGNATURE Joseph L. Mayne										B 3 LOCATION OF WELL 1 2 3 (SEQ. NO.) 6 COUNTY Howard (DO NOT ABBREVIATE COUNTY NAME) 21 SUBDIVISION Hall Mark 23 42 SECTION G 44 46 LOT 48 50 NEAREST TOWN Fulton 52 MILES FROM TOWN (ENTER 0 IF IN TOWN) 2 7/10 73 76 77 78										B 4 DIRECTION FROM TOWN (CIRCLE APPROPRIATE BOX) 1 2 3 (SEQ. NO.) 6 N NORTH E EAST NE NORTHEAST SE SOUTHEAST S SOUTH W WEST NW NORTHWEST SW SOUTHWEST NEAR WHAT Harrison Road ON WHICH SIDE OF ROAD (CIRCLE APPROPRIATE BOX) N S E W 32 32 32 32 DISTANCE FROM ROAD (ENTER DISTANCE AND CIRCLE APPROPRIATE BOX) 40 34 37 38 39																			
B 2 WELL INFORMATION 1 2 3 (SEQ. NO.) 6 MAXIMUM PUMPING RATE (GALLONS PER MINUTE) 5 8 12 AVERAGE DAILY QUANTITY NEEDED (GALLONS PER DAY) 750 14 20 USE FOR WATER (CIRCLE APPROPRIATE BOX) D HOME (SINGLE OR DOUBLE HOUSEHOLD UNIT ONLY) F FARMING, AGRICULTURE, IRRIGATION 19A2 I INDUSTRIAL, COMMERCIAL, STATE AND FEDERAL GOVERNMENT. M MUNICIPAL WATER SUPPLY P PRIVATE WATER COMPANY T TEST MUST HAVE STATE HEALTH DEPT. APPROVAL										APPROXIMATE DEPTH OF WELL 24 200 26 FEET APPROXIMATE DIAMETER OF WELL 6 (NEAREST INCH) METHOD OF DRILLING USED (CIRCLE APPROPRIATE METHOD) BORED (OR AUGERED) JETTED DRIVEN 30-37 AIR-ROTARY AIR-PERCUSSION ROTARY (HYDRAULIC ROTARY) CABLE REVERSE-ROTARY DRIVE-POINT OTHER (DESCRIBE)										REPLACEMENT OR DEEPEINED WELLS (CIRCLE APPROPRIATE BOX) N THIS WELL WILL NOT REPLACE AN EXISTING WELL Y THIS WELL WILL REPLACE A WELL THAT WILL BE ABANDONED AND SEALED S THIS WELL WILL REPLACE A WELL THAT WILL BE USED AS A STANDBY D THIS WELL WILL DEEPEIN AN EXISTING WELL PERMIT NUMBER OF WELL TO BE REPLACED OR DEEPEINED (IF AVAILABLE)																			
NOT TO BE FILLED IN BY DRILLER (WRA USE ONLY) APPROPRIATION PERMIT NUMBER 54 ENGINEER REVIEW DISTRICT NO. 63 FORCE 67 68 WRITE INITIALS IN BOX CONDITIONS 70 71 72 73 74 75 76 77 78 79										B 4 CONTINUED 1 2 3 (SEQ. NO.) 6 41 5 STATE HEALTH (CIRCLE BOX) MO. DAY YR. DATE 0303-78 43 48 HEALTH DEPARTMENT APPROVAL Howard COUNTY NAME 1127636 COUNTY NO. APPROVED BY Donald W. Monagan, Sanitarian										B 5 SPECIAL CONDITIONS 8-63 (WRA USE ONLY) 1 2 3 (SEQ. NO.) 6																			
B 4 CONTINUED 1 2 3 (SEQ. NO.) 6 41 5 STATE HEALTH (CIRCLE BOX) MO. DAY YR. DATE 0303-78 43 48 HEALTH DEPARTMENT APPROVAL Howard COUNTY NAME 1127636 COUNTY NO. APPROVED BY Donald W. Monagan, Sanitarian										B 5 SPECIAL CONDITIONS 8-63 (WRA USE ONLY) 1 2 3 (SEQ. NO.) 6										B 5 SPECIAL CONDITIONS 8-63 (WRA USE ONLY) 1 2 3 (SEQ. NO.) 6																			

52ft casing
27ft open hole well
jetted to 51 ft open hole
1ft casing above grade
10 bags cement

GLK 7/5/78

John Hopkins Rd.

Fulton


0/5

5/5

0/0

5/0

C 1 3732 (THIS NUMBER IS TO BE PUNCHED IN COLS. 3-6 ON ALL CARDS)		SEQUENCE NO. (WRA USE ONLY)		STATE OF MARYLAND WATER RESOURCES ADMINISTRATION TAWES STATE OFFICE BLDG., ANNAPOLIS, MD. 21401 WELL COMPLETION REPORT		THIS REPORT MUST BE SUBMITTED WITHIN 30 DAYS AFTER WELL COMPLETION FILL IN THIS FORM COMPLETELY COUNTY NUMBER	
DATE RECEIVED (WRA USE ONLY)		DEPTH OF WELL DATE WELL COMPLETED: 15 20 1985 22 (TO NEAREST FOOT) 26		PERMIT NO. FROM "PERMIT TO DRILL WELL" 10-73-2696 28 29 30 31 32 33 34 35 36 37			
OWNER: <u>Michael...</u> LAST NAME		STREET OR RFD: <u>2905...</u>		POST OFFICE: <u>...</u> FIRST NAME: <u>...</u>			
WELL LOG		WELL DESCRIPTION					
STATE THE KIND OF FORMATIONS PENETRATED, THEIR COLOR, DEPTH, THICKNESS AND IF WATER BEARING		GROUTING RECORD WELL HAS BEEN GROUTED (CIRCLE APPROPRIATE BOX) YES ☒ NO ☐ TYPE OF GROUTING MATERIAL (CIRCLE BOX) CEMENT ☒ BENTONITE CLAY ☐ NO. OF BAGS <u>10</u> NO. OF POUNDS <u>940</u> GALLONS OF WATER <u>66</u> DEPTH OF GROUT SEAL (TO NEAREST FOOT) FROM <u>0</u> FT. TO <u>50</u> FT. (ENTER 0 IF FROM SURFACE)					
DESCRIPTION (USE ADDITIONAL SHEETS IF NECESSARY)		CASING RECORD INSERT APPROPRIATE CODE BELOW STEEL ☒ CONCRETE ☐ PLASTIC ☐ OTHER ☐ MAIN CASING TYPE <u>ST</u> NOMINAL DIAMETER TOP (MAIN) CASING (NEAREST INCH) <u>6</u> TOTAL DEPTH OF MAIN CASING (NEAREST FOOT) <u>52</u> 60 61 63 64 66 70					
47 47 785		OTHER CASING (IF USED) DIAMETER (INCH) DEPTH (FEET) FROM TO 60 61 63 64 66 70					
		SCREEN RECORD INSERT APPROPRIATE CODE BELOW STEEL ☒ BRASS OR BRONZE ☐ OPEN HOLE ☐ PLASTIC ☐ OTHER ☐ C 2 1 2 3 (SEQ. NO.) 6 DEPTH (NEAREST WHOLE FOOT) FROM <u>40</u> TO <u>785</u> 8 9 11 15 17 21 23 24 26 30 32 36 38 39 41 45 47 51 SLOT SIZE 1. 2. 3.					
		C 3 1 2 3 (SEQ. NO.) 6 PUMPING TEST HOURS PUMPED (TO NEAREST HOUR) <u>4</u> PUMPING RATE (GALLONS PER MINUTE TO NEAREST GALLON) <u>4</u> METHOD USED TO MEASURE PUMPING RATE <u>...</u> WATER LEVEL: (DISTANCE FROM LAND SURFACE) BEFORE PUMPING <u>65</u> (NEAREST FOOT) WHEN PUMPING <u>5</u> (NEAREST FOOT) TYPE OF PUMPED USED (CIRCLE APPROPRIATE BOX) (FOR PUMPING TEST) AIR ☐ PISTON ☐ TURBINE ☐ CENTRIFUGAL ☐ ROTARY ☐ OTHER (DESCRIBE BELOW) ☐ JET ☐ SUBMERSIBLE ☐					
CIRCLE APPROPRIATE BOXES ☐ A WELL WAS ABANDONED AND SEALED WHEN THIS WELL WAS COMPLETED ☐ E ELECTRIC LOG OBTAINED ☐ P TEST WELL CONVERTED TO PRODUCTION WELL I HEREBY CERTIFY THAT I HAVE COMPLIED WITH ALL CONDITIONS STATED ON THE ABOVE-CAPTIONED "PERMIT TO DRILL WELL", AND THAT INFORMATION CONTAINED IN THIS REPORT IS TRUE, ACCURATE, AND COMPLETE TO THE BEST OF MY KNOWLEDGE, INFORMATION AND BELIEF. DRILLERS NAME: <u>Joseph L. Wayne</u> (PLEASE PRINT) SIGNATURE: <u>Joseph L. Wayne</u>		PUMP INSTALLED TYPE OF PUMP (WRITE APPROPRIATE LETTER IN BOX - SEE ABOVE: A, C, J, P, R, S, T, O) DRILLER WILL INSTALL PUMP (CIRCLE APPROPRIATE BOX) YES ☒ NO ☐ CAPACITY: GALLONS PER MINUTE (TO NEAREST GALLON) <u>31</u> <u>35</u> PUMP HORSE POWER <u>37</u> <u>41</u> PUMP COLUMN LENGTH (NEAREST FOOT) <u>43</u> <u>47</u> CASING HEIGHT (CIRCLE APPROPRIATE BOX AND ENTER CASING HEIGHT) ABOVE ☒ BELOW ☐ LAND SURFACE <u>50</u> (NEAREST FOOT) LOCATION OF WELL ON LOT SHOW PERMANENT STRUCTURE SUCH AS BUILDINGS, SEPTIC TANKS, AND/OR OTHER LAND MARKS AND INDICATE NOT LESS THAN TWO DISTANCES (MEASUREMENTS TO WELL). 					
		WRA USE ONLY (NOT TO BE FILLED IN BY DRILLER) T ☐ (E.R.O.S.) ☐ W Q ☐ 70 72 74 75 76 TELESCOPE CASING LOG INDICATOR OTHER DATA AVAILABLE					
		HEALTH					

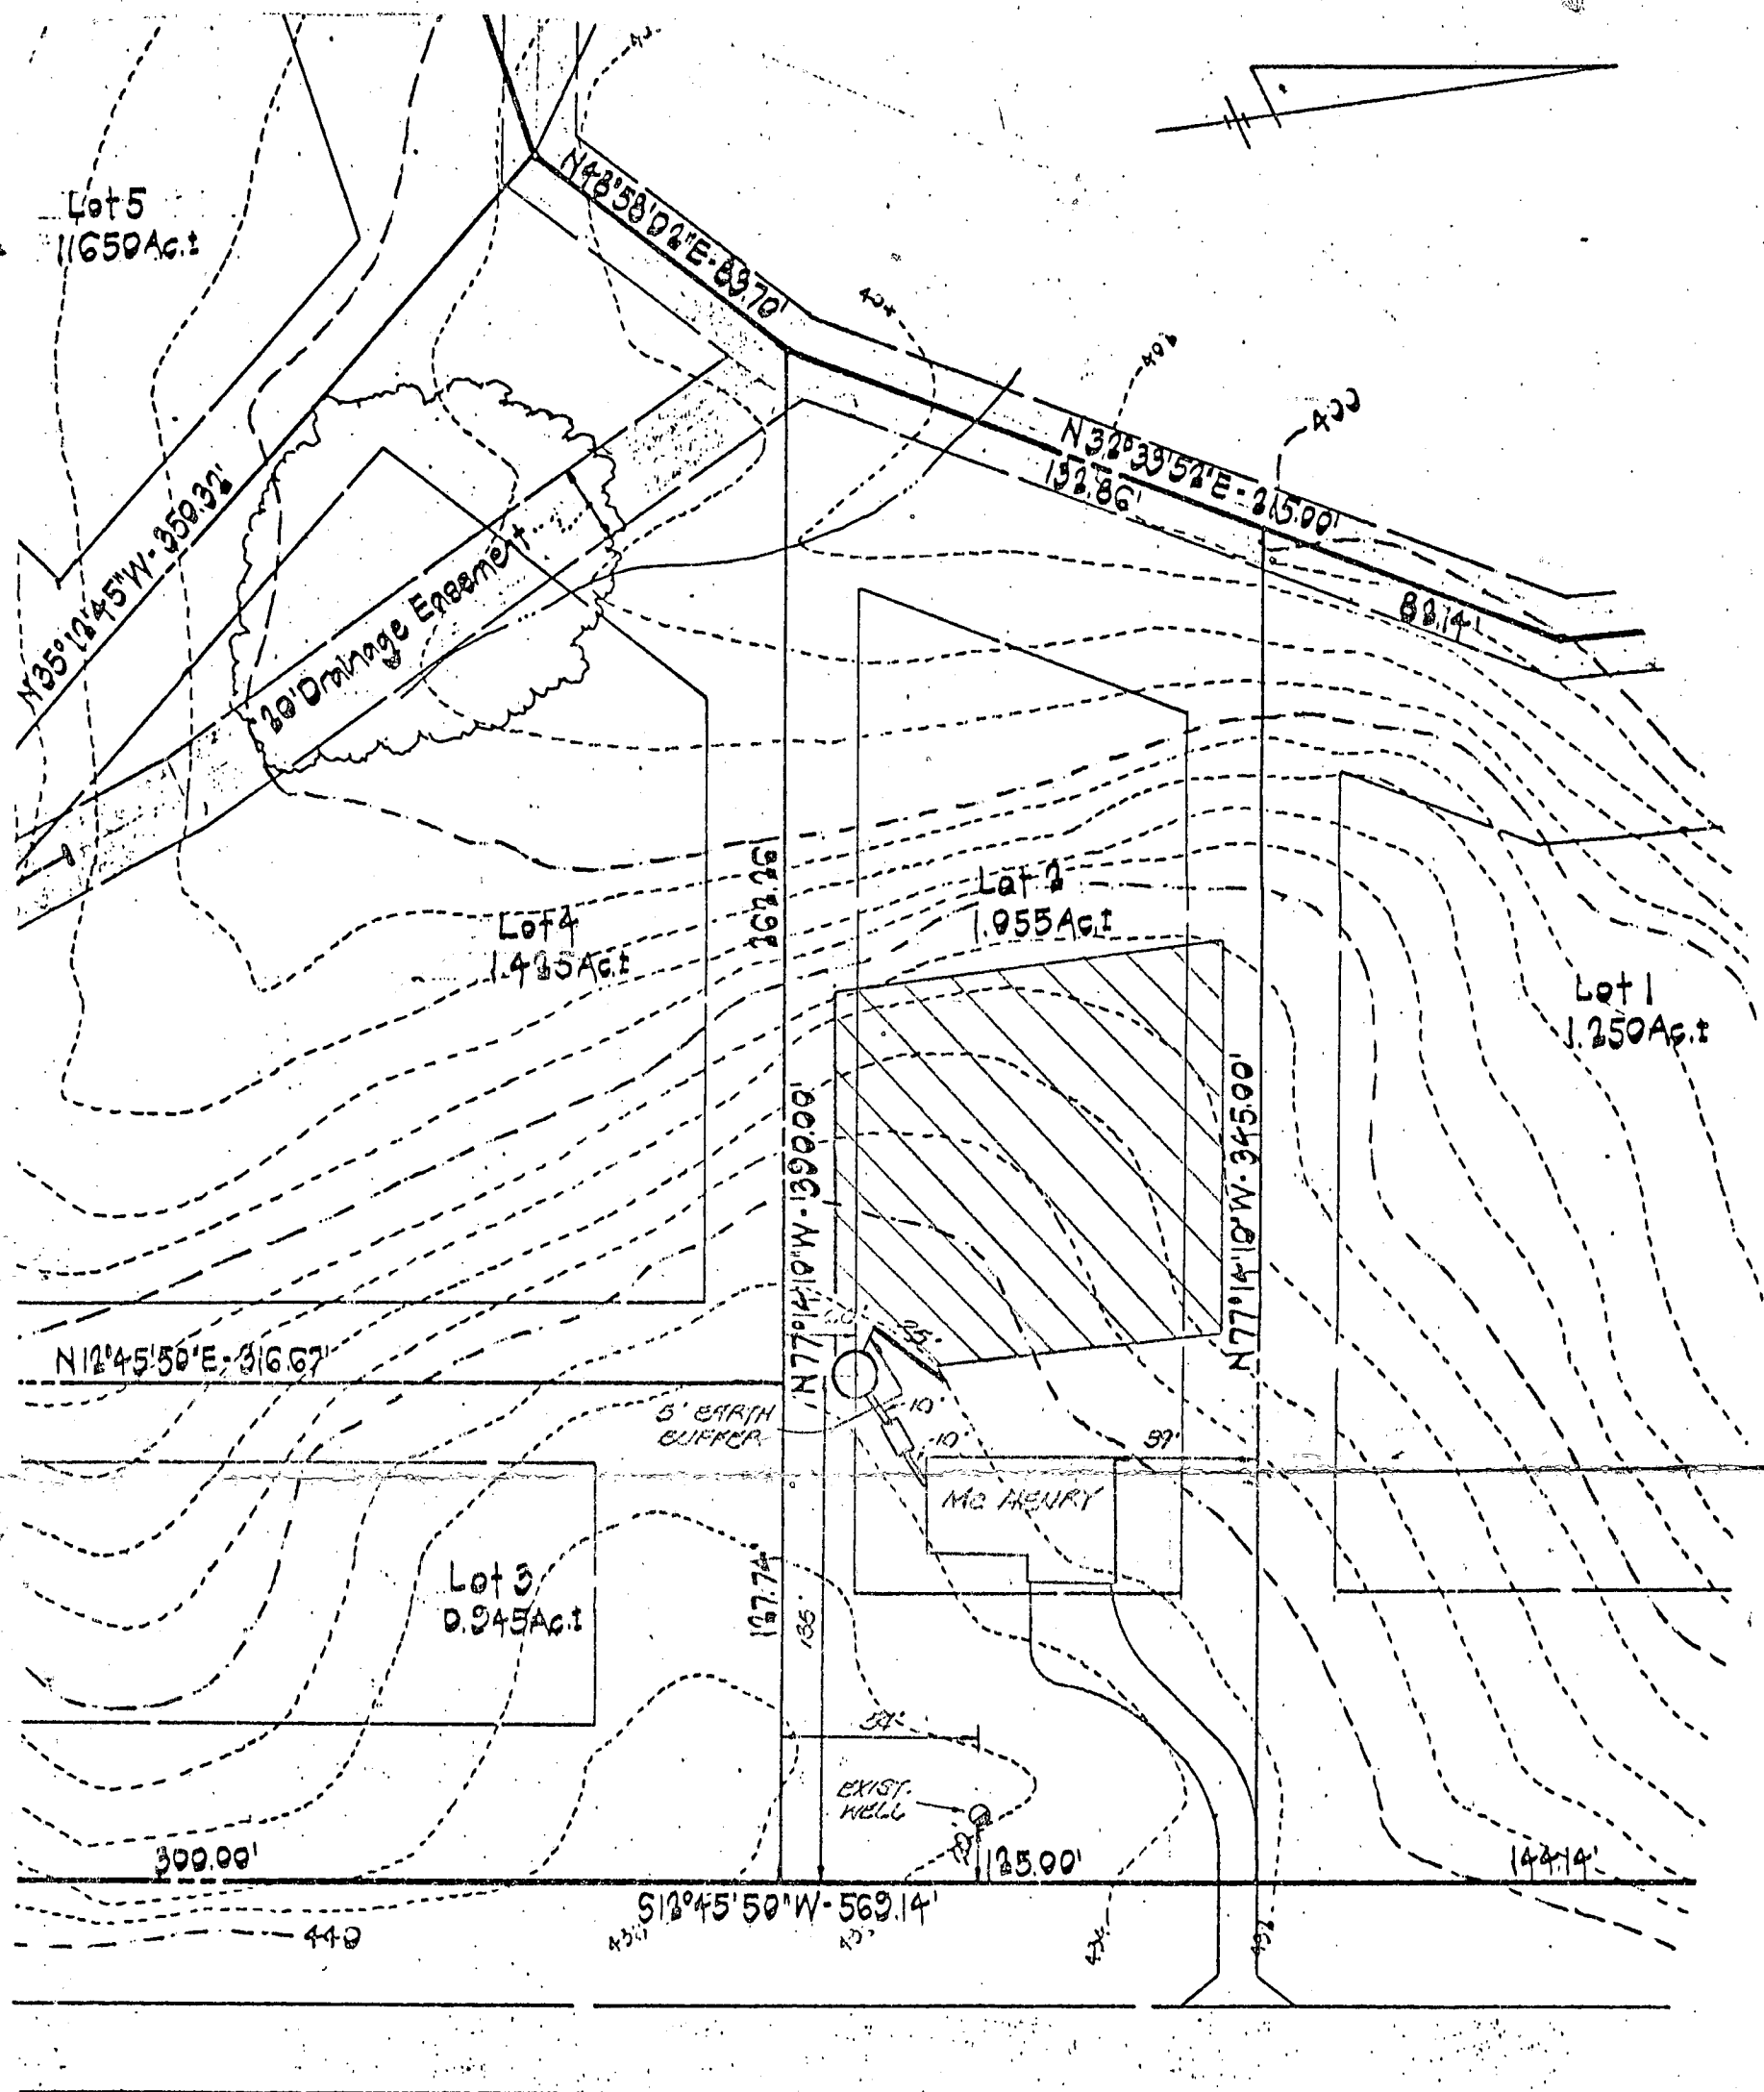

SANNER

ROAD

OK 10/20/94
9/22/95

HOUSE :
FIRST FLOOR ELEV. : 433.50
BASEMENT ELEV. : 425.50
INVERT OUT OF HOUSE : 429.60

SEPTIC TANK :
EXIST. GRO : 432.50
PROP GRO : 432.50
INVERT IN : 429.45
INVERT OUT : 429.15

DRYWELL :
EXIST. GRO : 433.00
PROP GRO : 433.00
INVERT IN : 429.00
INVERT OUT : 428.70

TRENCH :
INVERT IN : 428.50

WATER WELL :
EXIST. GRO. : 432.20
PROP GRO. : 430.20

GRADING STUDY
"HALLMARK"
LOT 2

5TH ELECTION DISTRICT
HOWARD CO., MO.
SCALE : 1" = 50' DATE : 9/21/78

APPROVED FOR PRIVATE WATER AND PRIVATE
SEWERAGE SYSTEMS. HOWARD CO.
HEALTH DEPARTMENT.


Joseph M. Boyd, M.D. 8-29-79
COUNTY HEALTH OFFICER DATE

Per: D.F.W.

NOTES:

1. THE LOTS SHOWN HEREON COMPLY WITH MINIMUM OWNERSHIP WIDTH
AND LOT AREA AS REQUIRED BY THE MD. STATE DEPT. OF HEALTH AND
MENTAL HYGIENE.

2. THIS AREA DESIGNATES A PRIVATE SEWAGE EASEMENT OF
APPROX. 10,000 SQ. FT. AS REQUIRED BY THE MD. STATE DEPT. OF
HEALTH AND MENTAL HYGIENE FOR INDIVIDUAL SEWAGE DISPOSAL.
IMPROVEMENTS OF ANY NATURE ARE RESTRICTED UNTIL PUBLIC
SEWERAGE IS AVAILABLE AND SERVICING ANY RESIDENTIAL STRUC-
TURES CONSTRUCTED ON THESE BUILDING SITES. THIS EASEMENT
SHALL BECOME NULL AND VOID UPON CONNECTION TO A PUBLIC
SEWAGE SYSTEM.

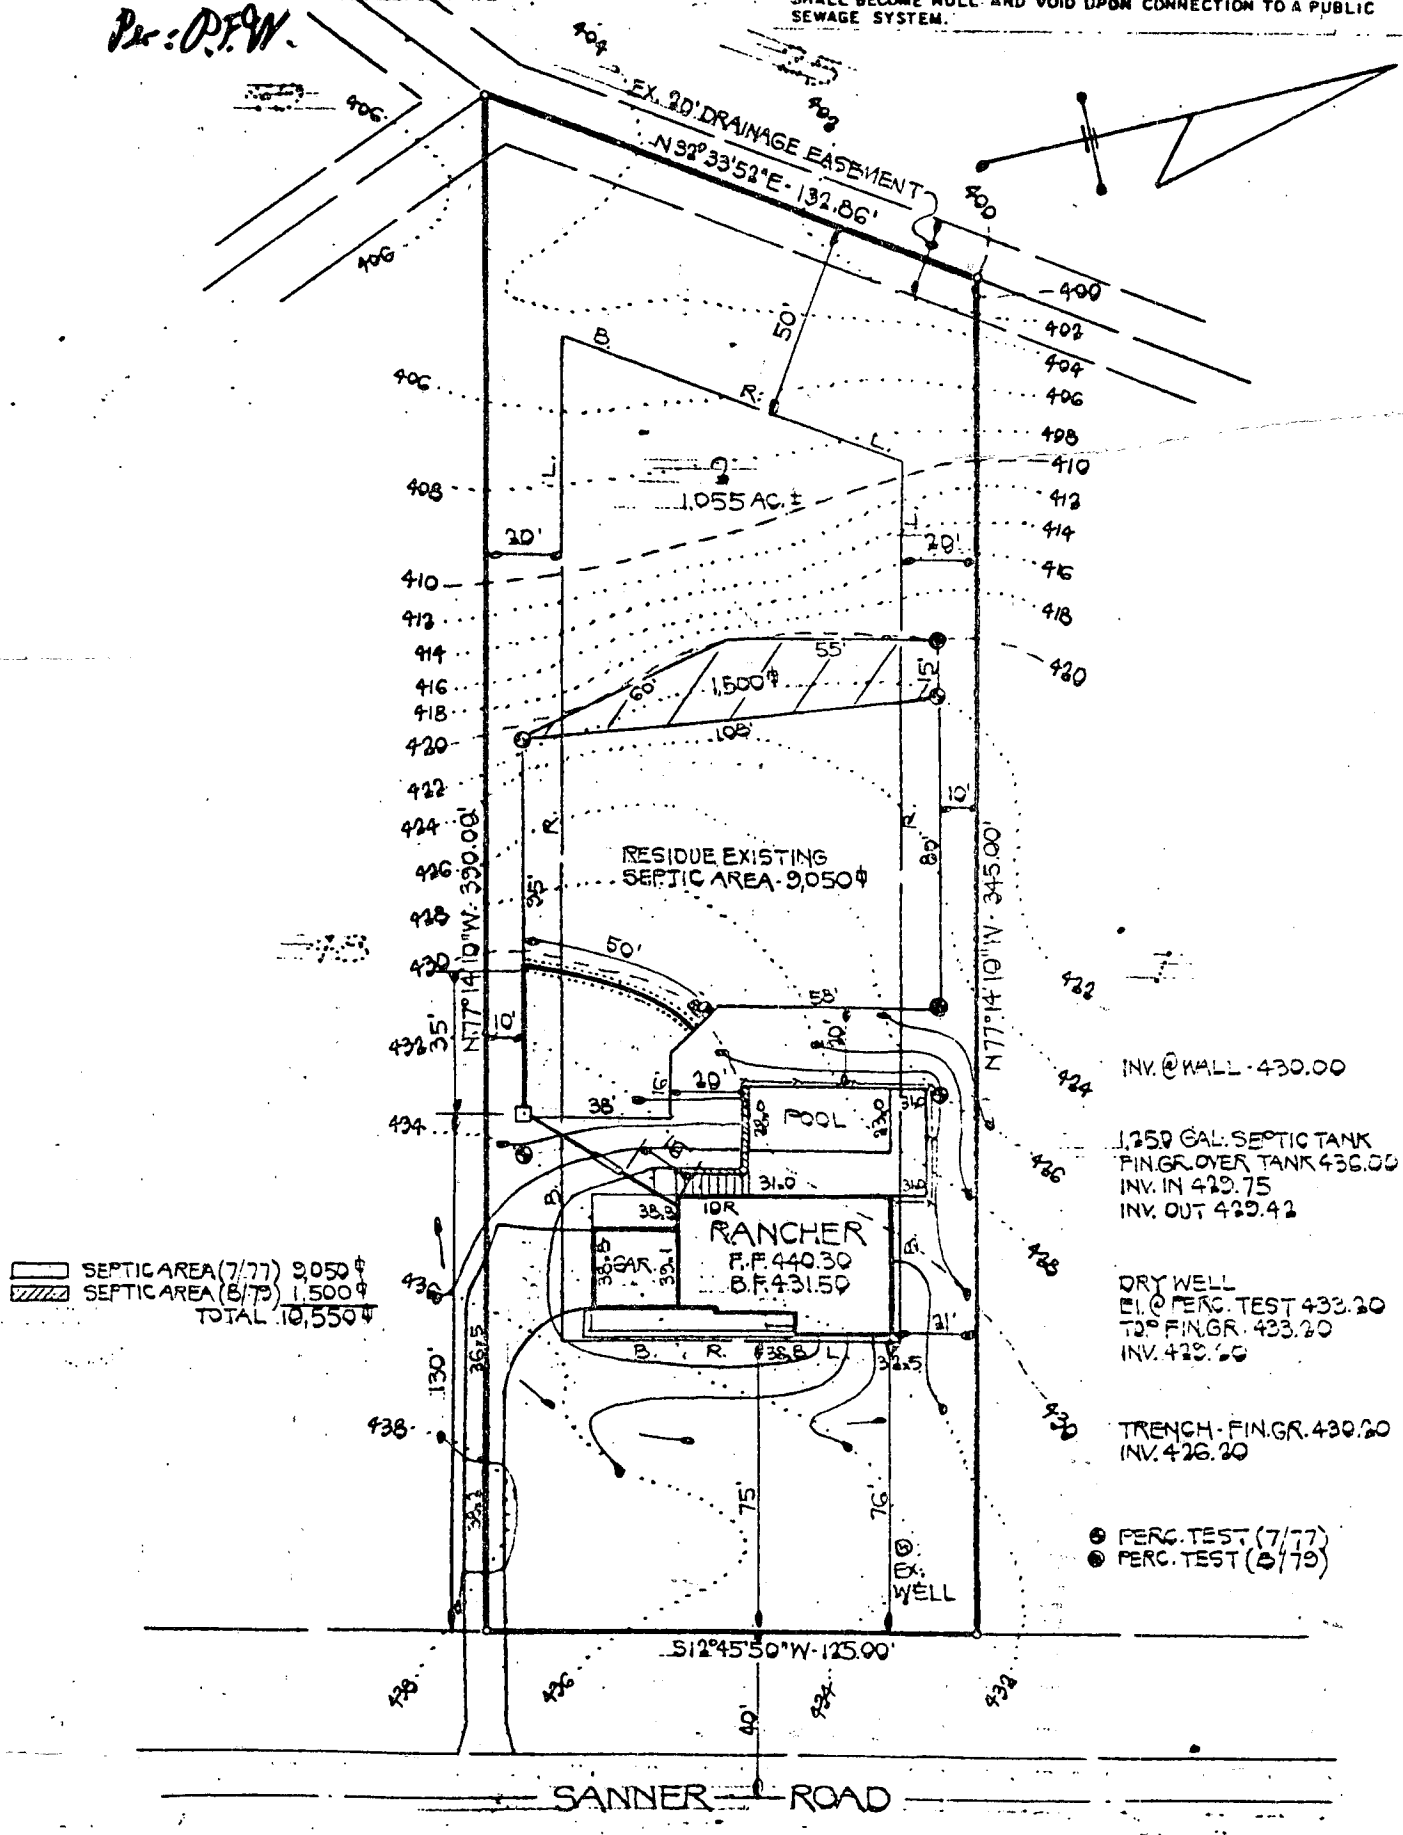

A PRIVATE RESIDENCE FOR:
MR. & MRS. EDWARD M. PRIBYL

I CERTIFY THAT THE ABOVE MEASUREMENTS ARE ACTUAL AND
CORRECT FOR THIS PROPERTY.

JOHN F. BURTON, M.D. REG. NO. 3416

3/20/79
DATE

BURTON ASSOCIATES

CIVIL ENGINEERS · LAND SURVEYORS
LAND PLANNERS · LANDSCAPE ARCHITECTS

210 SHADY NOOK CT. BALTO., MD. 21228 301-744-8471

SITE DEVELOPMENT PLAN

HALLMARK
SECTION ONE
LOT 2

5TH ELECTION DISTRICT HOWARD COUNTY, MARYLAND

DATE: JULY 30, 1979 DRAWN: B.D.B. JOB NO.: 9047
SCALE: 1" = 50' CHECKED: B.D.B. FILE NO.: H-002