

11-07-85

approved

S. Abel

P 36176

A 26754

PERMIT

SEWAGE DISPOSAL SYSTEM

MARYLAND STATE DEPARTMENT OF HEALTH

02-248387

INDEXED

HOWARD COUNTY

BUREAU OF ENVIRONMENTAL HEALTH

461-9933

ELLICOTT CITY

DISTRICT 2nd

DATE 11/05/85

Thornbrook Corporation (Emerson Feaga) IS PERMITTED TO INSTALL ☒ ALTER

ADDRESS PHONE 442-5623

SUBDIVISION Mt. Hebron ROAD 2608 Thornbrook Road LOT 1, Section 16

PROPERTY OWNER Thornbrook Corporation

2106 Mt. Hebron Drive

ADDRESS Ellicott City, Maryland 21043

IF GARBAGE GRINDER IS USED INCREASE SEPTIC TANK CAPACITY BY 50% AND ABSORPTION AREA BY 22%.

GARBAGE GRINDER? YES NO ☒

SEPTIC TANK CAPACITY 1000 GALLONS NUMBER OF BEDROOMS 3

TRENCHES - 158 sq. ft. per bedroom. Trench to be 2 feet wide. Inlet 2 1/2 feet below original grade. Bottom maximum depth 7 1/2 feet below original grade. Effective area begins at 2 1/2 feet below original grade. 5 feet of stone below distribution pipe. LOCATION: Start first trench 50 feet from the front lot line and 10 feet from the left lot line as seen when facing the property from Thornbrook Road. Run trench(s) along level ground toward lot line. O.K. to place septic tank out the back of house and pipe to trench in front of house.

NOTE: No trench to exceed 100 feet in length. If more than one trench used, a distribution box is required. Call for inspection of trench before and after gravel is installed. Provide 6" - 8" diameter cleanout and cap to grade or above on septic tank.

11/6/85 O.K. to use a 50 ft long trench @ 5 ft gravel depth on public sewer in embankment F.S.

PLANS APPROVED BY Frank Skinner/Craig Williams DATE 5/23/85/7/17/84

COVER NO WORK UNTIL INSPECTED AND APPROVED.

NEITHER THE HOWARD COUNTY COUNCIL NOR THE HEALTH DEPARTMENT IS RESPONSIBLE FOR THE SUCCESSFUL OPERATION OF ANY SYSTEM.

NOTE: IF TRENCH IS USED CALL FOR INSPECTION BEFORE AND AFTER PLACING GRAVEL IN TRENCH.

NOTE: NO DRY WELL SHALL EXCEED 15 FOOT IN DIAMETER. NO ABSORPTION TRENCH TO EXCEED 100 FEET IN LENGTH.

NOTE: ALL PIPE FROM HOUSE TO SEPTIC TANK MUST BE CAST IRON OR SCHEDULE 40 PVC OR ABS.

PERMIT VOID AFTER THREE YEARS.


NOTE: INSTALL STAND PIPE ON SEPTIC TANK AND DRY WELL. STAND PIPES MUST BE 6 INCHES IN DIAMETER. CAST IRON, CONCRETE OR TERRA COTTA. OR PVC OR ABS ACCEPTED. IF TOP OF SEPTIC TANK IS DEEPER THAN 3 FEET MANHOLE TO GRADE REQUIRED.

*INSTALLER IS RESPONSIBLE FOR OBTAINING FINAL APPROVAL ON THIS PERMIT

*CALL 992-2330 FOR INSPECTION OF SEPTIC SYSTEMS.

EH - 2-1082

A 26754

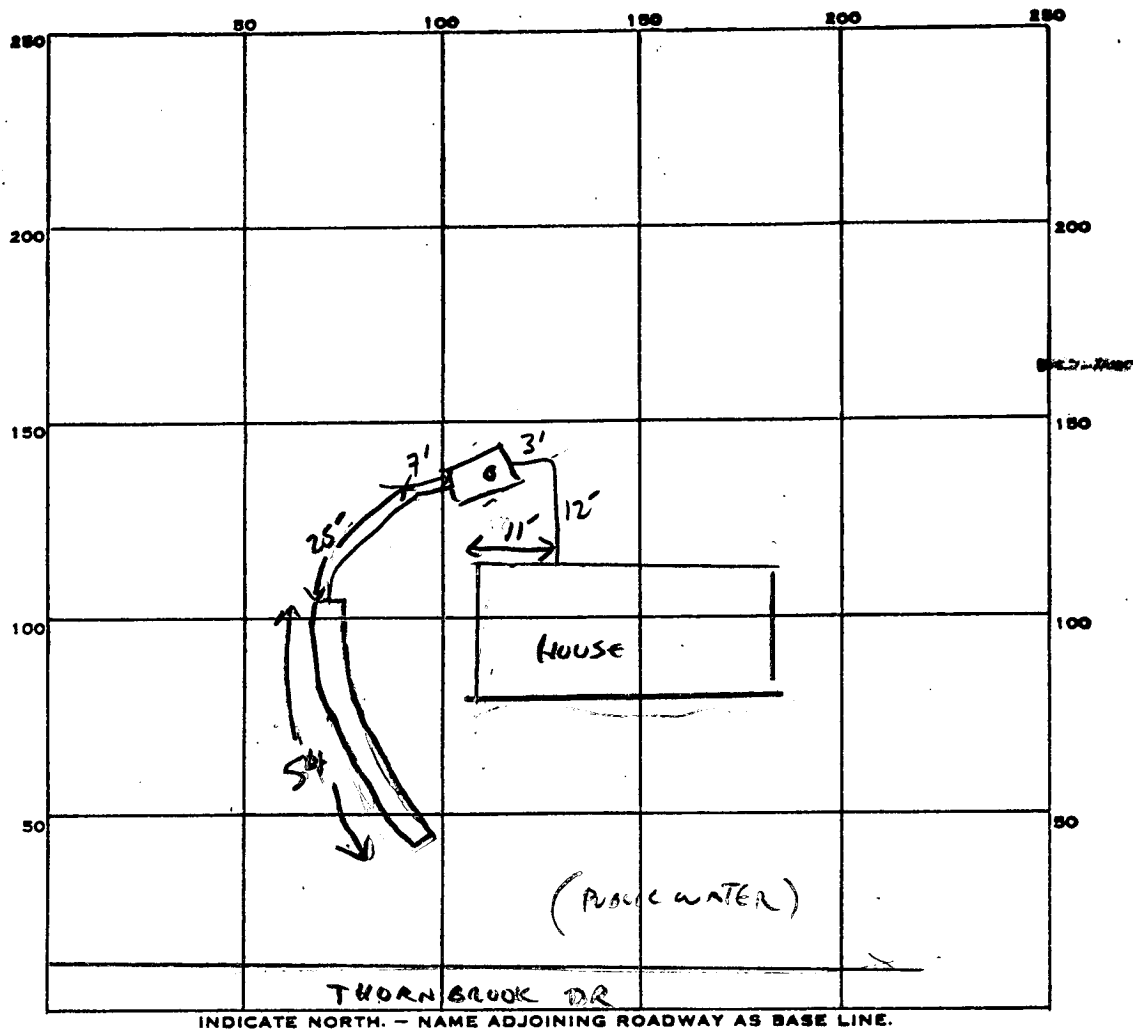

PERMIT CARD ☒

SEPTIC TANK, LEVEL ☒

CLEANOUTS ☒ STV

DISTRIBUTION BOX, LEVEL ☐

TILE FIELD, DEPTH 7 1/2 FT. TRENCH WIDTH 2 FT. INLET 2.5'

GRAVEL DEPTH 5 FE ☒ TOTAL LENGTH 54 FT.

NUMBER OF TRENCHES 1 ONE SIDEWAY TOTAL BOTTOM AREA 270 ☒

SEEPAGE PITS, INSIDE DIAMETER FT. DEPTH BELOW INLET FT.

ABSORBENT AREA 270 SQ. FT.

REMARKS OK TO ADD STONE TO TRENCH 1/1/85 CW.

DATE SYSTEM APPROVED 11-07-85 INSPECTOR S. Abel

PRELIMINARY

APPLICATION

lot 1

26754
A 26754

SEWAGE DISPOSAL TESTING

P. _____

STATE OF MARYLAND - DEPARTMENT OF HEALTH AND MENTAL HYGIENE

HOWARD COUNTY HEALTH DEPARTMENT
ENVIRONMENTAL HEALTH SERVICES

DISTRICT 2nd

P. O. BOX 476, ELLICOTT CITY, MARYLAND 21043
TELEPHONE: 465-5000, EXT. 356

DATE 8/19/77

TO: THE COUNTY HEALTH OFFICER
ELLICOTT CITY, MARYLAND

I, HEREBY, APPLY FOR THE NECESSARY TEST IN ORDER TO CONSTRUCT (OR RECONSTRUCT) A SEWAGE DISPOSAL SYSTEM.

PROPERTY OWNER Thornbrook Corporation

ADDRESS 2106 Mt. Hebron Drive, Ellicott City, Md. PHONE 465-2869

PROPERTY LOCATION:

SUBDIVISION Mt. Hebron LOT NO. 1, Sec. 16

ROAD AND DESCRIPTION Tiller Drive 2608 Thornbrook Road

SIZE OF LOT 22,000 sq. ft. TYPE BLDG. 3 or 4 bedrooms
NUMBER OF BEDROOMS

IF NOT SINGLE RESIDENCE DESCRIBE _____

THE SYSTEM INSTALLED UNDER THIS APPLICATION IS ACCEPTABLE ONLY UNTIL PUBLIC FACILITIES BECOME AVAILABLE.

SIGNATURE OF APPLICANT /s/ H. J. Baker, Jr.

APPROVED BY _____ FOR _____ DATE _____
(KIND OF SYSTEM)


REJECTED BY _____ FOR _____ DATE _____
(KIND OF SYSTEM)

HOLD PENDING FURTHER TESTS _____ DATE _____

REASONS FOR REJECTION OR HOLDING _____

RECEIVED AND RETURNED 4/17/78
Serial # 65776
JFL

THIS IS NOT A PERMIT

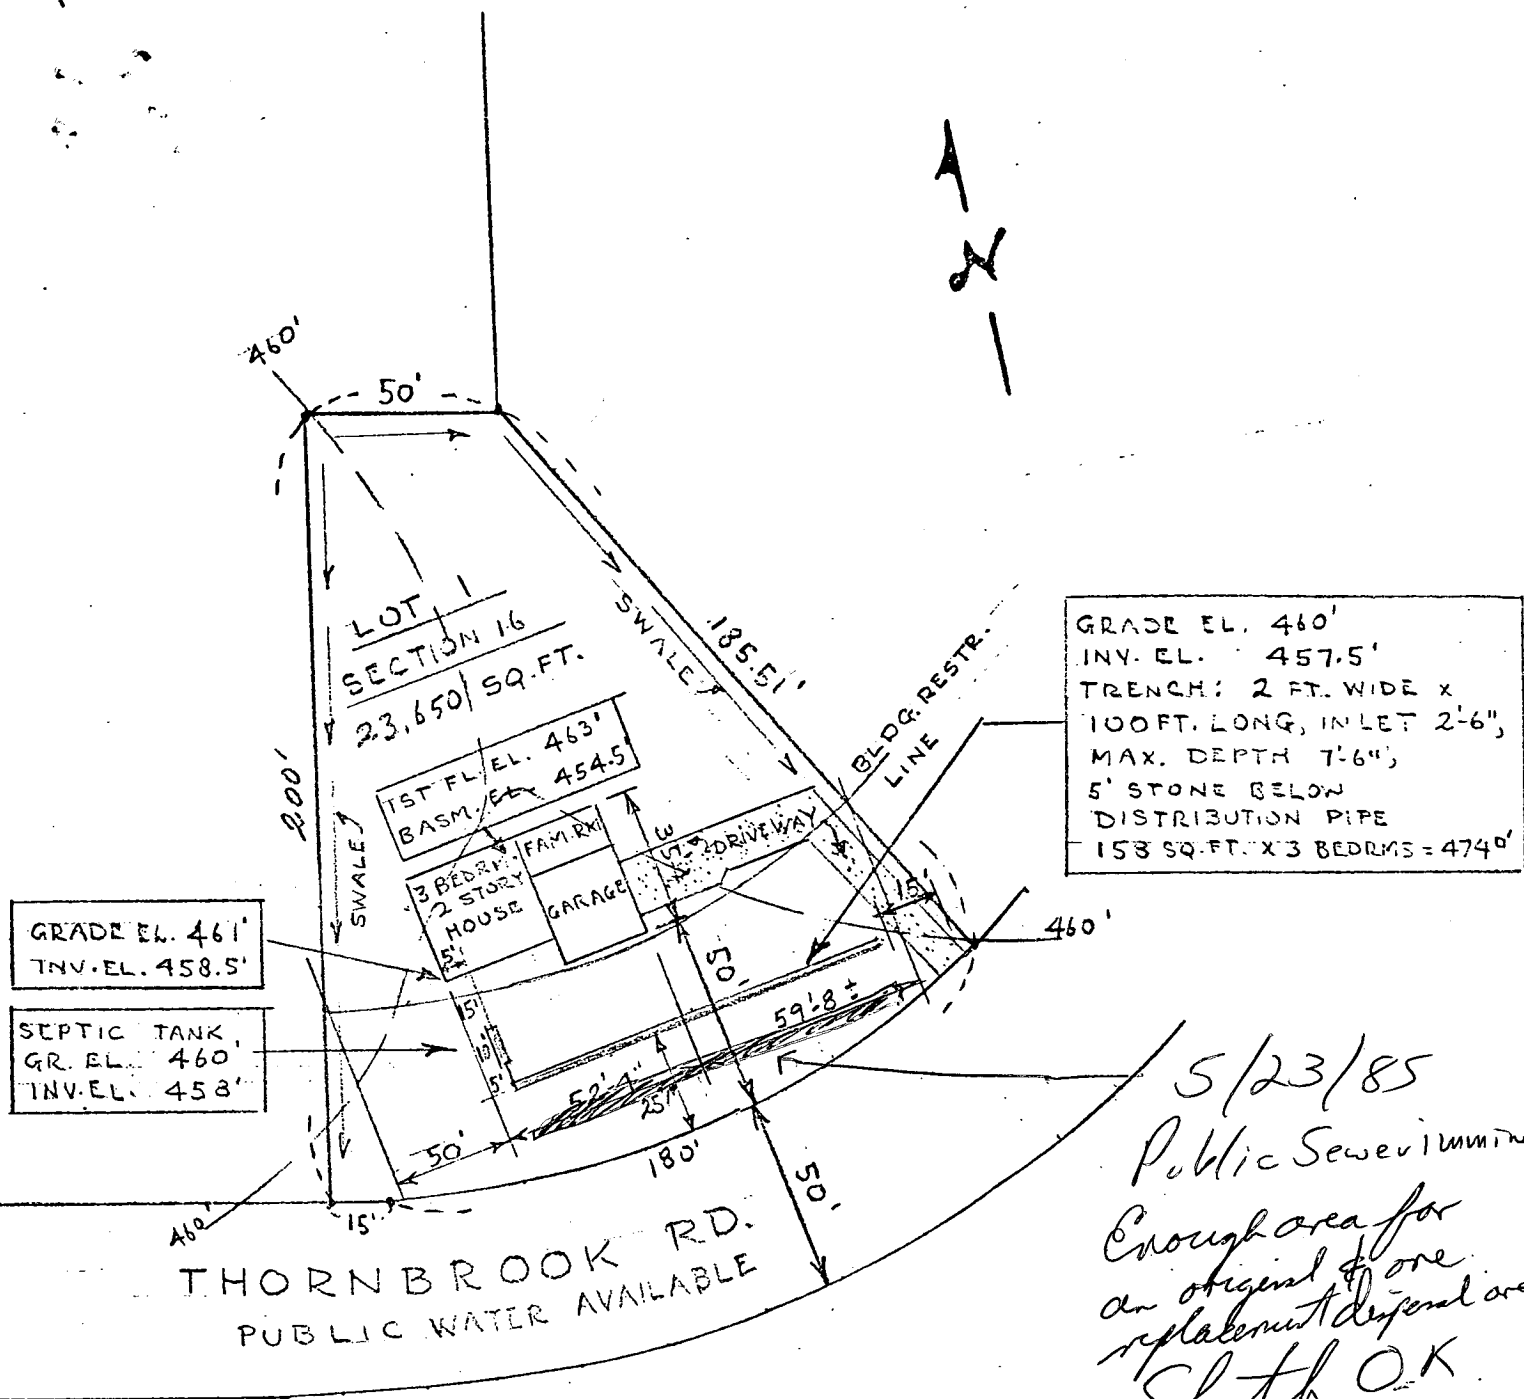

2608 THORNBROOK RD.
"MT. HEBRON"

PREPARED BY: THORNBROOK CORP.
H. J. BAKER 465-2869 OR C. N. BURGESS 465-9044
2106 MT. HEBRON DR.
ELLCOTT CITY, MD.

SCALE: 1" = 50'
LINK RES.

MAY 21, 1985

