

5/10/84
5/11/84 - morning & later
first and last

Approved
5/11/84
C. Williams

PERMIT

P 33824
A 26782

SEWAGE DISPOSAL SYSTEM

MARYLAND STATE DEPARTMENT OF HEALTH*

HOWARD COUNTY
BUREAU OF ENVIRONMENTAL HEALTH
992-2330

INDEX
02-263645

ELLICOTT CITY

DISTRICT 2nd

DATE 4/25/84

Emerson Feaga

IS PERMITTED TO INSTALL X ALTER

ADDRESS 1625 Henryton Road, Marriottsville, Md. 21104 PHONE 442-5623

SUBDIVISION Mt. Hebron ROAD 2605 Thornbrook Road LOT 35, Sec. 16

PROPERTY OWNER Thornbrook Corporation

ADDRESS 2106 Mt. Hebron Drive, Ellicott City, Md. 21043 Phone: 465-2869

IF GARBAGE GRINDER IS USED INCREASE SEPTIC TANK CAPACITY BY 50% AND ABSORPTION AREA BY 22%.

GARBAGE GRINDER? YES _____ NO X

50
12

SEPTIC TANK CAPACITY 1000 GALLONS NUMBER OF BEDROOMS 3

TRENCHES - 474 total square feet sidewall absorption area in system. Trench to be 2 ft. wide. Inlet 2 1/2 ft. below original grade. Bottom maximum depth 6 1/2 ft. below original grade. Effective area begins at 2 1/2 ft. below original grade. 4 feet of stone below distribution pipe. Start the first trench 10 ft. from the front lot line and 10 ft. from the left side line, as seen when facing the lot from Thornbrook Road. Continue to dig the trench on level ground. Place the second trench parallel to and 10 ft. away from the first trench.

PLANS APPROVED BY Frank A. Skinner DATE 11/10/83 & 4/25/84

COVER NO WORK UNTIL INSPECTED AND APPROVED.

NEITHER THE HOWARD COUNTY COUNCIL NOR THE HEALTH DEPARTMENT IS RESPONSIBLE FOR THE SUCCESSFUL OPERATION OF ANY SYSTEM.

NOTE: IF TRENCH IS USED CALL FOR INSPECTION BEFORE AND AFTER PLACING GRAVEL IN TRENCH.

NOTE: NO DRY WELL SHALL EXCEED 15 FOOT IN DIAMETER. NO ABSORPTION TRENCH TO EXCEED 100 FEET IN LENGTH.

NOTE: ALL PIPE FROM HOUSE TO SEPTIC TANK MUST BE CAST IRON OR SCHEDULE 40 PVC OR ABS.

PERMIT VOID AFTER THREE YEARS.


NOTE: INSTALL STAND PIPE ON SEPTIC TANK AND DRY WELL. STAND PIPES MUST BE 6 INCHES IN DIAMETER. CAST IRON, CONCRETE OR TERRA COTTA. OR PVC OR ABS ACCEPTED. IF TOP OF SEPTIC TANK IS DEEPER THAN 3 FEET MANHOLE TO GRADE REQUIRED.

*INSTALLER IS RESPONSIBLE FOR OBTAINING FINAL APPROVAL ON THIS PERMIT

*CALL 992-2330 FOR INSPECTION OF SEPTIC SYSTEMS.

EH - 2-1082

A 26782

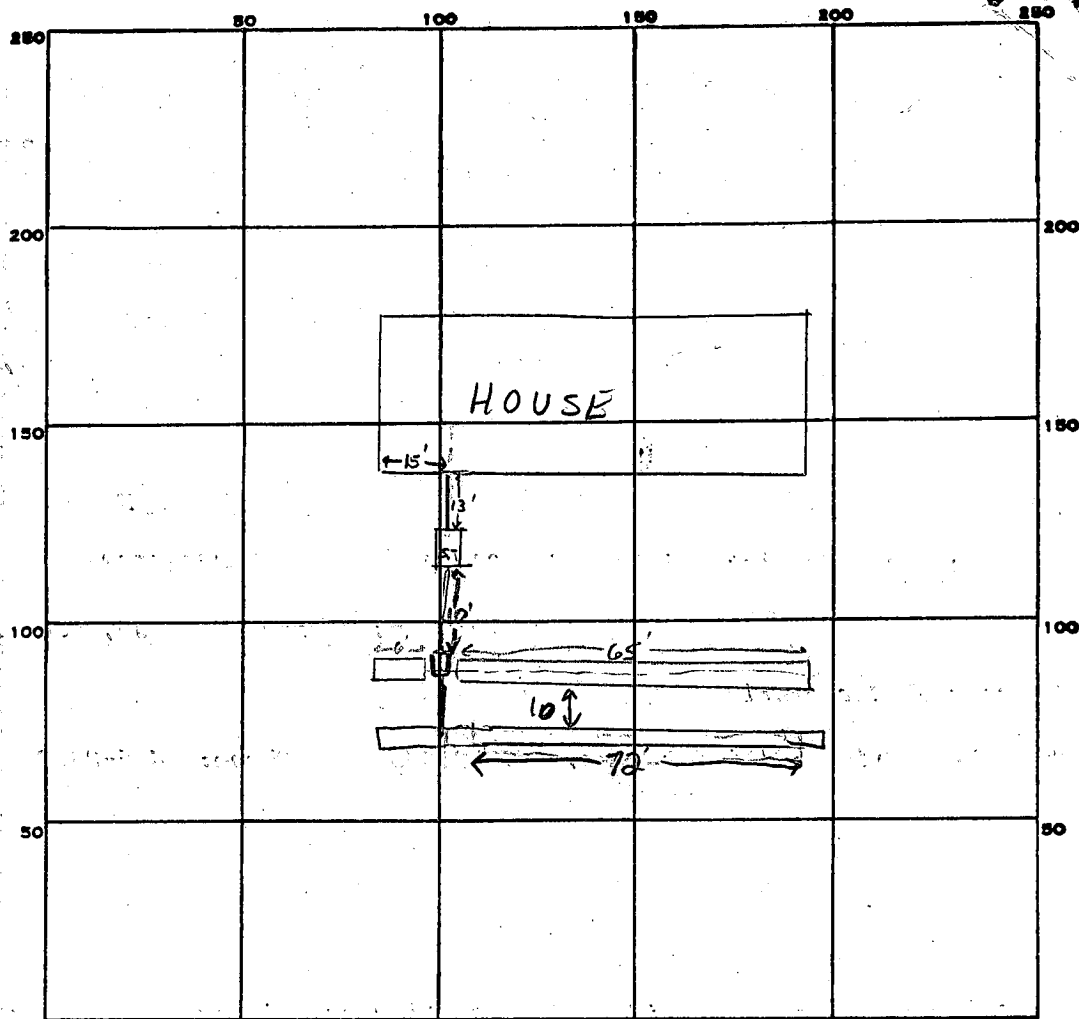

INDICATE NORTH. - NAME ADJOINING ROADWAY AS BASE LINE.

Thornbrook Dr,

PERMIT CARD ☒

SEPTIC TANK, LEVEL ☒

CLEANOUTS ☒

DISTRIBUTION BOX, LEVEL ☒

TILE FIELD, DEPTH 6 1/2 FT. TRENCH WIDTH 2 FT.

GRAVEL DEPTH 4 FT. TOTAL LENGTH 143 FT.

NUMBER OF TRENCHES 2 71+72 ONE SIDEWALL TOTAL BOTTOM AREA 472

1st trench 71' long

2nd trench 72' long

143' TRENCH
x 4 STONE

472

SEEPAGE PITS, INSIDE DIAMETER _____ FT. DEPTH BELOW INLET _____ FT.

ABSORBENT AREA _____ SQ. FT.

REMARKS 5/10/84 OK to continue work. F.S.

5/11/84 2ND OK TO ADD GRAVEL TO SECOND TRENCH CW

5/11/84 SYSTEM COMPLETE. OK TO COVER ALL WORK. CW

DATE SYSTEM APPROVED

MAY 16, 1984

INSPECTOR

C. Williams

PRELIMINARY

APPLICATION

35

A 26782

P _____

SEWAGE DISPOSAL TESTING

STATE OF MARYLAND - DEPARTMENT OF HEALTH AND MENTAL HYGIENE

HOWARD COUNTY HEALTH DEPARTMENT
ENVIRONMENTAL HEALTH SERVICES

P. O. BOX 476, ELLICOTT CITY, MARYLAND 21043
TELEPHONE: 465-5000, EXT. 356

DISTRICT 2nd

DATE 8/22/77

TO: THE COUNTY HEALTH OFFICER
ELLICOTT CITY, MARYLAND

I, HEREBY, APPLY FOR THE NECESSARY TEST IN ORDER TO CONSTRUCT (OR RECONSTRUCT) A SEWAGE DISPOSAL SYSTEM.

PROPERTY OWNER Thornbrook Corporation

ADDRESS 2106 Mt. Hebron Drive, Ellicott City, Md. PHONE 465-2869

PROPERTY LOCATION:

SUBDIVISION Mt. Hebron LOT NO. 35, Sec. 16

ROAD AND DESCRIPTION ~~Tiller Drive~~ 2605 Thornbrook Road

SIZE OF LOT 23,500 sq. ft. TYPE BLDG. 3 or 4 bedrooms

NUMBER OF BEDROOMS

IF NOT SINGLE RESIDENCE DESCRIBE _____

THE SYSTEM INSTALLED UNDER THIS APPLICATION IS ACCEPTABLE ONLY UNTIL PUBLIC FACILITIES BECOME AVAILABLE.

SIGNATURE OF APPLICANT /s/ H. J. Baker, Jr.

APPROVED BY Frank Sherrin FOR Frank DATE 11/16/83
(KIND OF SYSTEM)

REJECTED BY _____ FOR _____ DATE _____
(KIND OF SYSTEM)

HOLD PENDING FURTHER TESTS _____ DATE _____


REASONS FOR REJECTION OR HOLDING Hold for wet season test F.S.

may also need more area to get required 10,000 ft. area

BLDG. PERMIT SIGNED
AND RETURNED 2/7/84

Serial # 57269 SPKQ

THIS IS NOT A PERMIT

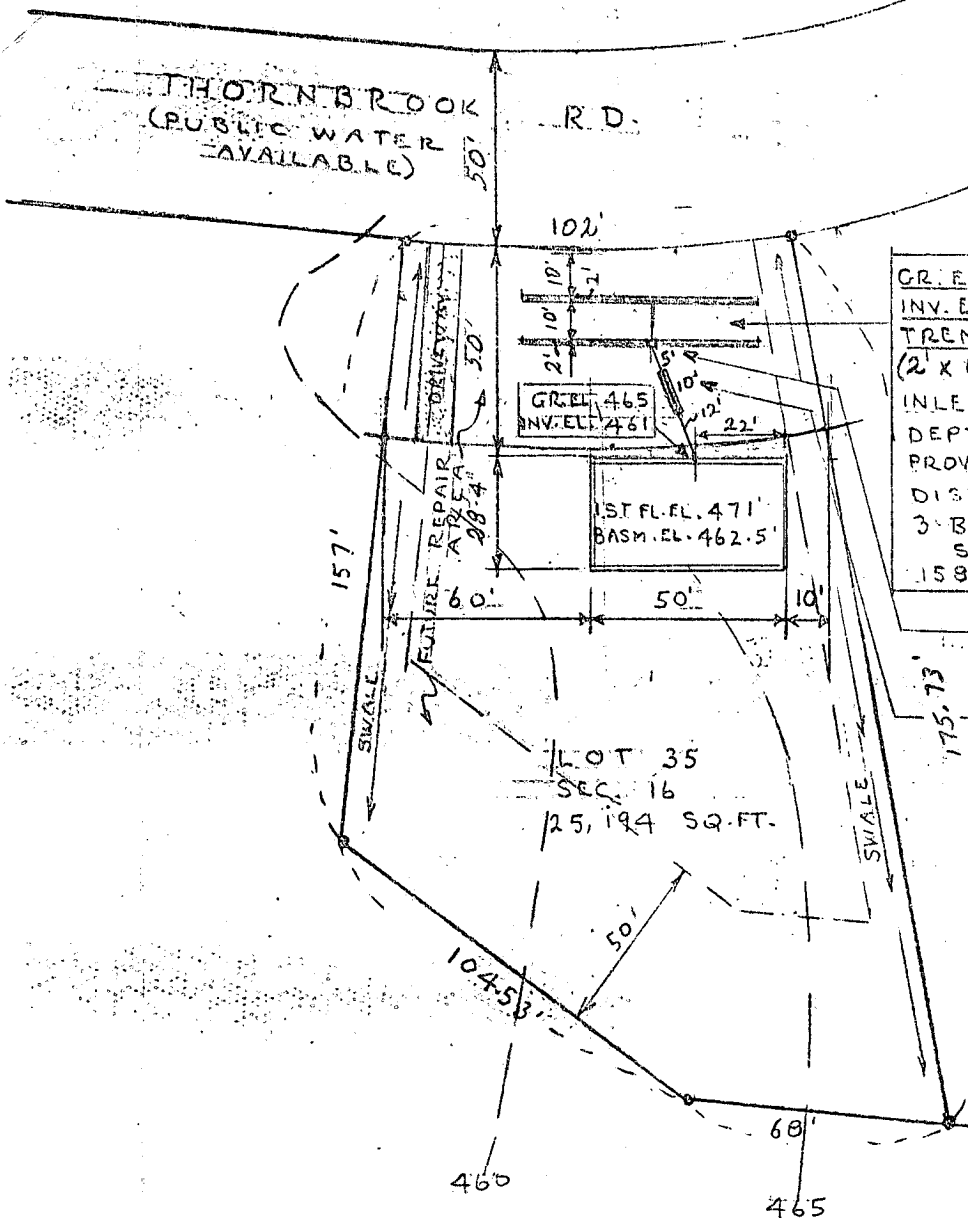

GR. EL. 462.5'
INV. EL. 460'
TRENCHES: 2 FT. WIDTH
(2 X 60' = 120 LIN. FT.)
INLET 2'-6"; TOTAL MAX.
DEPTH 6'-6" BELOW ORIG. GRADE
PROVIDE 4" STONE BELOW
DISTRIBUTION PIPE
3 BEDROOMS - 1000 GAL
SEPTIC TANK
158 SQ. FT. X 3 = 474 SQ. FT.

DISTRIBUTION BOX
GR. EL. 462.5'
INV. EL. 460'
SEPTIC TANK
GR. EL. 463.5'
INV. EL. 460.5'

2/22/84
Revised Sketch
F.S.

2605 THORNBROOK RD
"MT. HEBRON"

PREPARED BY: THORNBROOK CORP.
H.J. BAKER 465-2869 OR C.N. BURGESS 465-9044
2106 MT. HEBRON DR.
ELLCOTT CITY, MD.

SCALE: 1" = 50'
SEIDLIGH RES.

JAN. 25, 1984
REV. FEB. 13, 1984