

# PERMIT

SEWAGE DISPOSAL SYSTEM

MARYLAND STATE DEPARTMENT OF HEALTH

HOWARD COUNTY

ELLICOTT CITY

DISTRICT 4th

DATE 8/9/77

INDEXED

Herman Sirk

IS PERMITTED TO INSTALL ☒ ALTER ☒

ADDRESS 2555 Jennings Chapel Road, Woodbine, Md. 21797 PHONE 489-4724

A SEWAGE DISPOSAL SYSTEM LOCATED AT

SUBDIVISION ROAD 692 Route 27 LOT

PROPERTY OWNER Mr. Antonio F. Pereira

ADDRESS Route #3, Box 28B, Mt. Airy, Md. 21771

## SPECIFICATIONS

DRAIN FIELD DEPTH FEET, BOTTOM AREA SQ. FT.

SEEPAGE PITS ABSORBENT SIDE-WALL AREA SQ. FT.

SEPTIC TANK CAPACITY GALLONS

FOR GARBAGE GRINDER, INCREASE DISPOSAL AREA 22% & TANK CAPACITY 50%.


OTHER ~~REPAIR~~ ~~REPAIR~~ - Call for inspection when ground is opened up and Sanitarian will recommend repair system.

PLANS APPROVED BY Palmer F. Wine DATE 8/9/77

FILL SEPTIC TANK AND DISTRIBUTION BOX WITH WATER BEFORE CALLING FOR AN INSPECTION. COVER NO WORK UNTIL INSPECTED AND APPROVED.

NEITHER THE HOWARD COUNTY COMMISSIONERS NOR THE HEALTH DEPARTMENT IS RESPONSIBLE FOR THE SUCCESSFUL OPERATION OF ANY SYSTEM.

26533

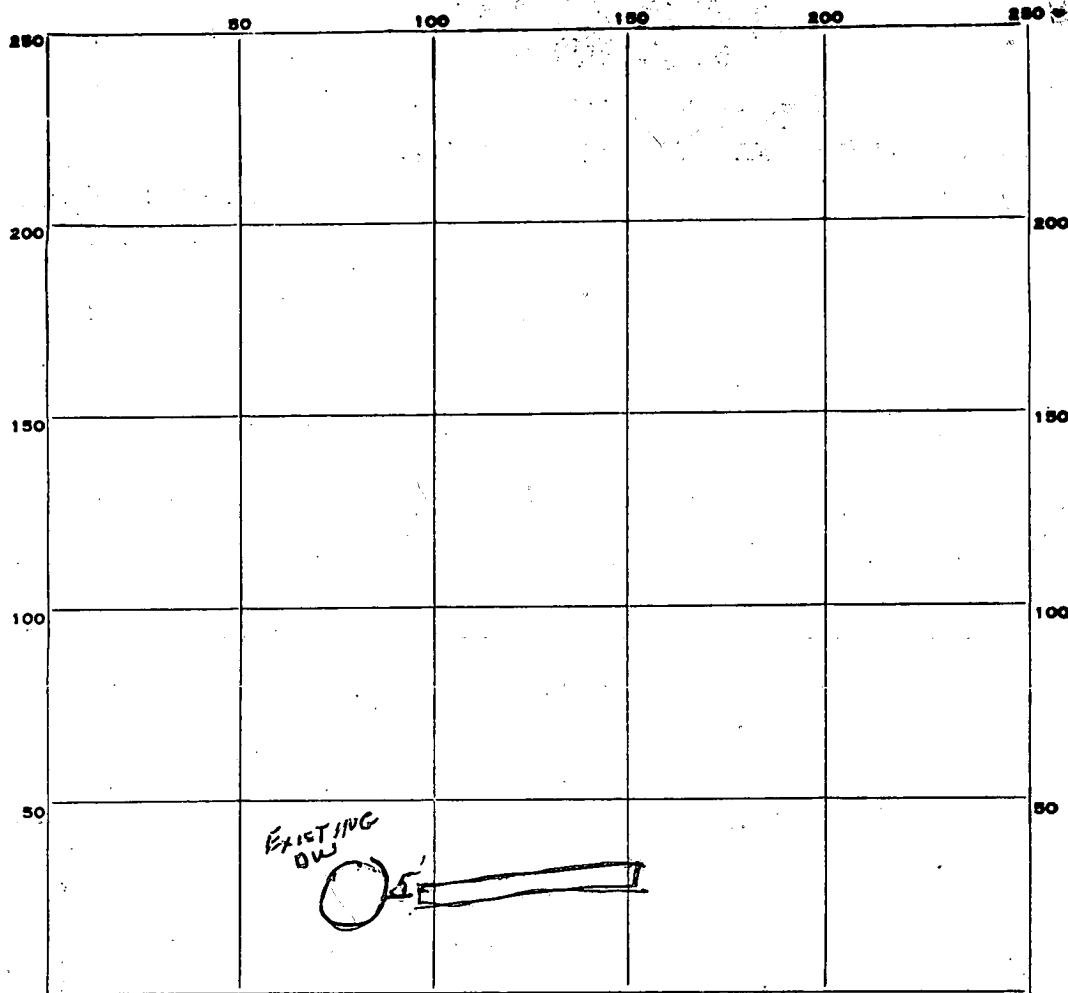

INDICATE NORTH. - NAME ADJOINING ROADWAY AS BASE LINE.

AT 27

PERMIT CARD NP

SEPTIC TANK, LEVEL NP

CLEANOUTS NP

DISTRIBUTION BOX, LEVEL \_\_\_\_\_

TILE FIELD, DEPTH 11 FT. TRENCH WIDTH 2 FT.

GRAVEL DEPTH 84 IN. TOTAL LENGTH 60 FT.

NUMBER OF TRENCHES 1 TOTAL BOTTOM AREA 120 sq ft

SEEPAGE PITS, INSIDE DIAMETER \_\_\_\_\_ FT. DEPTH BELOW INLET \_\_\_\_\_ FT.

ABSORBENT AREA 420 SQ. FT. one side of trench

REMARKS \_\_\_\_\_

DATE SYSTEM APPROVED 8-11-77 INSPECTOR SW. Monog Low

- **SENDER:** Complete items 1-2, and 3.  
Add your address in the "RETURN TO" space on reverse.

1. The following service is requested (check one).

- ☐ Show to whom and date delivered ..... 25¢  
☐ Show to whom, date, & address of delivery ..... 45¢  
☒ **RESTRICTED DELIVERY.**  
 Show to whom and date delivered ..... 85¢  
☐ **RESTRICTED DELIVERY.**  
 Show to whom, date, and address of delivery .. \$1.05

(Fees shown are in addition to postage charges and other fees).

2. ARTICLE ADDRESSED TO:

MR. ANTONIO F. PEREIRA  
 ROUTE #3, Box 28 B  
 MT. AIRY, MD. 21771

3. ARTICLE DESCRIPTION:

REGISTERED NO. | CERTIFIED NO. | INSURED NO.

215411

(Always obtain signature of addressee or agent)

I have received the article described above.

SIGNATURE ☐ Addressee ☐ Authorized agent

4.

DATE OF DELIVERY

7-29-77

5. ADDRESS (Complete only if requested)

6. UNABLE TO DELIVER BECAUSE:

CLERK'S  
INITIALS


UNITED STATES POSTAL SERVICE  
OFFICIAL BUSINESS

SENDER INSTRUCTIONS

Print your name, address, and ZIP Code in the space below.

- Complete items 1, 2, and 3 on the reverse.
- Moisten gummed ends and attach to front of article if space permits. Otherwise affix to back of article.
- Endorse article "Return Receipt Requested" adjacent to number.

RETURN  
TO

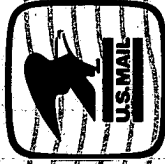

PERMIT NO. 1000  
PENALTY FOR PRIVATE  
USE TO AVOID PAYMENT  
OF POSTAGE, \$300

915  
AIRCRAFT  
HOWARD COUNTY HEALTH DEPT.  
ELICOTT CITY, MD.

Howard County Health Dept.

P. O. Box 476 of Sender)

Ellicott City, Maryland 21043

(Street or P.O. Box)

(City, State, and ZIP Code)

Recall 8/29/77

July 22, 1977

Mr. Antonio F. Pereira  
Route #3, Box 28B  
Mt. Airy, Maryland 21771

Dear Mr. Pereira:

Section 12.104 of the Howard County Code states: "The Board of Health, the County Health Officer, Sanitarian or his representative, shall take cognizance of all conditions dangerous to health and may on their own initiative institute an investigation."

On Monday, July 18, 1977, the investigation revealed an overflowing sewage disposal system on the property owned by you and located at 692 Route 27, Mt. Airy, Maryland.

In my capacity as a Sanitarian with the Howard County Health Department, I have determined that this overflowing sewage is of such a condition that it creates a public nuisance which endangers the public health.

To abate this unhealthy nuisance you must:

1. Secure a permit to repair the system.
2. Have ground opened up for inspection so Sanitarian can recommend the repair system.
3. Have the system repaired and inspected and approved by the Health Department.

You must comply with the provisions of this notice within thirty (30) days from the date of this notice, or apply to the Executive Secretary of the Board of Health for a hearing within ten (10) days from the date of this notice. If you do not apply for a hearing within the prescribed time and if you do not comply with this directive, a summons will be issued directing you to appear before the District Court of Howard County for a trial.

A copy of the Howard County Code is available for you to see at the Howard County Health Department.

Very truly yours,

Frank Skinner,  
Sanitarian

FS:hs

F.3-

FILE Sewage nuis DATE REPORTED 7-15-77

PROPERTY OWNER P

P.O. ADDRESS 692 Rt. 27 TELEPHONE \_\_\_\_\_

DIRECTIONS TO PROPERTY Rt. 27 at Penn Shop Rd. Keller Day

INFORMANT Robt. Murray (Mother loves adj.) <sup>Mrs Norman</sup> 700 Ridge Rd.

253-2290

overhas apt. in Silver Spring

Sewage overflowing  
pumped several times, 10+  
const. workers living there -  
all new Jersey tags

Complainter stated a New Jersey Contr.  
purchased house this spring

CONDITION FOUND 7/18/77 Visited property, spoke to a resident who "doesn't  
speak English." Sewage is overflowing at septic tank in front yard  
Spoke to Mrs. Norman Murray who said system was pumped  
by H. Sirk ~ 2-3 weeks ago but it is overflowing again.

7/21/77 Checked ownership at Ct. Hse, new owner is:  
ANTONIO F. PEREIRA & wife  
Rte #3 Box 28B

ACTION TAKEN Mt. Airy, Md.

21771

7/22/77 Send Bill #33 N.S.

FINAL DISPOSITION \_\_\_\_\_

map 1, blk 20, parcel 36

4th district

Parcel E.D. Blk Map 1

36. 4 20

David H. Monley & W.F.

Rte #3 Box 28B

Mt. Airy, Md.

21771

4/20/77

Index # R/4/116904

Antonio F. Pereira ewf

