

9/8/77
4:30pm
9/9/77
9/14/77
TSD.

PERMIT

SEWAGE DISPOSAL SYSTEM

MARYLAND STATE DEPARTMENT OF HEALTH

HOWARD COUNTY

05-348935

ELLICOTT CITY

DISTRICT 2nd

DATE 9/1/77

John T. Quill, Plumber

IS PERMITTED TO INSTALL

ALTER X

ADDRESS 503 - 5th Street, Laurel, Md.

PHONE

A SEWAGE DISPOSAL SYSTEM LOCATED AT

SUBDIVISION ROAD 11951 Scaggsville Road LOT

PROPERTY OWNER Mr. Curtis Bost

ADDRESS 11951 Scaggsville Road, Scaggsville, Md.

SPECIFICATIONS 2 bedrooms

DRAIN FIELD DEPTH FEET, BOTTOM AREA SQ. FT.

SEEPAGE PITS ABSORBENT SIDE-WALL AREA SQ. FT.

SEPTIC TANK CAPACITY 1000 GALLONS

FOR GARBAGE GRINDER, INCREASE DISPOSAL AREA 22% & TANK CAPACITY 50%.

OTHER REPAIR-CALL FOR INSPECTION WHEN GROUND IS OPENED SO SANITARIAN CAN

RECOMMEND REPAIR. 60' must 4' 10' deep


PLANS APPROVED BY Palmer F. Wine

DATE 9/1/77

FILL SEPTIC TANK AND DISTRIBUTION BOX WITH WATER BEFORE CALLING FOR AN INSPECTION. COVER NO WORK UNTIL INSPECTED AND APPROVED.

NEITHER THE HOWARD COUNTY COMMISSIONERS NOR THE HEALTH DEPARTMENT IS RESPONSIBLE FOR THE SUCCESSFUL OPERATION OF ANY SYSTEM.

P 26827

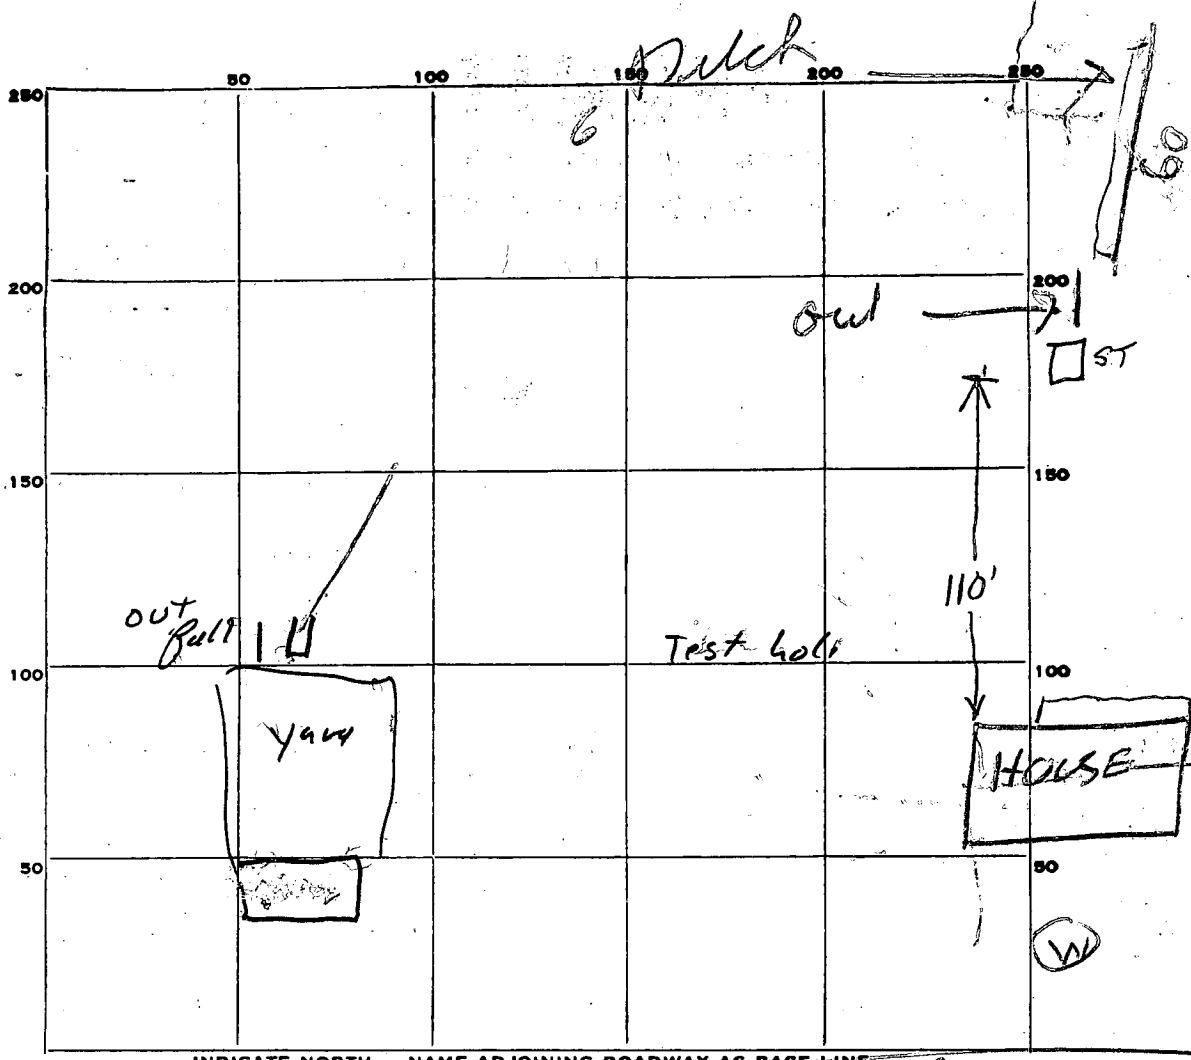

INDICATE NORTH. - NAME ADJOINING ROADWAY AS BASE-LINE.

RA 216

PERMIT CARD

SEPTIC TANK, LEVEL

CLEANOUTS

DISTRIBUTION BOX, LEVEL

TILE FIELD, DEPTH 10 FT. TRENCH WIDTH 2 FT.

GRAVEL DEPTH 7 FT. IN. TOTAL LENGTH 60 FT.

NUMBER OF TRENCHES 1 TOTAL BOTTOM AREA 420 ONE SIDE

SEEPAGE PITS, INSIDE DIAMETER FT. DEPTH BELOW INLET FT.

ABSORBENT AREA SQ. FT.

REMARKS 9/9/77 Dave O'Neill was here yesterday
I said to put stone in ditch R.H. 9/9/77
OK To Cover Ditch. No one knows where Tank
is located. Find Tank Put Cleanout on Tank, Pump
Tank out if needed & Repair Tees if needed R.H.

9/14/77: Septic Tank located, new concrete cover w/ c.i. cleanout. New 10' section into house 1/2 in.

DATE SYSTEM APPROVED 9/14/77

INSPECTOR T.S. Ogle