

12/28/78

Approved 1:00 P.M.

Approved (GLR)
28 Dec 78

PERMIT

SEWAGE DISPOSAL SYSTEM

MARYLAND STATE DEPARTMENT OF HEALTH*

HOWARD COUNTY

03-306186

ELLICOTT CITY

DISTRICT 3rd

DATE 12/13/78

INDEXED

Howard Sadler

IS PERMITTED TO INSTALL X ALTER

ADDRESS

PHONE

SUBDIVISION (Sandy Hill)

ROAD 2568 Sand Hill Road

LOT 3

PROPERTY OWNER Sandy Hill Properties

Bill Elder

ADDRESS P.O. Box 858, Columbia, Md.

SPECIFICATIONS 3 bedrooms

SEPTIC TANK CAPACITY 1000 GALLONS

DRAIN FIELD DEPTH FEET, BOTTOM AREA SQ. FT.

DEEP TRENCH DEPTH FEET, BOTTOM AREA SQ. FT.

SEEPAGE PITS X ABSORBENT SIDE-WALL AREA 120 SQ. FT. per bedroom in system.

INLET PIPE 4 FT. BELOW ORIGINAL GRADE. MAXIMUM DEPTH 13 FT. BELOW ORIGINAL GRADE

EFFECTIVE DEPTH AT FT. BELOW ORIGINAL GRADE.

LOCATE DISPOSAL AREA 131 FT. FROM front LOT LINE AND 137 FT. FROM left LOT LINE AS SEEN WHEN

FACING LOT FROM Sand Hill Road.

PLANS APPROVED BY Raymond Hodges

DATE 8/22/78

COVER NO WORK UNTIL INSPECTED AND APPROVED.

NEITHER THE HOWARD COUNTY COUNCIL NOR THE HEALTH DEPARTMENT IS RESPONSIBLE FOR THE SUCCESSFUL OPERATION OF ANY SYSTEM.

NOTE: IF TRENCH IS USED CALL FOR INSPECTION BEFORE PLACING GRAVEL IN TRENCH.

NOTE: NO DRY WELL SHALL EXCEED 15 FOOT IN DIAMETER.


NOTE: ALL PIPE FROM HOUSE TO DISPOSAL AREA MUST BE CAST IRON.

PERMIT VOID AFTER THREE YEARS.

NOTE: INSTALL STAND PIPE ON SEPTIC TANK AND DRY WELL. STAND PIPES MUST BE 6 INCHES IN DIAMETER. CAST IRON, CONCRETE OR TERRA COTTA ACCEPTED.

*INSTALLER IS RESPONSIBLE FOR OBTAINING FINAL APPROVAL ON THIS PERMIT.

A 27275

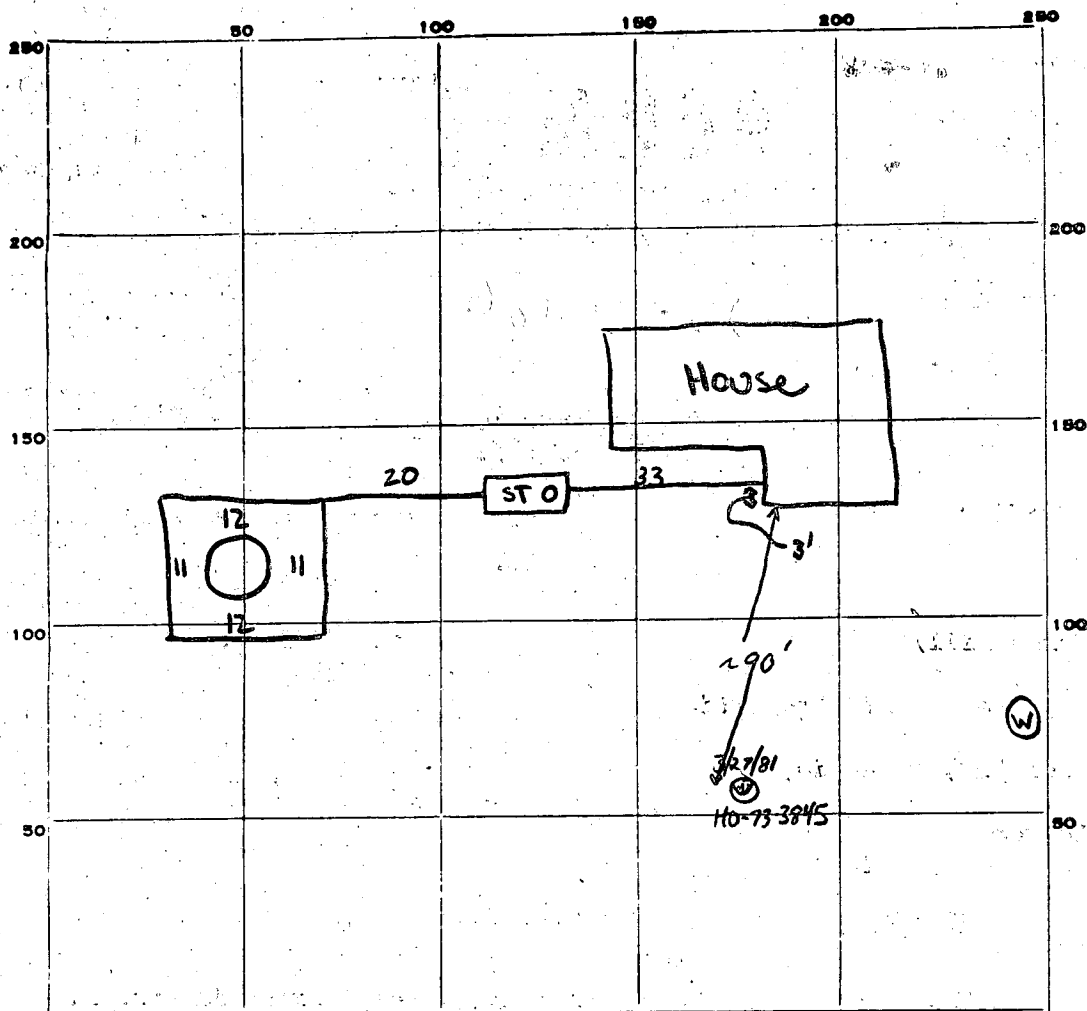

INDICATE NORTH. - NAME ADJOINING ROADWAY AS BASE LINE.

SANDHILL ROAD

PERMIT CARD ✓ NEW

SEPTIC TANK, LEVEL ✓ Rectangular

ST	DW
✓	✓

CLEANOUTS ✓ CAST IRON

DISTRIBUTION BOX, LEVEL Na

TILE FIELD, DEPTH Na FT. TRENCH WIDTH _____ FT.

GRAVEL DEPTH _____ IN. TOTAL LENGTH _____ FT.

NUMBER OF TRENCHES _____ TOTAL BOTTOM AREA _____

DW perimeter 46 FT. DEPTH BELOW INLET 9 FT.

ABSORBENT AREA ±414 SQ. FT.

REMARKS 28 Dec 78 - FINAL OK. (GLK)

DATE SYSTEM APPROVED 28 Dec 78

INSPECTOR G. Kellen

Howard
Sodter: SANDY HILL LOT 3

SEPTIC TANK: 3 BEDROOM, 1000 GALLON

Sand Hill Rd

4 BEDROOM, 1250 GALLON

DRY WELL TO HAVE 120 SQUARE FEET OF SIDEWALL AREA PER BEDROOM

DRY WELL INLET TO BE MAX. 4 FEET BELOW ORIGINAL GRADE.

DRY WELL BOTTOM (MAXIMUM DEPTH) TO BE 13 FEET BELOW ORIGINAL GRADE.

PLACE THE DRY WELL 131 FEET FROM THE FRONT LOT LINE AND 137 FEET FROM THE

LEFT LOT LINE AS SEEN WHEN FACING THE LOT FROM SAND HILL ROAD.

Owner: Sandy Hill Properties

P.O. Box 858

Columbia, Md.

730 - 3758

Address: 2568 Sand Hill Road

3 bedrooms

BLDG. PERMIT SIGNED

AND RETURNED 9/19/78

Serial No. 36718

PRELIMINARY

APPLICATION

A 27275

P

SEWAGE DISPOSAL TESTING

STATE OF MARYLAND - DEPARTMENT OF HEALTH AND MENTAL HYGIENE

HOWARD COUNTY HEALTH DEPARTMENT
ENVIRONMENTAL HEALTH SERVICES

DISTRICT 3rd

DATE 11/28/77

P O. BOX 476, ELLICOTT CITY, MARYLAND 21043
TELEPHONE: 465-5000, EXT. 356*See Attached Sheet for specs*TO: THE COUNTY HEALTH OFFICER
ELLICOTT CITY, MARYLAND

I, HEREBY, APPLY FOR THE NECESSARY TEST IN ORDER TO CONSTRUCT (OR RECONSTRUCT) A SEWAGE DISPOSAL SYSTEM.

PROPERTY OWNER Mr. Kim

ADDRESS 9802 Push CART way PHONE 730-3758

PROPERTY LOCATION:

SUBDIVISION SANDY HILL LOT NO. 3

ROAD AND DESCRIPTION Sand Hill Road - opposite Sand Hill Acres

SIZE OF LOT ? 3 acres TYPE BLDG. 3 or 4 bedrooms
NUMBER OF BEDROOMS

IF NOT SINGLE RESIDENCE DESCRIBE

THE SYSTEM INSTALLED UNDER THIS APPLICATION IS ACCEPTABLE ONLY UNTIL PUBLIC FACILITIES BECOME AVAILABLE.

SIGNATURE OF APPLICANT /s/ Rose Trager, Agent for Mr. Kim

APPROVED BY Raymond Hodges FOR (KIND OF SYSTEM) DATE 8/22/78


REJECTED BY FOR (KIND OF SYSTEM) DATE

HOLD PENDING FURTHER TESTS DATE

REASONS FOR REJECTION OR HOLDING 12/7/77 Per OK but hold for Plat

with Certified/Holder R/H 8/22/78 FINAC PLAT OK

THIS IS NOT A PERMIT

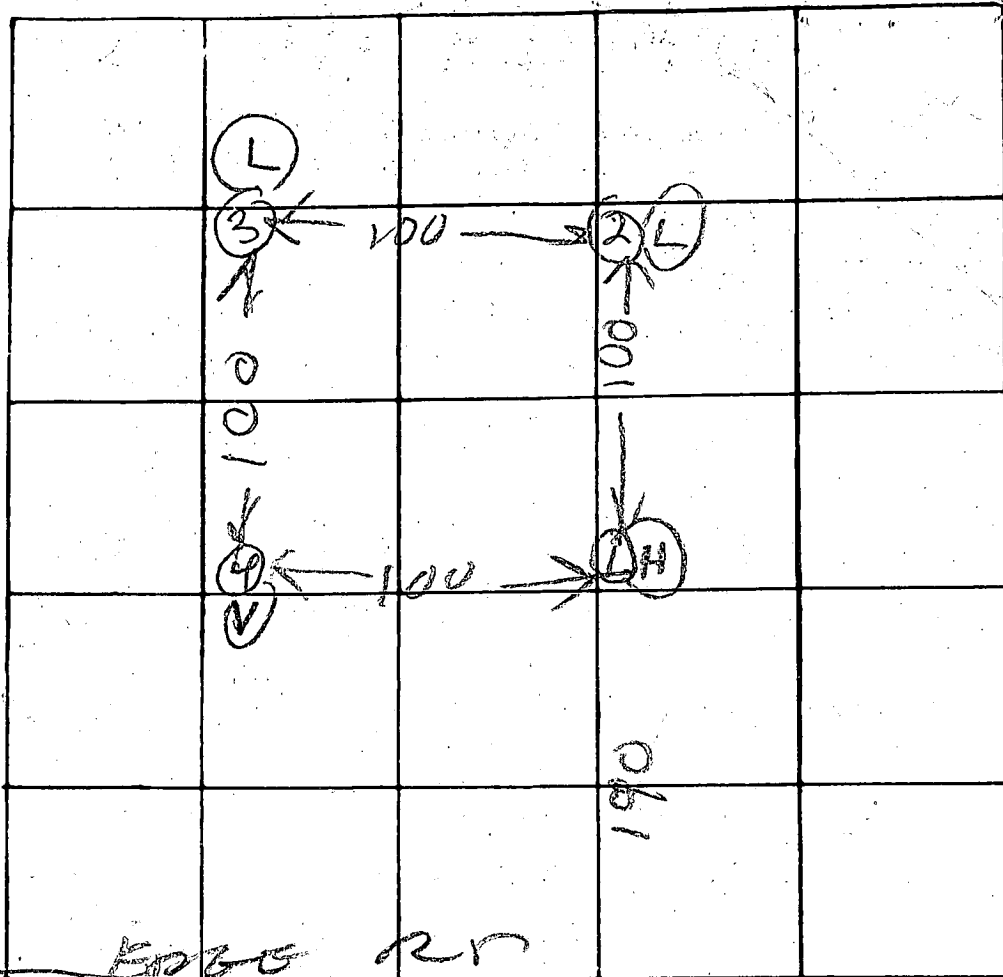

INDICATE NORTH - NAME ADJOINING ROADWAY AS BASE LINE

← to RD 144

SAND HILL RD

FIELD ELEVATION

DATE	TEST NO.	DEPTH	PRE-WET		TEST - 1" DROP		TIME
			START	STOP	START	STOP	
11/17/77	1D	13	1144	1146	1146	1148	2
	1S	5	1146	1153	1153	1202	9
	2D	14	1157	1200	1200	1204	4
	2S	5 1/2	1204	1206	1206	1210	4
	3D	12 1/2	1215	1218	1218	1221	
	3S	6	1216	1217	1217	1221	
12/17/77	4	11	TOP 1307	3 FT CLAY SAND 1317			

HIGHER

REMARKS

TYPE OF SOIL

TESTED BY

R. HODGES

ALSO PRESENT:

H. SIKK

R. TRAGER

90/94

14


1 1/2

STATE OF MARYLAND WATER RESOURCES ADMINISTRATION TAWES STATE OFFICE BLDG., ANNAPOLIS, MARYLAND 21401 APPLICATION FOR PERMIT TO DRILL WELL		WRA PERMIT NUMBER 11-77-111
B 1 9054 SEQUENCE NO. (WRA USE ONLY)		FILL IN THIS FORM COMPLETELY
1 2 3 (SEQ. NO.) 6 (THIS NUMBER IS TO BE PUNCHED IN COLS. 3-6 ON ALL CARDS)		
DATE RECEIVED (WRA USE ONLY) 8/31/78 9:30 a.m. 2nd		
OWNER <u>Cosmopolitan Inc.</u> COL 15 LAST NAME FIRST NAME COL. 34 STREET OR RFD <u>P.O. Box 853</u> COL 36 COL. 55 POST OFFICE <u>Columbia Md. 21044</u> COL 57 <u>730-3758</u> COL. 76		
B 1 CONTINUED DRILLER INFORMATION		
1 2 3 (SEQ. NO.) 6 DATE <u>July 10, 1978</u> LICENSE NUMBER <u>273</u> 77 80 FIRST NAME <u>Ralph Mayne</u> DRILLER LAST NAME SIGNATURE <u>Ralph Mayne</u>		
B 2 WELL INFORMATION		
1 2 3 (SEQ. NO.) 6 MAXIMUM PUMPING RATE (GALLONS PER MINUTE) <u>5</u> 8 12 AVERAGE DAILY QUANTITY NEEDED (GALLONS PER DAY) <u>500</u> 14 20		
USE FOR WATER (CIRCLE APPROPRIATE BOX) ☒ HOME (SINGLE OR DOUBLE HOUSEHOLD UNIT ONLY) ☐ FARMING, AGRICULTURE, IRRIGATION ☐ INDUSTRIAL, COMMERCIAL, STATE AND FEDERAL GOVERNMENT. ☐ MUNICIPAL WATER SUPPLY ☐ PRIVATE WATER COMPANY } MUST HAVE STATE HEALTH DEPT. APPROVAL ☐ TEST		
APPROXIMATE DEPTH OF WELL <u>150</u> FEET 24 28 APPROXIMATE DIAMETER OF WELL <u>6</u> (NEAREST INCH)		
METHOD OF DRILLING USED (CIRCLE APPROPRIATE METHOD) BORED (OR AUGURED) JETTED DRIVEN 30-37 AIR-ROTARY AIR-PERCUSSION ROTARY (HYDRAULIC ROTARY) CABLE REVERSE-ROTARY DRIVE-POINT OTHER (DESCRIBE)		
REPLACEMENT OR DEEPEINED WELLS (CIRCLE APPROPRIATE BOX) ☒ THIS WELL WILL NOT REPLACE AN EXISTING WELL ☐ THIS WELL WILL REPLACE A WELL THAT WILL BE ABANDONED AND SEALED ☐ THIS WELL WILL REPLACE A WELL THAT WILL BE USED AS A STANDBY ☐ THIS WELL WILL DEEPEIN AN EXISTING WELL PERMIT NUMBER OF WELL TO BE REPLACED OR DEEPEINED (IF AVAILABLE)		
NOT TO BE FILLED IN BY DRILLER (WRA USE ONLY) APPROPRIATION PERMIT NUMBER <u>54</u> ENGINEER REVIEW DISTRICT NO. <u>63</u> FORCE <u>67</u> WRITE INITIALS IN BOX CONDITIONS <u>67 68 70 71 72 73 74 75 76 77 78 79</u>		
B 4 CONTINUED HEALTH DEPARTMENT APPROVAL		
1 2 3 (SEQ. NO.) 6 41 <u>S</u> STATE HEALTH (CIRCLE BOX) COUNTY NAME <u>Howard</u> COUNTY NO. <u>U28471</u> MO. DAY YR. <u>7 1 78</u> DATE <u>7 1 78</u> 43 48 <u>Donald W. Monahan, Sanitation</u> APPROVED BY		
B 5 SPECIAL CONDITIONS 8-63 (WRA USE ONLY)		
1 2 3 (SEQ. NO.) 6		

B 3 LOCATION OF WELL	
1 2 3 (SEQ. NO.) 6 COUNTY <u>Howard</u> (DO NOT ABBREVIATE COUNTY NAME) 21 SUBDIVISION <u>Sandy Hill Prop.</u> 42 23 SECTION <u>none</u> LOT <u>3</u> 50 44 48 NEAREST TOWN <u>West Friendship</u> 71 52 MILES FROM TOWN (ENTER 0 IF IN TOWN) <u>4</u> 76 77 78 79	
B 4 DIRECTION FROM TOWN (CIRCLE APPROPRIATE BOX)	
1 2 3 (SEQ. NO.) 6 ☐ N NORTH ☒ E EAST ☐ NE NORTHEAST ☐ SE SOUTHEAST ☐ S SOUTH ☐ W WEST ☐ NW NORTHWEST ☐ SW SOUTHWEST 8 8 9 8 9 NEAR WHAT ROAD <u>Sandy Hill Rd.</u> 11 ON WHICH SIDE OF ROAD (CIRCLE APPROPRIATE BOX) ☐ N ☐ S ☐ E ☒ W 30 32 32 32 32 DISTANCE FROM ROAD (ENTER DISTANCE AND CIRCLE APPROPRIATE BOX) <u>100</u> 37 38 39 34	

DRAW A SKETCH BELOW SHOWING LOCATION OF WELL IN RELATION TO NEARBY TOWNS, ROADS AND STREAMS WITH NORTH IN THE DIRECTION OF THE ARROW, AND GIVE DISTANCE FROM WELL TO NEAREST ROAD JUNCTION OR STREAM CROSSING SHOWN ON THE SKETCH. ALSO SHOW, BY MEANS OF AN "X", THE WELL LOCATION IN THE BOX BELOW AND THE BOX NUMBER FROM THE WELL LOCATION MAP.

21 Bags of cement
 50+ Well gravel
 5' Well casing
 1 1/2' Casing out of ground

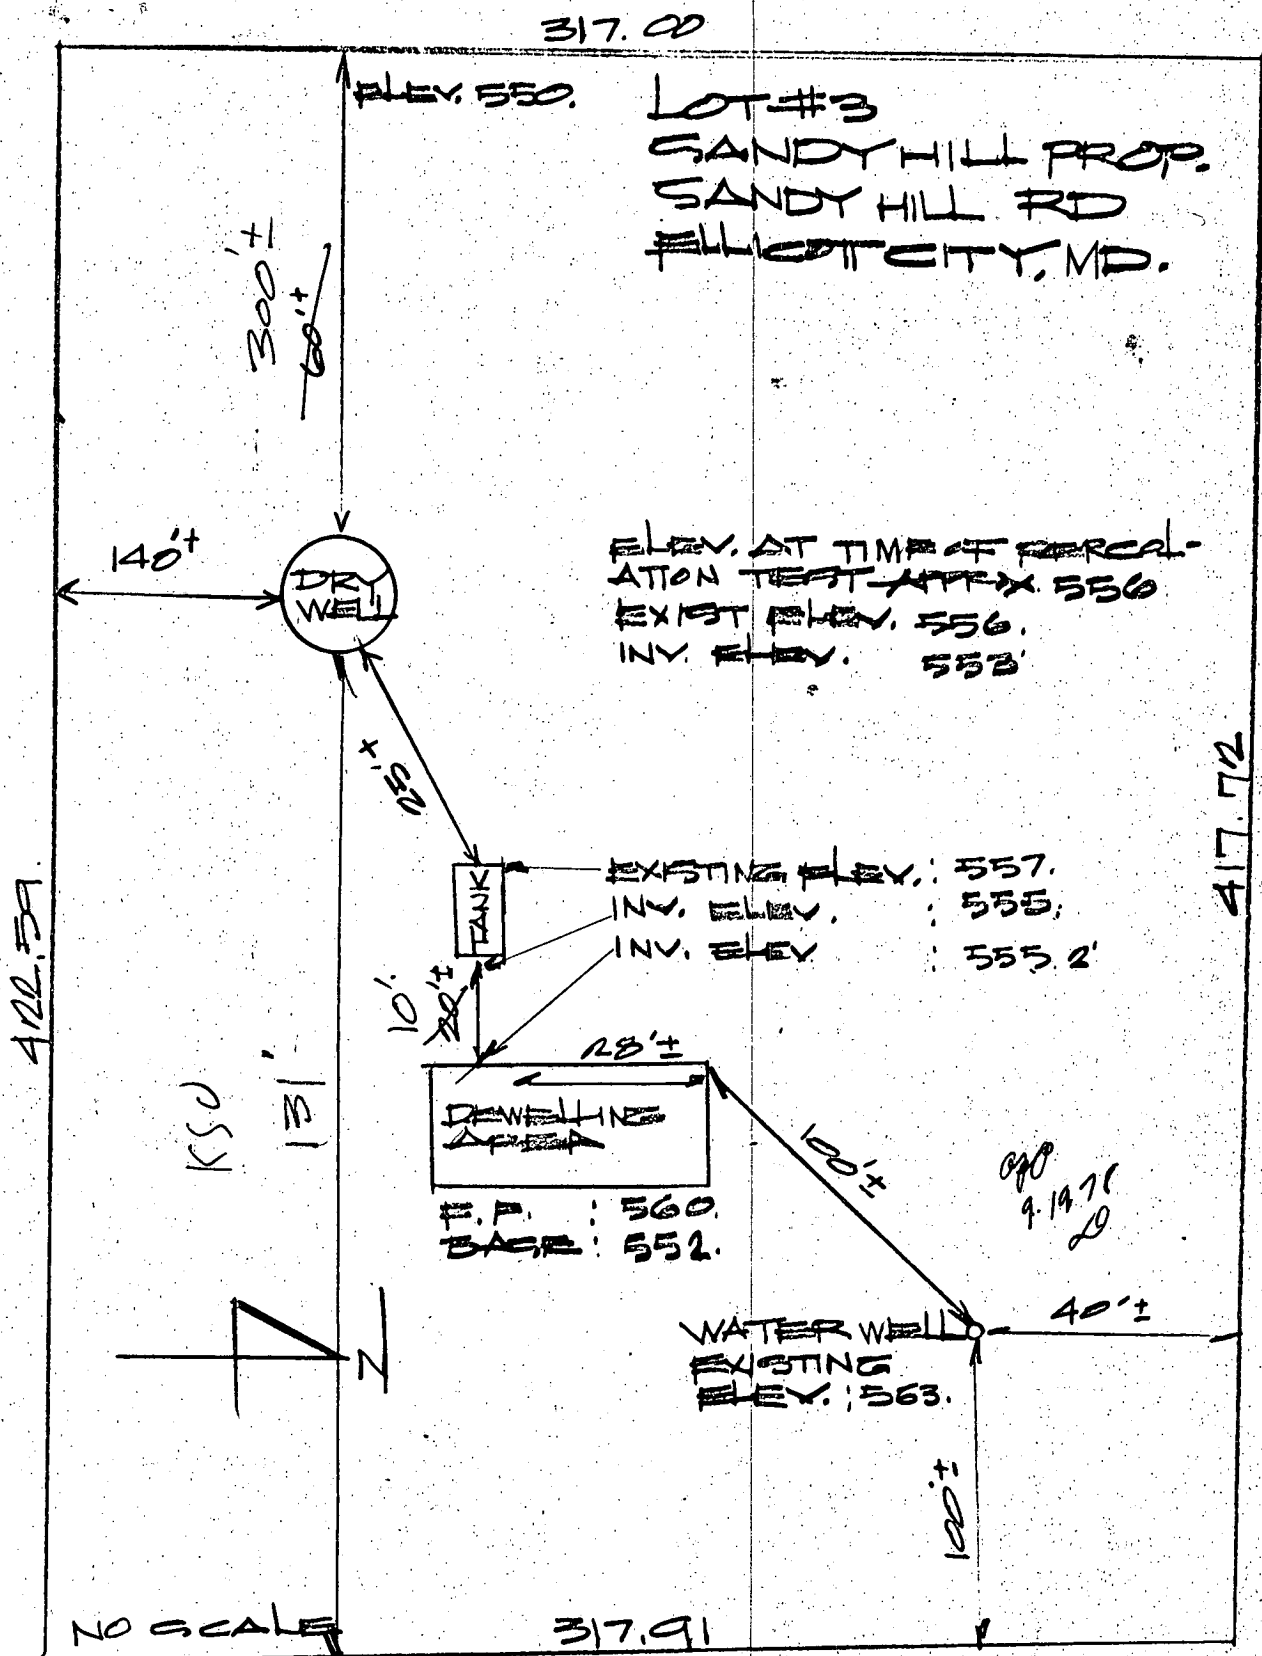

I CERTIFY THE ABOVE MEASUREMENT & ELEV.
ARE ACTUAL & CORRECT FOR THIS PROPERTY.

SIGNED

COSMOPOLITAN INC

C	1	9610	SEQUENCE NO. (WRA USE ONLY)
1 2 3 (SEQ. NO.) 6		(THIS NUMBER IS TO BE PUNCHED IN COLUMNS 3-6 ON ALL CARDS)	

STATE OF MARYLAND
WATER RESOURCES ADMINISTRATION
 TAWES STATE OFFICE BLDG., ANNAPOLIS, MD. 21401
WELL COMPLETION REPORT

THIS REPORT MUST BE SUBMITTED WITHIN 30 DAYS AFTER WELL COMPLETION

FILL IN THIS FORM COMPLETELY

COUNTY NUMBER W28-471DATE RECEIVED
(WRA USE ONLY)DATE WELL COMPLETED
Aug 31, 1978

DEPTH OF WELL

325'
22 (TO NEAREST FOOT) 26

PERMIT NO. FROM "PERMIT TO DRILL WELL"

28 29 30 31 32 33 34 35 36 37

DRILLERS IDENTIFICATION NO. 273
 OWNER Casnapolitan Inc. LAST NAME P.O. Box 853 FIRST NAME Columbia Md. 21044
 STREET OR RFD POST OFFICE

WELL LOG			
STATE THE KIND OF FORMATIONS PENETRATED, THEIR COLOR, DEPTH, THICKNESS AND IF WATER BEARING			
DESCRIPTION (USE ADDITIONAL SHEETS IF NECESSARY)	FEET		CHECK IF WATER BEARING
	FROM	TO	

Top Soil	0	2	
Sandy	2	46	✓
Sand Stone	46	58	✓
Micka	58	75	
Sand Stone	75	77	✓
Micka	77	325	

GROUTING RECORD	
WELL HAS BEEN GROUTED (CIRCLE APPROPRIATE BOX)	
YES ☒ Y	NO ☐ N
TYPE OF GROUTING MATERIAL (CIRCLE BOX)	
CEMENT ☒ CM	BENTONITE CLAY ☐ BC
NO. OF BAGS <u>21</u>	NO. OF POUNDS <u>2100</u>
GALLONS OF WATER <u>126</u>	
DEPTH OF GROUT SEAL (TO NEAREST FOOT)	
FROM <u>0</u> FT.	TO <u>50</u> FT.
(ENTER 0 IF FROM SURFACE)	

CASING RECORD	
CASING TYPES (INSERT APPROPRIATE CODE BELOW)	
☒ STEEL	☐ CONCRETE
☐ PLASTIC	☐ OTHER
MAIN CASING TYPE	
☒ S	☐ T
NOMINAL DIAMETER TOP (MAIN) CASING (NEAREST INCH)	TOTAL DEPTH OF MAIN CASING (NEAREST FOOT)
<u>6</u>	<u>57</u>

OTHER CASING (IF USED)	
DIAMETER (INCH)	DEPTH (FEET) FROM TO
<u> </u>	<u> </u> <u> </u>
<u> </u>	<u> </u> <u> </u>

SCREEN RECORD	
SCREEN TYPE OR OPEN HOLE (INSERT APPROPRIATE CODE BELOW)	
☒ STEEL	☐ BRASS OR BRONZE
☐ PLASTIC	☐ OTHER
SCREEN TYPE OR OPEN HOLE	
☒ H	☐ O

C 2	
1 2 3 (SEQ. NO.) 6	
DEPTH (NEAREST WHOLE FOOT) FROM TO	
<u>55</u>	<u>325</u>
EACH SCREEN	
1	2
3	4
5	6
99	100

DIAMETER OF SCREEN (NEAREST INCH)	
<u>56</u>	<u>60</u>
FROM	TO
GRAVEL PACK	
IF WELL DRILLED WAS A FLOWING WELL CIRCLE BOX	
☐ F	☐ F

WRA USE ONLY (NOT TO BE FILLED IN BY DRILLER)	
T	W O
☐ 70	☐ 72
TELESCOPE CASING	LOG INDICATOR
☐ 74-75	☐ 76
OTHER DATA AVAILABLE	

PUMPING TEST	
HOURS PUMPED (TO NEAREST HOUR) <u>8</u>	
PUMPING RATE (GALLONS PER MINUTE TO NEAREST GALLON) <u>1</u>	
METHOD USED TO MEASURE PUMPING RATE <u>Bucket</u>	
WATER LEVEL: (DISTANCE FROM LAND SURFACE)	
BEFORE PUMPING <u>25</u> (NEAREST FOOT)	17 20
WHEN PUMPING <u>325</u> (NEAREST FOOT)	22 25
TYPE OF PUMP USED (CIRCLE APPROPRIATE BOX) (FOR PUMPING TEST)	
☒ AIR	☐ PISTON
☐ CENTRIFUGAL	☐ ROTARY
☐ JET	☐ SUBMERSIBLE
☐ TURBINE	☐ OTHER (DESCRIBE BELOW)

PUMP INSTALLED	
TYPE OF PUMP (WRITE APPROPRIATE LETTER IN BOX - SEE ABOVE: A, C, J, P, R, S, T, O)	
DRILLER WILL INSTALL PUMP (CIRCLE APPROPRIATE BOX)	
YES ☒ Y	NO ☐ N
CAPACITY:	
GALLONS PER MINUTE (TO NEAREST GALLON)	<u>31</u> <u>35</u>
PUMP HORSE POWER	<u>37</u> <u>41</u>
PUMP COLUMN LENGTH (NEAREST FOOT)	<u>43</u> <u>47</u>
CASING HEIGHT (CIRCLE APPROPRIATE BOX AND ENTER CASING HEIGHT)	
☒ ABOVE	☐ BELOW
LAND SURFACE (NEAREST FOOT)	
<u>50</u>	<u>51</u>

LOCATION OF WELL ON LOT	
SHOW PERMANENT STRUCTURE SUCH AS BUILDINGS, SEPTIC TANKS, AND/OR OTHER LAND MARKS AND INDICATE NOT LESS THAN TWO DISTANCES (MEASUREMENTS TO WELL).	

CIRCLE APPROPRIATE BOXES

- ☐ A WELL WAS ABANDONED AND SEALED WHEN THIS WELL WAS COMPLETED
- ☐ E ELECTRIC LOG OBTAINED
- ☐ P TEST WELL CONVERTED TO PRODUCTION WELL

I HEREBY CERTIFY THAT I HAVE COMPLIED WITH ALL CONDITIONS STATED ON THE ABOVE-CAPTIONED "PERMIT TO DRILL WELL", AND THAT INFORMATION CONTAINED IN THIS REPORT IS TRUE, ACCURATE, AND COMPLETE TO THE BEST OF MY KNOWLEDGE, INFORMATION AND BELIEF.

DRILLERS NAME

 (PLEASE PRINT) Ralph Mayne
 SIGNATURE Ralph Mayne

HO-73-3845

1

2

3

Date Received
(WRA use only) 3/27/81

DATE WELL COMPLETED

Depth of Well
320
(TO NEAREST FOOT)

PERMIT NO.
FROM "PERMIT TO DRILL WELL"
HA-73-3845

OWNER Elder last name William first name

STREET OR RFD 2568 Sand Hill Rd. TOWN

SUBDIVISION Sandy Hill SECTION LOT 3

WELL LOG		
Not required for driven wells		
STATE THE KIND OF FORMATIONS PENETRATED, THEIR COLOR, DEPTH, THICKNESS AND IF WATER BEARING		
DESCRIPTION (Use additional sheets if needed)	FEET	Check if water bearing
	FROM	TO
TOP SOIL	0	2
SHALEY	2	10
BROWN SLATE	10	70
MICA	70	160
FLINT	160	170
MICA	170	230
FLINT	230	235
MICA	235	320

WELL HAS BEEN GROUTED
(Circle Appropriate Box) YES ☒ NO ☐

TYPE OF GROUTING MATERIAL
CEMENT ☒ BENTONITE CLAY ☐

NO. OF BAGS 11 NO. OF POUNDS 1100

GALLONS OF WATER

DEPTH OF GROUT SEAL (to nearest foot)
from 0 ft. to 45 ft. (enter 0 if from surface)

CASING RECORD

casing types insert appropriate code below

STEEL ☒ CONCRETE ☐
PLASTIC ☐ OTHER ☐

MAIN CASING TYPE

Nominal diameter top(main) casing (nearest inch) 6

Total depth of main casing (nearest foot) 50

OTHER CASING (if used)

diameter inch depth (feet) from to

SCREEN RECORD

screen type or open hole insert appropriate code below

STEEL ☐ BRASS ☐ OPEN HOLE ☐
BRONZE ☐ PLASTIC ☐ OTHER ☐

C2 (seq. no.)

DEPTH (nearest ft.) 48 320

SLOT SIZE 2

DIAMETER OF SCREEN (NEAREST INCH)

GRAVEL PACK

IF WELL DRILLED WAS FLOWING WELL CIRCLE BOX ☐

C3 (seq. no.)

PUMPING TEST

HOURS PUMPED (nearest hour) 2

PUMPING RATE (gal. per min. to nearest gal.) 1

METHOD USED TO MEASURE PUMPING RATE BUCKET

WATER LEVEL (distance from land surface)

BEFORE PUMPING 60

WHEN PUMPING 320

TYPE OF PUMP USED (for test)

A air ☒ P piston ☐ T turbine ☐
C centrifugal ☐ R rotary ☐ O other (describe below) ☐
J jet ☐ S submersible ☐

PUMP INSTALLED YES ☒ NO ☐

DRILLER WILL INSTALL PUMP (CIRCLE APPROPRIATE BOX)

IF DRILLER INSTALLS PUMP, THIS SECTION MUST BE COMPLETED FOR ALL WELLS EXCEPT HOME USE

TYPE OF PUMP (WRITE APPROPRIATE LETTER IN BOX - SEE ABOVE: (A, C, J, P, R, S, T, O))

CAPACITY: GALLONS PER MINUTE (to nearest gallon)

PUMP HORSE POWER

PUMP COLUMN LENGTH (nearest ft.)

CASING HEIGHT (circle appropriate box and enter casing height)

above ☒ below ☐

LAND SURFACE 2 (nearest foot)

CIRCLE APPROPRIATE BOX

A A WELL WAS ABANDONED AND SEALED WHEN THIS WELL WAS COMPLETED

E ELECTRIC LOG OBTAINED

P TEST WELL CONVERTED TO PRODUCTION WELL

I HEREBY CERTIFY THAT I HAVE COMPLIED WITH ALL CONDITIONS STATED ON THE ABOVE-CAPTIONED "PERMIT TO DRILL WELL", AND THAT INFORMATION CONTAINED IN THIS REPORT IS TRUE, ACCURATE, AND COMPLETE TO THE BEST OF MY KNOWLEDGE, INFORMATION AND BELIEF.

DRILLERS IDENT. NO. 40

DRILLERS SIGNATURE

SITE SUPERVISOR (sign of driller or journeyman responsible for sitework if different from permittee)

WRA USE ONLY (NOT TO BE FILLED IN BY DRILLER)

T (E.R.O.S.)

W Q

TELESCOPE CASING

LOG INDICATOR

OTHER DATA

LOCATION OF WELL ON LOT

SHOW PERMANENT STRUCTURE SUCH AS BUILDING, SEPTIC TANKS, AND/OR LANDMARKS AND INDICATE NOT LESS THAN TWO DISTANCES (MEASUREMENTS TO WELL)

WELL 65'

RIGHT LOT LINE

SAND HILL RD.