

PERMIT

SEWAGE DISPOSAL SYSTEM

MARYLAND STATE DEPARTMENT OF HEALTH

HOWARD COUNTY

ELLICOTT CITY

DISTRICT 5th.

DATE 9/22/82

INDEX

Allen's Dackhoe Rental

IS PERMITTED TO INSTALL X ALTER

ADDRESS 2388 Route 97, Cooksville, Maryland 21723 PHONE 774-2561

SUBDIVISION Fox Pause ROAD 6578 Route 32 LOT 5

PROPERTY OWNER Fotini Koutsogiannis PHONE: 725-3611

9240-C Livery Lane

ADDRESS Laurel, Maryland

**BUILDING PERMIT SIGNED
AND RETURNED**

7-15-04 800150349-16 POOL

SPECIFICATIONS 4 Bedrooms

SEPTIC TANK CAPACITY 1250 GALLONS

DRAIN FIELD _____ DEPTH _____ FEET, BOTTOM AREA _____ SQ. FT.

DEEP TRENCH _____ DEPTH _____ FEET, BOTTOM AREA _____ SQ. FT.

Dry Well

SEEPAGE PITS X ABSORBENT SIDE-WALL AREA 120 SQ. FT. per bedroom

INLET PIPE 3 FT. BELOW ORIGINAL GRADE. MAXIMUM DEPTH 11 FT. BELOW ORIGINAL GRADE

EFFECTIVE DEPTH AT _____ FT. BELOW ORIGINAL GRADE.

LOCATE DISPOSAL AREA 212 FT. FROM front LOT LINE AND 20 FT. FROM left LOT LINE AS SEEN WHEN

FACING LOT FROM Route 32 Road

NOTE: OKAY TO USE TRENCH OFF DRY WELL TO MAKE UP ABSORBENT SIDEWALL AREA IN SYSTEM.

LEAVE 5 FT. EARTH BUFFER BETWEEN TRENCH AND DRY WELL. TRENCH TO FOLLOW CONTOUR OF THE LAND. CALL FOR 2 INSPECTIONS - BEFORE AND AFTER GRAVEL IS INSTALLED.

9/23/82 O.K. to use one 80 ft long, 2 ft wide, 11 ft deep trench with inlet at 3 ft below original grade. Call for inspt. before placing #2 stone in trench. F.S.

PLANS APPROVED BY Raymond Hodges/Frank Skinner DATE 10/17/78 & 9/20/82

COVER NO WORK UNTIL INSPECTED AND APPROVED.

NEITHER THE HOWARD COUNTY COUNCIL NOR THE HEALTH DEPARTMENT IS RESPONSIBLE FOR THE SUCCESSFUL OPERATION OF ANY SYSTEM.

NOTE: IF TRENCH IS USED CALL FOR INSPECTION BEFORE PLACING GRAVEL IN TRENCH.

NOTE: NO DRY WELL SHALL EXCEED 15 FOOT IN DIAMETER.

NOTE: ALL PIPE FROM HOUSE TO DISPOSAL AREA MUST BE CAST IRON.

PERMIT VOID AFTER THREE YEARS.

NOTE: INSTALL STAND PIPE ON SEPTIC TANK AND DRY WELL. STAND PIPES MUST BE 6 INCHES IN DIAMETER. CAST IRON, CONCRETE OR TERRAZO ACCEPTED.


***INSTALLER IS RESPONSIBLE FOR OBTAINING FINAL APPROVAL ON THIS PERMIT.**

BLDG. PERMIT SIGNED
AND RETURNED

5/19/84
Serial # 70582
P.M.

EH-2-1079

8
A 27431

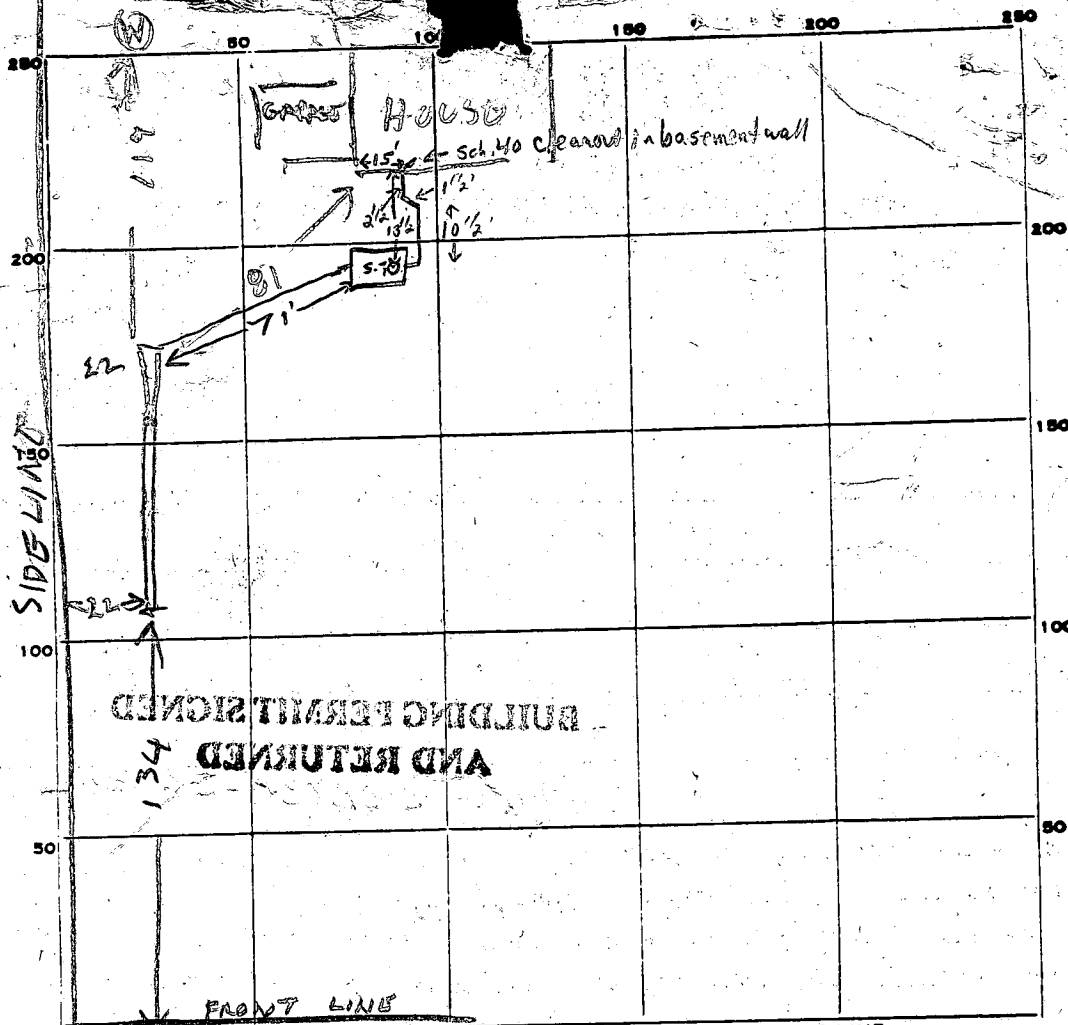

10/22/82 12/30/82
PERMIT CARD Yes Verbal OK given RT 32 TO CLARKSVILLE
Yes Also Talked to Contractor

SEPTIC TANK, LEVEL ✓

CLEANOUTS S.T. not see note below

DISTRIBUTION BOX, LEVEL na.

TILE FIELD, DEPTH 11 FT. TRENCH WIDTH 2 FT.

GRAVEL DEPTH 8 IN. TOTAL LENGTH 82 FT.

NUMBER OF TRENCHES 1 TOTAL BOTTOM AREA 656

SEEPAGE PITS, INSIDE DIAMETER _____ FT. DEPTH BELOW INLET _____ FT.

ABSORBENT AREA ±656 SQ. FT.

REMARKS 10/23/82 DITCH OK ADD STONE & PIPE & CALL RT
11/5/82 OK to cover trenches. JS
12/30/82* No need for stand pipe on septic tank as top of tank will only be ~6"
below grade F.S.

DATE SYSTEM APPROVED 12/30/82 INSPECTOR F. Shuman

APPLICATION

A 27431

P _____

SEWAGE DISPOSAL TESTING

STATE OF MARYLAND - DEPARTMENT OF HEALTH AND MENTAL HYGIENE

HOWARD COUNTY HEALTH DEPARTMENT
ENVIRONMENTAL HEALTH SERVICESDISTRICT 5thDATE 1/13/78P. O. BOX 476, ELLICOTT CITY, MARYLAND 21043
TELEPHONE: 465-5000, EXT. 356SYSTEM FIRSTSEE SEPARATE SHEET FOR SPECSTO: THE COUNTY HEALTH OFFICER
ELLICOTT CITY, MARYLANDI, HEREBY, APPLY FOR THE NECESSARY TEST IN ORDER TO CONSTRUCT (OR RECONSTRUCT) A SEWAGE
DISPOSAL SYSTEM.PROPERTY OWNER Jotini Koutsogiannis
Edwin G. Willson property (formerly Maurice Jager property)ADDRESS 9240-C Livery Lane PHONE 725-3611
Laurel, Md.

PROPERTY LOCATION:

SUBDIVISION Fox Pause LOT NO. 5ROAD AND DESCRIPTION 6578 Route 32SIZE OF LOT 3 acres m/1 TYPE BLDG. 3 or 4 bedrooms
NUMBER OF BEDROOMS

IF NOT SINGLE RESIDENCE DESCRIBE _____

THE SYSTEM INSTALLED UNDER THIS APPLICATION IS ACCEPTABLE ONLY UNTIL PUBLIC
FACILITIES BECOME AVAILABLE.SIGNATURE OF APPLICANT /s/ Edwin G. WillsonAPPROVED BY Raymond Hodges FOR DRY WELL DATE 10/12/78
(KIND OF SYSTEM)REJECTED BY _____ FOR _____ DATE _____
(KIND OF SYSTEM)

HOLD PENDING FURTHER TESTS _____ DATE _____

REASONS FOR REJECTION OR HOLDING 1/31/78 - Public Health Hold for Public Health10/12/78 FINAL PLAN SIGNED 10/12

THIS IS NOT A PERMIT

C 1 2605 (THIS NUMBER IS TO BE PUNCHED IN COLS. 3-6 ON ALL CARDS)	SEQUENCE NO. (WRA USE ONLY)	STATE OF MARYLAND WATER RESOURCES ADMINISTRATION TAWES STATE OFFICE BLDG., ANNAPOLIS, MD. 21401 WELL COMPLETION REPORT		THIS REPORT MUST BE SUBMITTED WITHIN 30 DAYS AFTER WELL COMPLET FILL IN THIS FORM COMPLETELY COUNTY NUMBER
DATE RECEIVED (WRA USE ONLY)	DATE WELL COMPLETED	DEPTH OF WELL 22 (TO NEAREST FOOT) 26		PERMIT NO. FROM "PERMIT TO DRILL WELL" 40-11-2918 28 29 30 31 32 33 34 35 36 37
OWNER LAST NAME <u>Wilson, Edwin</u> STREET OR RFD. <u>Box 32</u>		FIRST NAME <u>ASHTON, M.D.</u> POST OFFICE		
WELL DESCRIPTION				
WELL LOG				
STATE THE KIND OF FORMATIONS PENETRATED, THEIR COLOR, DEPTH, THICKNESS AND IF WATER BEARING				
DESCRIPTION (USE ADDITIONAL SHEETS IF NECESSARY)	FEET	FROM	TO	CHECK IF WATER BEARING
Top Soil	0	3		
Shale	3	5		
Hard Stone	5	8		
Rich	8	30		
Shale	30	35		
Rich	35	130		
Hard Stone	130	140		
Rich	140	160		

GROUTING RECORD	
WELL HAS BEEN GROUTED (CIRCLE APPROPRIATE BOX) YES ☒ NO ☐	
TYPE OF GROUTING MATERIAL (CIRCLE BOX) CEMENT ☒ BENTONITE CLAY ☐	
NO. OF BAGS <u>5</u> GALLONS OF WATER <u>25</u>	NO. OF POUNDS <u>500</u> DEPTH OF GROUT SEAL (TO NEAREST FOOT) FROM <u>0</u> FT. TO <u>20</u> FT. (ENTER 0 IF FROM SURFACE)
CASING RECORD	
CASING TYPES (INSERT APPROPRIATE CODE BELOW) STEEL ☐ CONCRETE ☐ PLASTIC ☐ OTHER ☐	
MAIN CASING TYPE <u>S</u> NOMINAL DIAMETER TOP (MAIN) CASING (NEAREST INCH) <u>6</u> TOTAL DEPTH OF MAIN CASING (NEAREST FOOT) <u>22</u>	OTHER CASING (IF USED) DIAMETER (INCH) <u> </u> DEPTH (FEET) FROM <u> </u> TO <u> </u>
SCREEN RECORD	
SCREEN TYPE OR OPEN HOLE (INSERT APPROPRIATE CODE BELOW) STEEL ☐ BRASS OR BRONZE ☐ OPEN HOLE ☐ PLASTIC ☐ OTHER ☐	
C 2 DEPTH (NEAREST WHOLE FOOT) FROM <u>10</u> TO <u>160</u> 8 9 11 15 17 21 23 24 26 30 32 36 38 39 41 45 47 51 SLOTSIZE 1. <u> </u> 2. <u> </u> 3. <u> </u>	
DIAMETER OF SCREEN <u>56</u> (NEAREST INCH) FROM <u> </u> TO <u> </u>	
GRAVEL PACK <u> </u>	
IF WELL DRILLED WAS A FLOWING WELL (CIRCLE BOX) ☐	
WRA USE ONLY (NOT TO BE FILLED IN BY DRILLER) T ☐ (E.R.O.S.) ☐ W ☐ 70 72 74 75 76 TELESCOPE CASING LOG INDICATOR OTHER DATA AVAILABLE	

PUMPING TEST	
HOURS PUMPED (TO NEAREST HOUR) <u>4</u> PUMPING RATE (GALLONS PER MINUTE TO NEAREST GALLON) <u>5</u> METHOD USED TO MEASURE PUMPING RATE <u>Bucket</u>	
WATER LEVEL: (DISTANCE FROM LAND SURFACE) BEFORE PUMPING <u>30</u> (NEAREST FOOT) WHEN PUMPING <u>22</u> (NEAREST FOOT)	
TYPE OF PUMP USED (CIRCLE APPROPRIATE BOX) (FOR PUMPING TEST) A AIR ☐ P PISTON ☐ T TURBINE ☐ C CENTRIFUGAL ☐ R ROTARY ☐ O OTHER (DESCRIBE BELOW) ☐ J JET ☐ S SUBMERSIBLE ☐	
PUMP INSTALLED	
TYPE OF PUMP (WRITE APPROPRIATE LETTER IN BOX - SEE ABOVE: A, C, J, P, R, S, T, O) <u> </u>	
DRILLER WILL INSTALL PUMP (CIRCLE APPROPRIATE BOX) YES ☐ NO ☐	
CAPACITY: GALLONS PER MINUTE (TO NEAREST GALLON) <u>31</u>	
PUMP HORSE POWER <u>37</u>	
PUMP COLUMN LENGTH (NEAREST FOOT) <u>43</u>	
CASING HEIGHT (CIRCLE APPROPRIATE BOX AND ENTER CASING HEIGHT) ABOVE ☐ BELOW ☐ LAND SURFACE <u>2</u> (NEAREST FOOT)	
LOCATION OF WELL ON LOT SHOW PERMANENT STRUCTURE SUCH AS BUILDINGS, SEPTIC TANKS, AND/OR OTHER LAND MARKS AND INDICATE NOT LESS THAN TWO DISTANCES (MEASUREMENTS TO WELL). <u>161 ft</u> <u>50 ft</u>	

CIRCLE APPROPRIATE BOXES	
A A WELL WAS ABANDONED AND SEALED WHEN THIS WELL WAS COMPLETED ☐	
E ELECTRIC LOG OBTAINED ☐	
P TEST WELL CONVERTED TO PRODUCTION WELL ☐	
I HEREBY CERTIFY THAT I HAVE COMPLIED WITH ALL CONDITIONS STATED ON THE ABOVE-CAPTIONED "PERMIT TO DRILL WELL", AND THAT INFORMATION CONTAINED IN THIS REPORT IS TRUE, ACCURATE, AND COMPLETE TO THE BEST OF MY KNOWLEDGE, INFORMATION AND BELIEF.	
DRILLERS NAME (PLEASE PRINT) <u>George F. Eastman</u> SIGNATURE <u>George F. Eastman</u>	

STATE OF MARYLAND WATER RESOURCES ADMINISTRATION TAWES STATE OFFICE BLDG., ANNAPOLIS, MARYLAND 21401 APPLICATION FOR PERMIT TO DRILL WELL		WRA PERMIT NUMBER 40-23-8978 FILL IN THIS FORM COMPLETELY																		
B 1 4459 1 2 3 (SEQ. NO.) 6 (THIS NUMBER IS TO BE PUNCHED IN COLS. 3-6 ON ALL CARDS) SEQUENCE NO. (WRA USE ONLY)																				
DATE RECEIVED (WRA USE ONLY) 10/17/78 9:30 OWNER <u>Willson Ed</u> COL 15 LAST NAME STREET OR RFD <u>Box 32</u> COL 36 POST OFFICE <u>Ashton Md.</u> COL 57 FIRST NAME COL. 34 COL. 55 COL. 76																				
B 1 CONTINUED DRILLER INFORMATION 1 2 3 (SEQ. NO.) 6 DATE <u>10/17/78</u> LICENSE NUMBER <u>4011</u> 77 80 FIRST NAME <u>D. F. Canterbury</u> DRILLER <u>Canterbury</u> LAST NAME SIGNATURE <u>D. F. Canterbury</u>		B 3 LOCATION OF WELL 1 2 3 (SEQ. NO.) 6 COUNTY <u>Howard</u> 8 (DO NOT ABBREVIATE COUNTY NAME) 21 SUBDIVISION <u>Force Sub.</u> 23 42 SECTION <u>44</u> LOT <u>5</u> 44 48 50 NEAREST TOWN <u>Chesapeake</u> 52 71 MILES FROM TOWN (ENTER 0 IF IN TOWN) <u>2</u> 73 76 77 78																		
B 2 WELL INFORMATION 1 2 3 (SEQ. NO.) 6 MAXIMUM PUMPING RATE (GALLONS PER MINUTE) <u>5</u> 8 12 AVERAGE DAILY QUANTITY NEEDED (GALLONS PER DAY) <u>600</u> 14 20 USE FOR WATER (CIRCLE APPROPRIATE BOX) ☒ D HOME (SINGLE OR DOUBLE HOUSEHOLD UNIT ONLY) ☐ F FARMING, AGRICULTURE, IRRIGATION ☐ I INDUSTRIAL, COMMERCIAL, STATE AND FEDERAL GOVERNMENT. ☐ M MUNICIPAL WATER SUPPLY ☐ P PRIVATE WATER COMPANY ☐ T TEST MUST HAVE STATE HEALTH DEPT. APPROVAL		B 4 DIRECTION FROM TOWN 1 2 3 (SEQ. NO.) 6 CIRCLE APPROPRIATE BOX <table border="1" style="width:100%; text-align: center;"><tr><td>☐ N NORTH</td><td>☒ E EAST</td><td>☐ NE NORTHEAST</td><td>☐ SE SOUTHEAST</td></tr><tr><td>☐ S SOUTH</td><td>☐ W WEST</td><td>☐ NW NORTHWEST</td><td>☐ SW SOUTHWEST</td></tr></table> NEAR WHAT ROAD <u>Box 32</u> <table border="1" style="width:100%; text-align: center;"><tr><td>ON WHICH SIDE OF ROAD (CIRCLE APPROPRIATE BOX)</td><td>☐ N NORTH</td><td>☒ S SOUTH</td><td>☐ E EAST</td><td>☐ W WEST</td></tr><tr><td></td><td>32</td><td>32</td><td>32</td><td>32</td></tr></table> DISTANCE FROM ROAD (ENTER DISTANCE AND CIRCLE APPROPRIATE BOX) <u>150</u> 34 37 38 39	☐ N NORTH	☒ E EAST	☐ NE NORTHEAST	☐ SE SOUTHEAST	☐ S SOUTH	☐ W WEST	☐ NW NORTHWEST	☐ SW SOUTHWEST	ON WHICH SIDE OF ROAD (CIRCLE APPROPRIATE BOX)	☐ N NORTH	☒ S SOUTH	☐ E EAST	☐ W WEST		32	32	32	32
☐ N NORTH	☒ E EAST	☐ NE NORTHEAST	☐ SE SOUTHEAST																	
☐ S SOUTH	☐ W WEST	☐ NW NORTHWEST	☐ SW SOUTHWEST																	
ON WHICH SIDE OF ROAD (CIRCLE APPROPRIATE BOX)	☐ N NORTH	☒ S SOUTH	☐ E EAST	☐ W WEST																
	32	32	32	32																
APPROXIMATE DEPTH OF WELL <u>150</u> FEET 24 28 APPROXIMATE DIAMETER OF WELL <u>6</u> (NEAREST INCH) METHOD OF DRILLING USED (CIRCLE APPROPRIATE METHOD) <table border="1" style="width:100%; text-align: center;"><tr><td>☒ BORED (OR AUGERED)</td><td>☐ JETTED</td><td>☐ DRIVEN</td></tr><tr><td>☐ AIR-ROTARY</td><td>☐ AIR-PERCUSSION</td><td>☐ ROTARY (HYDRAULIC ROTARY)</td></tr><tr><td>☐ CABLE</td><td>☐ REVERSE-ROTARY</td><td>☐ DRIVE-POINT</td></tr></table> OTHER (DESCRIBE)		☒ BORED (OR AUGERED)	☐ JETTED	☐ DRIVEN	☐ AIR-ROTARY	☐ AIR-PERCUSSION	☐ ROTARY (HYDRAULIC ROTARY)	☐ CABLE	☐ REVERSE-ROTARY	☐ DRIVE-POINT	DRAW A SKETCH BELOW SHOWING LOCATION OF WELL IN RELATION TO NEARBY TOWNS, ROADS AND STREAMS WITH NORTH IN THE DIRECTION OF THE ARROW, AND GIVE DISTANCE FROM WELL TO NEAREST ROAD JUNCTION OR STREAM CROSSING SHOWN ON THE SKETCH. ALSO SHOW, BY MEANS OF AN "X", THE WELL LOCATION IN THE BOX BELOW AND THE BOX NUMBER FROM THE WELL-LOCATION MAP. 22' CASING 2' ABOVE GR 20' OPEN HOLE 5-BAGS CEMENT OK 10/17/78									
☒ BORED (OR AUGERED)	☐ JETTED	☐ DRIVEN																		
☐ AIR-ROTARY	☐ AIR-PERCUSSION	☐ ROTARY (HYDRAULIC ROTARY)																		
☐ CABLE	☐ REVERSE-ROTARY	☐ DRIVE-POINT																		
REPLACEMENT OR DEEPEINED WELLS (CIRCLE APPROPRIATE BOX) ☒ N THIS WELL WILL NOT REPLACE AN EXISTING WELL. ☐ Y THIS WELL WILL REPLACE A WELL THAT WILL BE ABANDONED AND SEALED ☐ S THIS WELL WILL REPLACE A WELL THAT WILL BE USED AS A STANDBY ☐ D THIS WELL WILL DEEPEIN AN EXISTING WELL PERMIT NUMBER OF WELL TO BE REPLACED OR DEEPEINED (IF AVAILABLE) 41 52																				
NOT TO BE FILLED IN BY DRILLER (WRA USE ONLY) <table border="1" style="width:100%; text-align: center;"><tr><td>APPROPRIATION PERMIT NUMBER</td><td>ENGINEER REVIEW DISTRICT NO.</td></tr><tr><td><u>54</u></td><td><u>63</u></td></tr><tr><td>FORCE</td><td>CONDITIONS</td></tr><tr><td><u>67</u> <u>68</u></td><td><u>70</u> <u>71</u> <u>72</u> <u>73</u> <u>74</u> <u>75</u> <u>76</u> <u>77</u> <u>78</u> <u>79</u></td></tr></table>		APPROPRIATION PERMIT NUMBER	ENGINEER REVIEW DISTRICT NO.	<u>54</u>	<u>63</u>	FORCE	CONDITIONS	<u>67</u> <u>68</u>	<u>70</u> <u>71</u> <u>72</u> <u>73</u> <u>74</u> <u>75</u> <u>76</u> <u>77</u> <u>78</u> <u>79</u>	BOX NUMBER <table border="1" style="width:100%; text-align: center;"><tr><td>E <u>820</u></td></tr><tr><td>N <u>490</u></td></tr></table> NORTH COORDINATE <u>4900000</u> 50 51 52 53 54 55 EAST COORDINATE <u>0380000</u> 57 58 59 60 61 62 63 ELEVATION AT WELL HEAD (FEET) <u>65</u> <u>66</u> <u>67</u> <u>68</u> 0/0 5/0	E <u>820</u>	N <u>490</u>								
APPROPRIATION PERMIT NUMBER	ENGINEER REVIEW DISTRICT NO.																			
<u>54</u>	<u>63</u>																			
FORCE	CONDITIONS																			
<u>67</u> <u>68</u>	<u>70</u> <u>71</u> <u>72</u> <u>73</u> <u>74</u> <u>75</u> <u>76</u> <u>77</u> <u>78</u> <u>79</u>																			
E <u>820</u>																				
N <u>490</u>																				
B 4 CONTINUED HEALTH DEPARTMENT APPROVAL 1 2 3 (SEQ. NO.) 6 STATE HEALTH (CIRCLE BOX) <u>S</u> COUNTY NAME <u>Howard</u> COUNTY NO. <u>W28825</u> DATE <u>10/17/78</u> APPROVED BY <u>Fred Fromelt, Sanitarian</u>																				
B 5 SPECIAL CONDITIONS 8-63 (WRA USE ONLY) 1 2 3 (SEQ. NO.) 6																				

MD Route 32 →

RESTRICTED
VEHICULAR
ACCESS 10'

Fox Pause

LOT # 5

Map 35

R. 190

10,000 S.F.
PRIVATE
SEWAGE
EASEMENT

10' DRIVEWAY

623,771

LOT 6

PROP.D
MIN. FEE - 406.0

WELL

9/2
T.C
1


1:60

WOODS

N 30° 46' 32" E

3201

430

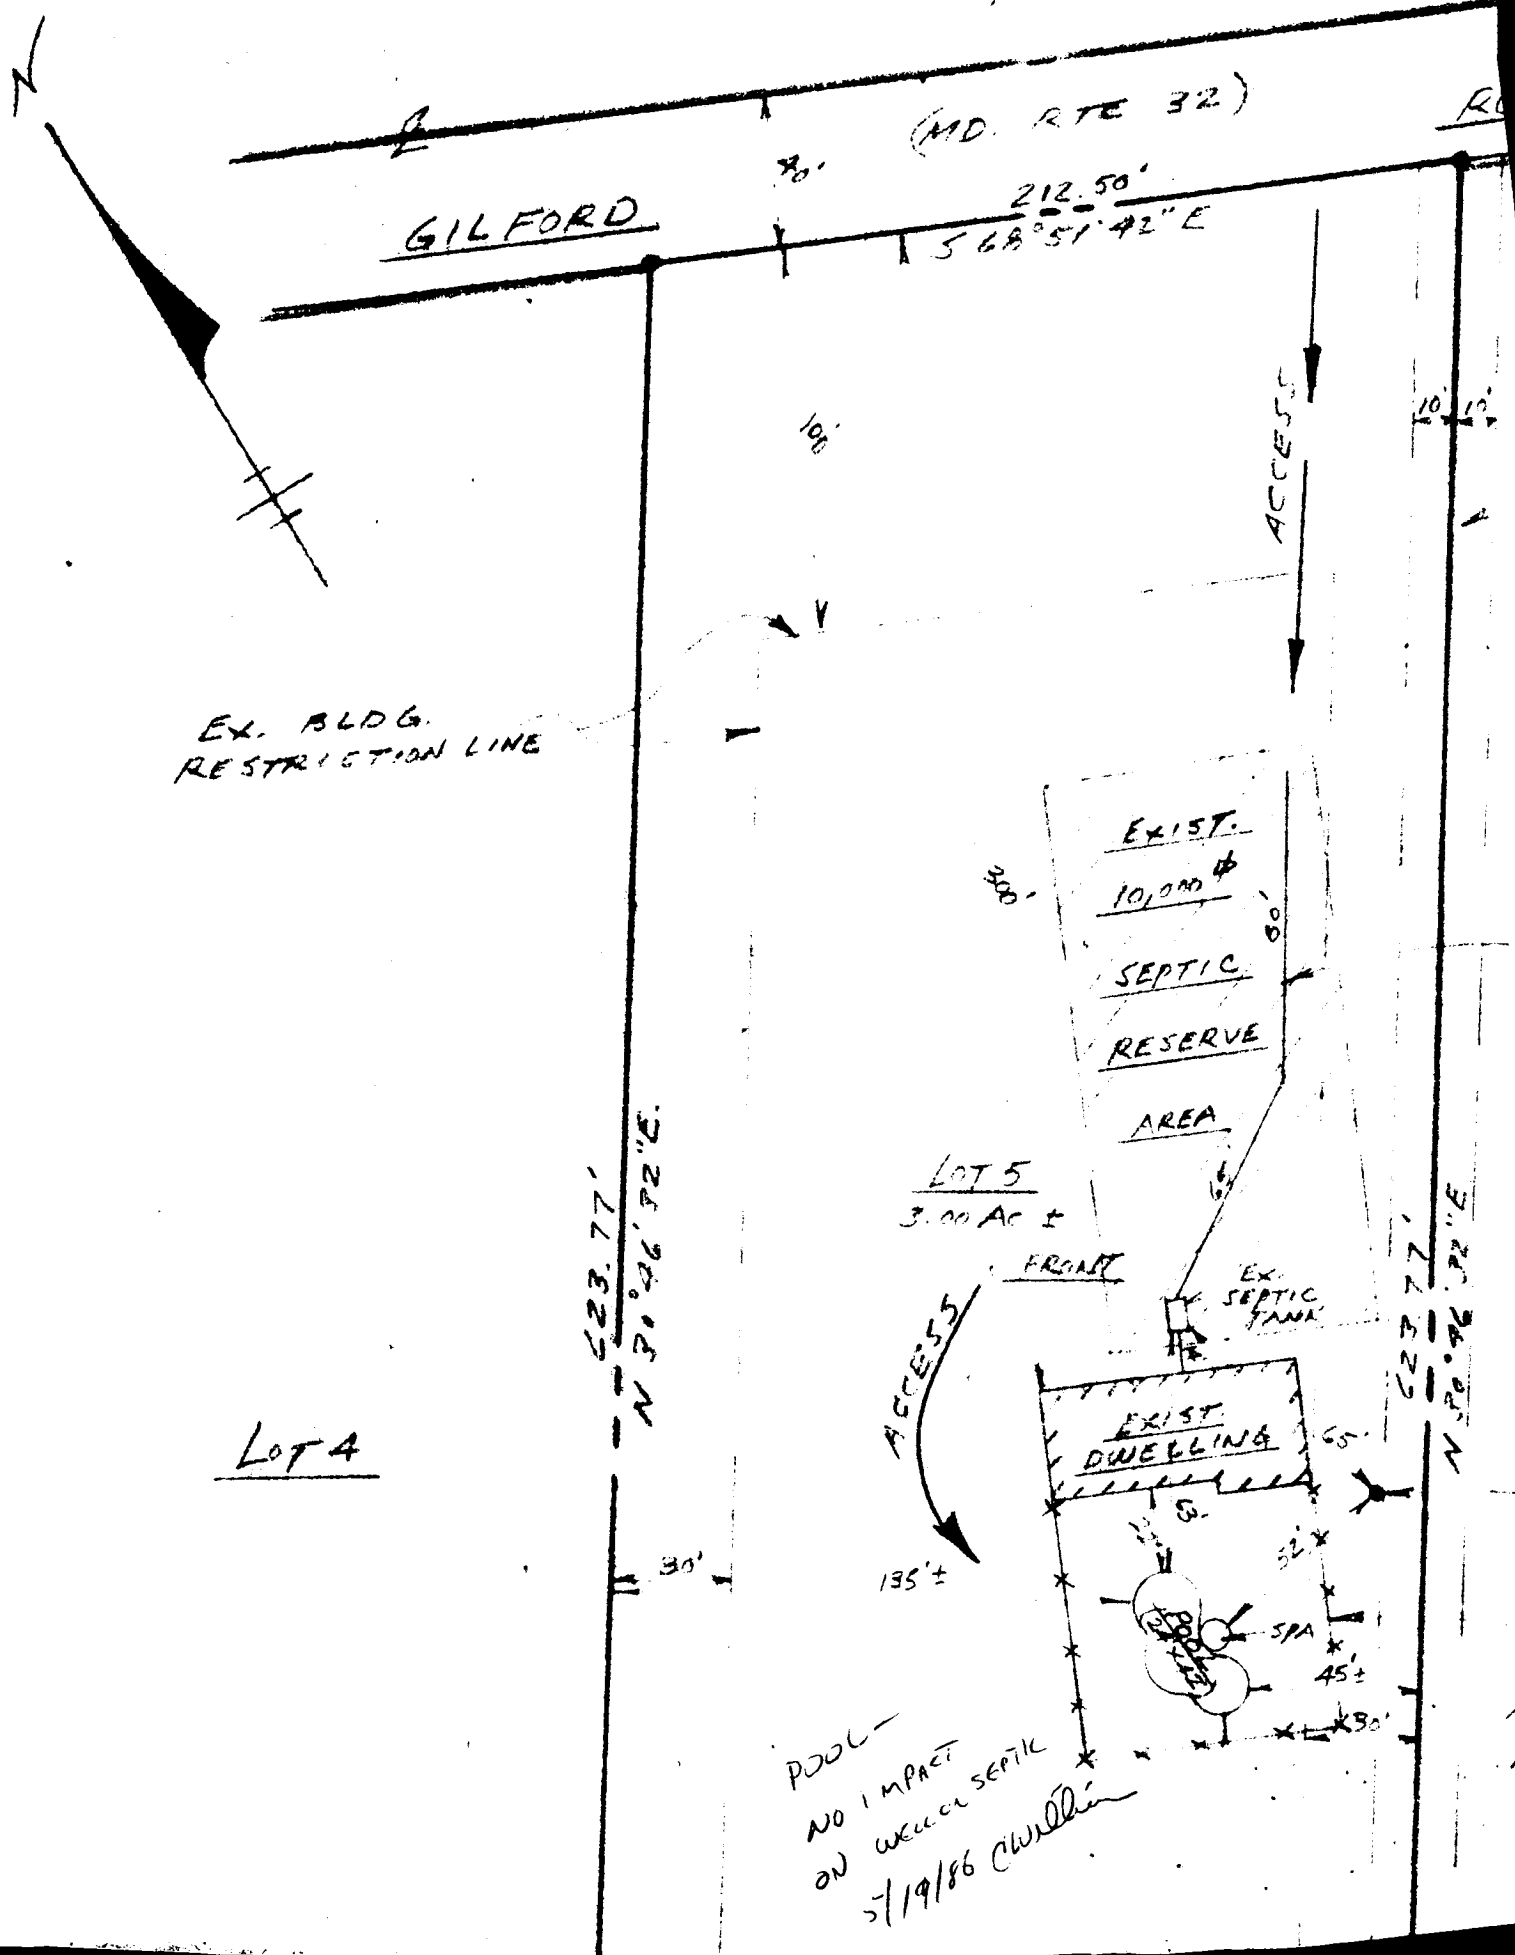

APPROVED

WALK-THRU BUILDING PERMIT

BP# 800150345 A# 27431


DATE: 7/15/04

DESC. OF WORK: Pave

NO impact on water or septic

NOTES:


- 1) B.R.L. information, if shown, was obtained from existing record plat or local agencies and is not guaranteed by NTT, Inc.
- 2) Building line and/or Flood Zone information is subject to the interpretation of the originator.
- 3) NTT, Inc. does not certify to unshown or recorded encroachments or overlaps.
- 4) Property markers not found, or guaranteed by this location.
- 5) Setback distance accuracy.

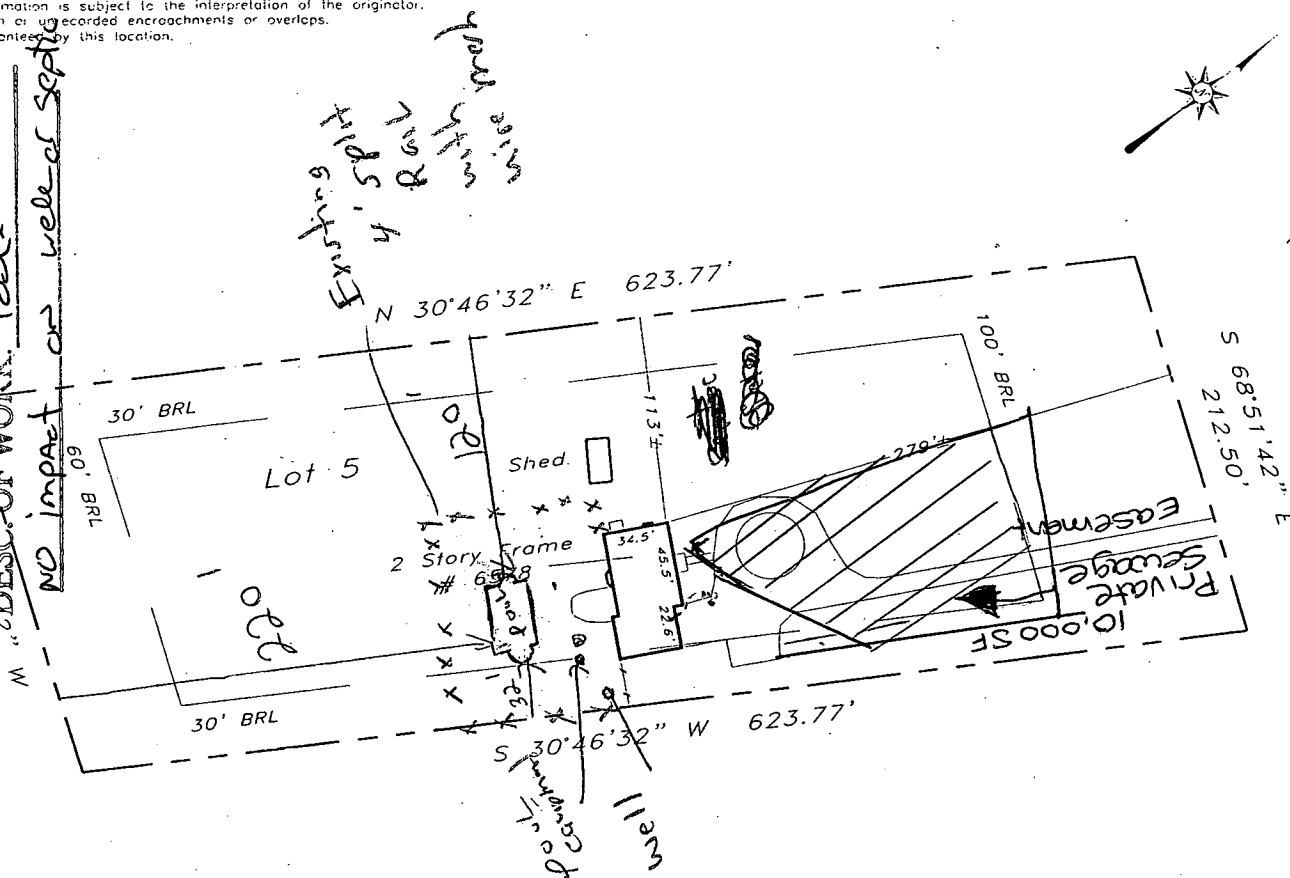

Maryland Route 32 (per plat)
(aka Guilford Road)

Subject property is shown in Zone C on the National Flood Insurance Program Flood Insurance Rate Map of Howard County, Maryland. Panel # 33 of 45 Community Panel # 240044-0033 B Effective date: December 4, 1986

This is to certify that I have surveyed the property shown hereon, being known as Lot 5 6578 Guilford Road recorded in the Land Records of Howard County, Maryland in Plat Bk. 4047 Liber 3469 Folio 595 for the purpose of locating the improvements thereon.

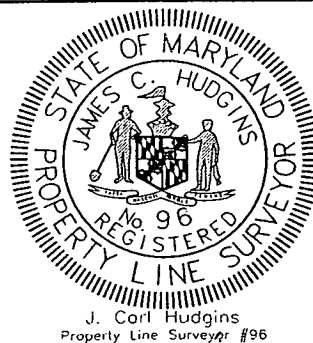

J. Carl Hudgins
Property Line Surveyor #96

LOCATION DRAWING
6578 Guilford Road
Fox Pause
5th election district
HOWARD COUNTY, MARYLAND

NTT Associates, Inc.

16205 Old Frederick Road
Mt. Airy, Maryland 21771
Ph. (410)442-2031
Fax No. (410)442-1315

Scale:	1"= 100'
Date:	June 4, 2004
Field by:	JLM
Drawn by:	JLM
Drawing #	040416HOC

- * This plat is of benefit to the consumer only insofar as it is required by a lender or a title insurance company or its agent in connection with contemplated transfer, financing, or refinancing purposes.
- * This plat is not to be relied upon for the establishment of location of fences, garages, buildings, or other existing or future structures.
- * This plat does not provide for the accurate identification of property boundary lines, but such identification may not be required for the transfer of title or for securing financing or refinancing.