

SYSTEM TO BE INSTALLED FIRST
BEFORE BUILDING PERMIT CAN
BE SIGNED.

PERMIT

SEWAGE DISPOSAL SYSTEM

MARYLAND STATE DEPARTMENT OF HEALTH

HOWARD COUNTY

ELLICOTT CITY

DISTRICT 5th

DATE 9/11/79

INDEXED

Donald Parlette

IS PERMITTED TO INSTALL ☒ ALTER

ADDRESS 6575 Route 32, Clarksville, Md. 21029

PHONE 286-2140

SUBDIVISION Fox Pause

ROAD 6574 Route 32

LOT 4

PROPERTY OWNER Edward and Judith Warfield

ADDRESS 6652 Hawkeye Run, Columbia, Md. 21044

Phone: work - 948-2700, Ext. 2487

SPECIFICATIONS 3 bedrooms

SEPTIC TANK CAPACITY 1000 GALLONS

DRAIN FIELD DEPTH FEET, BOTTOM AREA SQ. FT.

DEEP TRENCH DEPTH FEET, BOTTOM AREA SQ. FT.

SEEPAGE PITS ☒ ABSORBENT SIDE-WALL AREA 156 SQ. FT. per bedroom.

INLET PIPE 5 FT. BELOW ORIGINAL GRADE, MAXIMUM DEPTH 13 FT. BELOW ORIGINAL GRADE

EFFECTIVE DEPTH AT FT. BELOW ORIGINAL GRADE.

LOCATE DISPOSAL AREA 65 FT. FROM front LOT LINE AND 20 FT. FROM left LOT LINE AS SEEN WHEN
FACING LOT FROM Route 32.

NOTE: NO SEWER PIPE TO BE LAYED IN FILL DIRT. WELL PIPE TO BE LAYED IN CASE IRON
SLEEVE IN AREA NEAR SEWAGE ~~XXX~~ DISPOSAL AREA.

85' trench, 2 ft. stone, 11 ft. deep, location ok
ok to gravel 1st 20 ft. L. F.

PLANS APPROVED BY Raymond Hodges

DATE 10/17/78

COVER NO WORK UNTIL INSPECTED AND APPROVED.

NEITHER THE HOWARD COUNTY COUNCIL NOR THE HEALTH DEPARTMENT IS RESPONSIBLE FOR THE SUCCESSFUL OPERATION OF ANY SYSTEM.

NOTE: IF TRENCH IS USED CALL FOR INSPECTION BEFORE PLACING GRAVEL IN TRENCH.

NOTE: NO DRY WELL SHALL EXCEED 15 FOOT IN DIAMETER.


NOTE: ALL PIPE FROM HOUSE TO DISPOSAL AREA MUST BE CAST IRON.

PERMIT VOID AFTER THREE YEARS.

NOTE: INSTALL STAND PIPE ON SEPTIC TANK AND DRY WELL. STAND PIPES MUST BE 6 INCHES IN DIAMETER. CAST IRON, CONCRETE OR TERRA
COTTA ACCEPTED.

*INSTALLER IS RESPONSIBLE FOR OBTAINING FINAL APPROVAL ON THIS PERMIT.

29432

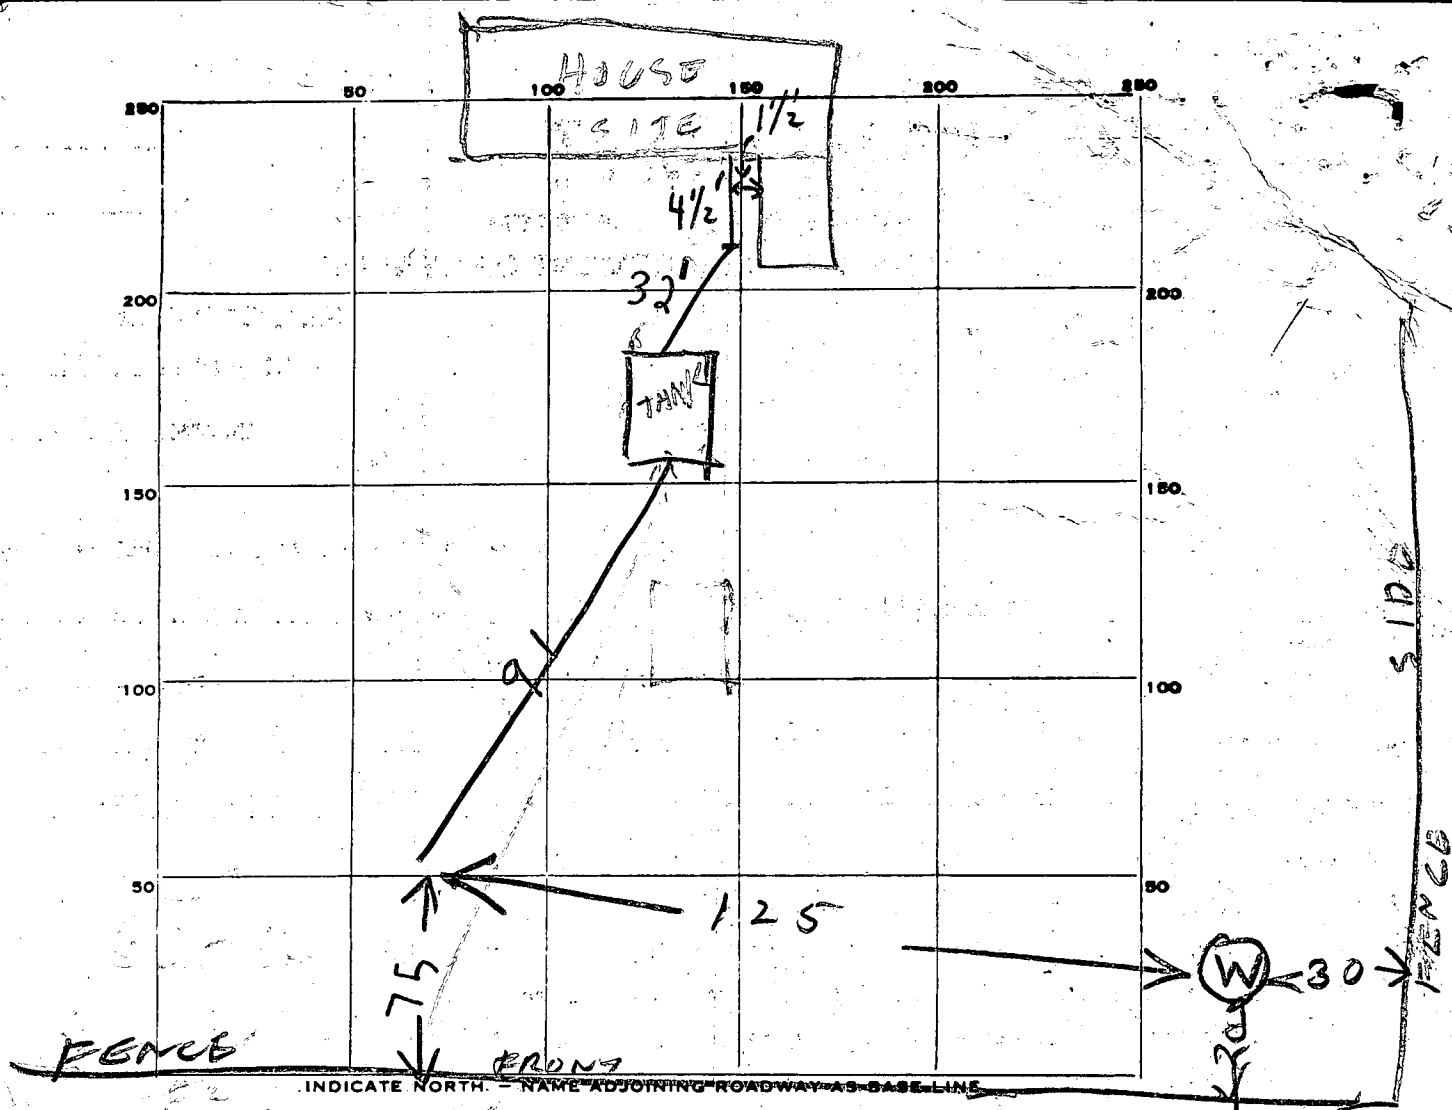

PERMIT CARD

✓ ROUTE 32

SEPTIC TANK, LEVEL

OK

CLEANOUTS

OK

DISTRIBUTION BOX, LEVEL

DITCH

FILE FIELD, DEPTH

11

FT.

TRENCH WIDTH

2 1/2

FT.

GRAVEL DEPTH

8

IN.

TOTAL LENGTH

91

FT.

NUMBER OF TRENCHES

1

TOTAL BOTTOM AREA

728

SEEPAGE PITS, INSIDE DIAMETER

FT.

DEPTH BELOW INLET

FT.

ABSORBENT AREA

SQ. FT.

REMARKS

9-17-79 OK to gravel 1st 20 ft. & gravel middle,

9/19/79 ALL OF DITCH FILLED WITH STONE TODAY - 11/10
CONNECT TO HOUSE & CALL OK TO COVER
DITCH & TANK R/H 3/20/80 checked system - house
connection - completed.

C.B.D.

DATE SYSTEM APPROVED

3/20/80

INSPECTOR

C. B. Shuck

APPLICATION

A 27432

P

SEWAGE DISPOSAL TESTING

STATE OF MARYLAND - DEPARTMENT OF HEALTH AND MENTAL HYGIENE

HOWARD COUNTY HEALTH DEPARTMENT
ENVIRONMENTAL HEALTH SERVICES

SYSTEM FIRST

DISTRICT 5th

DATE 1/13/78

P. O. BOX 476, ELLICOTT CITY, MARYLAND 21043
TELEPHONE: 465-5000, EXT. 356

NO SEWAGE PIPE TO BE

LAYED IN FILL DIRT

WELL PIPE TO BE LAYED IN CAST IRON SLEEVE
IN AREA NEAR SEWAGE DISPOSAL AREA

SEE OTHER SHEET FOR REST OF SPECS

BLDG. PERMIT SIGNED
AND RETURNED 10-3-79

Serial # 41123

TO: THE COUNTY HEALTH OFFICER
ELLICOTT CITY, MARYLANDI, HEREBY, APPLY FOR THE NECESSARY TEST IN ORDER TO CONSTRUCT (OR RECONSTRUCT) A SEWAGE
DISPOSAL SYSTEM.PROPERTY OWNER Edward & Judith Warfield
Edwin G. Willson propertyADDRESS 6652 Hawkeye Run
6574 Route 32 PHONE 596-5793PROPERTY LOCATION Clarksville, Md. 21044 work - 948-2700
Columbia, Md. 21044 X 2487SUBDIVISION Fox Pause Joy Pause LOT NO. 4ROAD AND DESCRIPTION Route 32 6574 Route 32.
Clarkville, Md. 21029SIZE OF LOT 3 acres m/1 TYPE BLDG. 3 or 4 bedrooms
NUMBER OF BEDROOMS


IF NOT SINGLE RESIDENCE DESCRIBE

THE SYSTEM INSTALLED UNDER THIS APPLICATION IS ACCEPTABLE ONLY UNTIL PUBLIC
FACILITIES BECOME AVAILABLE.SIGNATURE OF APPLICANT /s/ Edwin G. WillsonAPPROVED BY Raymond Hodge FOR DynWell DATE 10/17/78
(KIND OF SYSTEM)REJECTED BY _____ FOR _____ DATE _____
(KIND OF SYSTEM)

HOLD PENDING FURTHER TESTS _____ DATE _____

REASONS FOR REJECTION OR HOLDING 1/3/78 - Held for Review Perched Water
4/1/7810/17/78 FINAL PLAT SIGNED

THIS IS NOT A PERMIT

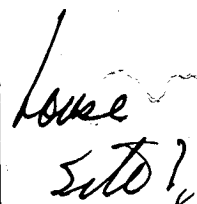

INDICATE NORTH. - NAME ADJOINING ROADWAY AS BASE LINE

DATE	TEST NO.	DEPTH	PRE-WET		TEST - 1" DROP		TIME
			START	STOP	START	STOP	
1/31/88	1D	14	125	138	138	142	10
	1S	4	125	127	127	129	1
	2D	13	130	145	145	205	20
	2S	4	130	138	139	144	6
	3D	12	152	203	203	219	16
	3S	4	152	202	202	230	28
	4V	13	TOP BOT	5 FT 2 FT	CLAY SANDY	DRY	
	5V	13	TOP BOT	5 FT 2 FT	CLAY SANDY		
	26.1H	13	SANDY NOT TESTED		13 FT	TO 14	GIN
	7R	7	NOT TESTED ROCK				

max depth
4 ft
air time
14 min

1/31/88

REMARKS

TYPE OF SOIL

TESTED BY

R. HODGES

ALSO PRESENT

Frick Co
Wallson
1881

MD RT #32

SCALE
1" = 50'


ELEVATIONS

PERC TEST - 447'
WELL - 448'
FIRST FLOOR - 446'
BASEMENT - 439'
INV. AT FOUNDATION - 444'-0"
INV. AT TANK - 443'-7"
INV. AT DRYWELL - 442'-0"

TANK - 1250 gal.

ELEVATIONS SAME
AS WHEN PERKED

DRYWELL 15ft SQUARE
8ft DEEP
BELOW INV.

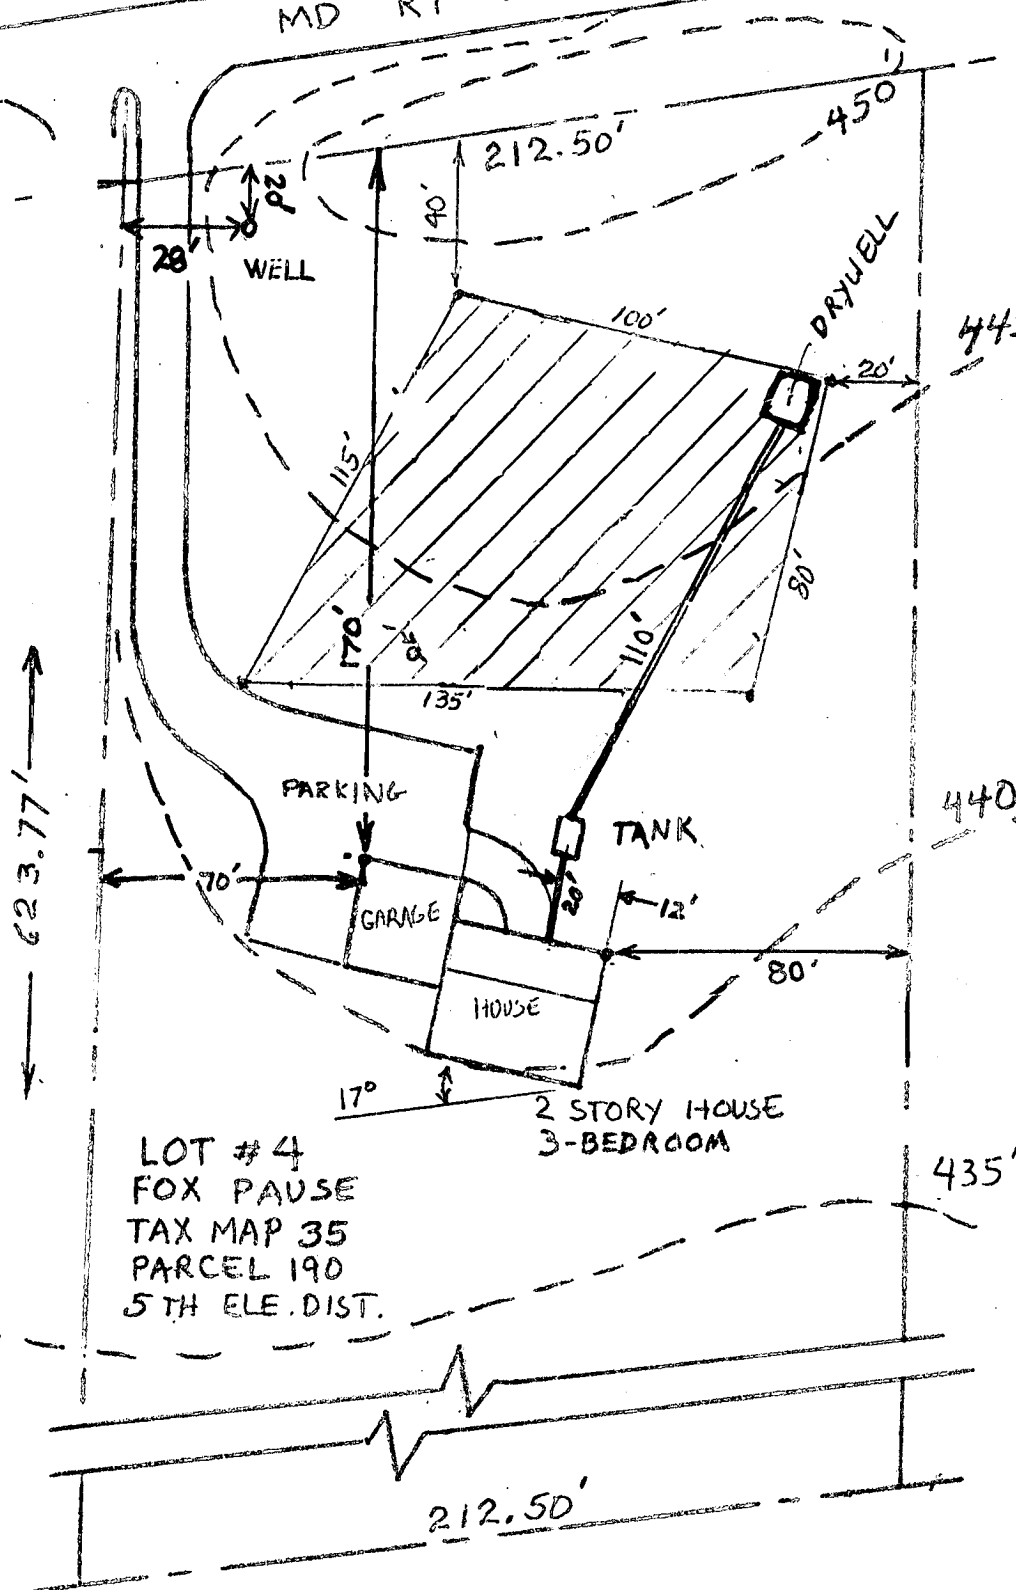

LOT #4
FOX PAUSE
TAX MAP 35
PARCEL 190
5TH ELE. DIST.

2 STORY HOUSE
3-BEDROOM

I CERTIFY THE ABOVE MEASUREMENTS AND ELEVATIONS
ARE ACTUAL & CORRECT FOR THIS PROPERTY


PLANS OK
8/13/79 RH

SIGNED

596-5795


Edward O. Wayfield / DATE 8/13/79
6652 HAWKEYE DR
COLUMBIA MD 21044

STATE OF MARYLAND WATER RESOURCES ADMINISTRATION TAWES STATE OFFICE BLDG., ANNAPOLIS, MARYLAND 21401 APPLICATION FOR PERMIT TO DRILL WELL		WRA PERMIT NUMBER <u>HO-73-2911</u> FILL IN THIS FORM COMPLETELY	
DATE RECEIVED (WRA USE ONLY) <u>10/17/78</u> OWNER COL 15 LAST NAME <u>William Ed.</u> FIRST NAME <u>Ed.</u> COL. 34 STREET OR RFD COL 36 <u>Box 32</u> COL. 55 POST OFFICE COL 57 <u>Adelton Md.</u> COL. 76			
B 1 CONTINUED 1 2 3 (SEQ. NO.) 6 DATE <u>9/5/78</u> LICENSE NUMBER <u>40</u> <u>V. F. Fortenberry</u> FIRST NAME DRILLER LAST NAME SIGNATURE <u>V. F. Fortenberry</u> B 3 LOCATION OF WELL 1 2 3 (SEQ. NO.) 6 COUNTY <u>Howard</u> (DO NOT ABBREVIATE COUNTY NAME) 21 SUBDIVISION <u>Adelton</u> 42 SECTION <u>44</u> LOT <u>4</u> 50 NEAREST TOWN <u>Adelton</u> 71 MILES FROM TOWN (ENTER 0 IF IN TOWN) <u>2</u> MI 76 77 78			
B 2 WELL INFORMATION 1 2 3 (SEQ. NO.) 6 MAXIMUM PUMPING RATE (GALLONS PER MINUTE) <u>5</u> 8 12 AVERAGE DAILY QUANTITY NEEDED (GALLONS PER DAY) <u>600</u> 14 20 USE FOR WATER (CIRCLE APPROPRIATE BOX) ☒ HOME (SINGLE OR DOUBLE HOUSEHOLD UNIT ONLY) ☐ FARMING, AGRICULTURE, IRRIGATION ☐ INDUSTRIAL, COMMERCIAL, STATE AND FEDERAL GOVERNMENT ☐ MUNICIPAL WATER SUPPLY } MUST HAVE STATE HEALTH DEPT. APPROVAL ☐ PRIVATE WATER COMPANY ☐ TEST B 4 DIRECTION FROM TOWN (CIRCLE APPROPRIATE BOX) N NORTH ☒ E EAST ☐ NE NORTHEAST ☐ SE SOUTHEAST S SOUTH ☐ W WEST ☐ NW NORTHWEST ☐ SW SOUTHWEST NEAR WHAT ROAD <u>Box 32</u> ON WHICH SIDE OF ROAD (CIRCLE APPROPRIATE BOX) N 32 S 32 E 32 W 32 DISTANCE FROM ROAD (ENTER DISTANCE AND CIRCLE APPROPRIATE BOX) <u>150</u> 34 37 38 39			
APPROXIMATE DEPTH OF WELL <u>150</u> FEET APPROXIMATE DIAMETER OF WELL <u>6</u> (NEAREST INCH) METHOD OF DRILLING USED (CIRCLE APPROPRIATE METHOD) BORED (OR AUGURED) ☒ JETTED ☐ DRIVEN ☐ 30-37 AIR-ROTARY AIR-PERCUSSION ROTARY (HYDRAULIC ROTARY) CABLE REVERSE-ROTARY DRIVE-POINT OTHER (DESCRIBE) _____ REPLACEMENT OR DEEPEINED WELLS (CIRCLE APPROPRIATE BOX) ☒ THIS WELL WILL NOT REPLACE AN EXISTING WELL ☐ THIS WELL WILL REPLACE A WELL THAT WILL BE ABANDONED AND SEALED ☐ THIS WELL WILL REPLACE A WELL THAT WILL BE USED AS A STANDBY ☐ THIS WELL WILL DEEPEIN AN EXISTING WELL PERMIT NUMBER OF WELL TO BE REPLACED OR DEEPEINED (IF AVAILABLE) _____ NOT TO BE FILLED IN BY DRILLER (WRA USE ONLY) APPROPRIATION PERMIT NUMBER <u>54</u> ENGINEER REVIEW DISTRICT NO. <u>63</u> FORCE <u>67</u> WRITE INITIALS IN BOX CONDITIONS <u>70</u> 71 72 73 74 75 76 77 78 79		N ↑ 140' DEEP 12 GPM 21'-CASING 2'-ABOVE GR / NOTT AD. 19'-OPEN HOLE 5 - BAGS CEMENT PER RICHIE WATER LEVEL COMP RPT OK 10/17/78 NOT FOUND ML 2/25/04	
B 4 HEALTH DEPARTMENT APPROVAL 1 2 3 (SEQ. NO.) 6 41 S STATE HEALTH (CIRCLE BOX) COUNTY NAME <u>Howard</u> COUNTY NO. <u>W28024</u> MD. DAY YR. <u>09</u> <u>08</u> <u>78</u> DATE <u>09</u> <u>08</u> <u>78</u> APPROVED BY <u>Fred Frommelt, Sanitarian</u> 43 48			
B 5 SPECIAL CONDITIONS 8-63 (WRA USE ONLY) 1 2 3 (SEQ. NO.) 6			
HEALTH			

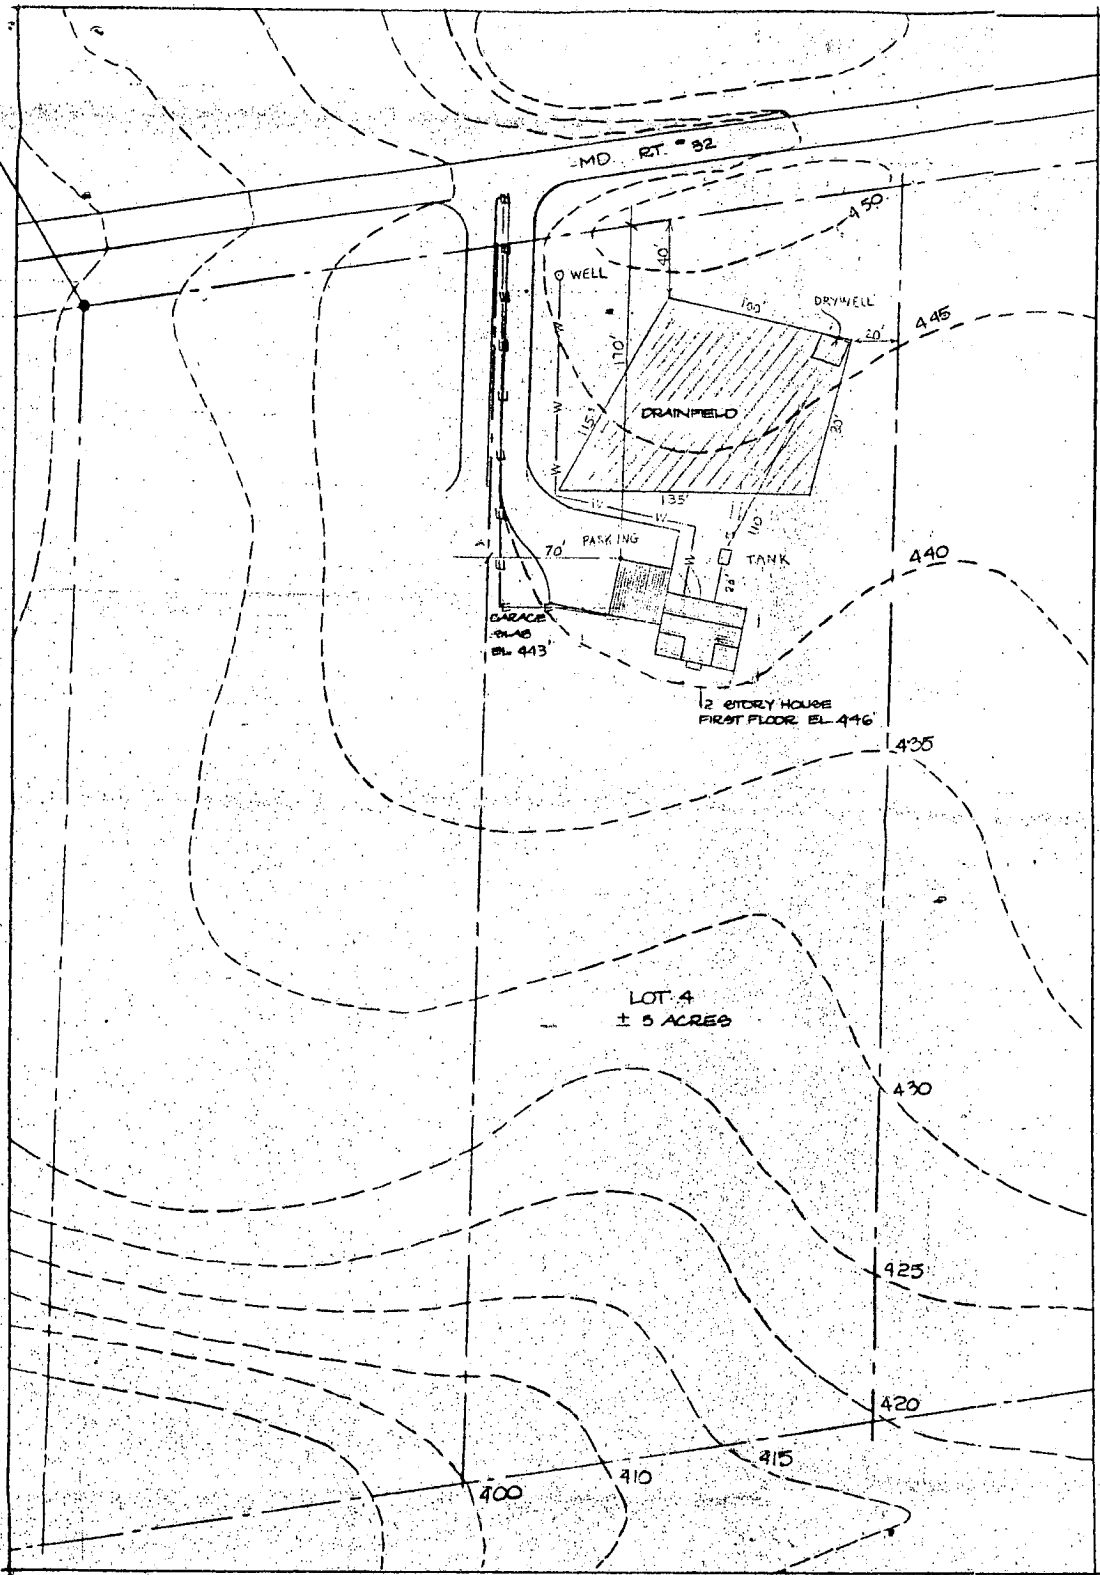

SITE PLAN 1:100

LOT #4
FOX PA
LOT #4
OF LOT
TAXMAP
PARCEL
15TH ELEC
HOWARD

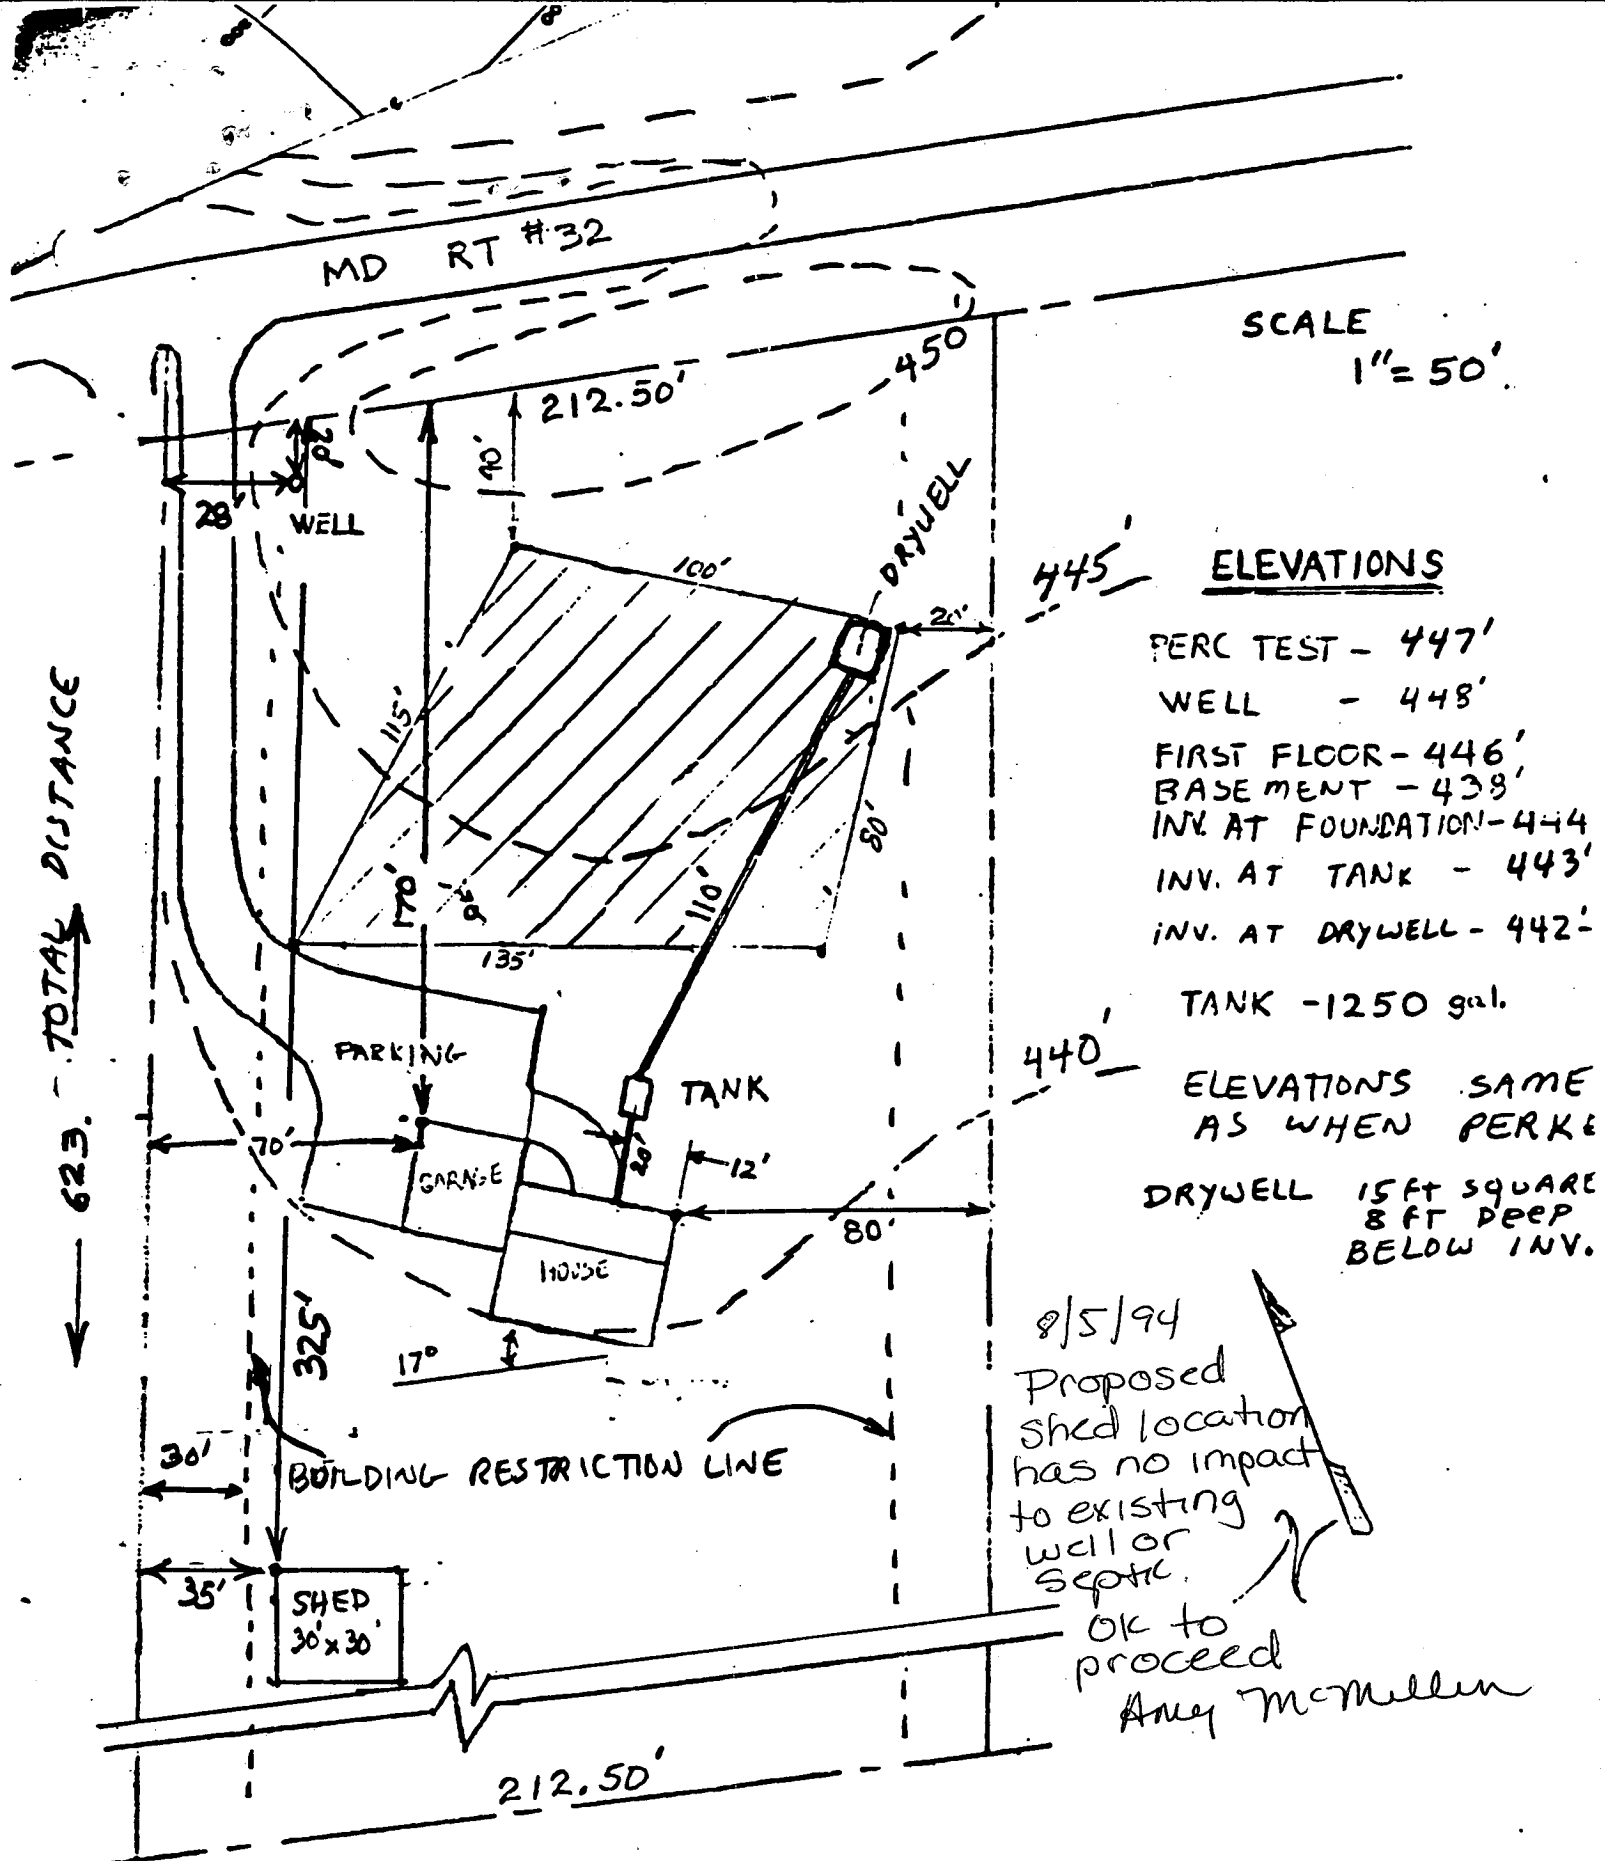

I CERTIFY THE ABOVE MEASUREMENTS AND ELEVATIONS ARE ACTUAL & CORRECT FOR THIS PROPERTY

PLANS OK
8/13/79 RH

SIGNED Edward O. Warfield DATE 6/20/94