

12/3/79 - a m. if possible
or 12/4/79

PERMIT

PERMIT

SEWAGE DISPOSAL SYSTEM

MARYLAND STATE DEPARTMENT OF HEALTH*

HOWARD COUNTY

ELLICOTT CITY

DISTRICT 4th

DATE 7/13/79

INDEXED

William B. Martin

IS PERMITTED TO INSTALL X ALTER

ADDRESS 3268 Route 94, Woodbine, Md.

PHONE 489-4983

SUBDIVISION _____ ROAD 3248 Route 94

LOT

PROPERTY OWNER William B. Martin

ADDRESS same as above

SPECIFICATIONS Tenant House - 3 bedrooms

SEPTIC TANK CAPACITY 1000 GALLONS

DRAIN FIELD _____ DEPTH _____ FEET, BOTTOM AREA _____ SQ. FT.

DEEP TRENCH _____ DEPTH _____ FEET, BOTTOM AREA _____ SQ. FT.

SEEPAGE PITS. X ABSORBENT SIDE-WALL AREA 200 SQ. FT. per bedroom.

INLET PIPE 4 FT. BELOW ORIGINAL GRADE. MAXIMUM DEPTH 10 FT. BELOW ORIGINAL GRADE

EFFECTIVE DEPTH AT _____ FT. BELOW ORIGINAL GRADE.

EFFECTIVE DEPTH AT _____ FT. BELOW ORIGINAL GRADE TO right side of lot per Mr. Martin when facing
LOCATE DISPOSAL AREA 45 +/- FT. FROM house _____
LET LINE AND XXXXX FT FROM XXXXX TO LINE AS SEEN WHEN X

~~XXXXXXXXXXXX~~ lot from Route 94. Perc hole 1 & 2 area. If trench is needed to make up necessary sidewall area; leave 5 ft. earth buffer between trench and dry well. Trench to follow contour of the ground.

PLANS APPROVED BY Charles B. Streaker

DATE 7/13/79

COVER NO WORK UNTIL INSPECTED AND APPROVED.

NEITHER THE HOWARD COUNTY COUNCIL NOR THE HEALTH DEPARTMENT IS RESPONSIBLE FOR THE SUCCESSFUL OPERATION OF ANY SYSTEM.

NOTE: IF TRENCH IS USED CALL FOR INSPECTION BEFORE PLACING GRAVEL IN TRENCH.

NOTE: NO DRY WELL SHALL EXCEED 15 FOOT IN DIAMETER.


NOTE: ALL PIPE FROM HOUSE TO DISPOSAL AREA MUST BE CAST IRON.

PERMIT VOID AFTER THREE YEARS.

NOTE: INSTALL STAND PIPE ON SEPTIC TANK AND DRY WELL. STAND PIPES MUST BE 8 INCHES IN DIAMETER. CAST IRON, CONCRETE OR TERRAZZO ACCEPTED.

***INSTALLER IS RESPONSIBLE FOR OBTAINING FINAL APPROVAL ON THIS PERMIT.**

A 27792

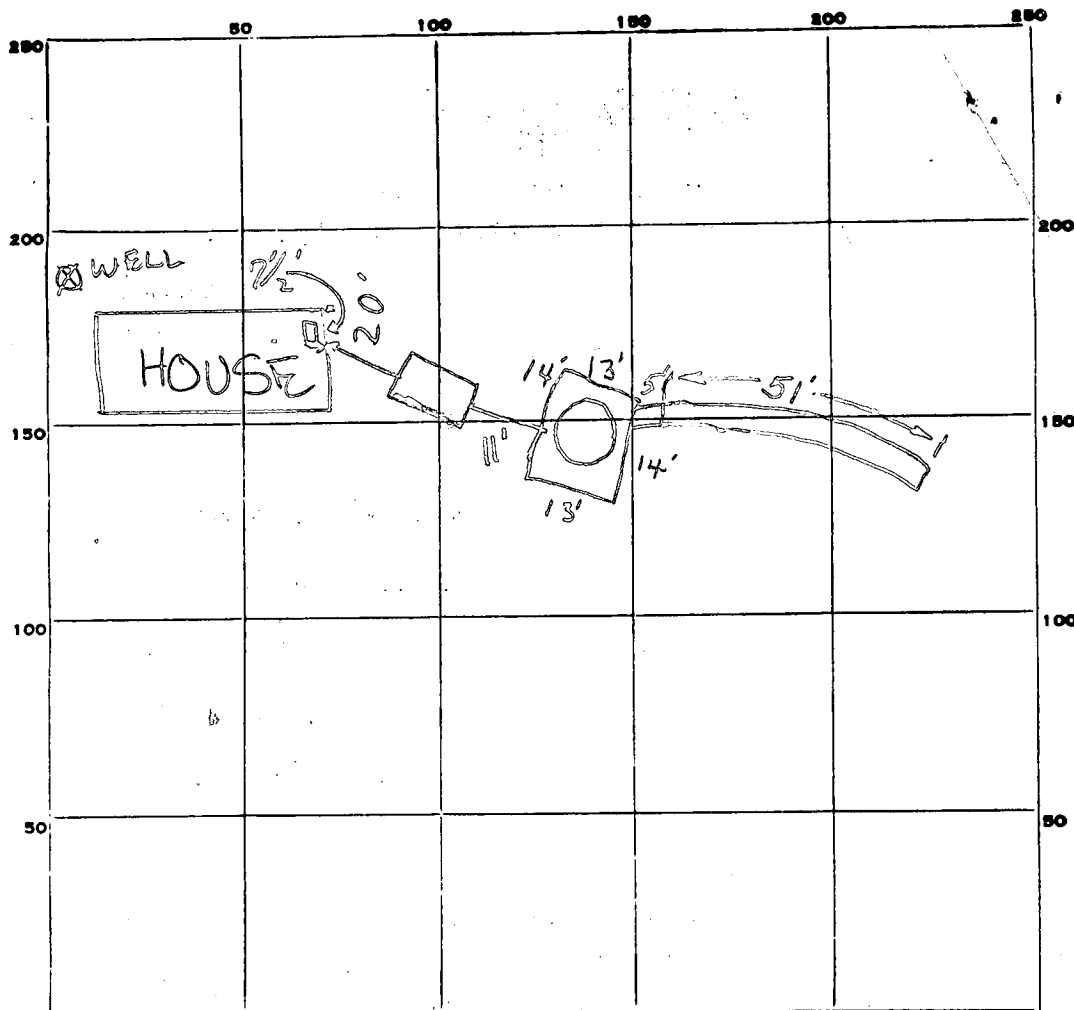

INDICATE NORTH. - NAME ADJOINING ROADWAY AS BASE LINE.

PERMIT CARD ☒

SEPTIC TANK, LEVEL ☒

CLEANOUTS ☒ S.T. ☒ D.W. ☒

DISTRIBUTION BOX, LEVEL N.A.

TILE FIELD, DEPTH 10" FT. TRENCH WIDTH 2' FT.

GRAVEL DEPTH 6 in. TOTAL LENGTH 51 FT.

306'

NUMBER OF TRENCHES 1 TOTAL BOTTOM AREA _____

SEEPAGE PITS, INSIDE DIAMETER 54 FT. DEPTH BELOW INLET 6 FT.

324'

ABSORBENT AREA 630 SQ. FT.

REMARKS 11/30/79 - OK TO ADD GRAVEL - DRYWELL NOT COMPLETE. R.D.
12/3/79 SYSTEM IN!

DATE SYSTEM APPROVED

12/3/79

INSPECTOR

C.B. Stucker

APPLICATION

A 27992

SEWAGE DISPOSAL TESTING

STATE OF MARYLAND - DEPARTMENT OF HEALTH AND MENTAL HYGIENE

HOWARD COUNTY HEALTH DEPARTMENT
ENVIRONMENTAL HEALTH SERVICESP. O. BOX 476, ELLICOTT CITY, MARYLAND 21043
TELEPHONE: 465-5000 EXT. 356

992-2330

1000 gallons

1-3 Bedroom

4th

DATE 5/4/78

1250

gallons

Septic Tank

4 Bedroom

* Dry well to have 200 sq. ft. effective
absorbent sidewall area per bedroom below
first 4' of original soil. Enlist to be 4' below
original grade and maximum depth 10'. Location
per drawing 45'± from house to right side of last per drawing
drawing when facing plot from Rt. 94. Per hole (H2) area
TO THE COUNTY HEALTH OFFICER
ELLICOTT CITY, MARYLAND

I, HEREBY, APPLY FOR THE NECESSARY TEST IN ORDER TO CONSTRUCT (OR RECONSTRUCT) A SEWAGE
DISPOSAL SYSTEM.

PROPERTY OWNER William B. Martin and Phyllis B. Martin B. 5' earthADDRESS 3268 Rt. 94 Woodbine, Md PHONE 21797 489-4983


PROPERTY LOCATION

SUBDIVISION 3248 Rt. 94 Woodbine LOT NO. 489-4983ROAD AND DESCRIPTION one mile south of Florence on Right - TimberleighFarmSIZE OF LOT Dairy Farm TYPE BLDG. TENANT HOUSEIF NOT SINGLE RESIDENCE DESCRIBE 3

THE SYSTEM INSTALLED UNDER THIS APPLICATION IS ACCEPTABLE ONLY UNTIL PUBLIC
FACILITIES BECOME AVAILABLE.

SIGNATURE OF APPLICANT William B. Martin BLDG. PERMIT SIGNED 4/25/79APPROVED BY C. B. Streaker for FOR "Dry Well & Trench" DATE 7/13/79REJECTED BY — FOR — DATE —HOLD PENDING FURTHER TESTS — DATE —REASONS FOR REJECTION OR HOLDING —

THIS IS NOT A PERMIT

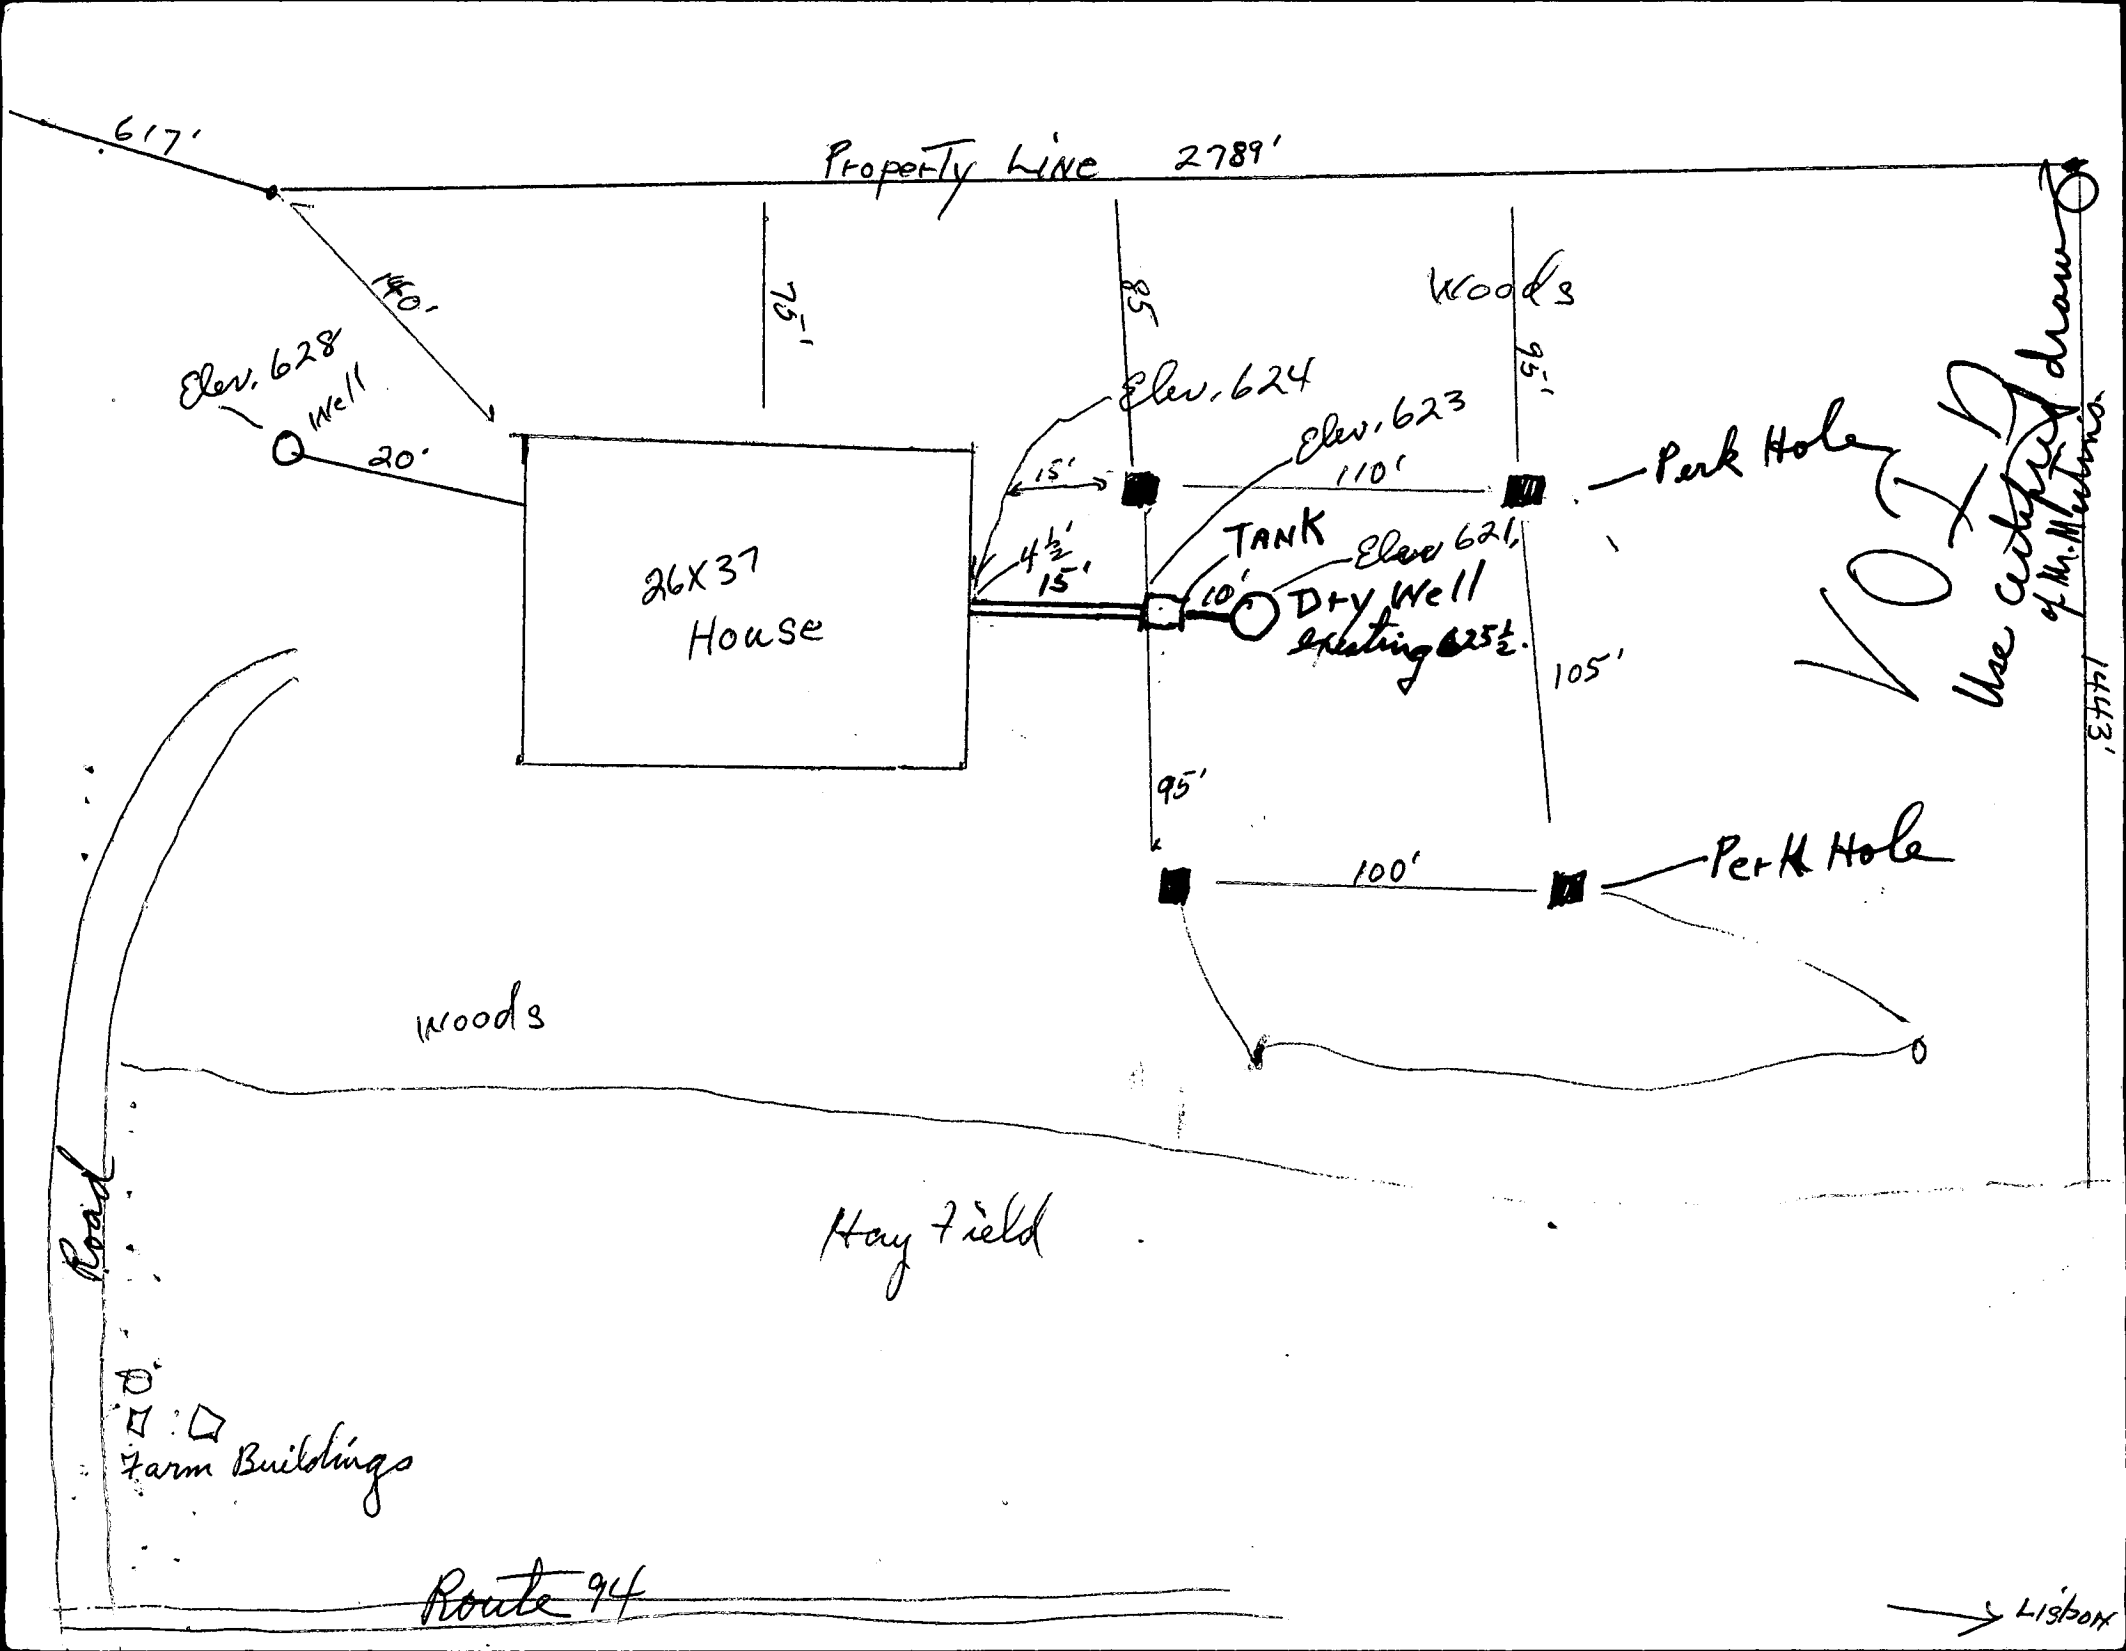

STATE OF MARYLAND WATER RESOURCES ADMINISTRATION		WRA PERMIT NUMBER 40-73-3215	
TAWES STATE OFFICE BLDG., ANNAPOLIS, MARYLAND 21401		APPLICATION FOR PERMIT TO DRILL WELL	
FILL IN THIS FORM COMPLETELY			

DATE RECEIVED (WRA USE ONLY) 4/26/79 10:00 A		OWNER COL 15 LAST NAME Martin FIRST NAME William	
STREET OR RFD COL 36 3968 Route 94		COL 58	
POST OFFICE COL 57 Woodhine Md 21797		COL 76	

B 1 CONTINUED 1 2 3 (SEQ. NO.) 6 DATE 3/27/79 LICENSE NUMBER 40 FIRST NAME George DRILLER LAST NAME Easterday SIGNATURE George Easterday		B 3 LOCATION OF WELL 1 2 3 (SEQ. NO.) 6 COUNTY Howard SUBDIVISION 23 SECTION 44 LOT 48 NEAREST TOWN Florence MILES FROM TOWN (ENTER 0 IF IN TOWN) 2	
--	--	--	--

B 2 WELL INFORMATION 1 2 3 (SEQ. NO.) 6 MAXIMUM PUMPING RATE (GALLONS PER MINUTE) 5 AVERAGE DAILY QUANTITY NEEDED (GALLONS PER DAY) 600 USE FOR WATER (CIRCLE APPROPRIATE BOX) ☒ HOME (SINGLE OR DOUBLE HOUSEHOLD UNIT ONLY) ☐ FARMING, AGRICULTURE, IRRIGATION ☐ INDUSTRIAL, COMMERCIAL, STATE AND FEDERAL GOVERNMENT. ☐ MUNICIPAL WATER SUPPLY ☐ PRIVATE WATER COMPANY ☐ TEST MUST HAVE STATE HEALTH DEPT. APPROVAL		B 4 DIRECTION FROM TOWN (CIRCLE APPROPRIATE BOX) N NORTH E EAST NE NORTHEAST SE SOUTHEAST S SOUTH W WEST NW NORTHWEST SW SOUTHWEST NEAR WHAT RT 94 ON WHICH SIDE OF ROAD (CIRCLE APPROPRIATE BOX) N 32 S 32 E 32 W 32 DISTANCE FROM ROAD (ENTER DISTANCE AND CIRCLE APPROPRIATE BOX) 200	
---	--	---	--

APPROXIMATE DEPTH OF WELL 120 FEET		N ↑ 21'-CASING 2'-ABOVE GR 17'-OPEN 5-BAGS CEMENT 4/26/79	
APPROXIMATE DIAMETER OF WELL 6" (NEAREST INCH)			
METHOD OF DRILLING USED (CIRCLE APPROPRIATE METHOD) BORED (OR AUGERED) JETTED DRIVEN 80-87 AIR-ROTARY AIR-PERCUSSION ROTARY (HYDRAULIC ROTARY) CABLE REVERSE-ROTARY DRIVE-POINT OTHER (DESCRIBE)			
REPLACEMENT OR DEEPEINED WELLS (CIRCLE APPROPRIATE BOX) ☒ THIS WELL WILL NOT REPLACE AN EXISTING WELL ☐ THIS WELL WILL REPLACE A WELL THAT WILL BE ABANDONED AND SEALED ☐ THIS WELL WILL REPLACE A WELL THAT WILL BE USED AS A STANDBY ☐ THIS WELL WILL DEEPEIN AN EXISTING WELL PERMIT NUMBER OF WELL TO BE REPLACED OR DEEPEINED (IF AVAILABLE)			

NOT TO BE FILLED IN BY DRILLER (WRA USE ONLY) APPROPRIATION PERMIT NUMBER 54 ENGINEER REVIEW DISTRICT NO. 63 FORCE 67 WRITE INITIALS IN BOX 68 CONDITIONS 70 71 72 73 74 75 76 77 78 79		BOX NUMBER E 760 N 530	
---	--	---	--

B 4 CONTINUED 1 2 3 (SEQ. NO.) 6 STATE HEALTH (CIRCLE BOX) S MO. DAY YR. 04 02 79 DATE 04 02 79 HEALTH DEPARTMENT APPROVAL Howard W29635 Donald W. Monaghan, Sanitaria		NORTH COORDINATE 57 58 59 60 61 62 63 EAST COORDINATE 65 66 67 68 ELEVATION AT WELL HEAD (FEET) 0/0	
---	--	--	--

B 5 SPECIAL CONDITIONS 8-63 (WRA USE ONLY) 1 2 3 (SEQ. NO.) 6			
---	--	--	--

A 2 7172

HEALTH

C 1	1243	SEQUENCE NO. (WRA USE ONLY)	STATE OF MARYLAND WATER RESOURCES ADMINISTRATION TAWES STATE OFFICE BLDG., ANNAPOLIS, MD. 21401 WELL COMPLETION REPORT	THIS REPORT MUST BE SUBMITTED WITHIN 30 DAYS AFTER WELL COMPLETION
1 2 3 (SEQ. NO.) 6		FILL IN THIS FORM COMPLETELY		
(THIS NUMBER IS TO BE PUNCHED IN COLS. 3-6 ON ALL CARDS)		COUNTY NUMBER		
DATE RECEIVED (WRA USE ONLY)		DEPTH OF WELL		PERMIT NO. FROM "PERMIT TO DRILL WELL"
4/26/79		100		11-32-15
DATE WELL COMPLETED		(TO NEAREST FOOT)		28 29 30 31 32 33 34 35 36 37
15 20		22 26		40
DRILLERS IDENTIFICATION NO.				

OWNER: MARTIN LAST NAME: 3268 R494 WOODBINE FIRST NAME: WILLIAM
 STREET OR RFD: 3268 R494 WOODBINE POST OFFICE: WOODBINE

WELL DESCRIPTION			GROUTING RECORD		PUMPING TEST																							
WELL LOG STATE THE KIND OF FORMATIONS PENETRATED, THEIR COLOR, DEPTH, THICKNESS AND IF WATER BEARING. <table border="1" style="width:100%; border-collapse: collapse;"> <thead> <tr> <th rowspan="2">DESCRIPTION (USE ADDITIONAL SHEETS IF NECESSARY)</th> <th colspan="2">FEET</th> <th rowspan="2">CHECK IF WATER BEARING</th> </tr> <tr> <th>FROM</th> <th>TO</th> </tr> </thead> <tbody> <tr> <td>TOP SOIL</td> <td>0</td> <td>3</td> <td></td> </tr> <tr> <td>SILT</td> <td>3</td> <td>10</td> <td></td> </tr> <tr> <td>BROWN SLATE</td> <td>10</td> <td>40</td> <td></td> </tr> <tr> <td>BLUE SLATE</td> <td>60</td> <td>100</td> <td></td> </tr> </tbody> </table>			DESCRIPTION (USE ADDITIONAL SHEETS IF NECESSARY)	FEET		CHECK IF WATER BEARING	FROM	TO	TOP SOIL	0	3		SILT	3	10		BROWN SLATE	10	40		BLUE SLATE	60	100		YES ☒ NO ☐ WELL HAS BEEN GROUTED (CIRCLE APPROPRIATE BOX) TYPE OF GROUTING MATERIAL (CIRCLE BOX) CEMENT ☒ BENTONITE CLAY ☐ NO. OF BAGS <u>5</u> NO. OF POUNDS <u>500</u> GALLONS OF WATER <u>25</u> DEPTH OF GROUT SEAL (TO NEAREST FOOT) FROM <u>0</u> FT. TO <u>19</u> FT. (ENTER 0 IF FROM SURFACE)		C 3 (SEQ. NO.) 6 HOURS PUMPED (TO NEAREST HOUR) <u>2</u> PUMPING RATE (GALLONS PER MINUTE TO NEAREST GALLON) <u>60</u> METHOD USED TO MEASURE PUMPING RATE <u>WICKET</u> WATER LEVEL: (DISTANCE FROM LAND SURFACE) BEFORE PUMPING <u>40</u> (NEAREST FOOT) WHEN PUMPING <u>100</u> (NEAREST FOOT) TYPE OF PUMP USED (CIRCLE APPROPRIATE BOX) (FOR PUMPING TEST) ☒ AIR ☐ PISTON ☐ TURBINE ☐ CENTRIFUGAL ☐ ROTARY ☐ OTHER (DESCRIBE BELOW) ☐ JET ☐ SUBMERSIBLE	
DESCRIPTION (USE ADDITIONAL SHEETS IF NECESSARY)	FEET			CHECK IF WATER BEARING																								
	FROM	TO																										
TOP SOIL	0	3																										
SILT	3	10																										
BROWN SLATE	10	40																										
BLUE SLATE	60	100																										
CASING TYPES INSERT APPROPRIATE CODE BELOW MAIN CASING TYPE: ☒ STEEL ☐ CONCRETE NOMINAL DIAMETER TOP (MAIN) CASING (NEAREST INCH) <u>6</u> TOTAL DEPTH OF MAIN CASING (NEAREST FOOT) <u>21</u>			OTHER CASING (IF USED) DIAMETER (INCH) <u> </u> DEPTH (FEET) FROM <u> </u> TO <u> </u>		PUMP INSTALLED TYPE OF PUMP (WRITE APPROPRIATE LETTER IN BOX - SEE ABOVE: A, C, J, P, R, S, T, O) DRILLER WILL INSTALL PUMP (CIRCLE APPROPRIATE BOX) YES ☐ NO ☐ CAPACITY: GALLONS PER MINUTE (TO NEAREST GALLON) <u> </u> PUMP HORSE POWER <u> </u> PUMP COLUMN LENGTH (NEAREST FOOT) <u> </u>																							
SCREEN TYPE OR OPEN HOLE INSERT APPROPRIATE CODE BELOW C 2 (SEQ. NO.) 6 DEPTH (NEAREST WHOLE FOOT) FROM <u> </u> TO <u> </u> 1 <u>11</u> 2 <u>100</u> 3 <u> </u> 4 <u> </u> 5 <u> </u> 100 <u> </u>			SCREEN RECORD INSERT APPROPRIATE CODE BELOW STEEL ☐ BRASS ☐ OPEN HOLE ☐ PLASTIC ☐ OTHER ☐ D 2 (SEQ. NO.) 6 DEPTH (NEAREST WHOLE FOOT) FROM <u> </u> TO <u> </u> 1 <u> </u> 2 <u> </u> 3 <u> </u> 100 <u> </u>		CASING HEIGHT (CIRCLE APPROPRIATE BOX AND ENTER CASING HEIGHT) ☒ ABOVE ☐ BELOW LAND SURFACE (NEAREST FOOT) <u> </u>																							

CIRCLE APPROPRIATE BOXES			LOCATION OF WELL ON LOT	
☐ A WELL WAS ABANDONED AND SEALED WHEN THIS WELL WAS COMPLETED ☐ E ELECTRIC LOG OBTAINED ☐ P TEST WELL CONVERTED TO PRODUCTION WELL			SHOW PERMANENT STRUCTURE SUCH AS BUILDINGS, SEPTIC TANKS, AND/OR OTHER LAND MARKS AND INDICATE NOT LESS THAN TWO DISTANCES (MEASUREMENTS TO WELL). 	
I HEREBY CERTIFY, THAT I HAVE COMPLIED WITH ALL CONDITIONS STATED ON THE ABOVE-CAPTIONED "PERMIT TO DRILL WELL", AND THAT INFORMATION CONTAINED IN THIS REPORT IS TRUE, ACCURATE, AND COMPLETE TO THE BEST OF MY KNOWLEDGE, INFORMATION AND BELIEF.			DRILLERS NAME (PLEASE PRINT) <u>George F. Fester</u> SIGNATURE <u>George F. Fester</u>	
WRA USE ONLY (NOT TO BE FILLED IN BY DRILLER) T ☐ (E.R.O.S.) ☐ W ☐ 70 ☐ 72 ☐ 74 ☐ 75 ☐ 76 ☐ TELESCOPE CASING LOG INDICATOR OTHER DATA AVAILABLE			HEALTH	

B 1 3755 1 2 3 (SEQ. NO.) 6 (THIS NUMBER IS TO BE PUNCHED IN COLS. 3-6 ON ALL CARDS)		SEQUENCE NO. (WRA USE ONLY)		STATE OF MARYLAND WATER RESOURCES ADMINISTRATION TAWES STATE OFFICE BLDG., ANNAPOLIS, MARYLAND 21401 APPLICATION FOR PERMIT TO DRILL WELL		WRA PERMIT NUMBER HO-73-3752 FILL IN THIS FORM COMPLETELY	
--	--	--------------------------------	--	--	--	---	--

DATE RECEIVED (WRA USE ONLY) Jan 4-80		OWNER COL. 15 LAST NAME Martin FIRST NAME William COL. 34	
STREET OR RFD COL. 38 3208 Rt 94 COL. 55		POST OFFICE COL. 57 Woodlawn, Md. 21797 COL. 76	

B 1 CONTINUED 1 2 3 (SEQ. NO.) 6		DRILLER INFORMATION		B 3 LOCATION OF WELL 1 2 3 (SEQ. NO.) 6	
DATE 12-1-80		LICENSE NUMBER 40 77 80		COUNTY Howard (DO NOT ABBREVIATE COUNTY NAME) 21	
FIRST NAME George		DRILLER Easterday LAST NAME		SUBDIVISION 23 42	
SIGNATURE George Easterday				SECTION 44 46 48 50	
				NEAREST TOWN 52 Florence 71	
				MILES FROM TOWN (ENTER 0 IF IN TOWN) 2 79 76 77 78	

B 2 WELL INFORMATION 1 2 3 (SEQ. NO.) 6		B 4 DIRECTION FROM TOWN (CIRCLE APPROPRIATE BOX)	
MAXIMUM PUMPING RATE (GALLONS PER MINUTE) 5 8 12		N NORTH E EAST NE NORTHEAST SE SOUTHEAST	
AVERAGE DAILY QUANTITY NEEDED (GALLONS PER DAY) 14 600 20		S SOUTH W WEST NW NORTHWEST SW SOUTHWEST	
USE FOR WATER (CIRCLE APPROPRIATE BOX)		NEAR WHAT ROAD RT 94	
☒ HOME (SINGLE OR DOUBLE HOUSEHOLD UNIT ONLY)		ON WHICH SIDE OF ROAD (CIRCLE APPROPRIATE BOX) N 32 S 32 E 32 W 32	
☐ FARMING, AGRICULTURE, IRRIGATION		DISTANCE FROM ROAD (ENTER DISTANCE AND CIRCLE APPROPRIATE BOX) 200 34 37 38 39	
☐ INDUSTRIAL, COMMERCIAL, STATE AND FEDERAL GOVERNMENT		DRAW A SKETCH BELOW SHOWING LOCATION OF WELL IN RELATION TO NEARBY TOWNS, ROADS AND STREAMS WITH NORTH IN THE DIRECTION OF THE ARROW, AND GIVE DIS- TANCE FROM WELL TO NEAREST ROAD JUNCTION OR STREAM CROSSING SHOWN ON THE SKETCH. ALSO SHOW, BY MEANS OF AN "X", THE WELL LOCATION IN THE BOX BELOW AND THE BOX NUMBER FROM THE WELL LOCATION MAP.	
☐ MUNICIPAL WATER SUPPLY } MUST HAVE STATE HEALTH DEPT. APPROVAL			
☐ PRIVATE WATER COMPANY			
☐ TEST			

APPROXIMATE DEPTH OF WELL 150 24 28 FEET	
APPROXIMATE DIAMETER OF WELL 6 (NEAREST INCH)	
METHOD OF DRILLING USED (CIRCLE APPROPRIATE METHOD)	
BORED (OR AUGURED) JETTED DRIVEN	
30-37 AIR-ROTARY AIR-PERCUSSION ROTARY (HYDRAULIC ROTARY)	
CABLE REVERSE-ROTARY DRIVE-POINT	
OTHER (DESCRIBE)	
REPLACEMENT OR DEEPEINED WELLS (CIRCLE APPROPRIATE BOX)	
☐ THIS WELL WILL NOT REPLACE AN EXISTING WELL	
☐ THIS WELL WILL REPLACE A WELL THAT WILL BE ABANDONED AND SEALED	
☒ THIS WELL WILL REPLACE A WELL THAT WILL BE USED AS A STANDBY	
☐ THIS WELL WILL DEEPEIN AN EXISTING WELL PERMIT NUMBER OF WELL TO BE REPLACED OR DEEPEINED (IF AVAILABLE)	

NOT TO BE FILLED IN BY DRILLER (WRA USE ONLY)		BOX NUMBER E 260 2 N 520 8	
APPROPRIATION PERMIT NUMBER 84 69 65		NORTH COORDINATE 525000 50 51 52 53 54 55	
FORCE 67 68		EAST COORDINATE 0760000 57 58 59 60 61 62 63	
WRITE INITIALS IN BOX		ELEVATION AT WELL HEAD (FEET) 65 66 67 68 0/0 5/0	
CONDITIONS 70 71 72 73 74 75 76 77 78 79			
B 4 CONTINUED 1 2 3 (SEQ. NO.) 6			
HEALTH DEPARTMENT APPROVAL HOWARD A27792 STATE HEALTH (CIRCLE BOX) MO. DAY YR. 12 01 80 DATE 43 APPROVED BY Frank Skinner, Sanitarian			
B 5 SPECIAL CONDITIONS 8-63 (WRA USE ONLY)			

C1	4819	SEQUENCE NO. (WRA USE ONLY)	STATE OF MARYLAND WELL COMPLETION REPORT FILL IN THIS FORM COMPLETELY PLEASE PRINT OR TYPE	THIS REPORT MUST BE SUBMITTED WITHIN 30 DAYS AFTER WELL IS COMPLETED
(THIS NUMBER IS TO BE PUNCHED IN COLS. 3-6 ON ALL CARDS)				COUNTY NUMBER A-27792

Date Received (WRA use only)	12-4-80 DATE WELL COMPLETED	Depth of Well 320	PERMIT NO. FROM "PERMIT TO DRILL WELL" 140-73-3752
		TO NEAREST FOOT	

OWNER	Martin last name	William first name
STREET OR RFD	3248	TOWN Woodbine
SUBDIVISION		LOT

WELL LOG Not required for driven wells		
STATE THE KIND OF FORMATIONS PENETRATED, THEIR COLOR, DEPTH, THICKNESS AND IF WATER BEARING		
DESCRIPTION (Use additional sheets if needed)	FEET FROM TO	Check if water bearing
Top Soil	0 3	
Brown Shale	3 50	
Brown shale	50 60	
mica	50 70	
Brown shale	70 72	
MICA	72 85	
Brown shale	85 88	
mica	88 265	
Blue shale	265 304	
Flint	304 306	
Blue shale	306 320	

GROUTING RECORD	
WELL HAS BEEN GROUTED (Circle Appropriate Box)	
YES ☒ Y	NO ☐ N
TYPE OF GROUTING MATERIAL	
CEMENT ☒ CM	BENTONITE CLAY ☐ BC
NO. OF BAGS 9	NO. OF POUNDS 900
GALLONS OF WATER 50	
DEPTH OF GROUT SEAL (to nearest foot)	
from 0 ft. to 40 ft.	
(enter 0 if from surface)	

CASING RECORD		
casing types insert appropriate code below	☒ ST	☐ CO
	STEEL	CONCRETE
	☒ PL	☐ OT
	PLASTIC	OTHER
MAIN CASING TYPE	Nominal diameter top(main)casing (nearest inch)	Total depth of main casing (nearest foot)
☒ ST	6	56

EACH CASING	OTHER CASING (if used)	
	diameter inch	depth (feet) from to
	☐	☐
	☐	☐

SCREEN RECORD			
screen type or openhole			
insert appropriate code below	☒ ST	☐ BR	☐ HO
	STEEL	BRASS	OPEN HOLE
	☐ PL	BRONZE	☐ OT
	PLASTIC	OTHER	

C2		
(Seq. no.)		
EACH SCREEN	DEPTH (nearest ft.)	
	HO 54 320	
	☐	☐
	☐	☐

CIRCLE APPROPRIATE BOX	
☒ A	A WELL WAS ABANDONED AND SEALED WHEN THIS WELL WAS COMPLETED
☐ E	ELECTRIC LOG OBTAINED
☐ P	TEST WELL CONVERTED TO PRODUCTION WELL

I HEREBY CERTIFY THAT I HAVE COMPLIED WITH ALL CONDITIONS STATED ON THE ABOVE-CAPTIONED "PERMIT TO DRILL WELL", AND THAT INFORMATION CONTAINED IN THIS REPORT IS TRUE, ACCURATE, AND COMPLETE TO THE BEST OF MY KNOWLEDGE, INFORMATION AND BELIEF.	
DRILLERS IDENT. NO.	40

DRILLERS SIGNATURE (MUST MATCH SIGNATURE ON APPLICATION)	
George N. Carter	
SITE SUPERVISOR (sign of driller or journeyman responsible for sitework if different from permittee)	
The Miller	
GRAVEL PACK	
IF WELL DRILLED WAS FLOWING WELL CIRCLE BOX ☐ F	
WRA USE ONLY (NOT TO BE FILLED IN BY DRILLER)	
(E.R.O.S.)	
70 ☐	72 ☐
TELESCOPE CASING	LOG INDICATOR
OTHER DATA	

C3		
(seq. no.)		
PUMPING TEST		
HOURS PUMPED (nearest hour)	5	
PUMPING RATE (gal. per min. to nearest gal.) 10		
METHOD USED TO MEASURE PUMPING RATE Bucket		
WATER LEVEL (distance from land surface)		
BEFORE PUMPING	60	
WHEN PUMPING	320	
TYPE OF PUMP USED (for test)		
☒ A	☐ P	☐ T
air	piston	turbine
☐ C	☐ R	☐ O
centrifugal	rotary	other (describe below)
☐ J	☐ S	
jet	submersible	

PUMP INSTALLED	
DRILLER WILL INSTALL PUMP (CIRCLE APPROPRIATE BOX)	YES ☒ Y NO ☐ N
IF DRILLER INSTALLS PUMP, THIS SECTION MUST BE COMPLETED FOR ALL WELLS EXCEPT HOME USE	
TYPE OF PUMP (WRITE APPROPRIATE LETTER IN BOX - SEE ABOVE: (A, C, J, P, R, S, T, O))	
CAPACITY: GALLONS PER MINUTE (to nearest gallon)	
PUMP HORSE POWER	
PUMP COLUMN LENGTH (nearest ft.)	
CASING HEIGHT (circle appropriate box and enter casing height)	
☒ +	above
☐ -	below
LAND SURFACE	
2 (nearest foot)	

LOCATION OF WELL ON LOT	
SHOW PERMANENT STRUCTURE SUCH AS BUILDING, SEPTIC TANKS, AND/OR LANDMARKS AND INDICATE NOT LESS THAN TWO DISTANCES (MEASUREMENTS TO WELL)	
House 60'	
Well 80'	
Pool	