

PERMIT

SEWAGE DISPOSAL SYSTEM

MARYLAND STATE DEPARTMENT OF HEALTH

HOWARD COUNTY

ELLICOTT CITY

DISTRICT 3rd

DATE 5/10/82

INDEX

Mr. Richard Wiker/ Mr. Charles E. Green, Jr. IS PERMITTED TO INSTALL X ALTER

1332 Highridge Dr., West Minister, Md.

ADDRESS 7200 Kennebunks Road, Baltimore, Md PHONE 795-6099

SUBDIVISION Salopha ROAD 705 River Road LOT 4

PROPERTY OWNER Mr. Richard Wiker

ADDRESS 7200 Kennebunks Road, Baltimore, Md.

SPECIFICATIONS 3 Bedrooms

SEPTIC TANK CAPACITY 1000 GALLONS

DRAIN FIELD _____ DEPTH _____ FEET, BOTTOM AREA _____ SQ. FT.

DEEP TRENCH _____ DEPTH _____ FEET, BOTTOM AREA _____ SQ. FT.

SEEPAGE PITS _____ ABSORBENT SIDE-WALL AREA 360 SQ. FT. per backflow

INLET PIPE 3 FT. BELOW ORIGINAL GRADE. MAXIMUM DEPTH 10 FT. BELOW ORIGINAL GRADE

EFFECTIVE DEPTH AT _____ FT. BELOW ORIGINAL GRADE

LOCATE DISPOSAL AREA 50 FT. FROM left side (228.06' long) (842.99')

FACING LOT FROM River Road

DRY WELL X
TRENCH

PLANS APPROVED BY Tom S. Ogle DATE June 16, 1978

COVER NO WORK UNTIL INSPECTED AND APPROVED.

NEITHER THE HOWARD COUNTY COUNCIL NOR THE HEALTH DEPARTMENT IS RESPONSIBLE FOR THE SUCCESSFUL OPERATION OF ANY SYSTEM.

NOTE: IF TRENCH IS USED CALL FOR INSPECTION BEFORE PLACING GRAVEL IN TRENCH.

NOTE: NO DRY WELL SHALL EXCEED 15 FOOT IN DIAMETER.

NOTE: ALL PIPE FROM HOUSE TO DISPOSAL AREA MUST BE CAST IRON.

PERMIT VOID AFTER THREE YEARS.


NOTE: INSTALL STAND PIPE ON SEPTIC TANK AND DRY WELL. STAND PIPES MUST BE 6 INCHES IN DIAMETER. CAST IRON, CONCRETE OR TERRA COTTA ACCEPTED.

*INSTALLER IS RESPONSIBLE FOR OBTAINING FINAL APPROVAL ON THIS PERMIT.

BOG: PERMIT SIGNED

AND RETURNED 7/13/90

Serial # 33853
2 car garage

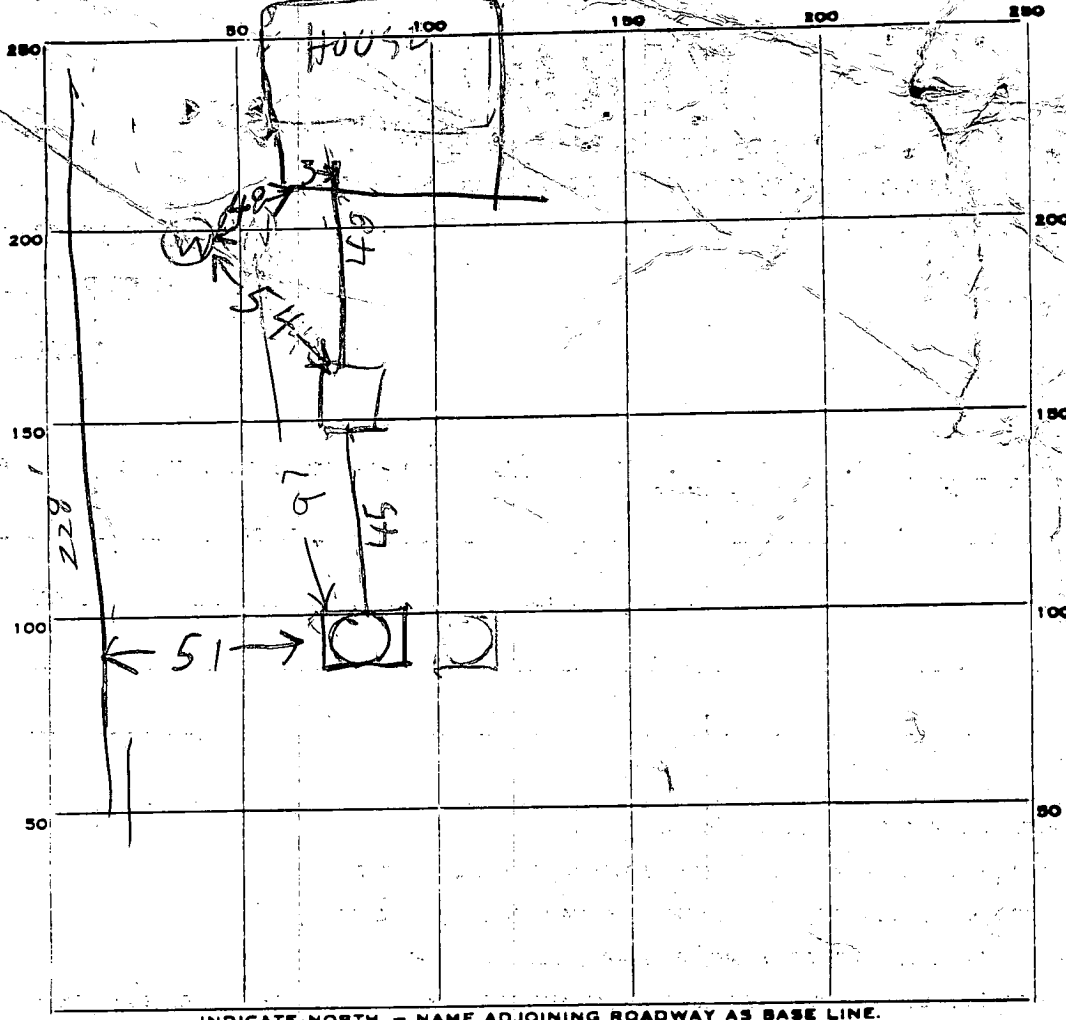

13

PERMIT CARD _____

SEPTIC TANK, LEVEL 1000 TOP 3-3 1/2 FT CLEANOUTS ST DW
BELOW GRADE BUT GRADE TO BE CUT NEAR TANK
OK OK

DISTRIBUTION BOX, LEVEL _____

TILE FIELD, DEPTH _____ FT. TRENCH WIDTH _____ FT.

GRAVEL DEPTH _____ IN. TOTAL LENGTH _____ FT.

NUMBER OF TRENCHES _____ TOTAL BOTTOM AREA _____

SEEPAGE PITS, INSIDE DIAMETER DERIMETER 56 FT. DEPTH BELOW INLET 7.5 FT.

ABSORBENT AREA 420 SQ. FT.

REMARKS 5/18/92 - LOCATION OK PER PLANS
DW INLET 3 FT B.O.G.

DATE SYSTEM APPROVED 5/18/82 INSPECTOR Raymond Dodge

75
36
45-0
375-0
2200

APPLICATION

A 27994

P

SEWAGE DISPOSAL TESTING

STATE OF MARYLAND - DEPARTMENT OF HEALTH AND MENTAL HYGIENE

HOWARD COUNTY HEALTH DEPARTMENT
ENVIRONMENTAL HEALTH SERVICESP. O. BOX 476, ELLICOTT CITY, MARYLAND 21043
TELEPHONE: 465-5000, EXT. 356

DISTRICT 3rd

DATE 5/4/78

TO: THE COUNTY HEALTH OFFICER
ELLICOTT CITY, MARYLAND

I, HEREBY, APPLY FOR THE NECESSARY TEST IN ORDER TO CONSTRUCT (OR RECONSTRUCT) A SEWAGE DISPOSAL SYSTEM.

PROPERTY OWNER ~~James W. Dickey~~ Richard Wiker
ADDRESS Forsythe Road, Sykesville, Md. Baltimore, Md. PHONE 594-3445-Work

PROPERTY LOCATION

SUBDIVISION Now SALOPHA SUB LOT NO. 2 4
ROAD AND DESCRIPTION 705 River Road 10/4/78 now lot 4 per plat of
6 acres Hold for certified holes 2/16/78SIZE OF LOT 18.588 acres TYPE BLDG 3 or 4 bedrooms
NUMBER OF BEDROOMS

IF NOT SINGLE RESIDENCE DESCRIBE


THE SYSTEM INSTALLED UNDER THIS APPLICATION IS ACCEPTABLE ONLY UNTIL PUBLIC FACILITIES BECOME AVAILABLE.

SIGNATURE OF APPLICANT /s/ Carol Clark, Caton RealtyAPPROVED BY T.S. Oyle FOR Drywell and trench DATE 6/16/78
(KIND OF SYSTEM)REJECTED BY _____ FOR _____ DATE _____
(KIND OF SYSTEM)

HOLD PENDING FURTHER TESTS _____ BLDG. PERMIT SIGNED _____ DATE _____

REASONS FOR REJECTION OR HOLDING _____ AND RETURNED 1/19/82
#48635 for S.F.D.

THIS IS NOT A PERMIT

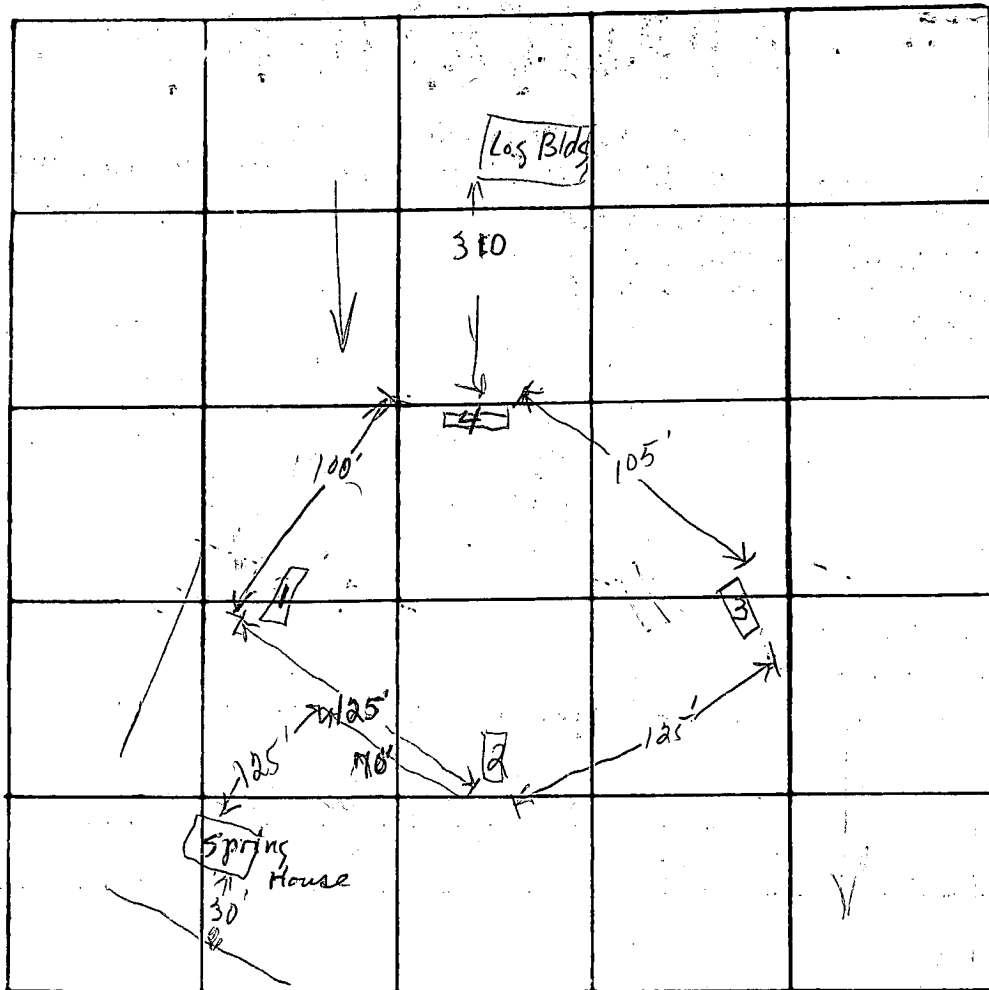

INDICATE NORTH - NAME ADJOINING ROADWAY AS BASE LINE

	DATE	TEST NO.	DEPTH	PRE-WET		TEST - 1" DROP		TIME
				START	STOP	START	STOP	
shaly sand	6/1/78	1s	3	0955	0956	0956	0959	3
		1d	11	0954	0956	0956	0958	2
Low Hole		2s	3	1003	1004	1004	1006	2
fast, shaly sand		2d	12	1002	1004	1004	1008	4
fast, shaly sand		3s	3	1010	1012	1012	1015	3
		3d	11	1011	1015	1015	1024	9
more shaly sand		4s	3	1024	1029	1029	1033	4
High Hole		4d	11	1024	1029	1029	1034	5
sandy clay to 8' - sand to 11'								


32 min. avg.

REMARKS _____

TYPE OF SOIL _____

TESTED BY Tom Ogile

ALSO PRESENT: Carol Clark, Cator Realty

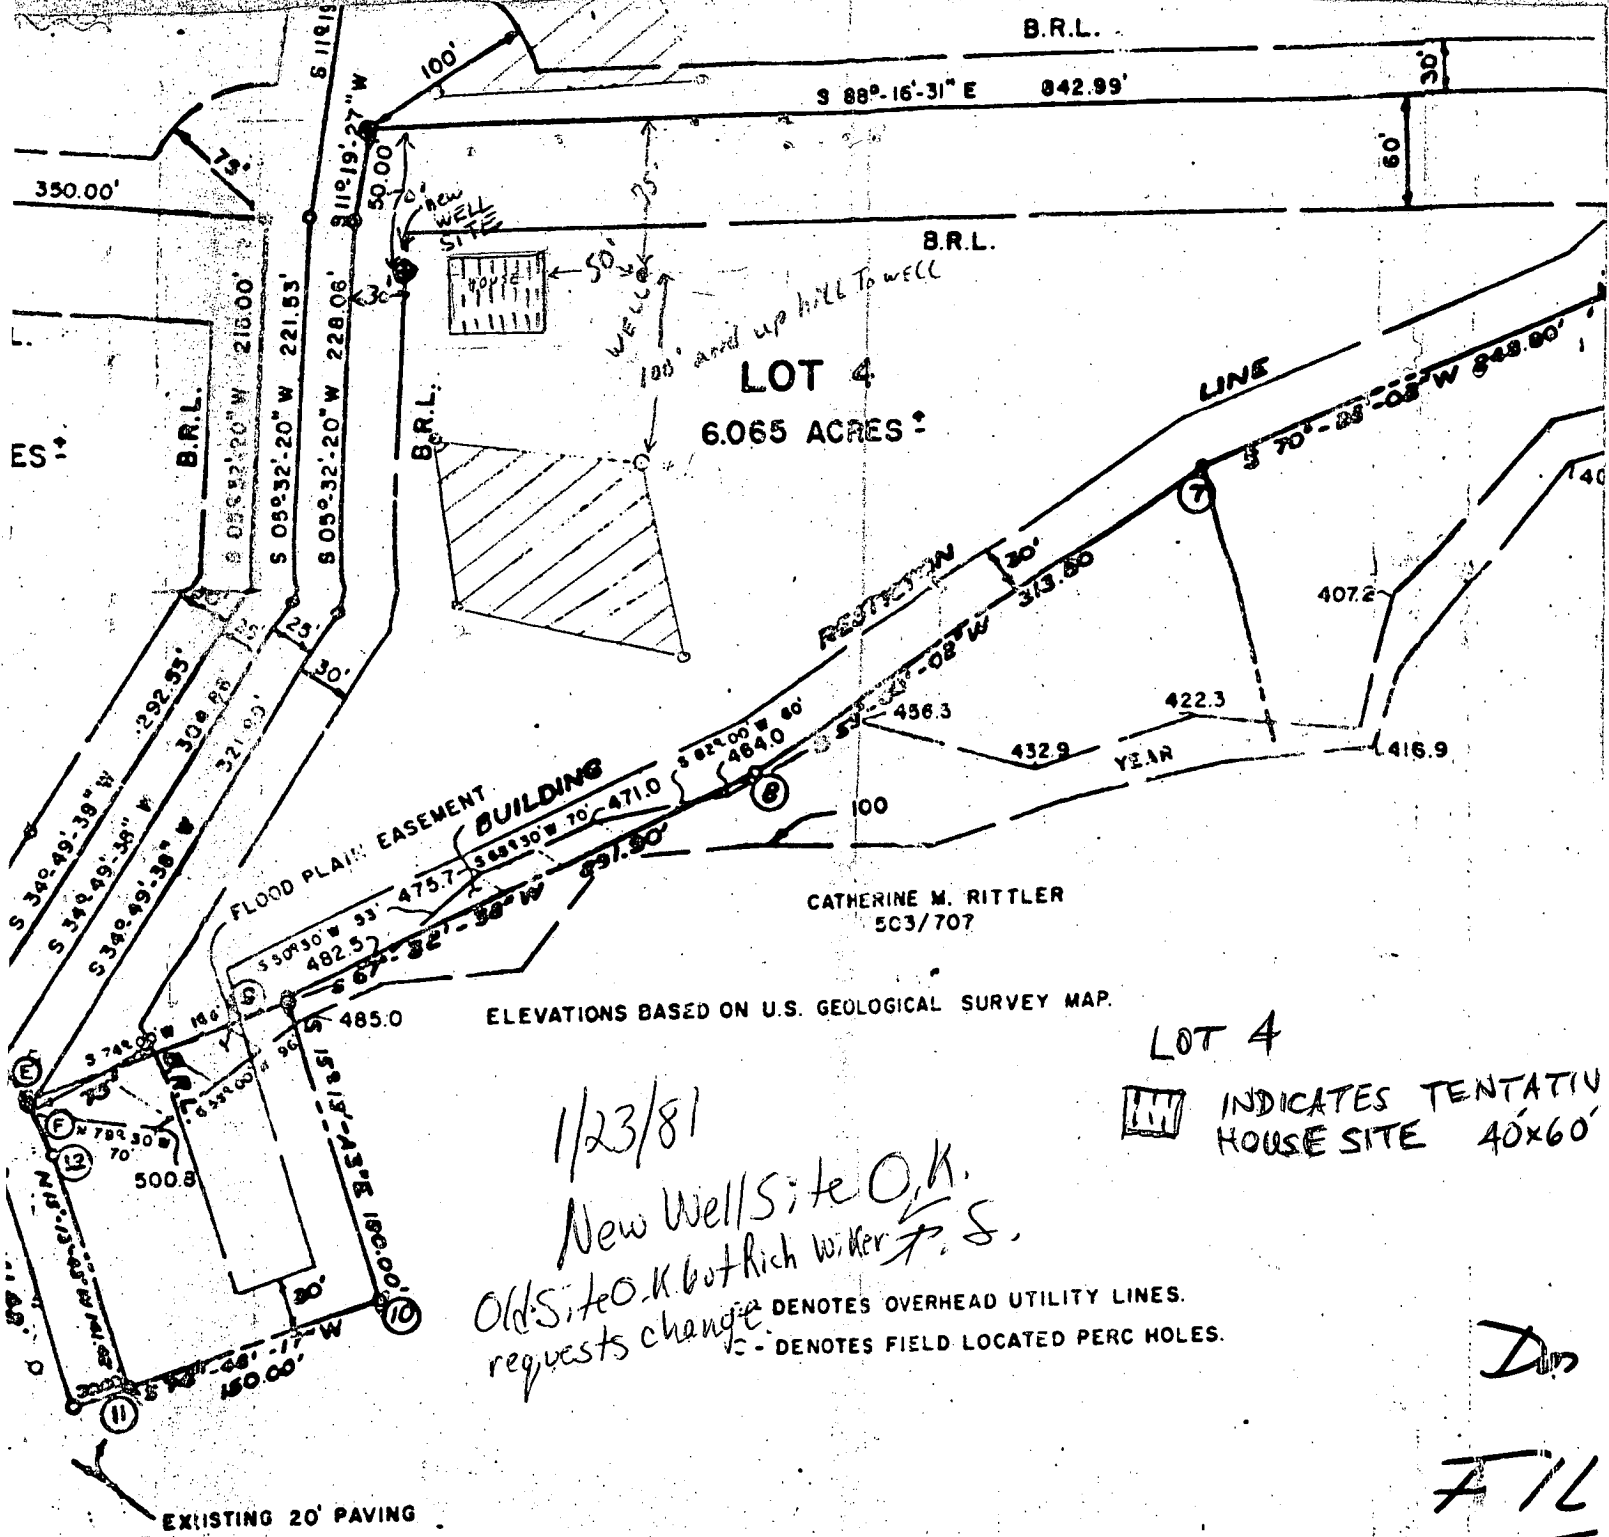

1/23/81
 New Well Site O.K.
 Old Site O.K. but Rich W. Ker requests change.

LOT 4
 [Symbol] INDICATES TENTATIVE HOUSE SITE 40'x60'

--- DENOTES OVERHEAD UTILITY LINES.
 - - - DENOTES FIELD LOCATED PERC HOLES.

Don
FILE

SURVEYOR'S CERTIFICATE


I HEREBY CERTIFY THAT THE FINAL PLAT SHOWN HEREON IS CORRECT. THAT IT IS A SUBDIVISION OF ALL THE LANDS CONVEYED BY GRACE I. CHRISTOPHER JAMES W. DICKEY BY DEED DATED JANUARY 28, 1978 & RECORDED AMONG THE LAND RECORDS OF HOWARD COUNTY IN LIBER 759 FOLIO 600, AND THAT ALL MONUMENTS IN PLACE ARE SHOWN IN ACCORDANCE WITH THE ANNOTATED CODE OF MARYLAND AS AMENDED.

OWNERS DEDICATION

I JAMES W. DICKEY, OWNER OF THE PROPERTY HEREON, HEREBY ADOPT THIS PLAN OF SUBDIVISION OF THE APPROVAL OF THIS PLAT BY THE OFFICIALS OF THE STATE OF MARYLAND TO ESTABLISH THE MINIMUM BUILDING RESTRICTIONS FOR THE PROPERTY HEREON. I, MY SUCCESSORS AND ASSIGNS, WILL MAINTAIN, SEWERS, DRAINS, WATER LINES, UTILITIES & SERVICES IN AND UNDER ALL ROAD AND THE SPECIFIC EASEMENT AREAS SHOWN HEREON. I AGREE TO PAY FOR THE COST OF ANY PUBLIC USE OF THE BEDS OF THE STREETS AND/ OR DRAINAGE AREAS APPLICABLE FOR ONE DOLLAR.

SALOPHA LOT 4 Well + SEPTIC PLAN

(4)

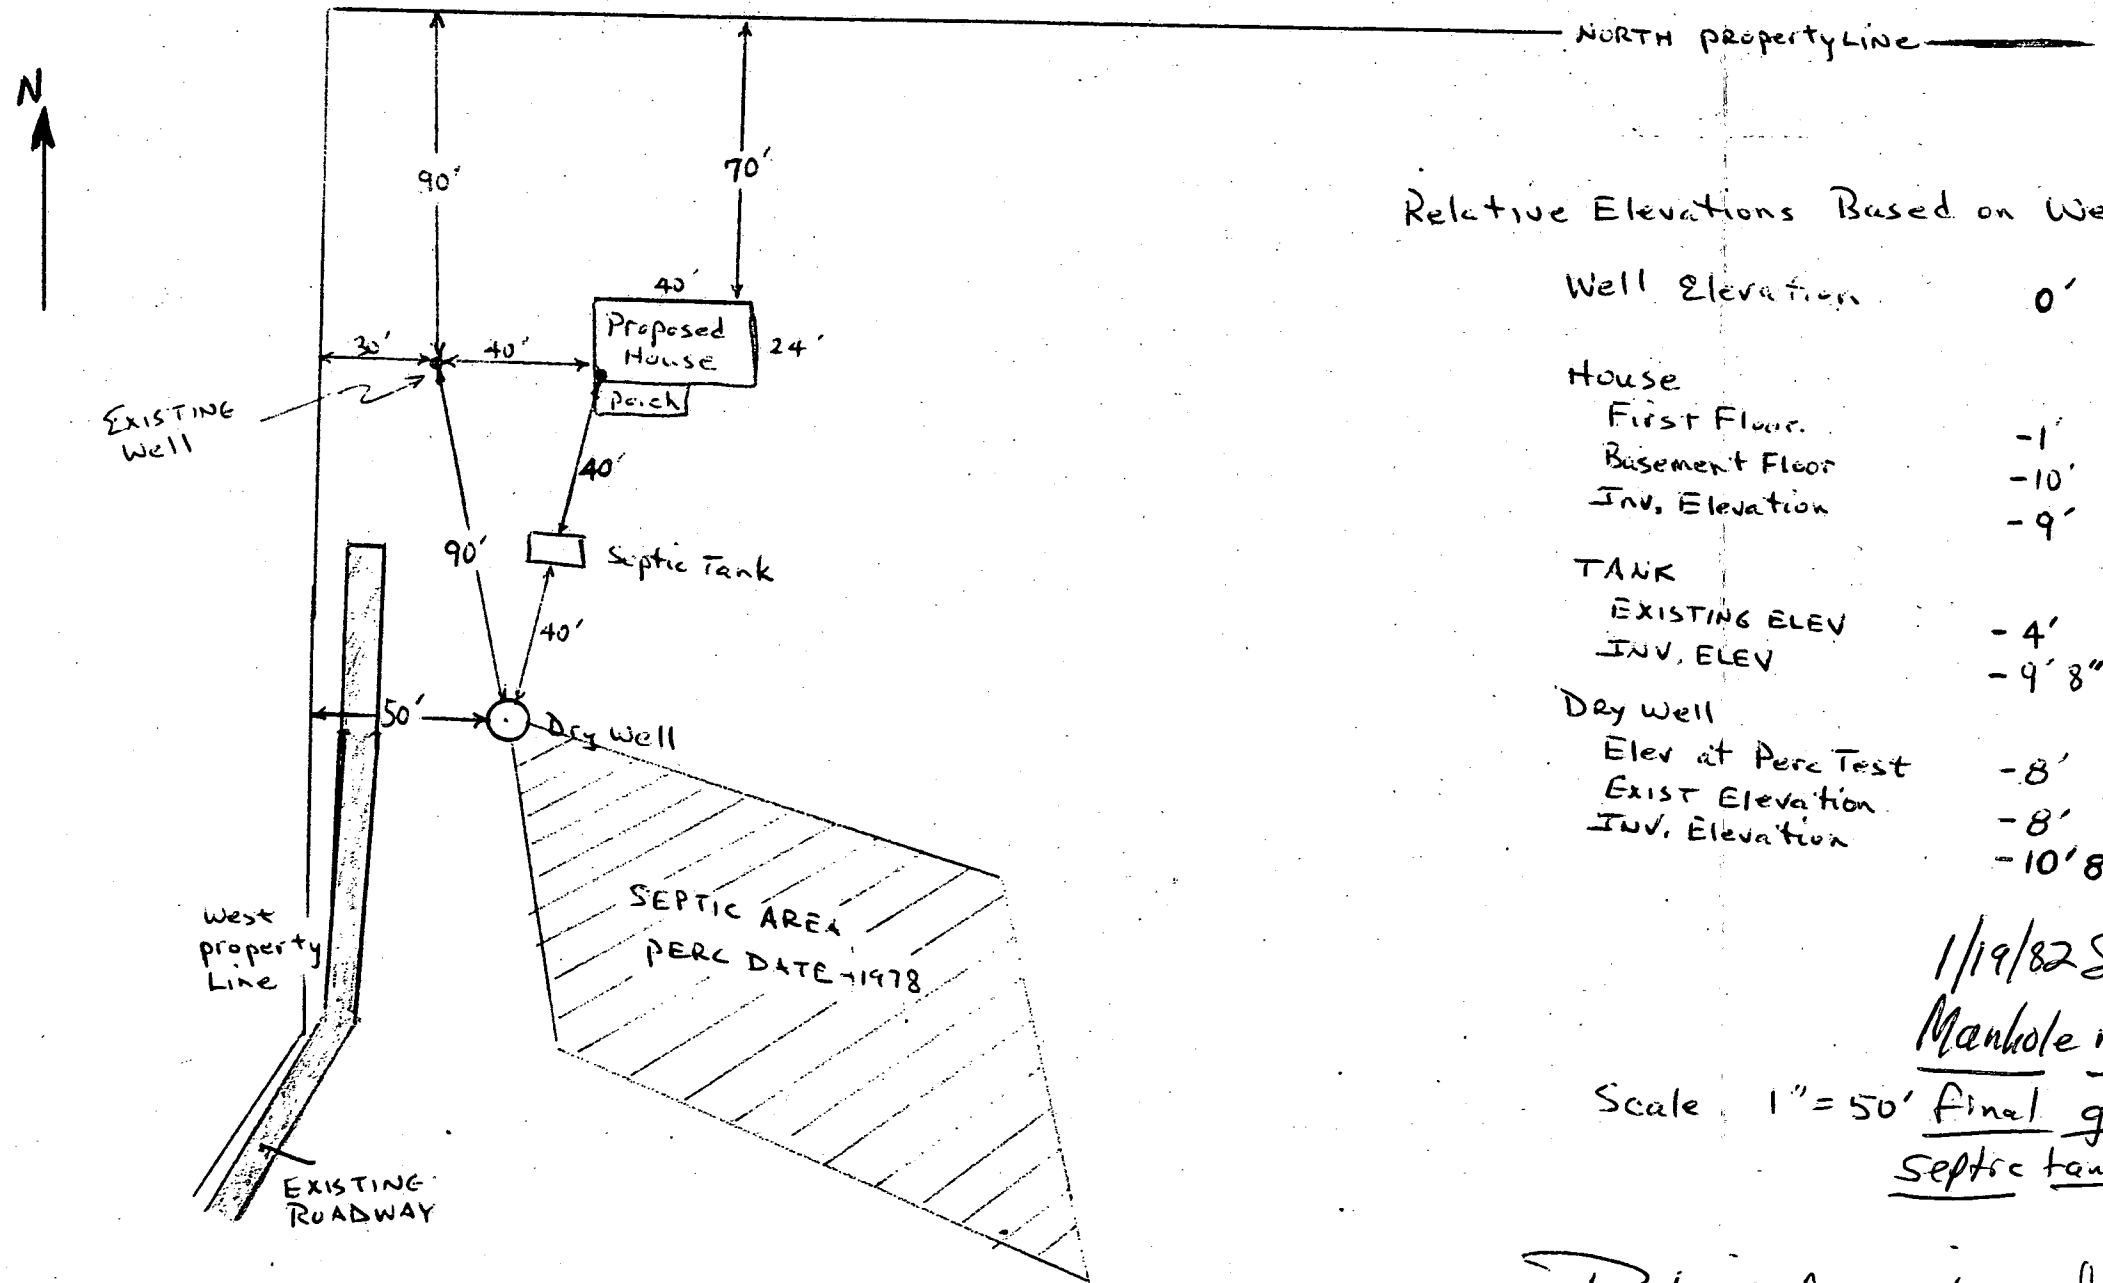

Relative Elevations Based on Well Height

Well Elevation	0'
House	
First Floor	-1'
Basement Floor	-10'
Inv. Elevation	-9'
TANK	
EXISTING ELEV	-4'
INV. ELEV	-9' 8"
Dry Well	
Elev at Perc Test	-8'
Exist Elevation	-8'
Inv. Elevation	-10' 8"

1/19/82 Sketch O.K.

Manhole required to

Scale 1" = 50' Final grade at
septic tank fr. S.

Richard A. Wiker Jan 15, 1982

1

2

437</

HEALTH

C 1	4855	SEQUENCE NO. (WRA USE ONLY)	STATE OF MARYLAND WELL COMPLETION REPORT FILL IN THIS FORM COMPLETELY PLEASE PRINT OR TYPE		THIS REPORT MUST BE SUBMITTED WITHIN 30 DAYS AFTER WELL IS COMPLETED	
					COUNTY NUMBER	A27994
Date Received (WRA use only)	2/26/81		DATE WELL COMPLETED		Depth of Well 125 (TO NEAREST FOOT)	
OWNER <u>Wiker</u> last name			Richard first name			
STREET OR RFD <u>River Rd.</u>			TOWN <u>Sykesville</u>			
SUBDIVISION <u>Solo ph</u>			SECTION <u>4</u>			

WELL LOG Not required for driven wells		GROUTING RECORD WELL HAS BEEN GROUTED (Circle Appropriate Box)		PERMIT NO. FROM "PERMIT TO DRILL WELL" #0-73-3786	
STATE THE KIND OF FORMATIONS PENETRATED, THEIR COLOR, DEPTH, THICKNESS AND IF WATER BEARING		TYPE OF GROUTING MATERIAL CEMENT (CM) BENTONITE CLAY (BC)		PUMPING TEST HOURS PUMPED (nearest hour) 3	
DESCRIPTION (Use additional sheets if needed)		NO. OF BAGS 8 NO. OF POUNDS 752		PUMPING RATE (gal. per min. to nearest gal.) 20	
FEET FROM TO		GALLONS OF WATER 48		METHOD USED TO MEASURE PUMPING RATE Bucket	
Check if water bearing		DEPTH OF GROUT SEAL (to nearest foot) from 48 TOP ft. to 33 BOTTOM 58 ft. (enter 0 if from surface)		WATER LEVEL (distance from land surface) BEFORE PUMPING 35 WHEN PUMPING 125	

DESCRIPTION (Use additional sheets if needed)	FEET FROM	TO	Check if water bearing
Top Soil	0	2	
Brown Shale	2	6	
Brown Sandstone	6	28	
Hard Brown Sandstone	28	40	
Hard Brown Sandstone	40	43	12
Granite	43	60	
Hard Brown Sandstone	60	65	118
Granite	65	125	

C 3		(seq. no.)	
PUMPING TEST		HOURS PUMPED (nearest hour) 3	
PUMPING RATE (gal. per min. to nearest gal.) 20		METHOD USED TO MEASURE PUMPING RATE Bucket	
WATER LEVEL (distance from land surface)		BEFORE PUMPING 35	
WHEN PUMPING 125		TYPE OF PUMP USED (for test)	
☒ air		☐ piston	
☐ centrifugal		☐ turbine	
☐ jet		☐ other (describe below)	
☐ submersible			

12	9551.838	5046.572
13	10046.464	4964.16
14	10023.086	4997.677

PETER J. FOURNIER
753/578

GENERAL NOTES

- THIS AREA INDICATES A PRIVATE SEWAGE SYSTEM OF APPROXIMATELY 10000 SQ. FT. AS REQUIRED BY THE MARYLAND STATE DEPT. OF HEALTH AND MENTAL HYGIENE FOR INDIVIDUAL DISPOSAL. IMPROVEMENTS OF ANY NATURE IN THIS AREA ARE RESTRICTED UNTIL PUBLIC SEWAGE IS AVAILABLE. SERVICES ANY RESIDENTIAL STRUCTURES CONSTRUCTED ON THESE BUILDING SITES. THIS EASEMENT SHALL BECOME NULL AND VOID UPON CONNECTION TO A PUBLIC SEWAGE SYSTEM.
- THE LOTS SHOWN HEREON COMPLY WITH THE MINIMUM OWNERSHIP WIDTH AND LOT AREA AS REQUIRED BY THE MARYLAND STATE DEPT. OF HEALTH AND MENTAL HYGIENE.
- THE COORDINATES SHOWN HEREON ARE BASED ON ASSUMED DATA.
- DEED REFERENCE: 763/488
- B.R.L. DENOTES BUILDING RESTRICTION LINE.
- EXISTING STRUCTURES ON LOT 1.
- FOR FLAG OR PIPESTEM LOTS, REFUSE COLLECTION, SNOW REMOVAL, AND ROAD MAINTENANCE ARE PROVIDED TO THE JUNCTION OF THE FLAG OR PIPESTEM AND THE ROAD RIGHT-OF-WAY LINE ONLY AND NOT ON TO THE FLAG OR PIPESTEM LOT DRIVEWAY.
- TAX MAP 4, PARCEL NO. 80.

CENTERLINE OF RIVER ROAD

SHAD: AREA TO BE DEDICATED TO HOWARD COUNTY FOR THE PURPOSE OF A PUBLIC ROAD. TOTAL AREA: 0.298 ACRES

AREA TABULATIONS

TOTAL NO. OF LOTS	4
TOTAL AREA OF LOTS	18.599 ACRES
TOTAL ROAD DEDICATION	0.298 ACRES
TOTAL AREA OF PLAT	18.897 ACRES

APPROVED: FOR PRIVATE WATER / PRIVATE SEWAGE SYSTEMS HOWARD COUNTY HEALTH DEPT.

Christopher J. ... 12-19-78
COUNTY HEALTH OFFICE DATE

APPROVED: HOWARD COUNTY OFFICE OF PLANNING

Thomas L. ... 12-21-78
DIRECTOR DATE

APPROVED: FOR STORM DRAINAGE SYSTEMS / PUBLIC ROADS HOWARD COUNTY DEPT. OF PUBLIC WORKS

Richard E. ... 12/20/78
DIRECTOR DATE

SURVEYOR'S CERTIFICATE

I HEREBY CERTIFY THAT THE FINAL PLAT SHOWN HEREON IS CORRECT. THAT IT IS A SUBDIVISION OF ALL OF THE LANDS CONVEYED BY GRACE I. CHRISTOPHER TO JAMES W. DICKEY BY DEED DATED JANUARY 28, 1976 AND RECORDED AMONG THE LAND RECORDS OF HOWARD COUNTY IN LIBER 763 FOLIO 488, AND THAT ALL MONUMENTS ARE IN PLACE AS SHOWN IN ACCORDANCE WITH THE ANNOTATED CODE OF MARYLAND AS AMENDED.

3-16-78
DATE

JOHN C. MELLEMA SR.
REGISTERED SURVEYOR
MD. REG. NO. 107

OWNERS DEDICATION

I, JAMES W. DICKEY, OWNER OF THE PROPERTY SHOWN AND DESCRIBED HEREON, HEREBY ADOPT THIS PLAN OF SUBDIVISION AND IN CONSIDERATION OF THE APPROVAL OF THIS PLAT BY THE OFFICE OF PLANNING AND ZONING ESTABLISH THE MINIMUM BUILDING RESTRICTION LINES, AND GRANT, UNTO HOWARD CO., MD., ITS SUCCESSORS AND ASSIGNS: (1) THE RIGHT TO LAY, CONSTRUCT, MAINTAIN, SEWERS, DRAINAGE, WATER PIPES AND OTHER MUNICIPAL UTILITIES; SERVICES IN AND UNDER ALL ROADS; STREET RIGHT-OF-WAYS AND THE SPECIFIC EASEMENT AREAS SHOWN HEREON (2) DEDICATED TO PUBLIC USE THE BEDS OF THE STREETS AND/OR ROADS; FLOOD PLAINS; OPEN SPACE WERE APPLICABLE; FOR ONE DOLLAR CONSIDERATION, HEREBY GRANT THE RIGHT AND OPTION TO HOWARD CO. TO ACQUIRE THE FEE SIMPLE TITLE IN THE BEDS OF THE STREETS AND/OR ROADS; FLOOD PLAINS; OPEN SPACE WERE APPLICABLE; (3) THAT NO BUILDING OR SIMILAR STRUCTURE OF ANY KIND, SHALL BE ERRECTED ON OR OVER THE SAID EASEMENT (RIGHT-OF-WAYS AND (4) IT IS FURTHER AGREED THAT MAINTENANCE OF ALL WATERWAYS, DRAINAGE EASEMENTS, AND/OR FLOOD PLAINS SHOWN HEREON ARE THE RESPONSIBILITY OF THE PROPERTY OWNERS, ITS SUCCESSORS AND ASSIGNS.

OWNER

WITNESS

VICINITY MAP
SCALE: 1" = 2000'

CURVE DATA					
NO.	R	T	A	L	CH
A	152.00	20.36	13°-16'-28"	40.52	N 56°-34'-24" W
B	152.00	12.88	09°-41'-04"	25.69	N 42°-09'-15" W
C	152.00	66.17	47°-02'-58"	124.82	N 36°-45'-14" W
D	128.00	53.11	47°-02'-58"	100.18	N 36°-45'-14" W
E	152.00	13.63	109°-14'-57"	27.19	N 32°-11'-26" W
F	152.00	15.76	114°-50'-27"	31.41	N 21°-09'-21" W

OWNER
JAMES W. DICKEY
DICKEY FARM
SYKESVILLE, MARYLAND

RECORDED: PLAT 4189
ON 12-22-78
HOWARD COUNTY, MD.

JOHN C. MELLEMA SR., INC.
LAND SURVEYORS
3704 MACTAVISH AVE. - BALTIMORE, MD. 21228

SALOPHA SUBDIVISION
LOTS 1-4

3RD ELECTION DISTRICT
HOWARD COUNTY, MARYLAND
FEBRUARY 16, 1970 - SCALE: 1" = 100'