

10/10/77  
p.m. please

Approved  
10/10/77  
T.S.O.

# PERMIT

P 27017  
A Repair

SEWAGE DISPOSAL SYSTEM

MARYLAND STATE DEPARTMENT OF HEALTH

HOWARD COUNTY

ELLICOTT CITY

DISTRICT \_\_\_\_\_

INDEXED

DATE 10/10/77

Jack Fyock IS PERMITTED TO INSTALL ALTER X

ADDRESS Triadelphia Road, Glenelg, Md. PHONE \_\_\_\_\_

A SEWAGE DISPOSAL SYSTEM LOCATED AT \_\_\_\_\_

SUBDIVISION \_\_\_\_\_ ROAD Waynewright Road LOT \_\_\_\_\_

PROPERTY OWNER Mr. Goodall Route 108 to Wainwright Road, turn right, 3rd driveway on right (top of the hill on left hand side)

ADDRESS \_\_\_\_\_

## SPECIFICATIONS

DRAIN FIELD \_\_\_\_\_ DEPTH \_\_\_\_\_ FEET, BOTTOM AREA \_\_\_\_\_ SQ. FT.

SEEPAGE PITS \_\_\_\_\_ ABSORBENT SIDE-WALL AREA \_\_\_\_\_ SQ. FT.

SEPTIC TANK CAPACITY \_\_\_\_\_ GALLONS

FOR GARBAGE GRINDER, INCREASE DISPOSAL AREA 22% & TANK CAPACITY 50%.

OTHER REPAIR-CALL FOR INSPECTION AFTER GROUND IS OPENED UP SO SANITARIAN CAN


RECOMMEND REPAIR.

PLANS APPROVED BY Palmer F. Wine DATE 10/10/77

FILL SEPTIC TANK AND DISTRIBUTION BOX WITH WATER BEFORE CALLING FOR AN INSPECTION. COVER NO WORK UNTIL INSPECTED AND APPROVED.

NEITHER THE HOWARD COUNTY COMMISSIONERS NOR THE HEALTH DEPARTMENT IS RESPONSIBLE FOR THE SUCCESSFUL OPERATION OF ANY SYSTEM.

27017

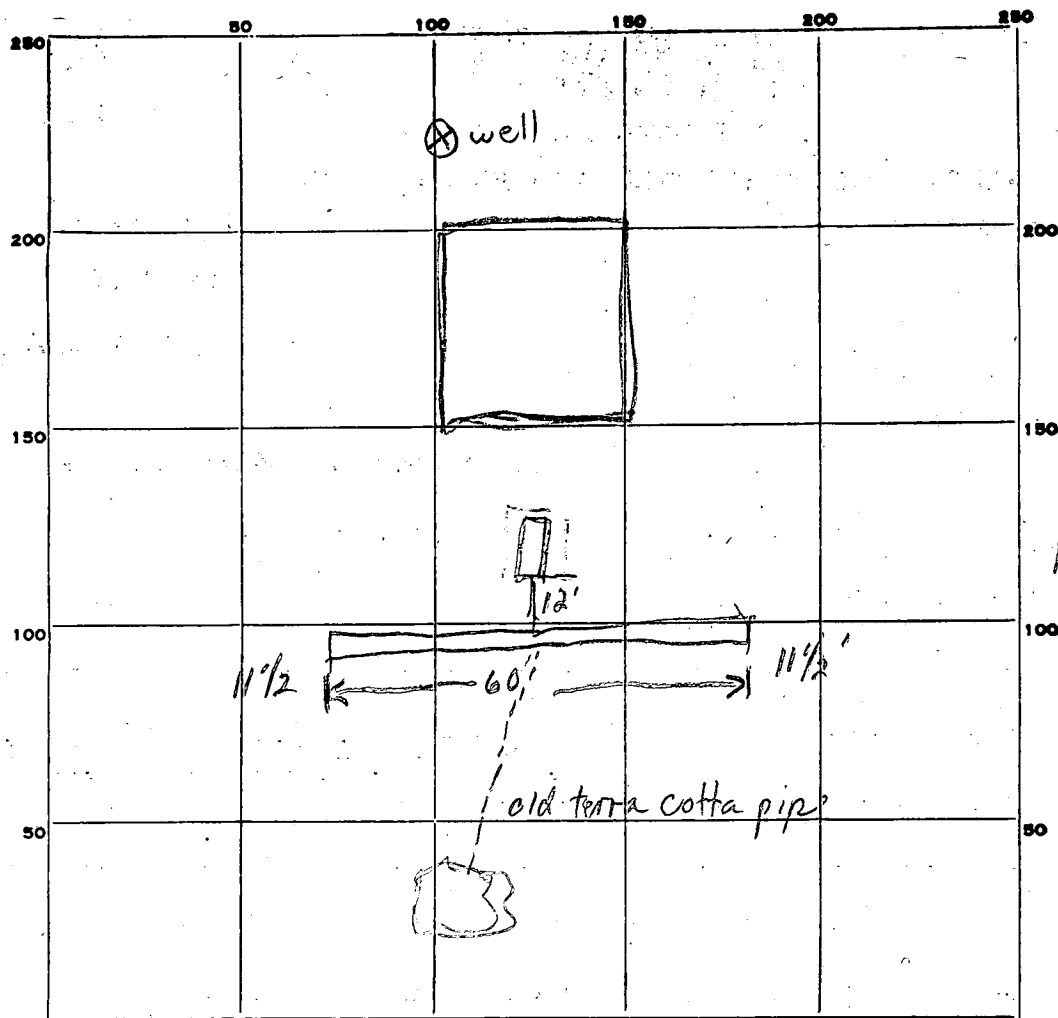

Sandy mica  
loam top to  
bottom - Excellent  
soil

8.5  
60  
510.0

3 bedrooms

INDICATE NORTH. - NAME ADJOINING ROADWAY AS BASE LINE.

PERMIT CARD \_\_\_\_\_

SEPTIC TANK, LEVEL \_\_\_\_\_

CLEANOUTS \_\_\_\_\_

DISTRIBUTION BOX, LEVEL \_\_\_\_\_

TILE FIELD, DEPTH 11 1/2 FT. TRENCH WIDTH 2 FT.

GRAVEL DEPTH 8 1/2 ft. IN. TOTAL LENGTH 60 FT.

NUMBER OF TRENCHES 1 TOTAL BOTTOM AREA 510

SEEPAGE PITS, INSIDE DIAMETER \_\_\_\_\_ FT. DEPTH BELOW INLET \_\_\_\_\_ FT.

ABSORBENT AREA 510 SQ. FT.

REMARKS 10/10/77: Trench OK, stone added while sanitarian present.

DATE SYSTEM APPROVED 10/10/77

INSPECTOR T.S. Ogile