

10/24/77 S.P.C. 0.0
P 27096 S.P.C. 0.0 ②

10/24/77
1:30 P.M.
10/17/78 9:30 A.M.

PERMIT

SEWAGE DISPOSAL SYSTEM

A Hold-for call

MARYLAND STATE DEPARTMENT OF HEALTH

HOWARD COUNTY

INDEXED

05-366410

ELLICOTT CITY

DISTRICT 5th

DATE 10/21/77

Donald Parlette

Jenkins Brothers

IS PERMITTED TO INSTALL ALTER X

ADDRESS Route 144, Ellicott City, Md.

PHONE 465-6646

A SEWAGE DISPOSAL SYSTEM LOCATED AT _____

SUBDIVISION Clarksville Ridge

ROAD 6718 Surrey Lane

LOT _____

PROPERTY OWNER George Seylar

(corner Surry Lane & Whitegobeld)

ADDRESS 6718 Surrey Lane, Clarksville, Md. 21039

Phone: 531-6633

SPECIFICATIONS

DRAIN FIELD _____ DEPTH _____ FEET, BOTTOM AREA _____ SQ. FT.

SEEPAGE PITS _____ ABSORBENT SIDE-WALL AREA _____ SQ. FT.

SEPTIC TANK CAPACITY _____ GALLONS

FOR GARBAGE GRINDER, INCREASE DISPOSAL AREA 22% & TANK CAPACITY 50%.

OTHER REPAIR - Call for inspection when ground is opened up and Sanitarian will
recommend repair system.

TRENCH - 60' LONG, 12' DEEP, 8' OF STONE; COME OFF LEFT
SIDE OF DW; FOLLOW CONTOUR TO KEEP TRENCH LEVEL


PLANS APPROVED BY Palmer F. Wine

DATE 10/21/77

FILL SEPTIC TANK AND DISTRIBUTION BOX WITH WATER BEFORE CALLING FOR AN INSPECTION. COVER NO WORK UNTIL INSPECTED AND APPROVED.

NEITHER THE HOWARD COUNTY COMMISSIONERS NOR THE HEALTH DEPARTMENT IS RESPONSIBLE FOR THE SUCCESSFUL OPERATION OF ANY SYSTEM.

P27096

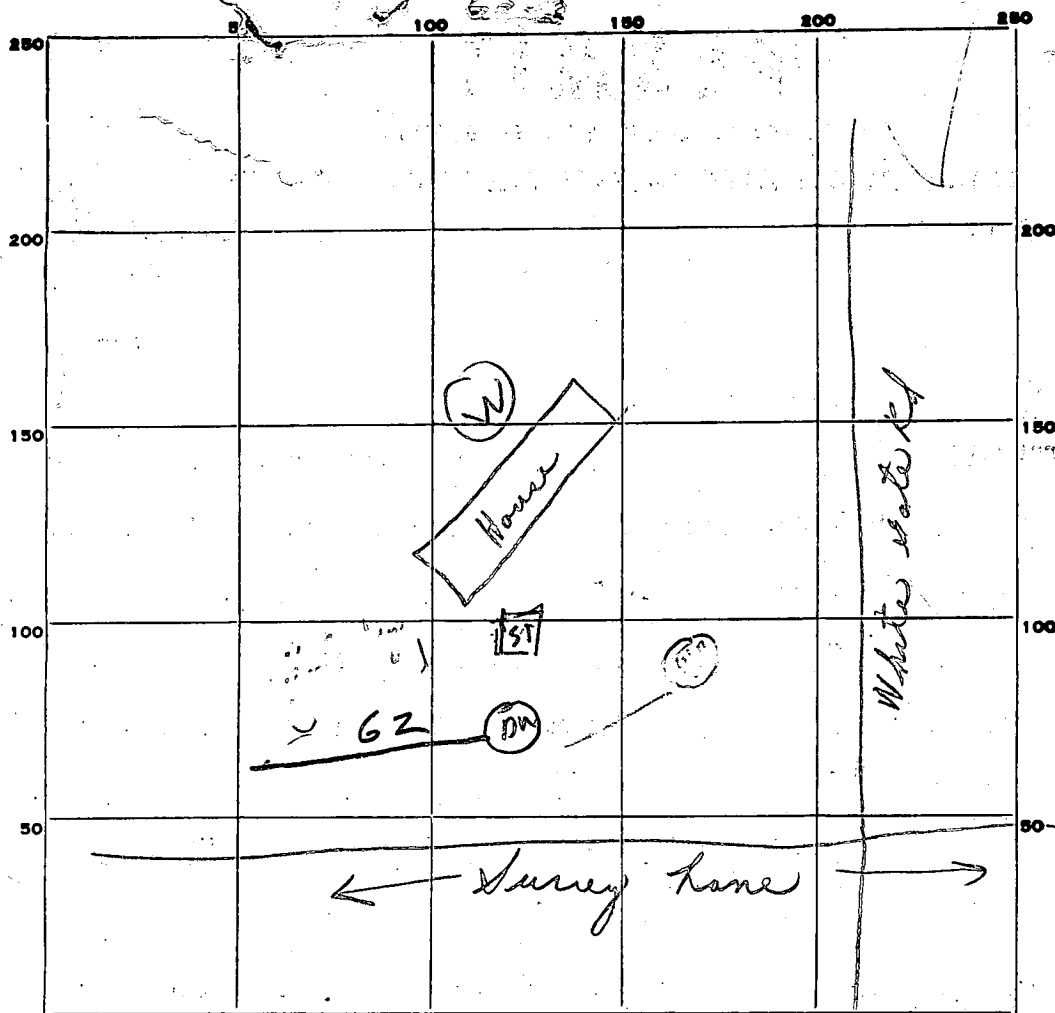

INDICATE NORTH. - NAME ADJOINING ROADWAY AS BASE LINE.

PERMIT CARD _____

SEPTIC TANK, LEVEL _____

CLEANOUTS _____

DISTRIBUTION BOX, LEVEL _____

TILE FIELD, DEPTH 12 1/2 FT. TRENCH WIDTH 2 FT.

GRAVEL DEPTH 13 F IN. TOTAL LENGTH 62 FT.

NUMBER OF TRENCHES 1 TOTAL BOTTOM AREA _____

SEEPAGE PITS, INSIDE DIAMETER _____ FT. DEPTH BELOW INLET _____ FT.

ABSORBENT AREA _____ SQ. FT.

REMARKS 10/24/77 No work started at 10:15

② 1:00 No work started. C.B.D.

10/17/78 1000 PM DITCH OK NOW ADD ROCK C.B.D.

10/17/78 1:30 PM - ROCK ADDED

DATE SYSTEM APPROVED 10/17/78

INSPECTOR Raymond G. Dodge

Repair perc.
10/20/77
9:30 A.M. 1:30 P.M.
10/21/77

APPLICATION

SEWAGE DISPOSAL TESTING

STATE OF MARYLAND - DEPARTMENT OF HEALTH AND MENTAL HYGIENE

HOWARD COUNTY HEALTH DEPARTMENT
ENVIRONMENTAL HEALTH SERVICES

P. O. BOX 476, ELLICOTT CITY, MARYLAND 21043
TELEPHONE: 465-5000, EXT. 356

A _____

P _____

DISTRICT 5th

DATE _____

TO: THE COUNTY HEALTH OFFICER
ELLICOTT CITY, MARYLAND

I, HEREBY, APPLY FOR THE NECESSARY TEST IN ORDER TO CONSTRUCT (OR RECONSTRUCT) A SEWAGE DISPOSAL SYSTEM.

PROPERTY OWNER George Seylar

ADDRESS 6718 Surrey Lane, Clarksville, Md. PHONE _____

PROPERTY LOCATION:

SUBDIVISION "Clarksville Ridge" LOT NO. _____

ROAD AND DESCRIPTION 6718 Surrey Lane

SIZE OF LOT ? TYPE BLDG. ? NUMBER OF BEDROOMS _____

IF NOT SINGLE RESIDENCE DESCRIBE _____

THE SYSTEM INSTALLED UNDER THIS APPLICATION IS ACCEPTABLE ONLY UNTIL PUBLIC FACILITIES BECOME AVAILABLE.

SIGNATURE OF APPLICANT /s/ Jenkins Brothers

APPROVED BY _____ FOR _____ DATE _____
(KIND OF SYSTEM)

REJECTED BY _____ FOR _____ DATE _____
(KIND OF SYSTEM)

HOLD/PENDING FURTHER TESTS _____ DATE _____

REASONS FOR REJECTION OR HOLDING _____

THIS IS NOT A PERMIT