

4/5/78
a.m. if possible

PERMIT

P 27744

A REPAIR

SEWAGE DISPOSAL SYSTEM

MARYLAND STATE DEPARTMENT OF HEALTH*

HOWARD COUNTY

05-376181

ELLICOTT CITY

DISTRICT 5th

INDEXED

DATE 3/31/78

Jack Fyock

IS PERMITTED TO INSTALL ALTER ☒

ADDRESS Glenelg, Md.

PHONE

SUBDIVISION

ROAD 4871 Ten Oaks Road

LOT

PROPERTY OWNER Four Square Gospel Church

ADDRESS 4871 Ten Oaks Road, Dayton, Md.

SPECIFICATIONS

SEPTIC TANK CAPACITY GALLONS

DRAIN FIELD DEPTH FEET, BOTTOM AREA SQ. FT.

DEEP TRENCH DEPTH FEET, BOTTOM AREA SQ. FT.

SEEPAGE PITS ABSORBENT SIDE-WALL AREA SQ. FT.

INLET PIPE FT. BELOW ORIGINAL GRADE. MAXIMUM DEPTH FT. BELOW ORIGINAL GRADE

EFFECTIVE DEPTH AT FT. BELOW ORIGINAL GRADE.

LOCATE DISPOSAL AREA FT. FROM LOT LINE AND FT. FROM LOT LINE AS SEEN WHEN

FACING LOT FROM

REPAIR-CALL FOR INSPECTION WHEN GROUND IS OPENED UP SO SANITARIAN CAN RECOMMEND

REPAIR. 100' trench 11' deep 3' invert to Run Towards Rear

of lot on contour 7/5/78 DJS

PLANS APPROVED BY Palmer F. Wine

DATE 3/31/78

COVER NO WORK UNTIL INSPECTED AND APPROVED.

NEITHER THE HOWARD COUNTY COUNCIL NOR THE HEALTH DEPARTMENT IS RESPONSIBLE FOR THE SUCCESSFUL OPERATION OF ANY SYSTEM.

NOTE: IF TRENCH IS USED CALL FOR INSPECTION BEFORE PLACING GRAVEL IN TRENCH.

NOTE: NO DRY WELL SHALL EXCEED 15 FOOT IN DIAMETER.

NOTE: ALL PIPE FROM HOUSE TO DISPOSAL AREA MUST BE CAST IRON.

PERMIT VOID AFTER THREE YEARS.

NOTE: INSTALL STAND PIPE ON SEPTIC TANK AND DRY WELL. STAND PIPES MUST BE 6 INCHES IN DIAMETER. CAST IRON, CONCRETE OR TERRA COTTA ACCEPTED.

*INSTALLER IS RESPONSIBLE FOR OBTAINING FINAL APPROVAL ON THIS PERMIT.


BLDG. PERMIT, SIGNED
AND RETURNED 2/14/79

Serial No. 38343

Remodel interior &

Construct nursery &
fence in rear of bldg.

27744

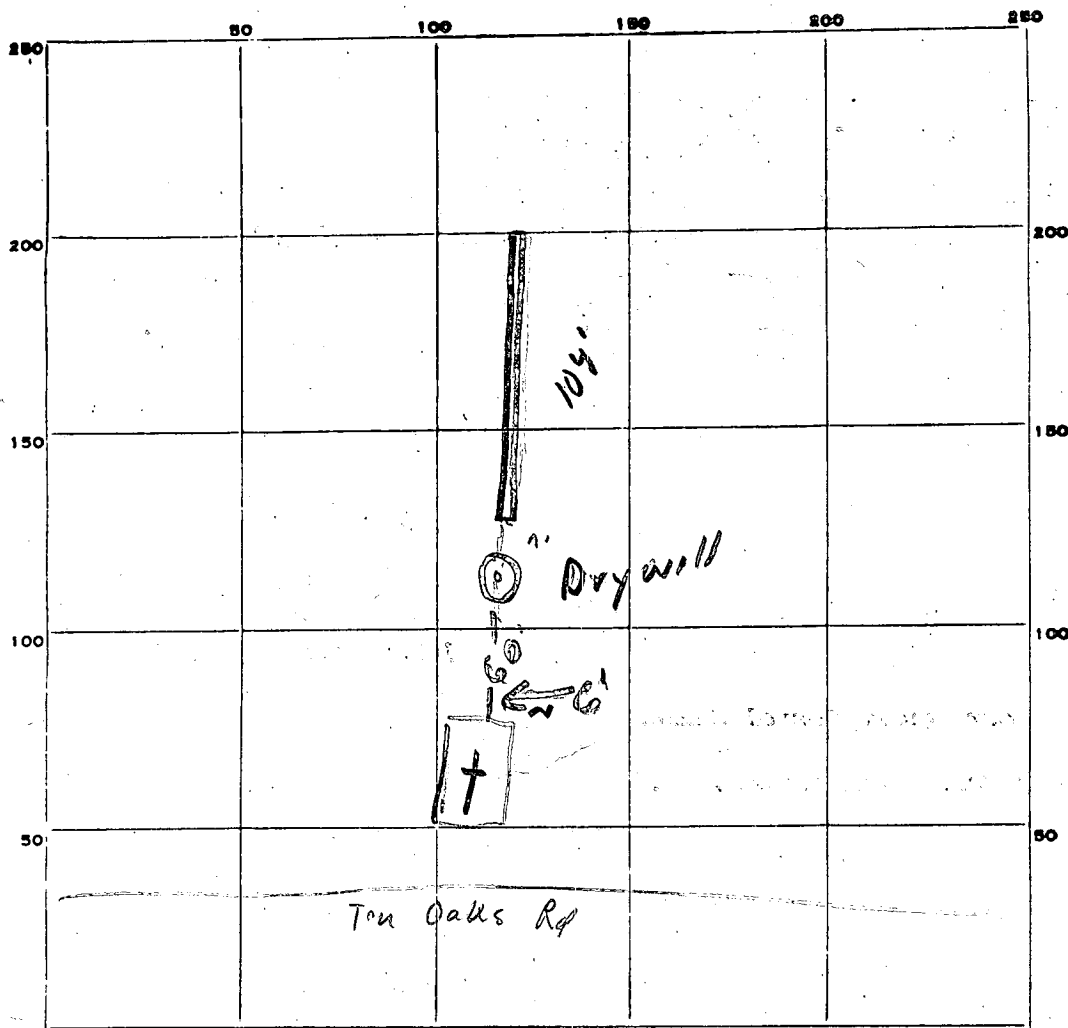

INDICATE NORTH. - NAME ADJOINING ROADWAY AS BASE LINE.

PERMIT CARD Speed Final

SEPTIC TANK, LEVEL NA

CLEANOUTS NA

DISTRIBUTION BOX, LEVEL NA

TILE FIELD, DEPTH 11' FT. TRENCH WIDTH 2 FT.

GRAVEL DEPTH 8' IN. TOTAL LENGTH 104' FT.

NUMBER OF TRENCHES 1 TOTAL BOTTOM AREA 832 sq. ft.

SEEPAGE PITS, INSIDE DIAMETER FT. DEPTH BELOW INLET FT.

ABSORBENT AREA SQ. FT.

REMARKS Letter from Pastor states "trench measured in my presence, and was 11' deep".

DATE SYSTEM APPROVED 4/5/78

INSPECTOR RJO'Neill

Inspector,

This ditch has been
dug to a depth of 11 feet.
It was measured in my
Sight.

REV. Robert A. Bingham