

SEPTIC SYSTEM TO BE INSTALLED
FIRST BEFORE BUILDING PERMIT
IS SIGNED.

PERMIT

SEWAGE DISPOSAL SYSTEM

MARYLAND STATE DEPARTMENT OF HEALTH

HOWARD COUNTY

ELLICOTT CITY

DISTRICT 5th

DATE 8/8/78

INDEXED

Costello Builders

IS PERMITTED TO INSTALL ☒ ALTER ☐

ADDRESS

PHONE

SUBDIVISION Highland Lake

ROAD

6624 Prestwick Drive

LOT 39

PROPERTY OWNER Costello Builders

Urban Const., Inc.

ADDRESS

600 Reisterstown Rd, Balto., Md. 21208

655-4103

SPECIFICATIONS 1 bedroom

SEPTIC TANK CAPACITY 1000 GALLONS

DRAIN FIELD DEPTH FEET. BOTTOM AREA SQ. FT.

DEEP TRENCH DEPTH FEET. BOTTOM AREA SQ. FT.

SEEPAGE PITS ABSORBENT SIDE WALL AREA 160 SQ. FT. below first 5 ft. of original soil.

INLET PIPE 4 FT. BELOW ORIGINAL GRADE. MAXIMUM DEPTH 11 FT. BELOW ORIGINAL GRADE

EFFECTIVE DEPTH AT FT. BELOW ORIGINAL GRADE.

LOCATE DISPOSAL AREA FT. FROM LOT LINE AND FT. FROM LOT LINE AS SEEN WHEN

FACING LOT FROM

LOCATION PER ENGINEER'S PLAT. If dry well and trench are used, need a 5 ft. earth buffer

between dry well and trench.

AND RETURNED 11/3/80

300127182 Garage/Family Room

PLANS APPROVED BY D.W. Monaghan/C.B. Stroecker

DATE 5/22/74

COVER NO WORK UNTIL INSPECTED AND APPROVED.

NEITHER THE HOWARD COUNTY COUNCIL NOR THE HEALTH DEPARTMENT IS RESPONSIBLE FOR THE SUCCESSFUL OPERATION OF ANY SYSTEM

NOTE IF TRENCH IS USED CALL FOR INSPECTION BEFORE PLACING GRAVEL IN TRENCH.

NOTE NO DRY WELL SHALL EXCEED 15 FOOT IN DIAMETER.

NOTE ALL PIPE FROM HOUSE TO DISPOSAL AREA MUST BE CAST IRON.

PERMIT VOID AFTER THREE YEARS.

NOTE INSTALL STAND PIPE ON SEPTIC TANK AND DRY WELL. STAND PIPES MUST BE 6 INCHES IN DIAMETER. CAST IRON, CONCRETE OR TERRA

COSTA ACCEPTED

INSTALLER IS RESPONSIBLE FOR OBTAINING FINAL APPROVAL ON THIS PERMIT.

MD 23

BLDG. PERMIT SIGNED
AND RETURNED 8/30/78
Serial No. 36958


428643

163
x 3
489

430
414
636

7
26
42 80

23
46

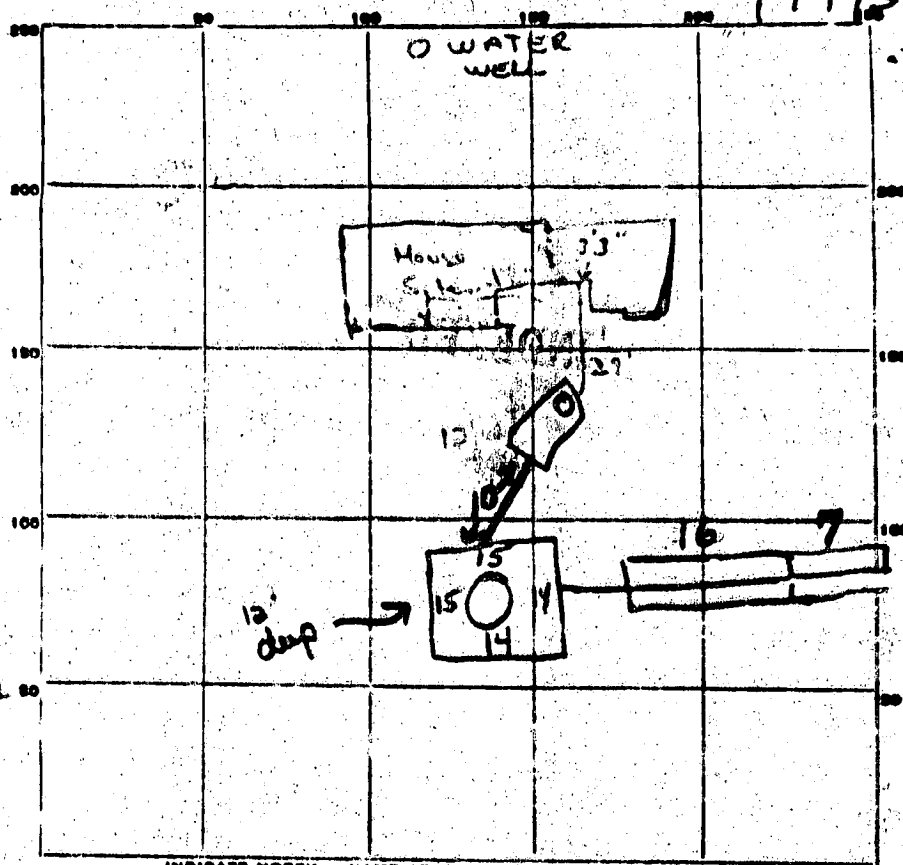

INDICATE NORTH - NAME ADJOINING ROADWAY AS BASE LINE.

PERMIT CARD ☒ No ^{Phone} Yes/Conf/No Preswick Drive ST / DW

SEPTIC TANK, LEVEL ☒ CLEANOUTS ☒ turn on

DISTRIBUTION BOX, LEVEL Na

TILE FIELD, DEPTH 11 FT. TRENCH WIDTH 2 FT. Effective AT 5'

GRAVEL DEPTH 6 ft TOTAL LENGTH 16 + 7 FT.

NUMBER OF TRENCHES 1 TOTAL BOTTOM AREA 1/2 SW

perimeter 58 FT. DEPTH BELOW INLET 6 FT. 34

SEEPAGE PITS, INSIDE DIAMETER 58 FT. DEPTH BELOW INLET 6 FT. 34

ABSORBENT AREA ±486 SQ. FT. 42 + 4'

REMARKS 11 Aug 78 - Need to extend trench 6ft. Warnig a
maximum depth in drywell. Call for next inspection w/
gravel is added to trench 3 work on drywell & septic
is complete (G4K) 15 Aug 78 - OK to cover all work. Call for
final when house connection installed (G4K) 11/13/78 3/1

[illegible]

Highland Lake
#30
-42

[illegible]

TESTED BY


11 Dec 6 (Sunday - E. L. Clark, Jr.)

21

ALSO PRESENT

Property known as: LOT 39
HIGHLAND LAKE
SECTION ONE
P.B. 1332/135
5TH ELECTION DISTRICT
HOWARD COUNTY, MD.

THIS PLAT CAN NOT BE USED TO ESTABLISH PROPERTY
LINES OR CORNERS.

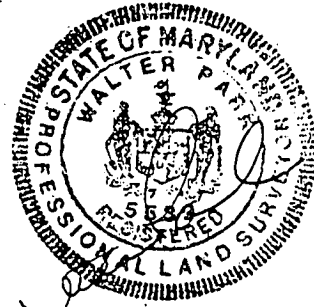

PRESTWICK DRIVE *Wall*
60' B/W

$R=605.00$ $L=43.00'$

$N 75^{\circ}18'36''E$

206.28'

