

8/14/78  
9:30 a.m.

Repair Approved (GUK)  
15 Aug. 78

# PERMIT

P 28652

A REPAIR

SEWAGE DISPOSAL SYSTEM

MARYLAND STATE DEPARTMENT OF HEALTH

HOWARD COUNTY

03-287920

ELLICOTT CITY

DISTRICT 3rd

**INDEXED**

DATE 8/8/78

Robert Reinhardt

IS PERMITTED TO INSTALL ALTER X

ADDRESS \_\_\_\_\_

PHONE \_\_\_\_\_

SUBDIVISION \_\_\_\_\_

ROAD 1105 River Road

LOT \_\_\_\_\_

PROPERTY OWNER Mrs. Hursey & Mrs. Eichelberger

ADDRESS 1105 River Road, Sykesville, Md.

SPECIFICATIONS 2 bedrooms

SEPTIC TANK CAPACITY 1000 GALLONS

DRAIN FIELD \_\_\_\_\_ DEPTH \_\_\_\_\_ FEET, BOTTOM AREA \_\_\_\_\_ SQ. FT.

DEEP TRENCH \_\_\_\_\_ DEPTH 10 FEET, BOTTOM AREA 300 SQ. FT.

SEEPAGE PITS \_\_\_\_\_ ABSORBENT SIDE-WALL AREA \_\_\_\_\_ SQ. FT.

INLET PIPE 2-4 FT. BELOW ORIGINAL GRADE. MAXIMUM DEPTH 10 FT. BELOW ORIGINAL GRADE

EFFECTIVE DEPTH AT 4 FT. BELOW ORIGINAL GRADE.

LOCATE DISPOSAL AREA \_\_\_\_\_ FT. FROM \_\_\_\_\_ LOT LINE AND \_\_\_\_\_ FT. FROM \_\_\_\_\_ LOT LINE AS SEEN WHEN  
FACING LOT FROM

REPAIR-CALL FOR INSPECTION WHEN GROUND IS OPENED UP SO SANITARIAN CAN

RECOMMEND REPAIR.

Good soil at 4'-10' ↔ 0'6" to 4' clayey-silty loam to 10'  
Trench to be 50 feet long, 10 feet deep, inlet at 2-4' and  
contain 6 feet of stone. Run with contour toward left prop. line.

PLANS APPROVED BY Palmer F. Wine

DATE 8/8/78

COVER NO WORK UNTIL INSPECTED AND APPROVED.

NEITHER THE HOWARD COUNTY COUNCIL NOR THE HEALTH DEPARTMENT IS RESPONSIBLE FOR THE SUCCESSFUL OPERATION OF ANY SYSTEM.

NOTE: IF TRENCH IS USED CALL FOR INSPECTION BEFORE PLACING GRAVEL IN TRENCH.

NOTE: NO DRY WELL SHALL EXCEED 15 FOOT IN DIAMETER.


NOTE: ALL PIPE FROM HOUSE TO DISPOSAL AREA MUST BE CAST IRON.

PERMIT VOID AFTER THREE YEARS.

NOTE: INSTALL STAND PIPE ON SEPTIC TANK AND DRY WELL. STAND PIPES MUST BE 6 INCHES IN DIAMETER. CAST IRON, CONCRETE OR TERRA  
COTTA ACCEPTED.

**\*INSTALLER IS RESPONSIBLE FOR OBTAINING FINAL APPROVAL ON THIS PERMIT.**

P28652

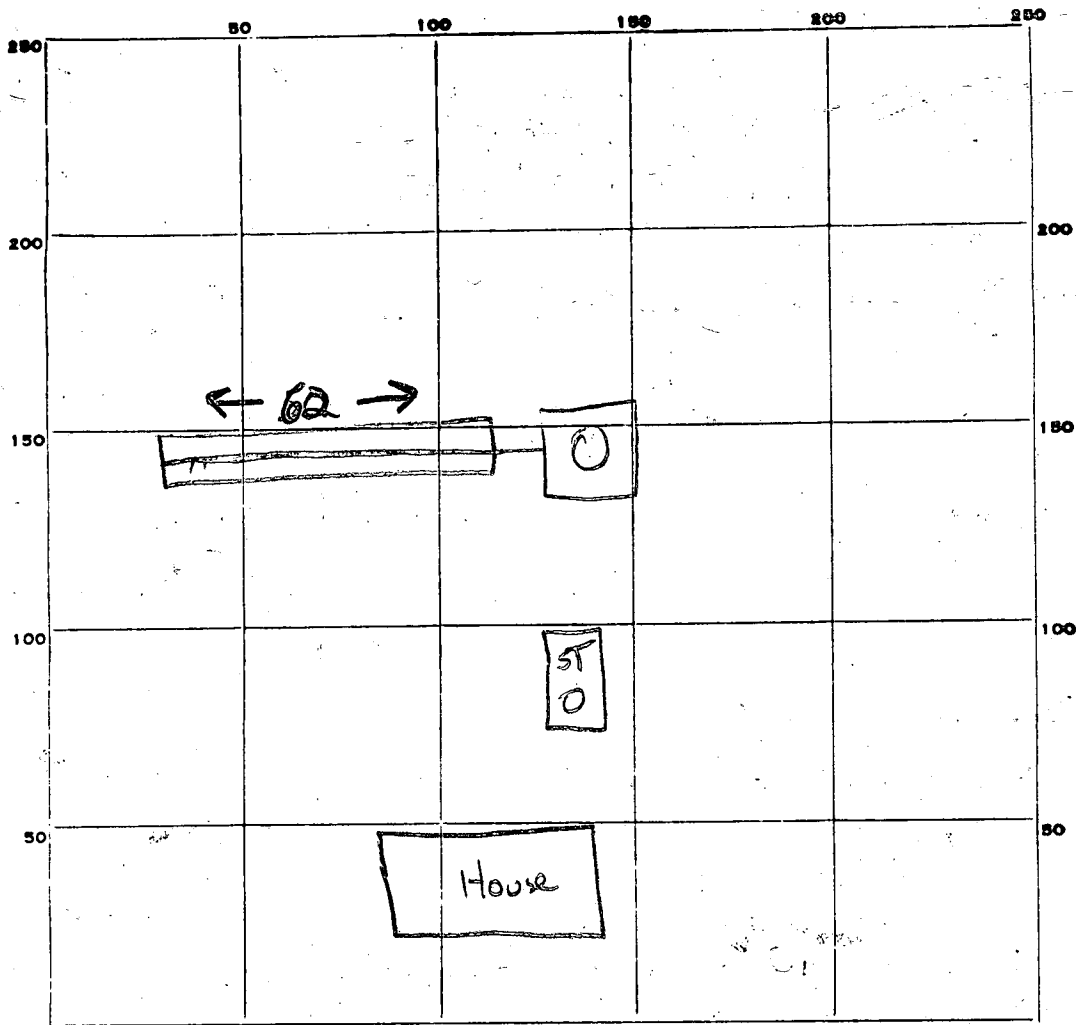

INDICATE NORTH. - NAME ADJOINING ROADWAY AS BASE LINE.

River Rd

PERMIT CARD NW

SEPTIC TANK, LEVEL \_\_\_\_\_

CLEANOUTS \_\_\_\_\_

DISTRIBUTION BOX, LEVEL \_\_\_\_\_

TILE FIELD, DEPTH 10 FT. TRENCH WIDTH 2 FT.

GRAVEL DEPTH 8' ☒ TOTAL LENGTH 62 FT.

NUMBER OF TRENCHES 1 TOTAL <sup>1/2 SW</sup> BOTTOM AREA ±496

SEEPAGE PITS, INSIDE DIAMETER \_\_\_\_\_ FT. DEPTH BELOW INLET \_\_\_\_\_ FT.

ABSORBENT AREA \_\_\_\_\_ SQ. FT.

REMARKS 14 Aug 78 - Specs. written. OK to add gravel to trench  
if owners will certify depth of trench (GLK)  
15 Aug 78 - Final OK - Cover all work (GLK)

DATE SYSTEM APPROVED 15 Aug. 78

INSPECTOR G. Keller