

# PERMIT

SEWAGE DISPOSAL SYSTEM

MARYLAND STATE DEPARTMENT OF HEALTH\*

HOWARD COUNTY

ELLICOTT CITY

DISTRICT 1st

DATE 9/5/78

INDEX

06-172557

Arid Septic Service

IS PERMITTED TO INSTALL ALTER X

ADDRESS \_\_\_\_\_ PHONE \_\_\_\_\_

SUBDIVISION \_\_\_\_\_ ROAD 7540 Washington Blvd. LOT \_\_\_\_\_

PROPERTY OWNER Luskins Bldg.

ADDRESS \_\_\_\_\_

## SPECIFICATIONS

SEPTIC TANK CAPACITY \_\_\_\_\_ GALLONS

DRAIN FIELD \_\_\_\_\_ DEPTH \_\_\_\_\_ FEET, BOTTOM AREA \_\_\_\_\_ SQ. FT.

DEEP TRENCH \_\_\_\_\_ DEPTH \_\_\_\_\_ FEET, BOTTOM AREA \_\_\_\_\_ SQ. FT.

SEEPAGE PITS \_\_\_\_\_ ABSORBENT SIDE-WALL AREA \_\_\_\_\_ SQ. FT.

INLET PIPE \_\_\_\_\_ FT. BELOW ORIGINAL GRADE. MAXIMUM DEPTH \_\_\_\_\_ FT. BELOW ORIGINAL GRADE

EFFECTIVE DEPTH AT \_\_\_\_\_ FT. BELOW ORIGINAL GRADE.

LOCATE DISPOSAL AREA \_\_\_\_\_ FT. FROM \_\_\_\_\_ LOT LINE AND \_\_\_\_\_ FT. FROM \_\_\_\_\_ LOT LINE AS SEEN WHEN

FACING LOT FROM

REPAIR-CALL FOR INSPECTION WHEN GROUND IS OPENED UP SO SANITARIAN CAN RECOMMEND

REPAIR.

PLANS APPROVED BY Palmer F. Wine DATE 9/5/78

COVER NO WORK UNTIL INSPECTED AND APPROVED.

NEITHER THE HOWARD COUNTY COUNCIL NOR THE HEALTH DEPARTMENT IS RESPONSIBLE FOR THE SUCCESSFUL OPERATION OF ANY SYSTEM.

NOTE: IF TRENCH IS USED CALL FOR INSPECTION BEFORE PLACING GRAVEL IN TRENCH.

NOTE: NO DRY WELL SHALL EXCEED 15 FOOT IN DIAMETER.


NOTE: ALL PIPE FROM HOUSE TO DISPOSAL AREA MUST BE CAST IRON.

PERMIT VOID AFTER THREE YEARS.

NOTE: INSTALL STAND PIPE ON SEPTIC TANK AND DRY WELL. STAND PIPES MUST BE 6 INCHES IN DIAMETER. CAST IRON, CONCRETE OR TERRA COTTA ACCEPTED.

\*INSTALLER IS RESPONSIBLE FOR OBTAINING FINAL APPROVAL ON THIS PERMIT.

28795

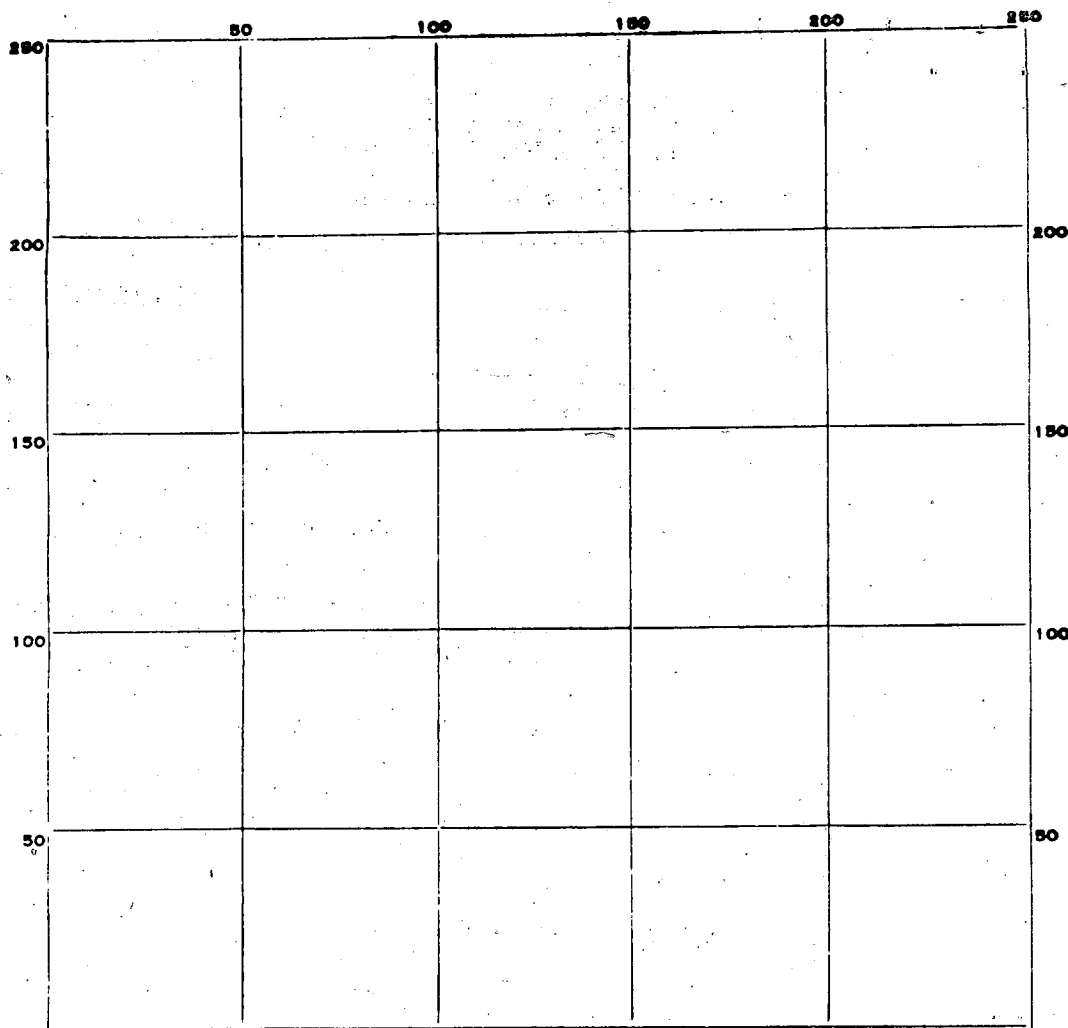

INDICATE NORTH. - NAME ADJOINING ROADWAY AS BASE LINE.

PERMIT CARD \_\_\_\_\_

SEPTIC TANK, LEVEL \_\_\_\_\_

CLEANOUTS \_\_\_\_\_

DISTRIBUTION BOX, LEVEL \_\_\_\_\_

TILE FIELD, DEPTH \_\_\_\_\_ FT. TRENCH WIDTH \_\_\_\_\_ FT.

GRAVEL DEPTH \_\_\_\_\_ IN. TOTAL LENGTH \_\_\_\_\_ FT.

NUMBER OF TRENCHES \_\_\_\_\_ TOTAL BOTTOM AREA \_\_\_\_\_

SEEPAGE PITS, INSIDE DIAMETER \_\_\_\_\_ FT. DEPTH BELOW INLET \_\_\_\_\_ FT.

ABSORBENT AREA \_\_\_\_\_ SQ. FT.

REMARKS \_\_\_\_\_  
 \_\_\_\_\_  
 \_\_\_\_\_  
DATE SYSTEM APPROVED \_\_\_\_\_ INSPECTOR \_\_\_\_\_

2091  
**PERMIT**

SEWAGE DISPOSAL SYSTEM

MARYLAND STATE DEPARTMENT OF HEALTH

HOWARD COUNTY

ELLICOTT CITY

DISTRICT 1

DATE 7/28/60

8/2/60 - 10:00

**INDEXED**

George F. Warner Co.

IS PERMITTED TO INSTALL ☒ ALTER

ADDRESS 101 High St., N.E., Washington 2

PHONE Columbia 5-9610

A SEWAGE DISPOSAL SYSTEM LOCATED AT Baltimore Washington Boulevard - north west side  
near Waterloo - First election district.

SUBDIVISION

ROAD

LOT

PROPERTY OWNER

Donohoe, Richard J. (Farmers Market)

ADDRESS

314 Pennsylvania Ave. S.E. Washington, D.C.

**SPECIFICATIONS**

DRAIN FIELD DEPTH FEET, BOTTOM AREA SQ. FT.

SEEPAGE PITS 4 ABSORBENT SIDE-WALL AREA SQ. FT. 9 x 10 ft. dry wells

SEPTIC TANK CAPACITY 2,500 GALLONS

FOR GARBAGE GRINDER, INCREASE DISPOSAL AREA 22% & TANK CAPACITY 50%.

OTHER

Dry wells to be located on the highest elevation to the rear of the

Episcopal Church and existing house. Sewage lift pump will be required

to pump effluent from septic tank to the surge box and dry wells.

Keep dry wells 27' apart


PLANS APPROVED BY Palmer F. Wine

DATE 12/1/59

FILL SEPTIC TANK AND DISTRIBUTION BOX WITH WATER BEFORE CALLING FOR AN INSPECTION. COVER NO WORK UNTIL INSPECTED AND APPROVED.

NEITHER THE HOWARD COUNTY COMMISSIONERS NOR THE HEALTH DEPARTMENT IS RESPONSIBLE FOR THE SUCCESSFUL OPERATION OF ANY SYSTEM.

A01923

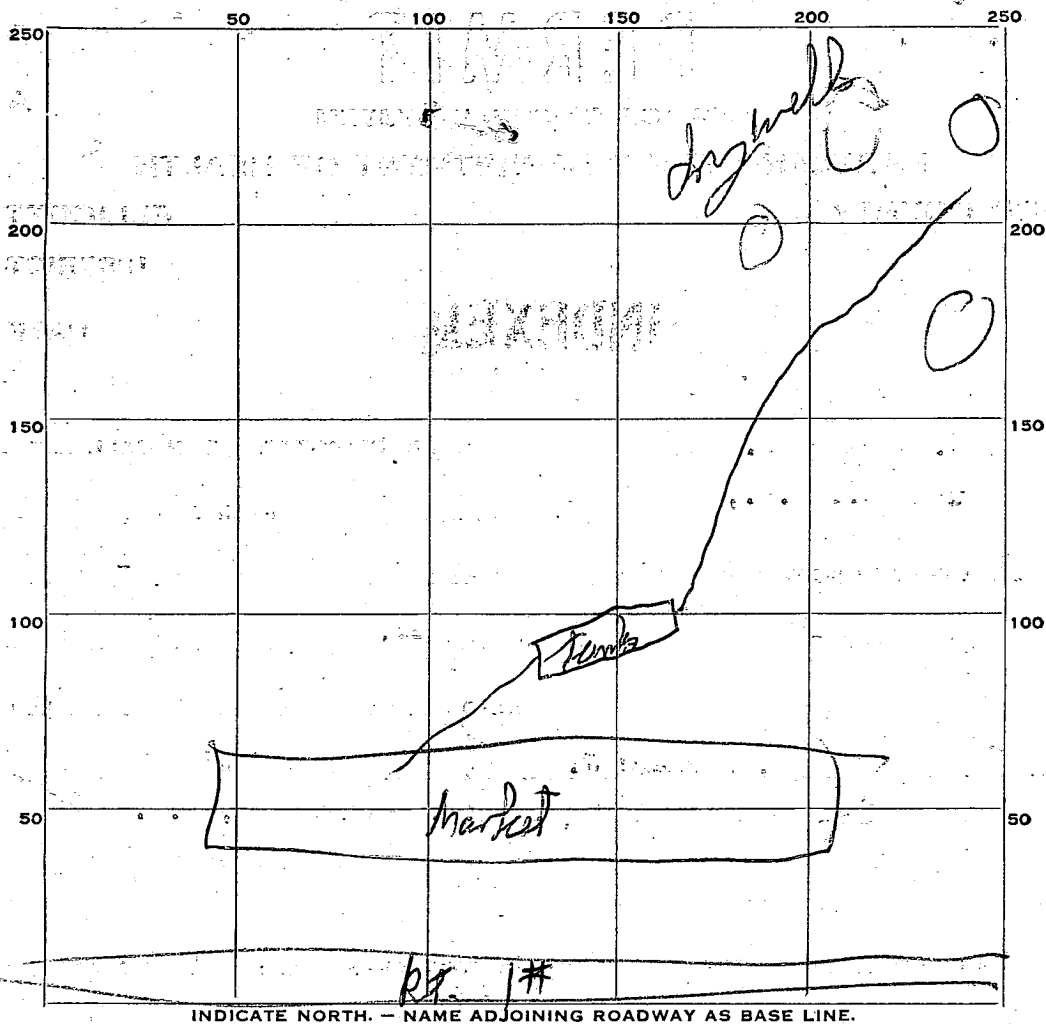

PERMIT CARD \_\_\_\_\_

SEPTIC TANK, LEVEL ☒ \_\_\_\_\_

CLEANOUTS ☒ \_\_\_\_\_

DISTRIBUTION BOX, LEVEL \_\_\_\_\_

TILE FIELD, DEPTH \_\_\_\_\_ FT. TRENCH WIDTH \_\_\_\_\_ FT.

GRAVEL DEPTH \_\_\_\_\_ IN. TOTAL LENGTH \_\_\_\_\_ FT.

NUMBER OF TRENCHES \_\_\_\_\_ TOTAL BOTTOM AREA \_\_\_\_\_

SEEPAGE PITS, INSIDE DIAMETER \_\_\_\_\_ FT. DEPTH BELOW INLET \_\_\_\_\_ FT.

ABSORBENT AREA \_\_\_\_\_ SQ. FT.

REMARKS \_\_\_\_\_

*checked septic tank & pump, 9/29/60*

DATE SYSTEM APPROVED \_\_\_\_\_

INSPECTOR \_\_\_\_\_

# APPLICATION

SEWAGE DISPOSAL TESTING

MARYLAND STATE DEPARTMENT OF HEALTH

A 01923  
P 02764

HOWARD COUNTY

ELLICOTT CITY

DISTRICT

DATE 11/23/59

4'4" X 13' ft long  
X 5' deep

100 employees  
2500 gal. septic tank  
4 - 9' X 10' dry-wells.

4 DW 13' 4" wide including gravel  
about 5 1/2' deep below inlet

DOLAR BLITZ & ASSOCIATES

consulting Engineers

TO: THE COUNTY HEALTH OFFICER  
ELLICOTT CITY, MARYLAND

904 26th ST NW  
WASH DC

I, HEREBY, APPLY FOR THE NECESSARY TESTS IN ORDER TO CONSTRUCT (OR RECONSTRUCT) A SEWAGE DISPOSAL SYSTEM.

PROPERTY OWNER Richard J. Donohoe (Agent)

ADDRESS 314 Pennsylvania Avenue, S. E. Washington, D.C. PHONE Lincoln 3-0577

PROPERTY LOCATION:

LI 3 0084

SUBDIVISION

LOT NO.

ROAD AND DESCRIPTION North west side of Baltimore Washington Boulevard near Waterloo -

First election District

OCCUPANT none

PHONE -----

PERSON TO CONSTRUCT SYSTEM Donohoe Construction Co., Inc.

ADDRESS 314 Pennsylvania Avenue, S. E.

PHONE Lincoln 3-0577

SIZE OF LOT fifteen (15) acres

TYPE BLDG.

NUMBER OF BEDROOMS

IF NOT SINGLE RESIDENCE DESCRIBE Proposed Farmers Market

SIGNATURE OF APPLICANT

APPROVED BY

FOR

(KIND OF SYSTEM)

DATE

12/1/59

REJECTED BY

FOR

(KIND OF SYSTEM)

DATE

HOLD PENDING FURTHER TESTS

DATE

REASONS FOR REJECTION OR HOLDING

## THIS IS NOT A PERMIT

A 01923



# Farmer's Market

CERTIFIED

August 31, 1960

Mr. Verena A. Howison  
314 Pennsylvania Avenue, S.E.  
Washington 3, D.C.

Dear Mr. Howison:

On November 23, 1959 application was made at this office for percolation tests for a proposed Farmer's Market located in the First Election District on the Washington Boulevard near Waterloo.

On December 1, 1959 after extensive tests were conducted a small area of land was found that was suitable for underground sewage disposal. Mr. W. B. Hallett was present and signed the percolation test results at that time. A copy of the application was approved and given to your representative on the basis of not more than 100 employees would use the facilities at the Farmer's Market.

Recently, word has come to this office that a restaurant, beauty parlor, etc., might be located in the building now under construction. I think you should understand at this time that the approval granted you on December 1, 1959 did not include restaurants or any type of business that would use more than a nominal amount of water. Our approval was granted with the understanding that employees of the proposed Farmer's Market would be the only ones using the sewage facilities.

In light of the above facts we <sup>only</sup> cannot grant approval as ~~originally~~ stipulated on the original application.

Very truly yours,

Palmer F. Wine, Chief  
Sanitarian

PFW:f

HARRY C. COLWELL

VS.

WM. GLUCKIN DORSEY CORPORATION  
et al

CIRCUIT COURT

FOR

HOWARD COUNTY

Equity 7844

June 21, 1972

MR. CLERK:

Please issue summons for the following named witnesses to testify for the

defendant in the above entitled case and make the same returnable on

Monday the 26th day of June, 1972

at 10 o'clock A.M.

Mr. Roland Barth, Sr.  
Barth Contracting Company  
Clarksville Pike, Route 108  
Ellicott City, Maryland 21043

✓  
Mr. Palmer F. Wine, Director  
Howard County Department of Health  
Sanitation  
County Office Building Annex  
Ellicott City, Maryland 21043

duces tecum: Any and all information, reports, inspections  
and/or tests for percolation tests on the  
property belonging to the Wm. Gluckin Dorsey  
Corporation, A/K/A formerly the Farmer's Market,  
Route 1, Howard County, Maryland.

Bernard F. Goldberg  
Attorney for Defendant  
8370 Court Avenue  
Ellicott City, Maryland 21043  
PHONE: 465-2772

MR. SHERIFF:  
PLEASE SERVE ON ABOVE WITNESSES

*C. Merritt Pumphrey*

C. MERRITT PUMPHREY, CLERK

*filed  
6/21/72  
dcw*