

PERMIT

SEWAGE DISPOSAL SYSTEM

MARYLAND STATE DEPARTMENT OF HEALTH*

HOWARD COUNTY

04-317475

INDEXED

ELLICOTT CITY

DISTRICT 4th

DATE 10/11/78

① P.C.O.
C.B.S.

P 28999

A Repair

Final
File

Jenkins-Brethers

IS PERMITTED TO INSTALL ALTER X

ADDRESS Wallas Park, Route 144, Ellicott City, Md.

PHONE 465-6646

SUBDIVISION ROAD 2902 Route 97

LOT

PROPERTY OWNER Norman C. Hepburn

ADDRESS 2902 Route 97, Glenwood, Maryland

SPECIFICATIONS

SEPTIC TANK CAPACITY GALLONS

DRAIN FIELD DEPTH FEET, BOTTOM AREA SQ. FT.

DEEP TRENCH DEPTH FEET, BOTTOM AREA SQ. FT.

SEEPAGE PITS ABSORBENT SIDE-WALL AREA SQ. FT.

INLET PIPE FT. BELOW ORIGINAL GRADE. MAXIMUM DEPTH FT. BELOW ORIGINAL GRADE

EFFECTIVE DEPTH AT FT. BELOW ORIGINAL GRADE.

LOCATE DISPOSAL AREA FT. FROM LOT LINE AND FT. FROM LOT LINE AS SEEN WHEN
FACING LOT FROM

REPAIR - 75 ft. trench; 8 ft. to 9 ft. below original grade, with 4 ft. of stone under
pipe. Tie into existing septic tank. Use cast iron to trench. Start trench
20 to 25 ft. from second septic tank. CALL FOR INSPECTION OF TRENCH BEFORE PLACING
STONE IN TRENCH.

PLANS APPROVED BY Charles B. Streaker

DATE 10/11/78

COVER NO WORK UNTIL INSPECTED AND APPROVED.

NEITHER THE HOWARD COUNTY COUNCIL NOR THE HEALTH DEPARTMENT IS RESPONSIBLE FOR THE SUCCESSFUL OPERATION OF ANY SYSTEM.

NOTE: IF TRENCH IS USED CALL FOR INSPECTION BEFORE PLACING GRAVEL IN TRENCH.

NOTE: NO DRY WELL SHALL EXCEED 15 FOOT IN DIAMETER.

NOTE: ALL PIPE FROM HOUSE TO DISPOSAL AREA MUST BE CAST IRON.

PERMIT VOID AFTER THREE YEARS.

NOTE: INSTALL STAND PIPE ON SEPTIC TANK AND DRY WELL. STAND PIPES MUST BE 6 INCHES IN DIAMETER. CAST IRON, CONCRETE OR TERRA
COTTA ACCEPTED.

*INSTALLER IS RESPONSIBLE FOR OBTAINING FINAL APPROVAL ON THIS PERMIT.

P 28999

APPLICATION

SEWAGE DISPOSAL TESTING

STATE OF MARYLAND - DEPARTMENT OF HEALTH AND MENTAL HYGIENE

A _____

P _____

HOWARD COUNTY HEALTH DEPARTMENT
ENVIRONMENTAL HEALTH SERVICES

P.O. BOX 476 ELLICOTT, MARYLAND 21043
TELEPHONE: 992-2330

DISTRICT 4th

DATE 10/4/78

TO: THE COUNTY HEALTH OFFICER
ELLICOTT CITY, MARYLAND

I HEREBY APPLY FOR THE NECESSARY TEST IN ORDER TO CONSTRUCT (OR RECONSTRUCT) A SEWAGE DISPOSAL SYSTEM.

PROPERTY OWNER Mr. Heckburn

ADDRESS 2902 Route 97, Glenwood, Md. PHONE _____

PROPERTY LOCATION:

SUBDIVISION _____ LOT NO. _____

ROAD AND DESCRIPTION 2902 Route 97 - two stone posts at entrance - just past middle school
on Route 97

SIZE OF LOT ? TYPE BLDG. 3 bedrooms per Mr. Jenkins

THE SYSTEM INSTALLED UNDER THIS APPLICATION IS ACCEPTABLE ONLY UNTIL PUBLIC FACILITIES BECOME AVAILABLE.

I FULLY UNDERSTAND THE FEE CONNECTED WITH THE FILING OF THIS PERC TEST APPLICATION IS NON-REFUNDABLE UNDER

ANY CIRCUMSTANCES.

SIGNATURE OF APPLICANT /s/ Jenkins Brothers

APPROVED BY C. B. Bether FOR Trench in field DATE 10/10/78


REJECTED BY _____ FOR _____ DATE _____

HOLD PENDING FURTHER TESTS _____ DATE _____

REASONS FOR REJECTION OR HOLDING 10/10/78 Recommended 75' long trench 8'-9' deep with
4" of stone under pipe Two inspections of trench before & after storm.
Install line - by passing pipe. Put both corners
from 2nd Tank & going straight to trench
I gave a copy to Mr. Jenkins to go to office and get Repair permit. Stop at 1:00 clock for trench inspection

THIS IS NOT A PERMIT

Q

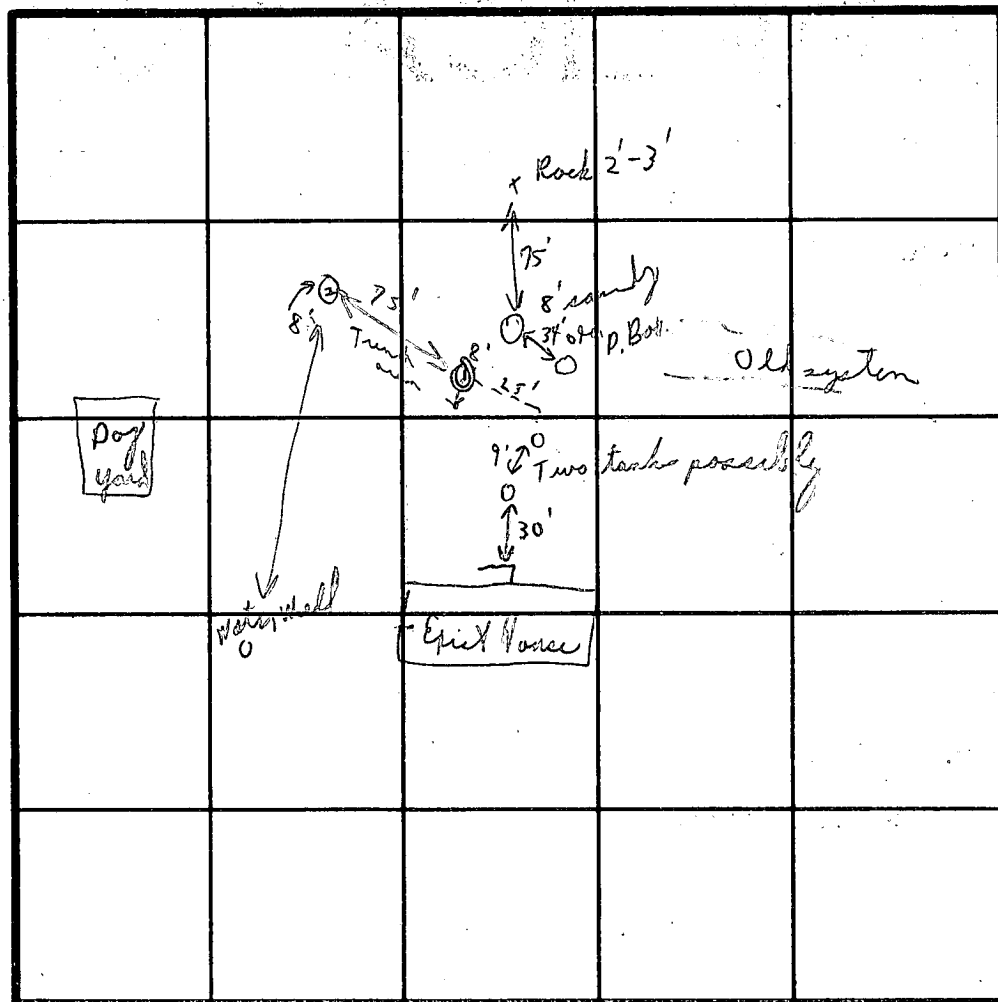

INDICATE NORTH - NAME ADJOINING ROADWAY AS BASE LINE

[illegible]

REMARKS

TYPE OF SOIL

TESTED BY

Epist. house


Vandy beam 4'-8'

C. B. A.

ALSO PRESENT

(Dry near D. Box)
Nov. 1970
Mrs. Jenkins
M. Callin
Mr. Heckburn

O. Goldsmith

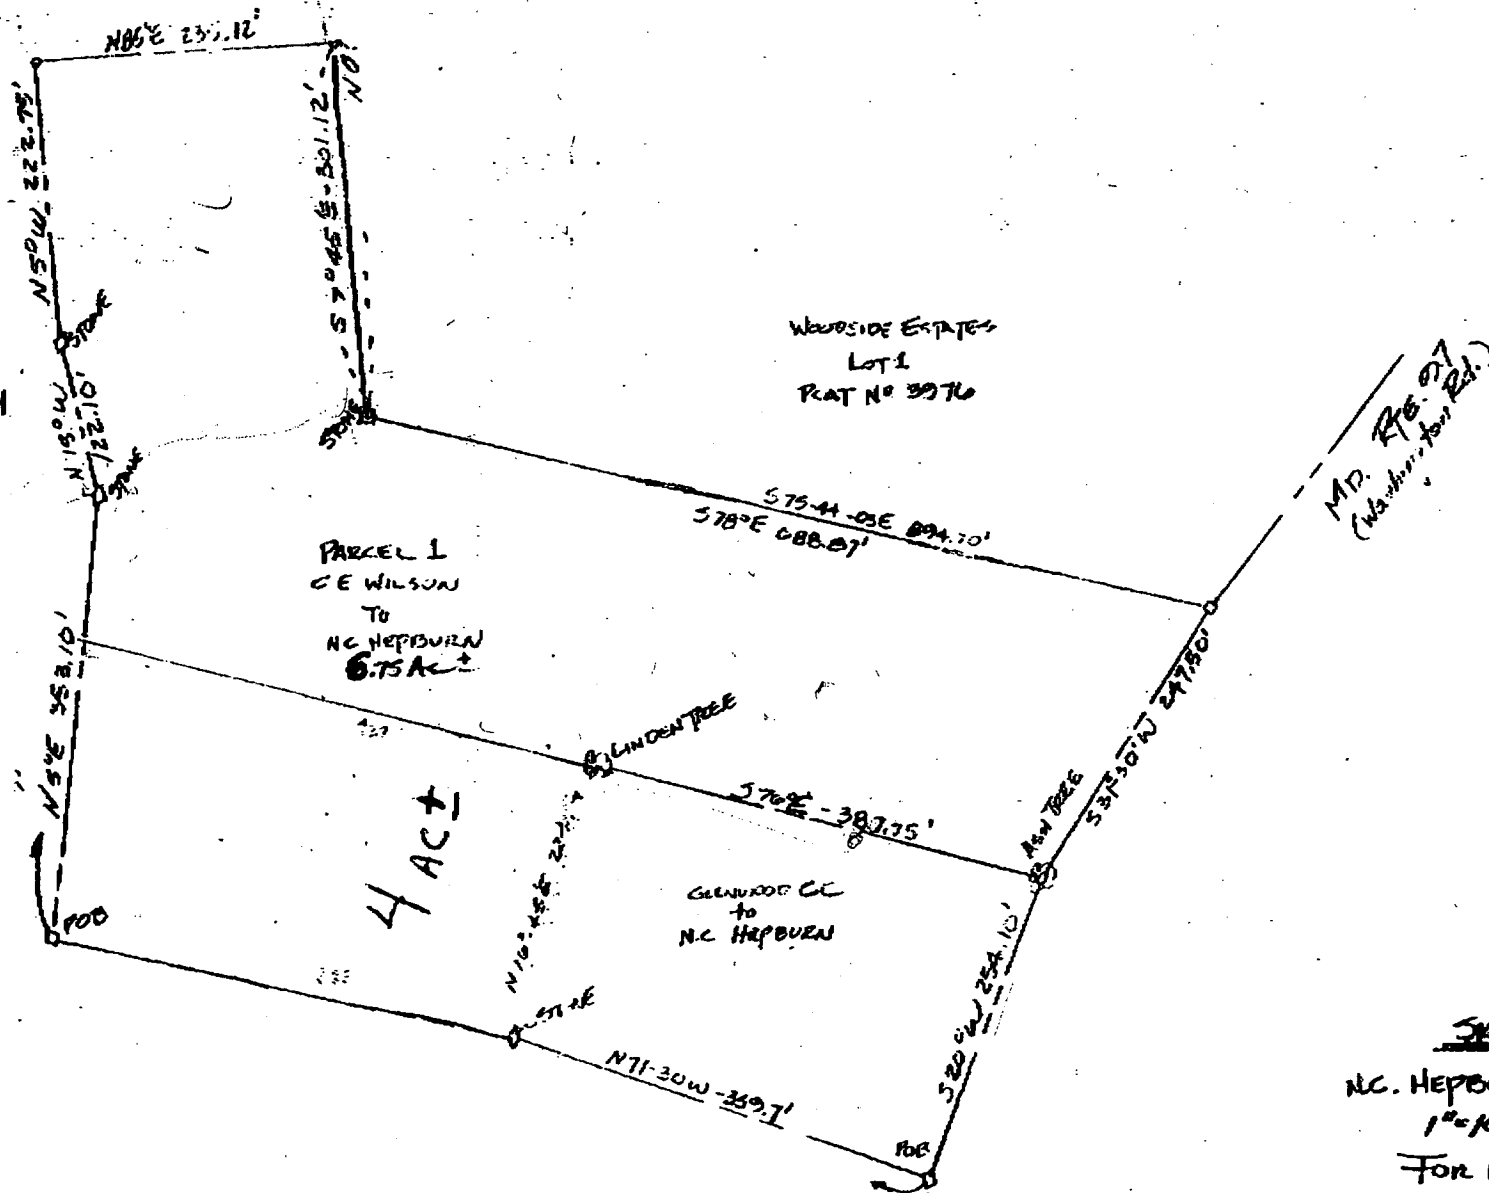

SKETCH
N.C. HEPBURN PROP (13.75 AC BY DEC
1"=100' 2/15/09
FOR MR & MRS JERVEY
CLIENT COPY