

PERMIT

SEWAGE DISPOSAL SYSTEM

DEPARTMENT OF HEALTH AND MENTAL HYGIENE

HOWARD COUNTY HEALTH DEPARTMENT

BUREAU OF ENVIRONMENTAL HEALTH

461-9933

INDEXED

NEEDS HOUSE CONNECTION

P 46994

A 29090

DISTRICT 4th

DATE 04/12/91

DATE SYSTEM APPROVED 5/2/91

INSPECTOR C.B.✓

04-320212

Arnold Backhoe & Septic Services, Inc.

IS PERMITTED TO INSTALL ☒ ALTER

ADDRESS P. O. Box 15, Woodbine, Maryland 21797

PHONE 795-7873

SUBDIVISION Jordan Property LOT ROAD 3704 Route 94

PROPERTY OWNER Helen W. Jordan

ADDRESS

SEPTIC TANK CAPACITY 1000 GALLONS

NUMBER OF BEDROOMS 3

*** INSTALLER TO REQUEST TRENCH LAYOUT INSPECTION
BEFORE INSTALLING ANY TRENCHES ***

240 SQUARE FEET PER BEDROOM

LINEAR FEET OF TRENCH REQUIRED 180

TRENCHES - Trench to be 2 feet wide. Inlet 3 feet below original grade. Bottom maximum depth 7 feet below original grade. Effective area begins at 3 feet below original grade. 4 feet of stone below distribution pipe.

LOCATION - Place the first trench along the highest edge of deeded sewage easement located just West of the driveway-in-common.

NOTE - No trench to exceed 100 feet in length. Provide 6" - 8" diameter cleanout and cap to grade or above on septic tank. 3/8/91 OK RH

PLANS APPROVED BY C. Williams

REVISED DATE 3/07/91

COVER NO WORK UNTIL INSPECTED AND APPROVED

NEITHER THE HOWARD COUNTY COUNCIL NOR THE HEALTH DEPARTMENT IS RESPONSIBLE FOR THE SUCCESSFUL OPERATION OF ANY SYSTEM

NOTE: CLEANOUT REQUIRED EVERY 70 FEET OF SEWER LINE AND/OR AT 90° SWEEPS IN LINES FROM HOUSE TO DRAIN FIELDS, 90° ELBOWS NOT ACCEPTABLE.

NOTE: ALL PARTS OF SEPTIC SYSTEMS (I.E. TANK, DISTRIBUTION BOX TRENCHES) TO BE 100 FEET FROM WELL (UNLESS OTHERWISE SPECIFICALLY AUTHORIZED)

NOTE: IF DEEP TRENCH(ES) ARE USED CALL FOR INSPECTION BEFORE AND AFTER PLACING GRAVEL IN TRENCH(ES)

NOTE: NO DRY WELL SHALL EXCEED 15 FOOT IN DIAMETER NO ABSORPTION TRENCH TO EXCEED 100 FEET IN LENGTH

NOTE: ALL PIPE FROM HOUSE TO SEPTIC TANK MUST BE CAST IRON OR SCHEDULE 35/40 PVC OR ABS

PERMIT VOID AFTER TWO YEARS

NOTE: INSTALL STAND PIPE ON SEPTIC TANK AND DRY WELL STAND PIPES MUST BE 6 INCHES IN DIAMETER CAST IRON. CONCRETE OR TERRA COTTA OR PVA OR ABS ACCEPTED. IF TOP OF SEPTIC TANK IS DEEPER THAN 3 FEET. MANHOLE TO GRADE REQUIRED.

NOTE: DISTRIBUTION BOXES MUST HAVE BAFFLES


*INSTALLER IS RESPONSIBLE FOR OBTAINING FINAL APPROVAL ON THIS PERMIT

OLD PERMIT SIGNED
AND RETURNED 2-4-98

Serial # B04109802

Close in cap
for a garage

A 29090

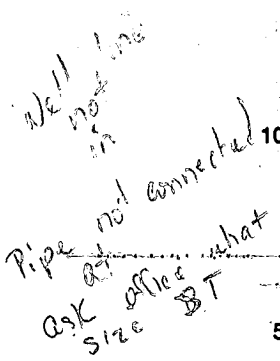

NOV 5 1971

REMARKS: 4-19-91 System installed according to specs. OK to backfill from 3" from the house to end of trenches. DB

HOUSE CONNECTION NOT SEEN.

5/2/91 Houses connection seen; ok to cover all work. Final

"SYSTEM OPEN BUT AS PER ABOVE"

1/2/91 Final - W. P. I. → Line thru wall @ basement Final -

Line 39" @ 5/2/91

DATE SYSTEM APPROVED 5/2/91 INSPECTOR Charles Benjamin

Liben 661, Folio 402 (Nov. 26, 1973)

APPLICATION

Recorded
4/4/98
9:30 A.M.

12/5/78
1:30 P.M.

SEWAGE DISPOSAL TESTING

STATE OF MARYLAND - DEPARTMENT OF HEALTH AND MENTAL HYGIENE

A 29090

P _____

HOWARD COUNTY HEALTH DEPARTMENT
ENVIRONMENTAL HEALTH SERVICES

P.O. BOX 476 ELLICOTT, MARYLAND 21043
TELEPHONE: 992-2330

DISTRICT ✓ 4TH

DATE ✓ 10/23/78

TO: THE COUNTY HEALTH OFFICER
ELLICOTT CITY, MARYLAND

992-2112-16

I, HEREBY, APPLY FOR THE NECESSARY TEST IN ORDER TO CONSTRUCT (OR RECONSTRUCT) A SEWAGE DISPOSAL SYSTEM.

PROPERTY OWNER ✓ HELEN W. JORDAN

ADDRESS ✓ 506 BAXTER AVE. ORLANDO- FLA PHONE ✓ 1-305-851-7463

PROPERTY LOCATION: (GUINEVERE WATFIELD) 32806
SISTER 3684 RTE 94 → 480-4851

SUBDIVISION ✓ none LOT NO. ✓ none

ROAD AND DESCRIPTION ✓ 1/2 mile N. OF ROUTE 94 ON PRIVATE ROAD

3704 Ellicott Road

SIZE OF LOT ✓ 3 ACRES TYPE BLDG. 3 bedrooms
1 STORY wood -
CONCRETE BLOCK

THE SYSTEM INSTALLED UNDER THIS APPLICATION IS ACCEPTABLE ONLY UNTIL PUBLIC FACILITIES BECOME AVAILABLE.

I FULLY UNDERSTAND THE FEE CONNECTED WITH THE FILING OF THIS PERC TEST APPLICATION IS NON-REFUNDABLE UNDER

ANY CIRCUMSTANCES.

SIGNATURE OF APPLICANT ✓ Helen W. Jordan (Mrs. Charles S.)

APPROVED BY JES FOR Septic System DATE 12/19/78

REJECTED BY W Monaghan FOR Septic System DATE 11-14-78

HOLD PENDING FURTHER TESTS _____ DATE _____

REASONS FOR REJECTION OR HOLDING 11/14/78 - rocks - well drilled in middle of test area

See attached ltr of 8/1/83 J.S.



BLDG. PERMIT SIGNED

AND RETURNED 3-1-98

Serial # 36590

SFD

THIS IS NOT A PERMIT

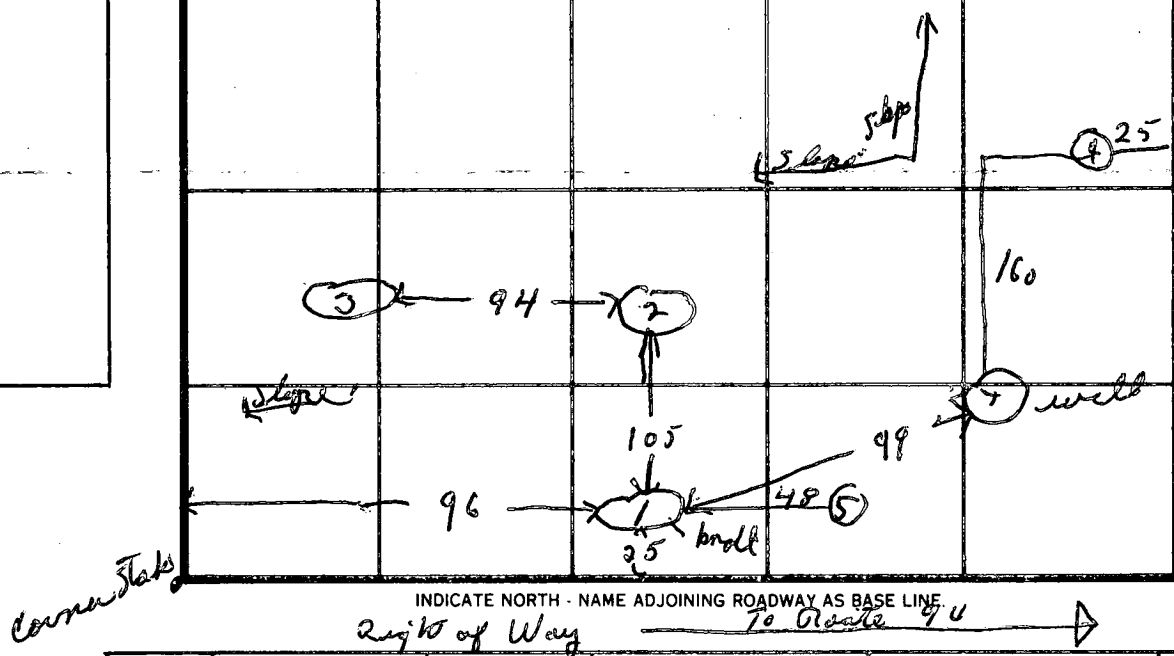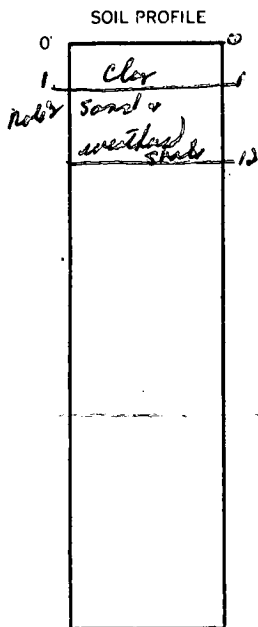


DATE	TEST NO.	DEPTH	PRE-WET		TEST - 1" DROP		TIME
			START	STOP	START	STOP	
11/14/78	1	2 ft.	Solid rock				
	2	12 ft.	10:26	10:31	10:31		
		4 ft.	10:37		step test		
	3	11 ft.	rocky				
	4	4 ft.	rock				
	5	8 ft.	rock				

REMARKS _____

TYPE OF SOIL _____

TESTED BY _____ ALSO PRESENT _____

HELEN W. JORDAN PROPERTY
(G.G. WARFIELD) 3684 RT. 94

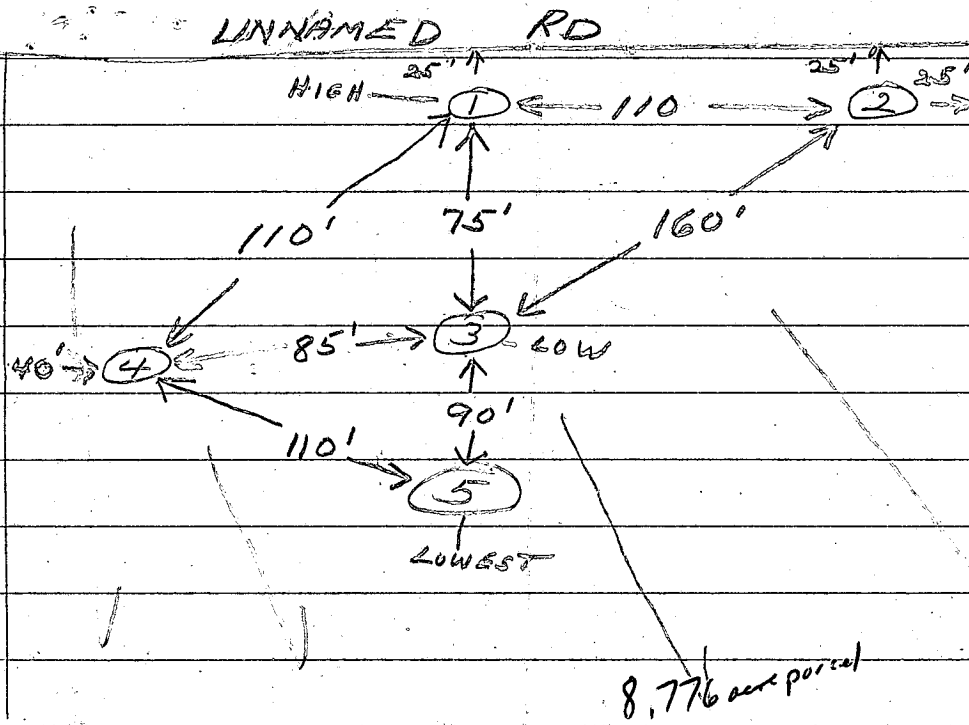

$\bar{x} = 14 \text{ min}$
240 BR
Inlet 3'
Bottom 7'

DATE	TEST No	DEPTH	START	STOP	START	STOP	TIME
12/5/78	1 S	4	1:19	1:26	1:26	1:43	17
	1 D	12	1:26	1:33	1:33	1:45	12
	2 S	4	1:38	1:45	1:45	1:50	5
	2 D	11	1:38	1:45	1:45	2:00	15
	3 S	3 1/2	2:05	2:25	2:25	2:54	29
	3 D	11	2:08	2:18	2:18	2:33	15
	4 S	4	2:15	2:22	2:22	2:34	12
	4 D	13	2:15	2:27	2:27	2:53	26
	5 S	4	2:39	2:45	2:45	2:54	9
	5 D	12 1/2	2:39	2:42	2:42	2:45	3

TESTED BY JS


ALSO PRESENT H. SARK.

SOIL PROFILE — ALL HOLES CONSISTENT

0-4-FT
CLAY


4-13 FT

CLAY, SHALEY CLAY,
LITTLE SAND

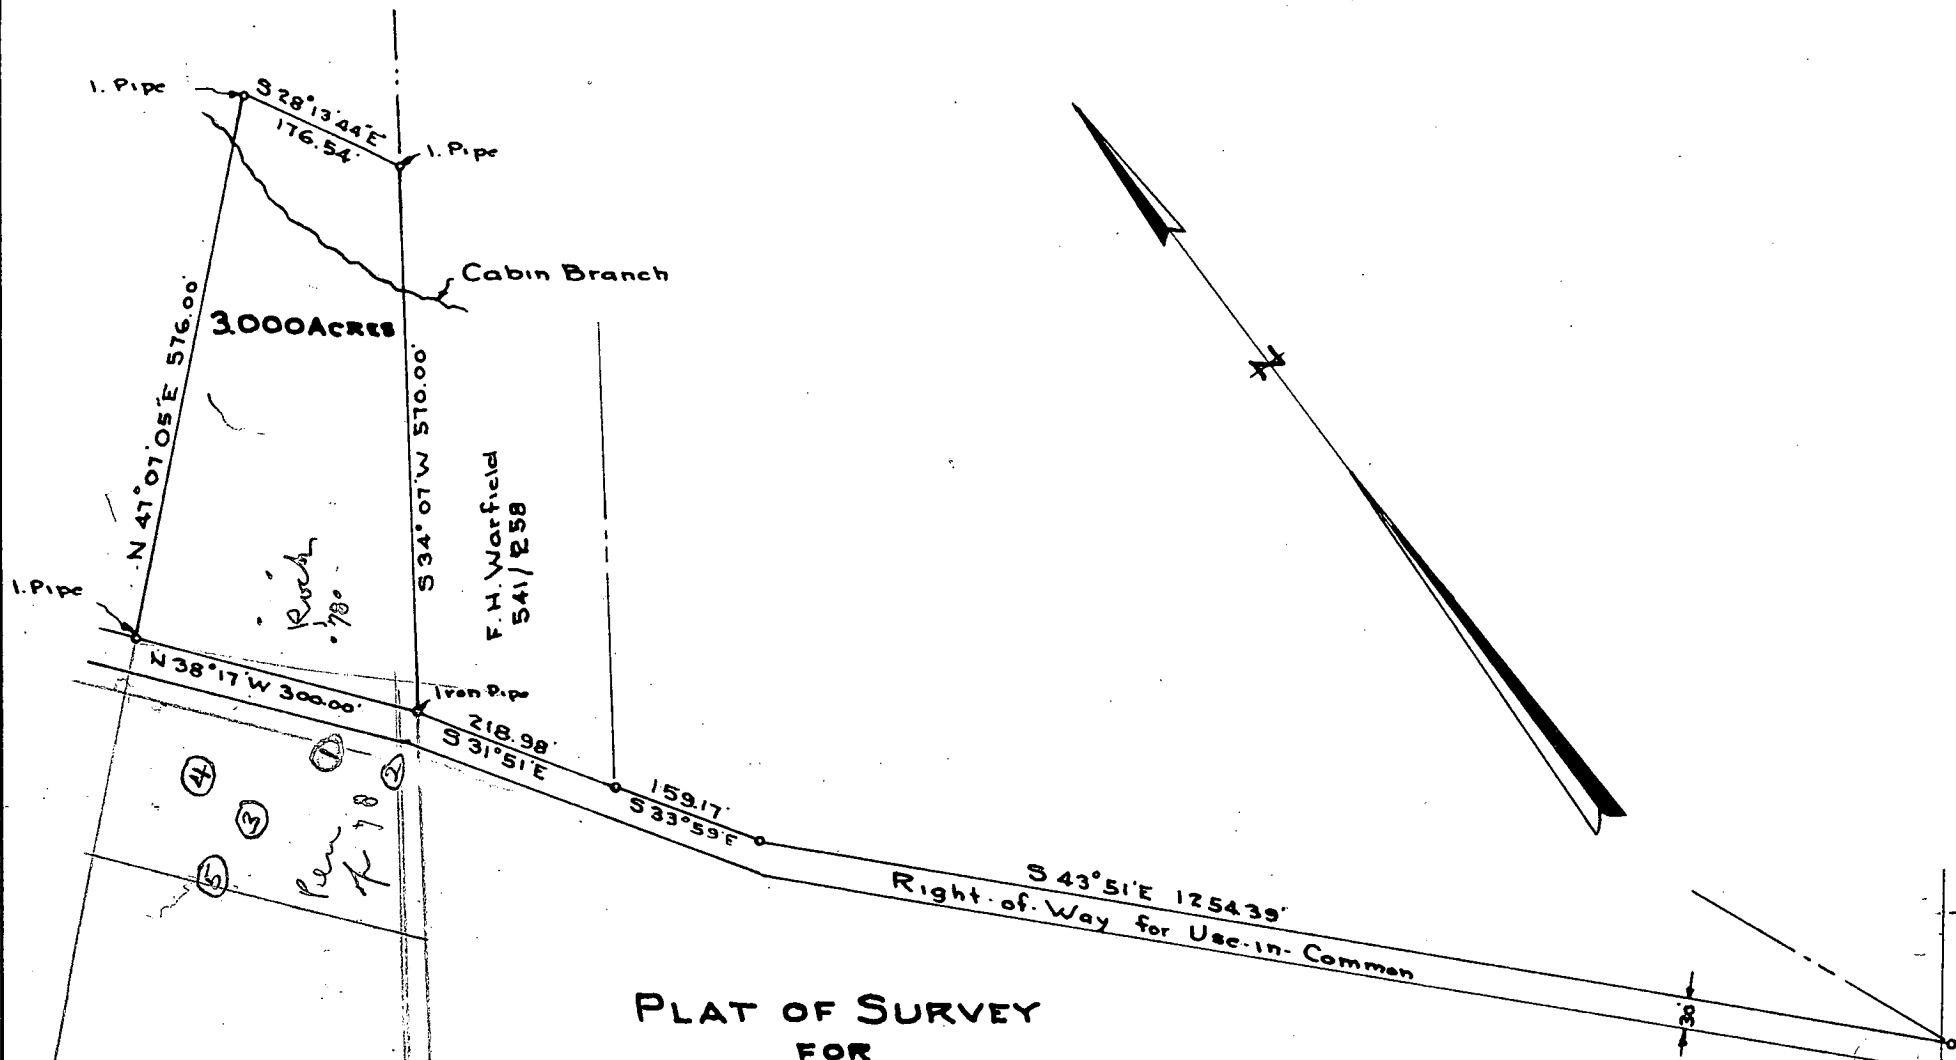

PLAT OF SURVEY
FOR
CHARLES S. JORDAN
FOURTH ELECTION DISTRICT - HOWARD COUNTY
WOODBINE, MARYLAND.
SCALE: 1 IN. = 200 FT. NOVEMBER 8, 1972

Claude M. Skinner, Jr.
Claude M. Skinner, Jr.
Reg. Professional Engineer &
Land Surveyor No. 2237

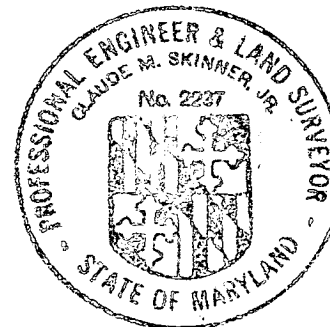

MARYLAND STATE ROUTE No. 94

HOWARD COUNTY HEALTH DEPARTMENT
Bureau of Environmental Health
3525-H Ellicott Mills Drive
Ellicott City, MD 21043
461-9933

APPLICATION FOR PITLESS ADAPTER, WELL PUMP AND PRESSURE TANK INSTALLATION

New Installation ☒
Replacement ☐

Receipt # 47027
Date 5/7/91

Name of Installer Harold W. Peterson Inc.

Telephone 301-845-8329

License Number 3229

Certified Well Pump Installer ☐ Well Driller ☐ Registered Plumber ☒

Name of Property Owner Helen W. Jordan Telephone

Subdivision Lot # Well Tag #

Site Address 3704 Ellicott Rd, Woodbine MD 21797

Pump

1. Type
 - a. Deep well jet
 - b. Shallow well jet
 - c. Submersible ☒
2. Make Griswold - Deming
3. Model # 5XLN
4. Capacity 5 GPM
5. Pump exceeds well capacity Yes ☐ No ☒
6. If Yes, is low pressure cutoff switch installed? Yes ☐ No ☐
7. What methods are used to protect the pump and electrical wiring from vibrations? Torque arrestors ☒ Cable guards ☐ Other ☐

Motor

1. Horsepower 1/2
2. RPM 3450
3. Voltage
 - a. 110
 - b. 220 ☒

Pitless Adapter Martinson

1. Make Harvard
2. Model # BCP-10X
3. Depth 48"

Tank

1. Capacity 40 gal.
2. Pressure relief valve? 1/2"

Piping

1. Type Soft Plastic
2. Size 1"
3. NSF and/or BOCA Code approved NSF
4. Depth of supply line 46

Well data

1. Depth 140 ft.
2. Yield 10 GPM
3. Static water level 40 ft.
4. Will water supply be disinfected by installer? yes

I understand that it is my responsibility to notify the Howard County Health Department when the installation is ready for inspection (otherwise this permit is null and void).

All information given above is true to the best of my knowledge.

Signature of Applicant: Harold W. Peterson


Date: 5-1-91

Note: A sticker indicating approval/status of the installation will be placed on the well casing at the time of the inspection.

RECEIVED
HOWARD COUNTY
HEALTH DEPARTMENT

R.W. REED, ET UX
L. 1397, F. 352


P.E. CRUSENBERRY, JR
ET UX
L. 680, F. 276

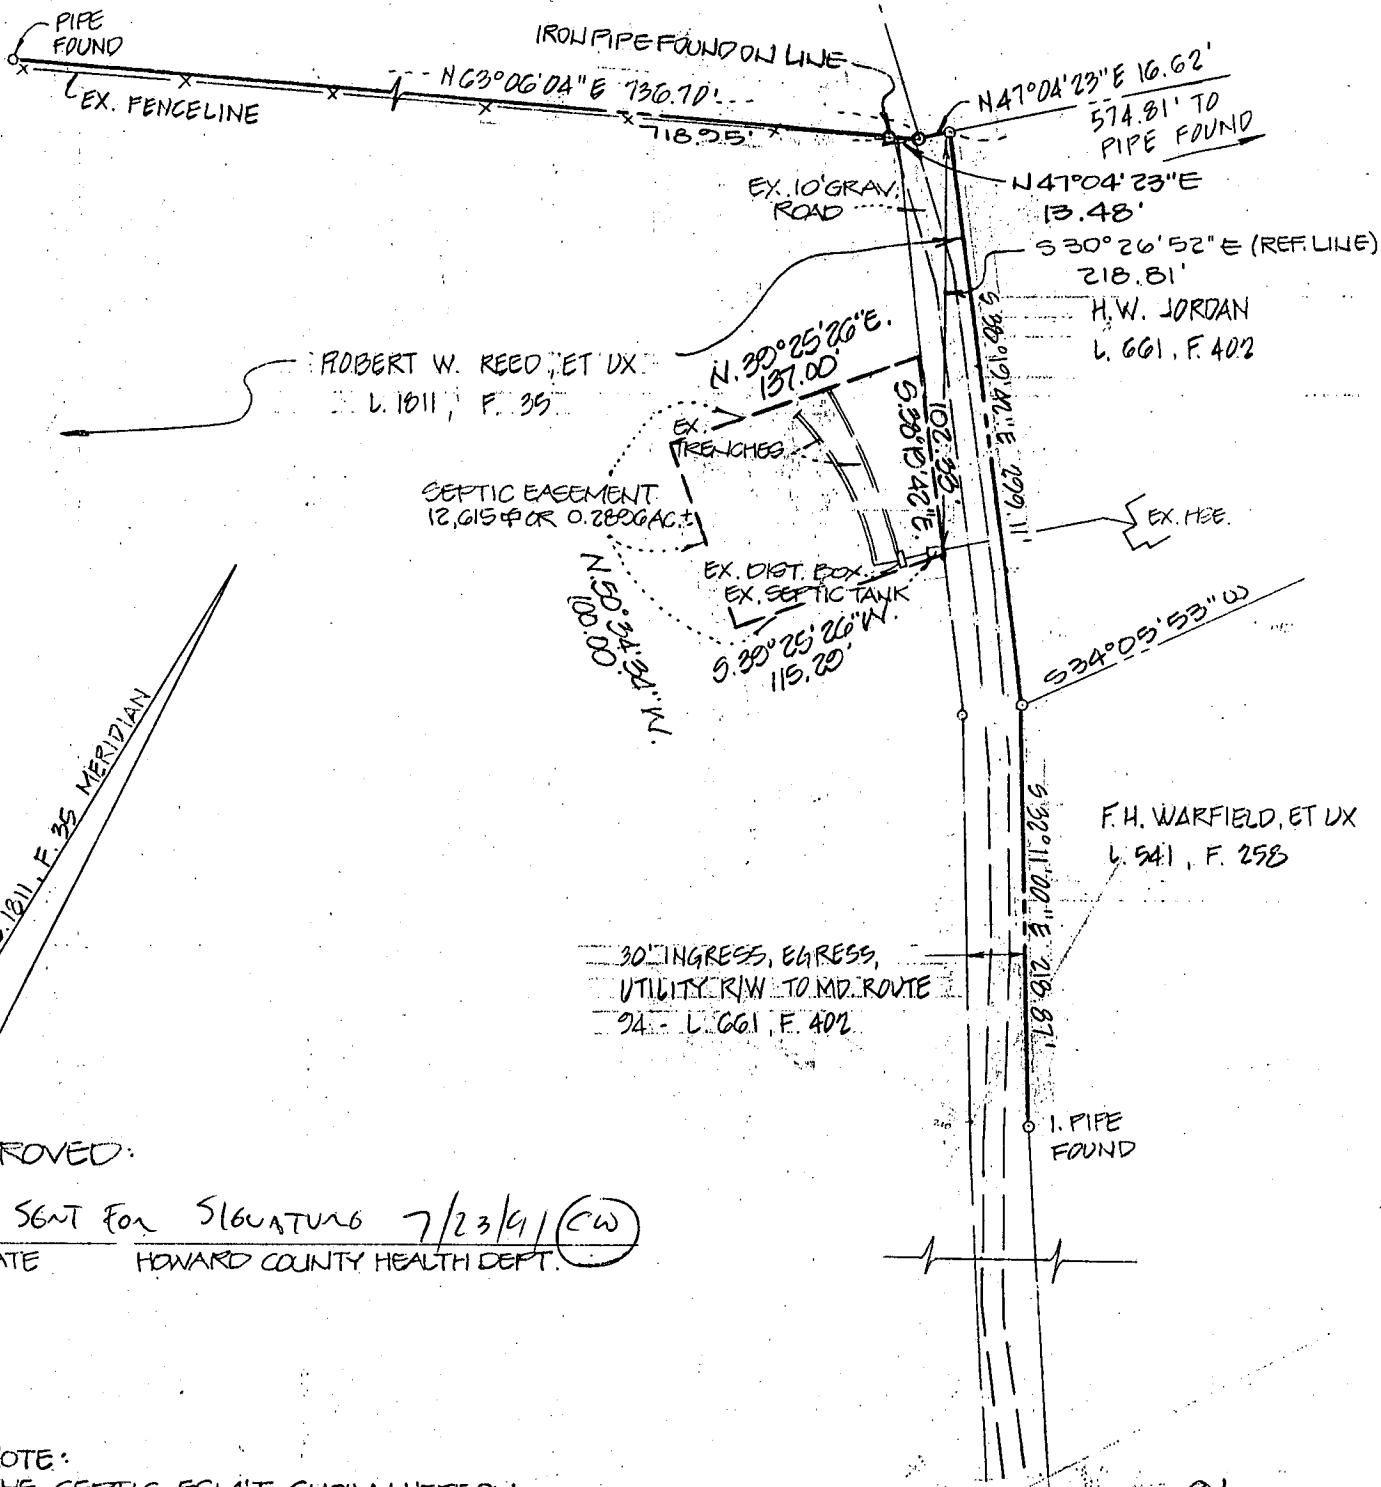

APPROVED:

SENT FOR SIGNATURE 7/23/91 (CW)
DATE HOWARD COUNTY HEALTH DEPT.

NOTE:
THE SEPTIC ESM'T. SHOWN HEREON
IS INTENDED TO SERVE THE H.W. JORDAN
PROPERTY.

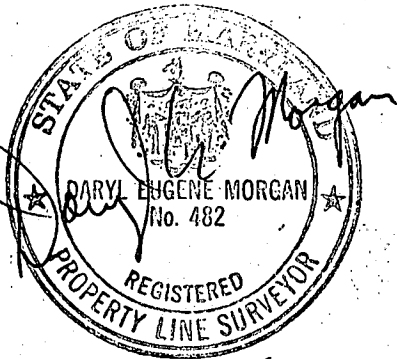

6-11-91

MARYLAND RTE 94

A PLAT TO SHOW A SEPTIC EASEMENT
ACROSS LANDS CONVEYED TO
ROBERT W. REED AND
LINDA BOYD REED
LIBER 1311, FOLIO 35
SITUATED NORTHWESTERLY OF MD. RTE. 94
TAX MAP 12, PARCEL 72
4th ELECTION DISTRICT
HOWARD COUNTY, MARYLAND
SCALE 1" = 100' JUNE 1991

I CERTIFY THIS PLAT TO BE CORRECT; IT IS THE RESULT
OF AN ACTUAL FIELD SURVEY, BASED ON DATA FOUND AMONG
THE LAND RECORDS OF HOWARD COUNTY,
MARYLAND, AS REFERENCED HEREON.

REFERENCE

JOB NO.

L. 1811, F. 35

90-2674



VANMAR
ASSOCIATES INC.
Engineers • Surveyors • Planners
310 South Main Street, Mount Airy, Maryland 21771
(301) 829-2890 (301) 831-5015

STATE OF MARYLAND WATER RESOURCES ADMINISTRATION TAWES STATE OFFICE BLDG., ANNAPOLIS, MARYLAND 21401 APPLICATION FOR PERMIT TO DRILL WELL		WRA PERMIT NUMBER HO-20-4674	
SEQUENCE NO. (WRA USE ONLY) 8191		FILL IN THIS FORM COMPLETELY	
DATE RECEIVED (WRA USE ONLY) 8/25/78 2:30 PM 1st		OWNER Landon, Charles E.	
STREET OR RFD 566 Landon Ave.		FIRST NAME Charles	
POST OFFICE Belair 3700 WOODBINE RD		LAST NAME Landon	
DRILLER INFORMATION		LOCATION OF WELL	
DATE 8/25/78		COUNTY Howard	
LICENSE NUMBER 40		SUBDIVISION 760000	
FIRST NAME Charles E.		SECTION 44	
LAST NAME Landon		LOT 46	
SIGNATURE Charles E. Landon		NEAREST TOWN 760000	
WELL INFORMATION		DIRECTION FROM TOWN	
MAXIMUM PUMPING RATE (GALLONS PER MINUTE) 600		NEAR WHAT ROAD 760000	
AVERAGE DAILY QUANTITY NEEDED (GALLONS PER DAY) 600		ON WHICH SIDE OF ROAD (CIRCLE APPROPRIATE BOX) W	
USE FOR WATER (CIRCLE APPROPRIATE BOX)		DISTANCE FROM ROAD (ENTER DISTANCE AND CIRCLE APPROPRIATE BOX) 2000	
☒ HOME (SINGLE OR DOUBLE HOUSEHOLD UNIT ONLY) ☐ FARMING, AGRICULTURE, IRRIGATION ☐ INDUSTRIAL, COMMERCIAL, STATE AND FEDERAL GOVERNMENT. ☐ MUNICIPAL WATER SUPPLY ☐ PRIVATE WATER COMPANY ☐ TEST		☐ NORTH ☒ SOUTH ☐ EAST ☐ WEST ☐ NORTHWEST ☐ SOUTHWEST	
APPROXIMATE DEPTH OF WELL 150 FEET		LOT HAS NOT BEEN PERC TESTED YET DO NOT PLAN TO BUILD FOR 3 YEARS.	
APPROXIMATE DIAMETER OF WELL 6" (NEAREST INCH)		31' - CASING 2' - ABOVE GR 29' - OPEN HOLE 6 - BAGS CEMENT	
METHOD OF DRILLING USED (CIRCLE APPROPRIATE METHOD) ☒ BORED (OR AUGERED) ☐ JETTED ☐ DRIVEN ☐ AIR-ROTARY ☐ AIR-PERCUSSION ☐ ROTARY (HYDRAULIC ROTARY) ☐ CABLE ☐ REVERSE-ROTARY ☐ DRIVE-POINT OTHER (DESCRIBE)		OK 8/25/78	
REPLACEMENT OR DEEPEINED WELLS (CIRCLE APPROPRIATE BOX) ☐ THIS WELL WILL NOT REPLACE AN EXISTING WELL ☐ THIS WELL WILL REPLACE A WELL THAT WILL BE ABANDONED AND SEALED ☐ THIS WELL WILL REPLACE A WELL THAT WILL BE USED AS A STANDBY ☐ THIS WELL WILL DEEPEIN AN EXISTING WELL PERMIT NUMBER OF WELL TO BE REPLACED OR DEEPEINED (IF AVAILABLE)		BOX NUMBER 7600 520	
NOT TO BE FILLED IN BY DRILLER (WRA USE ONLY)		HEALTH DEPARTMENT APPROVAL	
APPROPRIATION PERMIT NUMBER 54		ENGINEER REVIEW 63	
FORCE 67		CONDITIONS 70	
STATE HEALTH (CIRCLE BOX) S		COUNTY NAME Howard	
DATE 070678		COUNTY NO. N28428	
APPROVED BY Donald U. Monaghan		ELEVATION AT WELL HEAD (FEET) 65	
SPECIAL CONDITIONS 8-83 (WRA USE ONLY)		HEALTH	

C 1	3268	SEQUENCE NO. (WRA USE ONLY)	STATE OF MARYLAND WATER RESOURCES ADMINISTRATION TAWES STATE OFFICE BLDG., ANNAPOLIS, MD. 21401 WELL COMPLETION REPORT	THIS REPORT MUST BE SUBMITTED WITHIN 30 DAYS AFTER WELL COMPLETION
1 2 3 (SEQ. NO.) 6 (THIS NUMBER IS TO BE PUNCHED IN COLS. 3-6 ON ALL CARDS)		FILL IN THIS FORM COMPLETELY		
DATE RECEIVED (WRA USE ONLY)		DEPTH OF WELL 22 (TO NEAREST FOOT) 26		COUNTY NUMBER
DATE WELL COMPLETED 8/25/78		PERMIT NO. FROM "PERMIT TO DRILL WELL" 111-17-17714		28 29 30 31 32 33 34 35 36 37
8-13		DRILLERS IDENTIFICATION NO. 40		

OWNER	LAST NAME <u>Jordan</u> <u>Charles</u>	FIRST NAME <u>RELAND</u> <u>Freida</u>
STREET OR RFD	POST OFFICE	
<u>500 BARKER AVE.</u> <u>3704 WOODBINE RD</u>		

WELL LOG STATE THE KIND OF FORMATIONS PENETRATED, THEIR COLOR, DEPTH, THICKNESS AND IF WATER BEARING <table border="1" style="width:100%; border-collapse: collapse;"> <thead> <tr> <th rowspan="2">DESCRIPTION (USE ADDITIONAL SHEETS IF NECESSARY)</th> <th colspan="2">FEET</th> <th rowspan="2">CHECK IF WATER BEARING</th> </tr> <tr> <th>FROM</th> <th>TO</th> </tr> </thead> <tbody> <tr> <td>TOP SOIL</td> <td>0</td> <td>3</td> <td></td> </tr> <tr> <td>SHALE</td> <td>3</td> <td>10</td> <td></td> </tr> <tr> <td>SAND</td> <td>10</td> <td>20</td> <td></td> </tr> <tr> <td>GRAVEL</td> <td>20</td> <td>25</td> <td></td> </tr> <tr> <td>CLAY</td> <td>25</td> <td>145</td> <td></td> </tr> </tbody> </table>	DESCRIPTION (USE ADDITIONAL SHEETS IF NECESSARY)	FEET		CHECK IF WATER BEARING	FROM	TO	TOP SOIL	0	3		SHALE	3	10		SAND	10	20		GRAVEL	20	25		CLAY	25	145		GROUTING RECORD YES NO WELL HAS BEEN GROUTED (CIRCLE APPROPRIATE BOX) ☒ Y ☐ N TYPE OF GROUTING MATERIAL (CIRCLE BOX) CEMENT ☒ CM BENTONITE CLAY ☐ BC NO. OF BAGS <u>10</u> NO. OF POUNDS <u>1000</u> GALLONS OF WATER <u>30</u> DEPTH OF GROUT SEAL (TO NEAREST FOOT) FROM <u>0</u> FT. TO <u>29</u> FT. (ENTER 0 IF FROM SURFACE) CASING RECORD INSERT APPROPRIATE CODE BELOW STEEL ☐ ST CONCRETE ☐ CO PLASTIC ☐ PL OTHER ☐ OT MAIN CASING TYPE ☒ S ☐ T NOMINAL DIAMETER TOP (MAIN) CASING (NEAREST INCH) <u>60</u> TOTAL DEPTH OF MAIN CASING (NEAREST FOOT) <u>145</u> OTHER CASING (IF USED) DIAMETER (INCH) <u>60</u> DEPTH (FEET) FROM <u>60</u> TO <u>61</u> SCREEN RECORD INSERT APPROPRIATE CODE BELOW STEEL ☐ ST BRASS ☐ BR OPEN HOLE ☐ HO PLASTIC ☐ PL OTHER ☐ OT C 2 (SEQ. NO.) 6 DEPTH (NEAREST WHOLE FOOT) FROM <u>21</u> TO <u>145</u> 8 9 11 15 17 21 23 24 26 30 32 36 38 39 41 45 47 51 SLOT SIZE 1, 2, 3, <u>40</u> DIAMETER OF SCREEN <u>56</u> (NEAREST INCH) FROM <u>56</u> TO <u>60</u> GRAVEL PACK <u>68</u> IF WELL DRILLED WAS A FLOWING WELL CIRCLE BOX ☐ F WRA USE ONLY (NOT TO BE FILLED IN BY DRILLER) T ☐ 70 E.R.O.S. ☐ 72 W ☐ 74 Q ☐ 75 TELESCOPE CASING LOG INDICATOR OTHER DATA AVAILABLE	PUMPING TEST HOURS PUMPED (TO NEAREST HOUR) <u>8</u> PUMPING RATE (GALLONS PER MINUTE TO NEAREST GALLON) <u>8</u> METHOD USED TO MEASURE PUMPING RATE <u>Bucket</u> WATER LEVEL: (DISTANCE FROM LAND SURFACE) BEFORE PUMPING <u>40</u> (NEAREST FOOT) WHEN PUMPING <u>145</u> (NEAREST FOOT) TYPE OF PUMP USED (CIRCLE APPROPRIATE BOX) AIR ☒ A PISTON ☐ P TURBINE ☐ T CENTRIFUGAL ☐ C ROTARY ☐ R OTHER (DESCRIBE BELOW) ☐ O JET ☐ J SUBMERSIBLE ☐ S PUMP INSTALLED TYPE OF PUMP (WRITE APPROPRIATE LETTER IN BOX - SEE ABOVE: A, C, J, P, R, S, T, O) <u>29</u> DRILLER WILL INSTALL PUMP (CIRCLE APPROPRIATE BOX) YES ☐ NO ☐ Y CAPACITY: GALLONS PER MINUTE (TO NEAREST GALLON) <u>31</u> <u>35</u> PUMP HORSE POWER <u>37</u> <u>41</u> PUMP COLUMN LENGTH (NEAREST FOOT) <u>43</u> <u>47</u> CASING HEIGHT (CIRCLE APPROPRIATE BOX AND ENTER CASING HEIGHT) ABOVE ☒ BELOW ☐ LAND SURFACE <u>50</u> (NEAREST FOOT) LOCATION OF WELL ON LOT SHOW PERMANENT STRUCTURE SUCH AS BUILDINGS, SEPTIC TANKS, AND/OR OTHER LAND MARKS AND INDICATE NOT LESS THAN TWO DISTANCES (MEASUREMENTS TO WELL).
DESCRIPTION (USE ADDITIONAL SHEETS IF NECESSARY)		FEET			CHECK IF WATER BEARING																							
	FROM	TO																										
TOP SOIL	0	3																										
SHALE	3	10																										
SAND	10	20																										
GRAVEL	20	25																										
CLAY	25	145																										

CIRCLE APPROPRIATE BOXES ☐ A A WELL WAS ABANDONED AND SEALED WHEN THIS WELL WAS COMPLETED ☐ E ELECTRIC LOG OBTAINED ☐ P TEST WELL CONVERTED TO PRODUCTION WELL I HEREBY CERTIFY THAT I HAVE COMPLIED WITH ALL CONDITIONS STATED ON THE ABOVE-CAPTIONED "PERMIT TO DRILL WELL", AND THAT INFORMATION CONTAINED IN THIS REPORT IS TRUE, ACCURATE, AND COMPLETE TO THE BEST OF MY KNOWLEDGE, INFORMATION AND BELIEF. DRILLERS NAME (PLEASE PRINT) <u>George F. Fosterman</u> SIGNATURE <u>George A. Fosterman</u>	
---	--

SEPTIC PUMP
 PAVING OK
 DESPITE NO DETAIL
 ELEVATION
 GRAD TO SEPTIC
 AREA IS
 0.81003
 3/1/91
 CWB

SECTION
 EASEMENT 13440
 SURVEYING

INVL EL. -0.1
 FLYT. EL. 2.9

EXISTING WELL
 ELEV. 4.0

FF. ELEV 9.9
 BF. ELEV 1.0

PLOT PLAN FOR:

HELEN W. JORDAN
 L. 661 F. 402 30 80

4th ELECTION DIS. HONORARY


RL 94 BOX 3704


WOODRINE RD 21797

589-4851

I CERTIFY THE ABOVE MEASUREMENTS ARE CORRECT.

Paul D. [Signature] P.E.

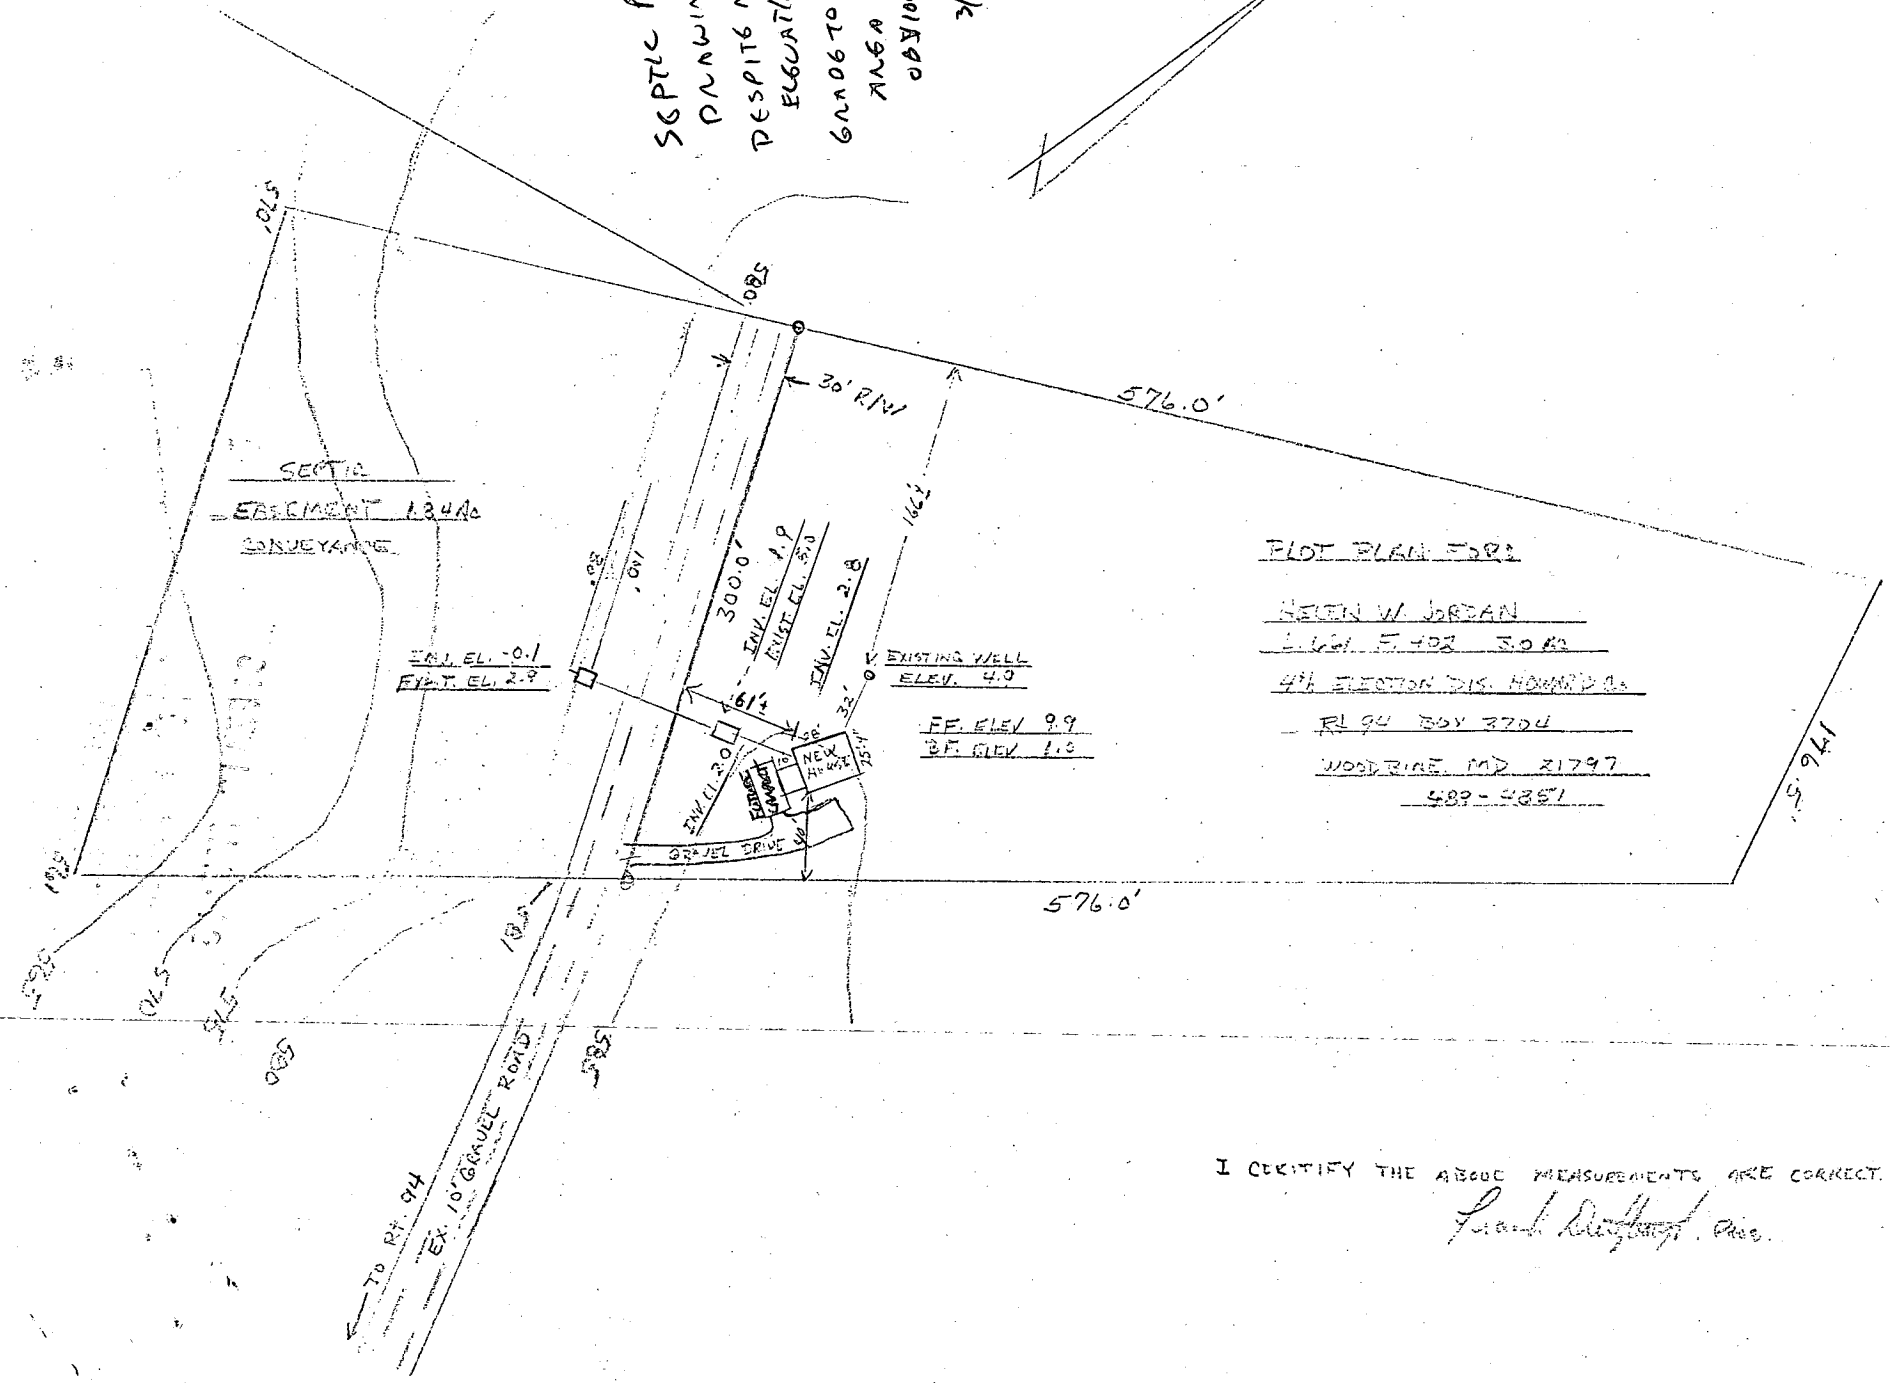

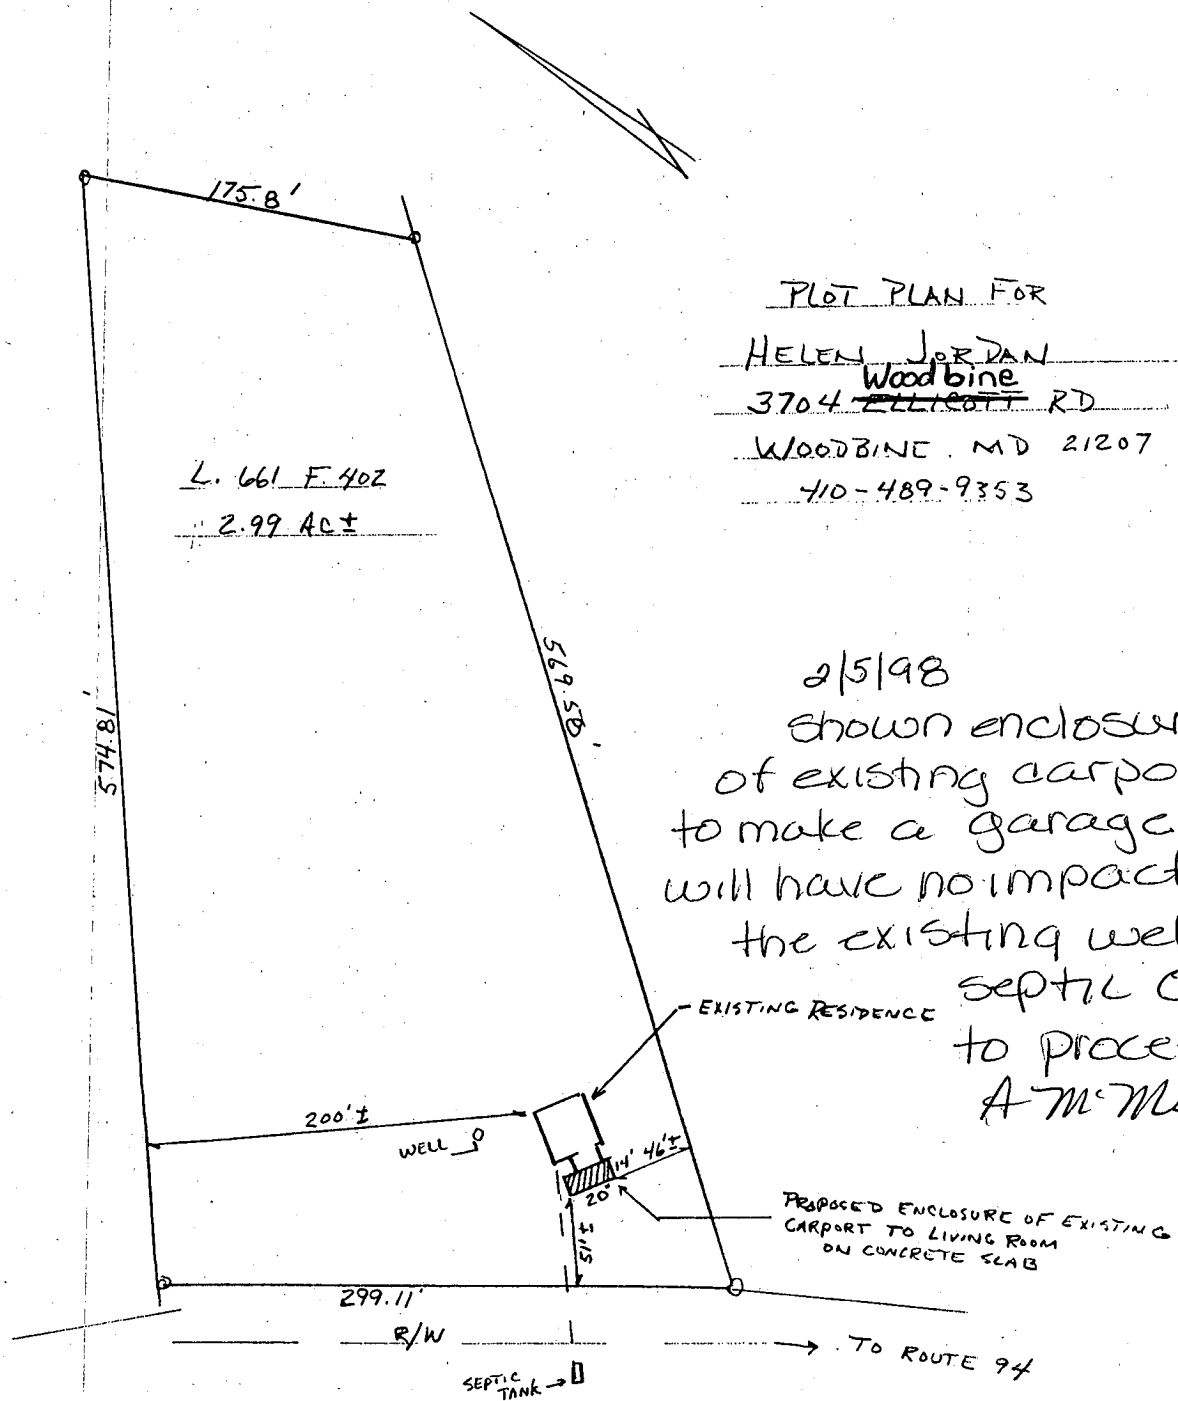

Dertzbaugh Const., Inc.
P.O. Box 476
Mt. Airy, MD 21771
(301) 865-3658