

PERMIT

SEWAGE DISPOSAL SYSTEM

MARYLAND STATE DEPARTMENT OF HEALTH

APPROVED
2/2/82
RH

P 31776
A 29159

HOWARD COUNTY

ELLICOTT CITY

DISTRICT 3rd

DATE 12/29/81

INDEX

03-307659

Charles Karfonta

IS PERMITTED TO INSTALL ☒ ALTER ☐

ADDRESS 21 Chrysler Drive, Baltimore, Md. 21228

PHONE Home: 788-9012

Work: 788-5997

SUBDIVISION Sunset Valley

ROAD

905 ~~405~~ Sunset Valley Drive LOT 1, Sec. 1

PROPERTY OWNER ~~Charles Karfonta~~ Robert M'Daniel

ADDRESS same as above

SPECIFICATIONS 3 bedrooms

SEPTIC TANK CAPACITY 1000 GALLONS

DRAIN FIELD DEPTH FEET, BOTTOM AREA SQ. FT.

DEEP TRENCH DEPTH FEET, BOTTOM AREA SQ. FT.

SEEPAGE PITS ☒ ABSORBENT SIDE-WALL AREA 190 SQ. FT. per bedroom

INLET PIPE 4 FT. BELOW ORIGINAL GRADE. MAXIMUM DEPTH 11 1/2 FT. BELOW ORIGINAL GRADE

EFFECTIVE DEPTH AT 5 FT. BELOW ORIGINAL GRADE.

LOCATE DISPOSAL AREA 26 3/4 FT. FROM front LOT LINE AND 90 1/2 FT. FROM right LOT-LINE AS SEEN WHEN

FACING LOT FROM front. (in perc hole #1)

If trench used in conjunction with dry well, to follow a constant elevation more or less toward front line.

Fred Frommelt & Charles B. Streaker

5/25/81

PLANS APPROVED BY DATE

COVER NO WORK UNTIL INSPECTED AND APPROVED.

NEITHER THE HOWARD COUNTY COUNCIL NOR THE HEALTH DEPARTMENT IS RESPONSIBLE FOR THE SUCCESSFUL OPERATION OF ANY SYSTEM.

NOTE: IF TRENCH IS USED CALL FOR INSPECTION BEFORE PLACING GRAVEL IN TRENCH.

NOTE: NO DRY WELL SHALL EXCEED 15 FOOT IN DIAMETER.

NOTE: ALL PIPE FROM HOUSE TO DISPOSAL AREA MUST BE CAST IRON.

PERMIT VOID AFTER THREE YEARS.

NOTE: INSTALL STAND PIPE ON SEPTIC TANK AND DRY WELL. STAND PIPES MUST BE 6 INCHES IN DIAMETER. CAST IRON, CONCRETE OR TERRA COTTA ACCEPTED.


*INSTALLER IS RESPONSIBLE FOR OBTAINING FINAL APPROVAL ON THIS PERMIT.

BLDG. PERMIT SIGNED
AND RETURNED 7/7/86

Snail # 71541

EH-2-1079

190
3
570

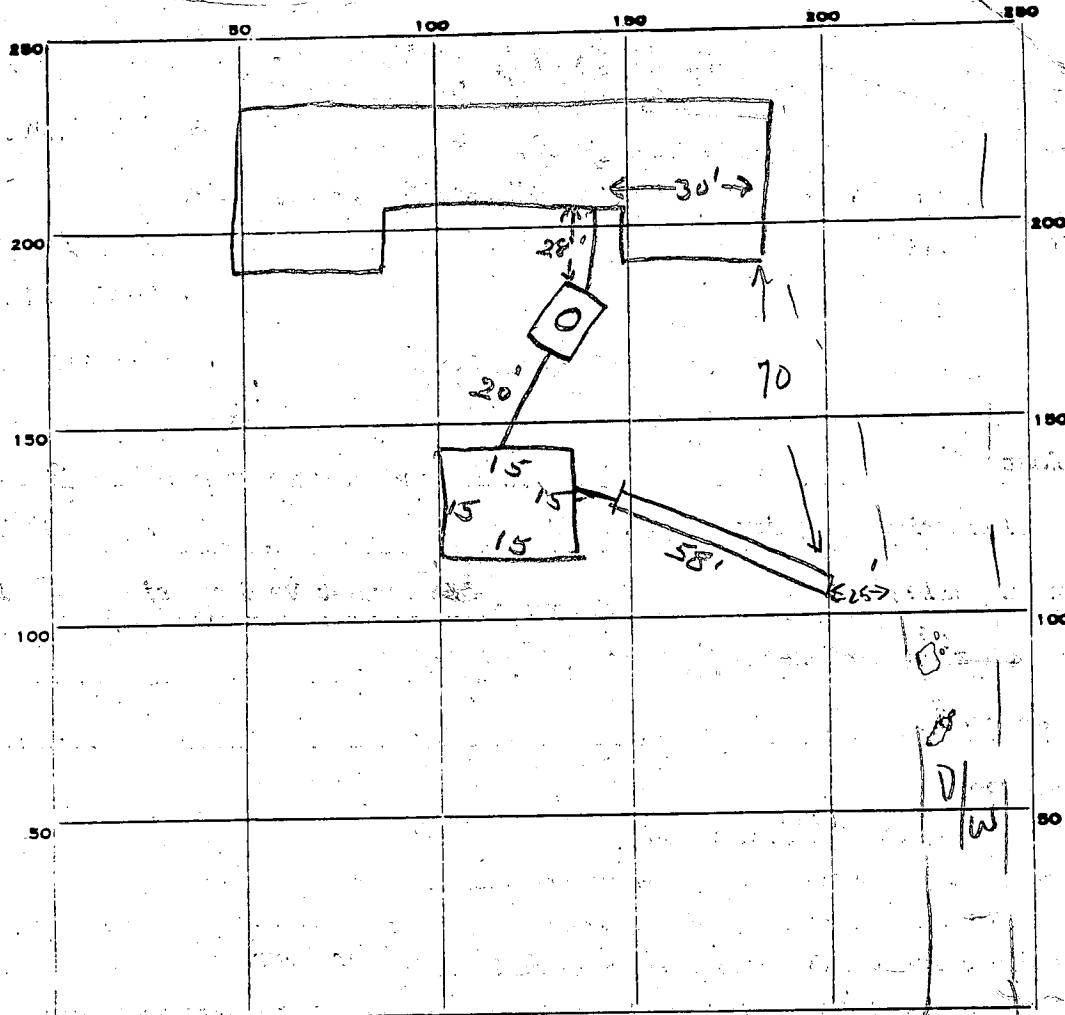

INDICATE NORTH. - NAME ADJOINING ROADWAY AS BASE LINE.

Sunset Valley Dr.

PERMIT CARD

SEPTIC TANK, LEVEL ☒

CLEANOUTS ☒ DW

DISTRIBUTION BOX, LEVEL ☒

TILE FIELD, DEPTH 13' (12'-4" fill) FT. TRENCH WIDTH 2 FT.

GRAVEL DEPTH 4 FT IN. TOTAL LENGTH 58-71 FT.

NUMBER OF TRENCHES 1 TOTAL BOTTOM AREA 284

SEEPAGE PITS, INSIDE DIAMETER 60 FT. DEPTH BELOW INLET 5 FT.

ABSORBENT AREA 300 SQ. FT.

REMARKS 1/22/82 Home connection OK. OK to cover work to septic tank. JS

1/29/82 Need 50-55 ft trench. JS-SK

2/1/82 OK to gravel trench - SK

2/2/82 AM DITCH & HORT ON ABSORBENT AREA 4250 FT

DITCH TO BE LENGTHENED 2/2/82 PM DITCH LENGTHENED R17

DATE SYSTEM APPROVED 2/2/82 INSPECTOR Raymond Thode

APPLICATION

SEWAGE DISPOSAL TESTING

STATE OF MARYLAND - DEPARTMENT OF HEALTH AND MENTAL HYGIENE

HOWARD COUNTY HEALTH DEPARTMENT
ENVIRONMENTAL HEALTH SERVICES
P.O. BOX 476 ELLICOTT, MARYLAND 21043
TELEPHONE: 992-2330

*S. tank 1000 gal.
4BR 1250 gal.*

A 29159

P _____

DISTRICT 3RD

DATE 10/12/78

*location: 20 ft from front (Sunset Valley Dr.) 110 ft
from right side line as seen from front.
Drywell inlet 4 ft. with effective area starting at 5 ft., max. total depth
1 1/2 ft. below original grade
190 sq. ft. per bedroom*

TO: THE COUNTY HEALTH OFFICER
ELLICOTT CITY, MARYLAND

I, HEREBY, APPLY FOR THE NECESSARY TEST IN ORDER TO CONSTRUCT (OR RECONSTRUCT) A SEWAGE DISPOSAL SYSTEM.

*If trench used in conjunction @ drywell, it follows a constant elev.
more or less toward rear line*

PROPERTY OWNER VIRGINIA M. GARRATT

ADDRESS FORSYTHE ROAD SYKESVILLE, MD. PHONE 301-442-2262
21784

PROPERTY LOCATION:

SUBDIVISION SUNSET VALLEY LOT NO. 1 + new 1

ROAD AND DESCRIPTION SUNSET VALLEY DRIVE

SIZE OF LOT 3.0 AC. ± TYPE BLDG. 3 bedrooms
SINGLE FAMILY RESIDENCE

THE SYSTEM INSTALLED UNDER THIS APPLICATION IS ACCEPTABLE ONLY UNTIL PUBLIC FACILITIES BECOME AVAILABLE.

I FULLY UNDERSTAND THE FEE CONNECTED WITH THE FILING OF THIS PERC TEST APPLICATION IS NON-REFUNDABLE UNDER

ANY CIRCUMSTANCES.

SIGNATURE OF APPLICANT Bruce D. Burt BLDG. PERMIT SIGNED AND RETURNED 7/20/88
Serial # 46688

APPROVED BY ? FOR ? DATE ?

REJECTED BY _____ FOR _____ DATE _____



HOLD PENDING FURTHER TESTS _____ DATE _____

REASONS FOR REJECTION OR HOLDING _____

THIS IS NOT A PERMIT

11
Final

SOIL PROFILE

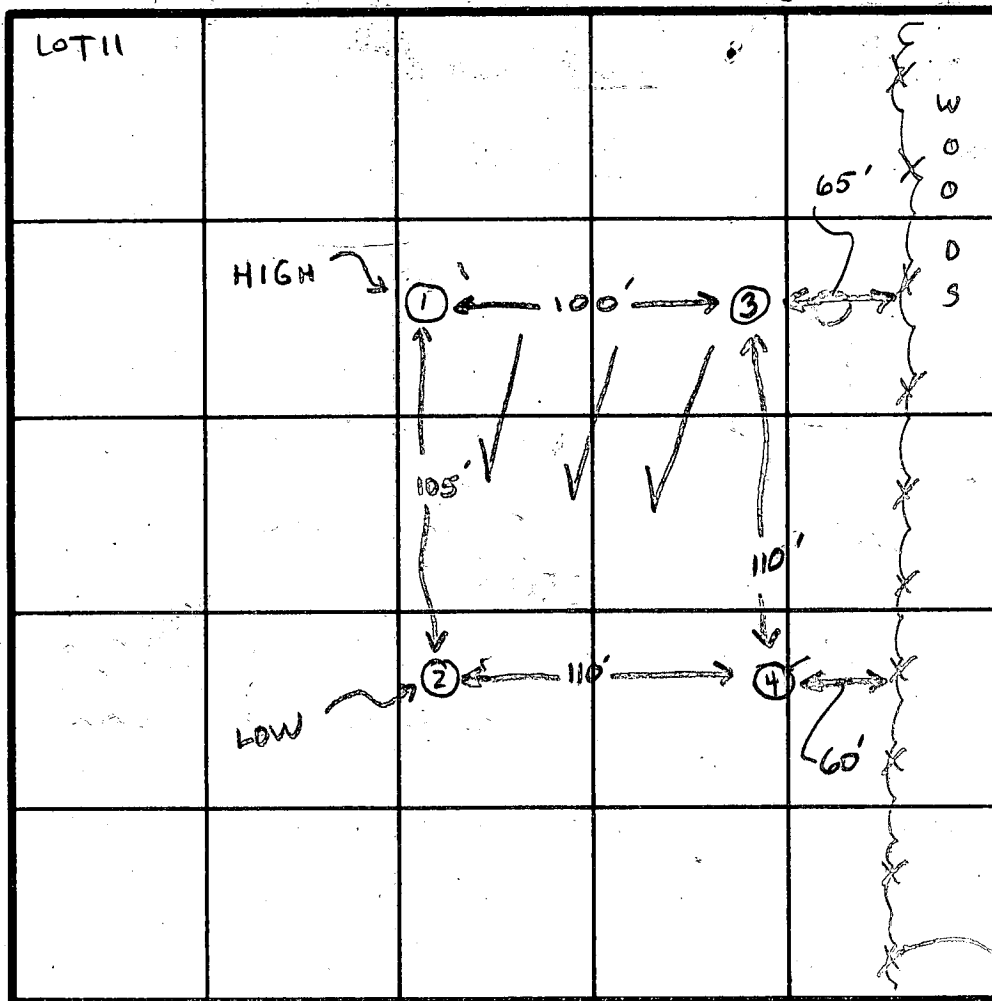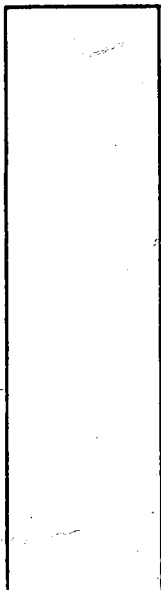

INDICATE NORTH - NAME ADJOINING ROADWAY AS BASE LINE.
Forsythe Rd

DATE	TEST NO.	DEPTH	PRE-WET		TEST - 1" DROP		TIME
			START	STOP	START	STOP	
12/17/78	15	5 1/2	231	240	240	255	29
	10	13 1/2	231	236	236	250	14
	25	6	222	226	226	235	9
	20	14'	230	249	249	310	21
	35	5 1/2	208	215	215	225	10
	30	12	VISUAL - 5 min		1" drop		1
	45	6	255	315	315	330	21
	40	13 1/2	255	309	309	330	21
30 Dec 78	4m	6 1/2'	946	956	956	1020	24

REMARKS open field tests as stated - high weeds

TYPE OF SOIL variable clay layer - silty sand below clay

TESTED BY CLK

ALSO PRESENT

B 1 6790

SEQUENCE NO.
WRA USE ONLY

STATE OF MARYLAND

APPLICATION FOR PERMIT TO DRILL WELL

WRA PERMIT NUMBER

H0-73-3668

(THIS NUMBER IS TO BE PUNCHED
IN COLS. 3-6 ON ALL CARDS)

please print or type

fill in this form completely

DATE RECEIVED

7/10/81

9:30

8 (WRA USE ONLY) 13

OWNER INFORMATION

H-788-9012
W-788-5997

KARFONTA

CHARLES

LAST NAME

OWNER

FIRST NAME

21 CHRYSLER PLACE

STREET OR RFD

BALTIMORE, MD 21228

TOWN 57 STATE 76 ZIP

B 1 CONTINUED

DRILLER INFORMATION

Ralph MAYNE

273

DRILLER'S NAME

77 LICENSE NO. 80

Ralph Mayne 7/1/81

SIGNATURE

DATE

B 2

WELL INFORMATION

APPROX. PUMPING RATE (GAL. PER MIN)

5

AVERAGE DAILY QUANTITY NEEDED (GAL. PER DAY)

500

USE FOR WATER (CIRCLE APPROPRIATE BOX)

☒ D

HOME (SINGLE OR DOUBLE HOUSEHOLD UNIT ONLY)

☐ F

FARMING (LIVESTOCK WATERING & AGRICULTURAL IRRIGATION)

☐ I

INDUSTRIAL, COMMERCIAL, STATE AND FEDERAL GOV. OTHER (REQUIRES APPROPRIATION PERMIT)

☐ P

PUBLIC OR PRIVATE WATER COMPANY (REQUIRES APPROPRIATION PERMIT AND STATE HEALTH DEPARTMENT APPROVAL)

☐ T

TEST, OBSERVATION, MONITORING (MAY REQUIRE APPROPRIATION PERMIT)

APPROXIMATE DEPTH OF WELL

150

FEET

APPROXIMATE DIAMETER OF WELL

6

NEAREST INCH

Method of Drilling (circle one)

BORED (OR AUGERED)

JETTED

JETTED & DRIVEN

30-37 AIR ROTARY

AIR PERCUSSION

ROTARY (HYDRAULIC)

CABLE

REVERSE ROTARY

DRIVE POINT

ROTARY

other

REPLACEMENT OR DEEPEINED WELLS

(Circle Appropriate Box)

☒ N

THIS WELL WILL NOT REPLACE AN EXISTING WELL

☐ Y

THIS WELL WILL REPLACE A WELL THAT WILL BE ABANDONED AND SEALED

☐ S

THIS WELL WILL REPLACE A WELL THAT WILL BE USED AS A STANDBY

☐ D

THIS WELL WILL DEEPEIN AN EXISTING WELL

PERMIT NUMBER OF WELL TO BE REPLACED OR DEEPEINED (IF AVAILABLE) 41 52

Not to be filled in by driller (WRA USE ONLY)

APPROX. PERMIT NUMBER

GAP

WRITE

FORCE ES INITIALS

CONDITIONS

H0-73-3668

B 5

SPECIAL CONDITIONS

8-63

(WRA USE ONLY)

B 3

LOCATION OF WELL

COUNTY

HOWARD

SUBDIVISION

Sunset VALLEY

SECTION

I

LOT

I

NEAREST TOWN


SYKESVILLE

MILES FROM TOWN (enter 0 if in town)

3

B 4


DIRECTION OF WELL FROM TOWN (CIRCLE BOX)

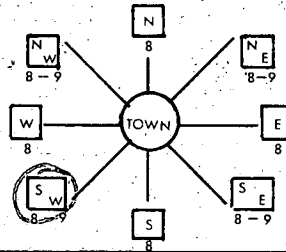

FORSYTHE Rd.

NEAR WHAT ROAD

ON WHICH SIDE OF ROAD (CIRCLE APPROPRIATE BOX)

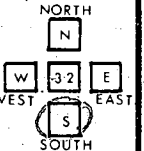

34 DISTANCE FROM ROAD (CIRCLE APPROPRIATE BOX)

600


SHOW LOCATION OF WELL WITH AN "X" IN THIS BOX

24' casing 2' abn grade
21' open
7' bcp cement

WRITE THE BOX NUMBER FROM THE MAP HERE

800 4
550 1

DRAW A SKETCH BELOW SHOWING LOCATION OF WELL IN RELATION TO NEARBY TOWNS AND ROADS AND GIVE DISTANCE FROM WELL TO NEAREST ROAD JUNCTION

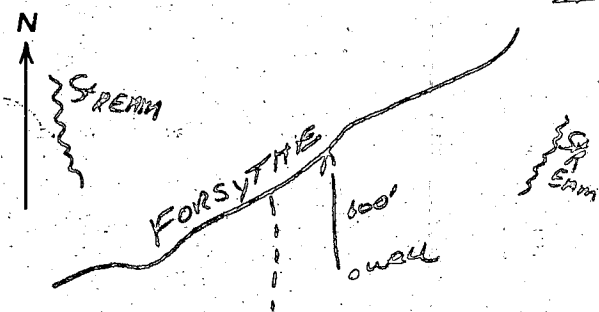

B 4

NOT TO BE FILLED IN BY DRILLER HEALTH DEPARTMENT APPROVAL

HOWARD

A29159

COUNTY NAME

COUNTY NO.

EHA SIGNATURE

STATE HEALTH CIRCLE BOX

MO DAY YR 07/10/81

CO SIGNATURE Frank Shuman

DATE 7/10/81

NORTH 551

EAST 0804

ELEV. (FT.)

GRID 50

GRID 57

GRID 65

C 1	8129	SEQUENCE NO. (WRA USE ONLY)	STATE OF MARYLAND WELL COMPLETION REPORT FILL IN THIS FORM COMPLETELY PLEASE PRINT OR TYPE	THIS REPORT MUST BE SUBMITTED WITHIN 30 DAYS AFTER WELL IS COMPLETED
THIS NUMBER IS TO BE PUNCHED IN COLS. 3-6 ON ALL CARDS				COUNTY NUMBER A 29159

Date Received (WRA use only)	July 26, 1981	DATE WELL COMPLETED	Depth of Well 205	PERMIT NO. FROM "PERMIT TO DRILL WELL" 40-73-3668
15		22		26

OWNER last name	Karfonta	first name	Charles		
STREET OR RFD	Forsythe Rd & Sunset Valley Dr	TOWN	Sykesville		
SUBDIVISION	Sunset Valley	SECTION	I	LOT	1

WELL LOG Not required for driven wells		
STATE THE KIND OF FORMATIONS PENETRATED, THEIR COLOR, DEPTH, THICKNESS AND IF WATER BEARING		
DESCRIPTION (Use additional sheets if needed)	FEET FROM TO	Check if water bearing
Top Soil	0 2	
Sandy	2 12	
Sand/Stone	12 40	
GRANITE	40 45	
Sand/Stone	45 50	✓
GRANITE	50 165	
Sand/Stone	165 120	✓
GRANITE	120 205	

GROUTING RECORD	
WELL HAS BEEN GROUTED (Circle Appropriate Box)	
TYPE OF GROUTING MATERIAL	
CEMENT ☒ CM	BENTONITE CLAY ☒ BC
NO. OF BAGS 7	NO. OF POUNDS 100
GALLONS OF WATER 42	
DEPTH OF GROUT SEAL (to nearest foot) from 0 ft to 23 ft	

CASING RECORD		
casing types insert appropriate code below	☒ ST	☒ CO
	STEEL	CONCRETE
	☒ PL	☒ OT
	PLASTIC	OTHER
MAIN CASING TYPE	Nominal diameter top(main)casing (nearest inch)	Total depth of main casing (nearest foot)
☒ ST	6	24

E A C H C A S I N G	OTHER CASING (if used)	
	diameter inch	depth (feet) from to
	☐	☐
	☐	☐

SCREEN RECORD			
screen type or openhole			
insert appropriate code below	☒ ST	☒ BR	☒ HO
	STEEL	BRASS	OPEN HOLE
	☒ PL	☒ OT	
	PLASTIC	OTHER	

C 2	Seq. no.	DEPTH (nearest ft.)
1	40	22
2		205
3		
SLOT SIZE 1 2 3		
DIAMETER OF SCREEN (NEAREST INCH)		
from to		

GRAVEL PACK				
IF WELL DRILLED WAS FLOWING WELL CIRCLE BOX ☒ F				
WRA USE ONLY (NOT TO BE FILLED IN BY DRILLER)				
T	(E.R.O.S.)			
W Q				
70	72	74	75	76
TELESCOPE CASING	LOG INDICATOR	OTHER DATA		

C 3	Seq. no.	
PUMPING TEST		
HOURS PUMPED (nearest hour)	6	
PUMPING RATE (gal. per min. to nearest gal.)	4	
METHOD USED TO MEASURE PUMPING RATE Bucker		
WATER LEVEL (distance from land surface)		
BEFORE PUMPING	45	
WHEN PUMPING	205	
TYPE OF PUMP USED (for test)		
☒ A air	☐ P piston	☐ T turbine
☐ C centrifugal	☐ R rotary	☐ O other (describe below)
☐ J jet	☐ S submersible	

PUMP INSTALLED	
DRILLER WILL INSTALL PUMP (CIRCLE APPROPRIATE BOX)	YES ☒ Y NO ☒ N
IF DRILLER INSTALLS PUMP, THIS SECTION MUST BE COMPLETED FOR ALL WELLS EXCEPT HOME USE	
TYPE OF PUMP (WRITE APPROPRIATE LETTER IN BOX - SEE ABOVE: (A, C, J, P, R, S, T, O))	
CAPACITY: GALLONS PER MINUTE (to nearest gallon)	31 35
PUMP HORSE POWER	37 41
PUMP COLUMN LENGTH (nearest ft.)	43 47
CASING HEIGHT (circle appropriate box and enter casing height)	
☒ above	LAND SURFACE
☐ below	2 (nearest foot)

LOCATION OF WELL ON LOT	
SHOW PERMANENT STRUCTURE SUCH AS BUILDING, SEPTIC TANKS, AND/OR LANDMARKS AND INDICATE NOT LESS THAN TWO DISTANCES (MEASUREMENTS TO WELL)	
well 50'	
100'	
Prob Line	

CIRCLE APPROPRIATE BOX	
☒ A	A WELL WAS ABANDONED AND SEALED WHEN THIS WELL WAS COMPLETED.
☐ E	ELECTRIC LOG OBTAINED
☐ P	TEST WELL CONVERTED TO PRODUCTION WELL
I HEREBY CERTIFY THAT I HAVE COMPLIED WITH ALL CONDITIONS STATED ON THE ABOVE-CAPTIONED "PERMIT TO DRILL WELL", AND THAT INFORMATION CONTAINED IN THIS REPORT IS TRUE, ACCURATE, AND COMPLETE, TO THE BEST OF MY KNOWLEDGE, INFORMATION AND BELIEF.	
DRILLERS IDENT. NO. 273	
DRILLERS SIGNATURE Ralph E. Mayne	
DRILLERS SIGNATURE (MUST MATCH SIGNATURE ON APPLICATION)	
SITE SUPERVISOR (sign of driller or journeyman responsible for sitework if different from permittee)	

FORSYTHE ROAD

563°45'00"E 2.26'

519°41'05"E 41.73'
R=889.81' L=71.44' 519°46'52"W 116.85'

150

140

130

467.20'

60'

120

559°08'30"E

BUILDING RESTRICTION LINE

BUILDING RESTRICTION LINE

35' DRAINAGE EASEMENT

PROP. 1250 GALLON SEPTIC TANK
EXISTING GROUND 138.00
FINISHED GRADE 136.00
INV. IN 133.36 INV. OUT 133.11

12/29/81
O.K. to put Drywell here
F.S.

N25°57'07"E

PLAN TO ACCOMPANY APPLICATION FOR BUILDING PERMIT

SUNSET VALLEY SECTION ONE LOT 1

3RD ELECTION DISTRICT HOWARD COUNTY, MD.
AUGUST 1, 1980
SCALE: 1"=50'

LOT AREA= 3.000 Ac.±

I certify the above measurements and elevations are accurate and correct for this property
Charles J. Crow
May 25, 1981

PROP. WELL
EXISTING & FINISHED GRADE 142.8

PROP. DRY WELL
EXISTING GROUND 136.5
FINISHED GRADE 136.5
INV. 132.50

8/8/80
P.M. note
8/8/80
P.M. note
8/13/80
P.M. note

8/13/80
P.M. note

8/8/80
P.M. note

8/8/80
P.M. note

