

6/10/83

Approved 6/10/83
Stager

PERMIT

SEWAGE DISPOSAL SYSTEM

MARYLAND STATE DEPARTMENT OF HEALTH

HOWARD COUNTY

BUREAU OF ENVIRONMENTAL HEALTH
992-2330

BLDG. PERMIT SIGNED
AND RETURNED 5/28/84

ELLICOTT CITY

DISTRICT 3rd.

DATE 5/25/83

INDEX

03-307913

South Carroll Plumbing and Heating

IS PERMITTED TO INSTALL ☒ ALTER

ADDRESS 4949 Old Washington Road, Sykesville, Maryland 21784 PHONE 795-4881

SUBDIVISION Sunset Valley ROAD 950 Sunset Valley Drive LOT 7, Section 1

PROPERTY OWNER Dennis M. DeHart PHONE: 256-0075

130 Chapel Towne Circle
ADDRESS Baltimore, Maryland 21236

IF GARBAGE GRINDER IS USED INCREASE SEPTIC TANK CAPACITY BY 50% AND ABSORPTION AREA BY 22%.

GARBAGE GRINDER? YES ☐ NO ☒

SEPTIC TANK CAPACITY 1000 GALLONS NUMBER OF BEDROOMS 3

Dry well - 125 sq. ft. per bedroom. Inlet 4 feet below original grade. Bottom maximum depth 11 feet below original grade. Effective area begins at 4 feet below original grade.
NOTE: If trench is used to make up absorbent area, run the trench on level ground and leave a 5 foot earth buffer between dry well and trench. No trench is to exceed 100 feet in length. Trench inlet to be same as dry well, with 7 feet of stone below distribution pipe.

5/31/83 Trench on. see spec on attached sheet P.S. 6/6/changed see below
6/6/83 HIT ROCK TRENCH TO BE 9'x10' DEEP FILLED
WITH 5 FT STONE & 100 FT LONG
PUT DITCH IN ARG BETWEEN HIGH PERC HOLES
#1 & #2

PLANS APPROVED BY Raymond Hodges

DATE 3/10/83

COVER NO WORK UNTIL INSPECTED AND APPROVED.

NEITHER THE HOWARD COUNTY COUNCIL NOR THE HEALTH DEPARTMENT IS RESPONSIBLE FOR THE SUCCESSFUL OPERATION OF ANY SYSTEM.

NOTE: IF TRENCH IS USED CALL FOR INSPECTION BEFORE AND AFTER PLACING GRAVEL IN TRENCH.

NOTE: NO DRY WELL SHALL EXCEED 15 FOOT IN DIAMETER. NO ABSORPTION TRENCH TO EXCEED 100 FEET IN LENGTH.

NOTE: ALL PIPE FROM HOUSE TO SEPTIC TANK MUST BE CAST IRON OR SCHEDULE 40 PVC OR ABS.

PERMIT VOID AFTER THREE YEARS.

NOTE: INSTALL STAND PIPE ON SEPTIC TANK AND DRY WELL. STAND PIPES MUST BE 6 INCHES IN DIAMETER. CAST IRON, CONCRETE OR TERRA COTTA, OR PVC OR ABS ACCEPTED. IF TOP OF SEPTIC TANK IS DEEPER THAN 3 FEET MANHOLE TO GRADE REQUIRED.

*INSTALLER IS RESPONSIBLE FOR OBTAINING FINAL APPROVAL ON THIS PERMIT

*CALL 992-2330 FOR INSPECTION OF SEPTIC SYSTEMS.


EH - 2-1082

PERC HOLE #2 IS LOCATED 300 FT FROM JASON LANE PROP
LINE & 110 FROM SUNSET VALLEY PROP LINE

15' 4" BR
3
474
71

PERC HOLE #1 IS LOCATED 200 FT
FROM JASON LANE
PROPERTY LINE &
147 FT from
SUNSET VALLEY
PROP LINE

29163

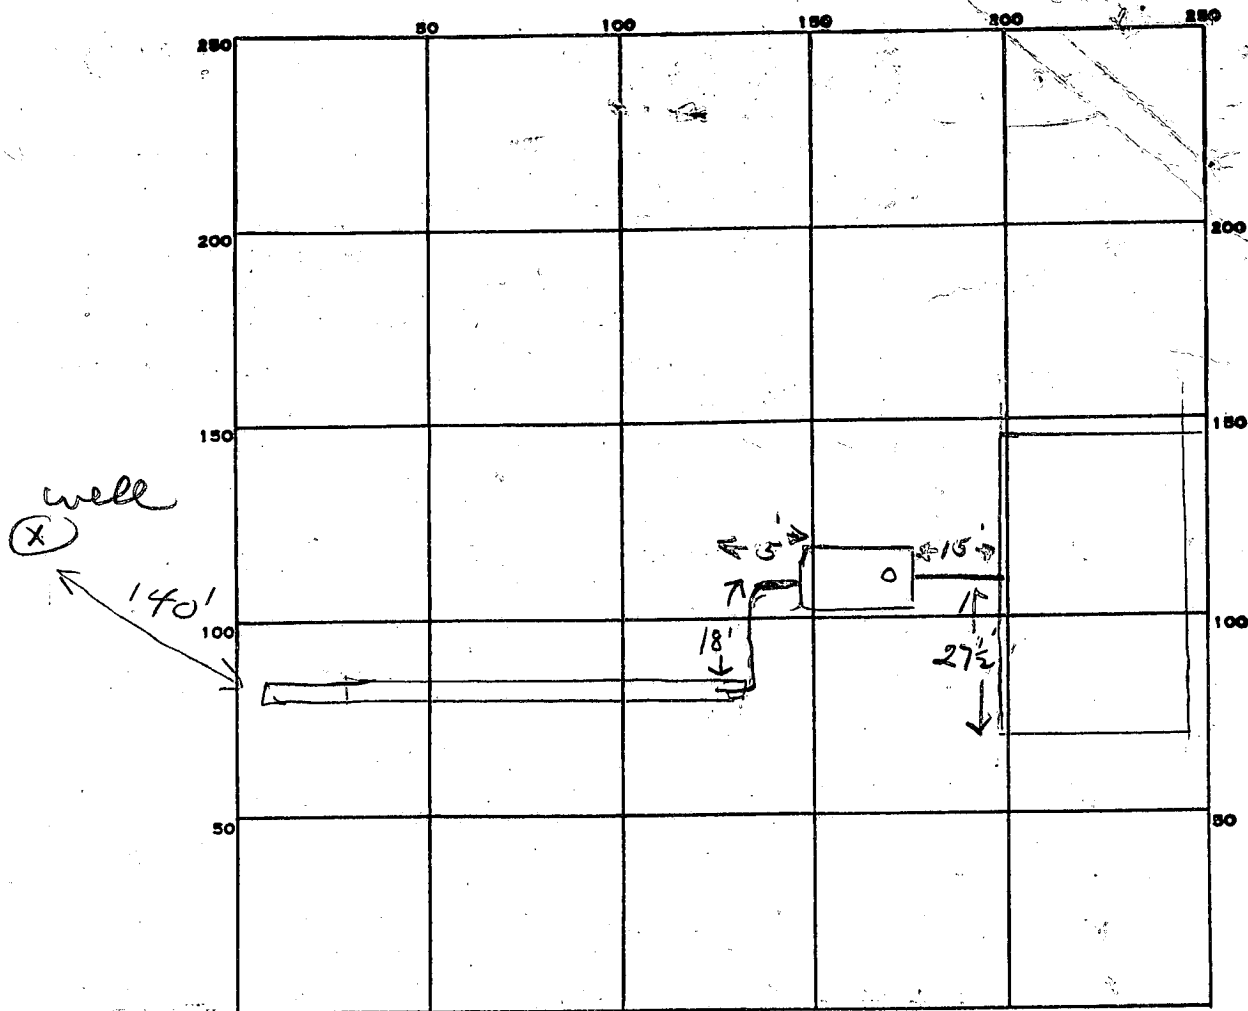

INDICATE NORTH. - NAME ADJOINING ROADWAY AS BASE LINE.

Sunset Valley DR

PERMIT CARD _____

SEPTIC TANK, LEVEL 2

1000 gal

CLEANOUTS ST

DISTRIBUTION BOX, LEVEL _____

TILE-FIELD, DEPTH 9

FT.

TRENCH WIDTH 2

FT.

GRAVEL DEPTH 5

IN.

TOTAL LENGTH 100

FT.

NUMBER OF TRENCHES 1

TOTAL BOTTOM AREA 500

SEEPAGE PITS, INSIDE DIAMETER _____

FT.

DEPTH BELOW INLET _____

FT.

ABSORBENT AREA 500

SQ. FT.

REMARKS

6/7/83 VISITED SITE & CHANGED SPECS BECAUSE ROCK
AT 7 FT. RH. 6/8/83 OK to add stone in trench. JS
6/10/83 OK to cover all work JS

DATE SYSTEM APPROVED 6/10/83

INSPECTOR Stayer

PERMIT

SEWAGE DISPOSAL SYSTEM

MARYLAND STATE DEPARTMENT OF HEALTH

P 32803

A 29162

HOWARD COUNTY
BUREAU OF ENVIRONMENTAL HEALTH
992-2330

ELLICOTT CITY
DISTRICT 3rd.

DATE 5/25/83

South Carroll Plumbing and Heating IS PERMITTED TO INSTALL ☒ ALTER ☐

ADDRESS 4949 Old Washington Road, Sykesville, Maryland 21784 PHONE 795-4881

SUBDIVISION Sunset Valley ROAD 950 Sunset Valley Drive LOT 7, Section 1

PROPERTY OWNER Dennis M. DeHart PHONE: 256-0075

ADDRESS 130 Chapel Towne Circle
Baltimore, Maryland 21236

IF GARBAGE GRINDER IS USED INCREASE SEPTIC TANK CAPACITY BY 50% AND ABSORPTION AREA BY 22%.

GARBAGE GRINDER? YES ☐ NO ☒

SEPTIC TANK CAPACITY 1000 GALLONS NUMBER OF BEDROOMS 3

Dry well - 125 sq. ft. per bedroom. Inlet 4 feet below original grade. Bottom maximum depth 11 feet below original grade. Effective area begins at 4 feet below original grade.

NOTE: If trench is used to make up absorbent area, run the trench on level ground and leave a 5 foot earth buffer between dry well and trench. No trench is to exceed 100 feet in length. Trench inlet to be same as dry well, with 7 feet of stone below distribution pipe.

5/31/83 OK to use one trench 11' deep, 2' wide, 75' long, inlet @ 4', 7' stone below inlet pipe.
Locate trench about 160' from (and parallel to) the right sideline, as seen when
facing the lot from Sunset Valley Drive, S.E.

changed because of P or R

PLANS APPROVED BY Raymond Hodges DATE 3/10/83

COVER NO WORK UNTIL INSPECTED AND APPROVED.

NEITHER THE HOWARD COUNTY COUNCIL NOR THE HEALTH DEPARTMENT IS RESPONSIBLE FOR THE SUCCESSFUL OPERATION OF ANY SYSTEM.

NOTE: IF TRENCH IS USED CALL FOR INSPECTION BEFORE AND AFTER PLACING GRAVEL IN TRENCH.

NOTE: NO DRY WELL SHALL EXCEED 15 FOOT IN DIAMETER. NO ABSORPTION TRENCH TO EXCEED 100 FEET IN LENGTH.

NOTE: ALL PIPE FROM HOUSE TO SEPTIC TANK MUST BE CAST IRON OR SCHEDULE 40 PVC OR ABS.

PERMIT VOID AFTER THREE YEARS.

NOTE: INSTALL STAND PIPE ON SEPTIC TANK AND DRY WELL. STAND PIPES MUST BE 6 INCHES IN DIAMETER. CAST IRON, CONCRETE OR TERRA COTTA, OR PVC OR ABS ACCEPTED. IF TOP OF SEPTIC TANK IS DEEPER THAN 3 FEET MANHOLE TO GRADE REQUIRED.


***INSTALLER IS RESPONSIBLE FOR OBTAINING FINAL APPROVAL ON THIS PERMIT**

92-2330 FOR INSPECTION OF SEPTIC SYSTEMS.

EH - 2-1082

SUBDIVISION: SUNSET VALLEY LOT #7 SECT. 1
 PERMIT NO: 52985
 JAMES L. TOPPER -
 BUILDER.

ELEVATION OF SEPTIC SYSTEM
 DENNIS & MARY DEHART
 950 SUNSET VALLEY DRIVE
 SYKESVILLE MD. 21784

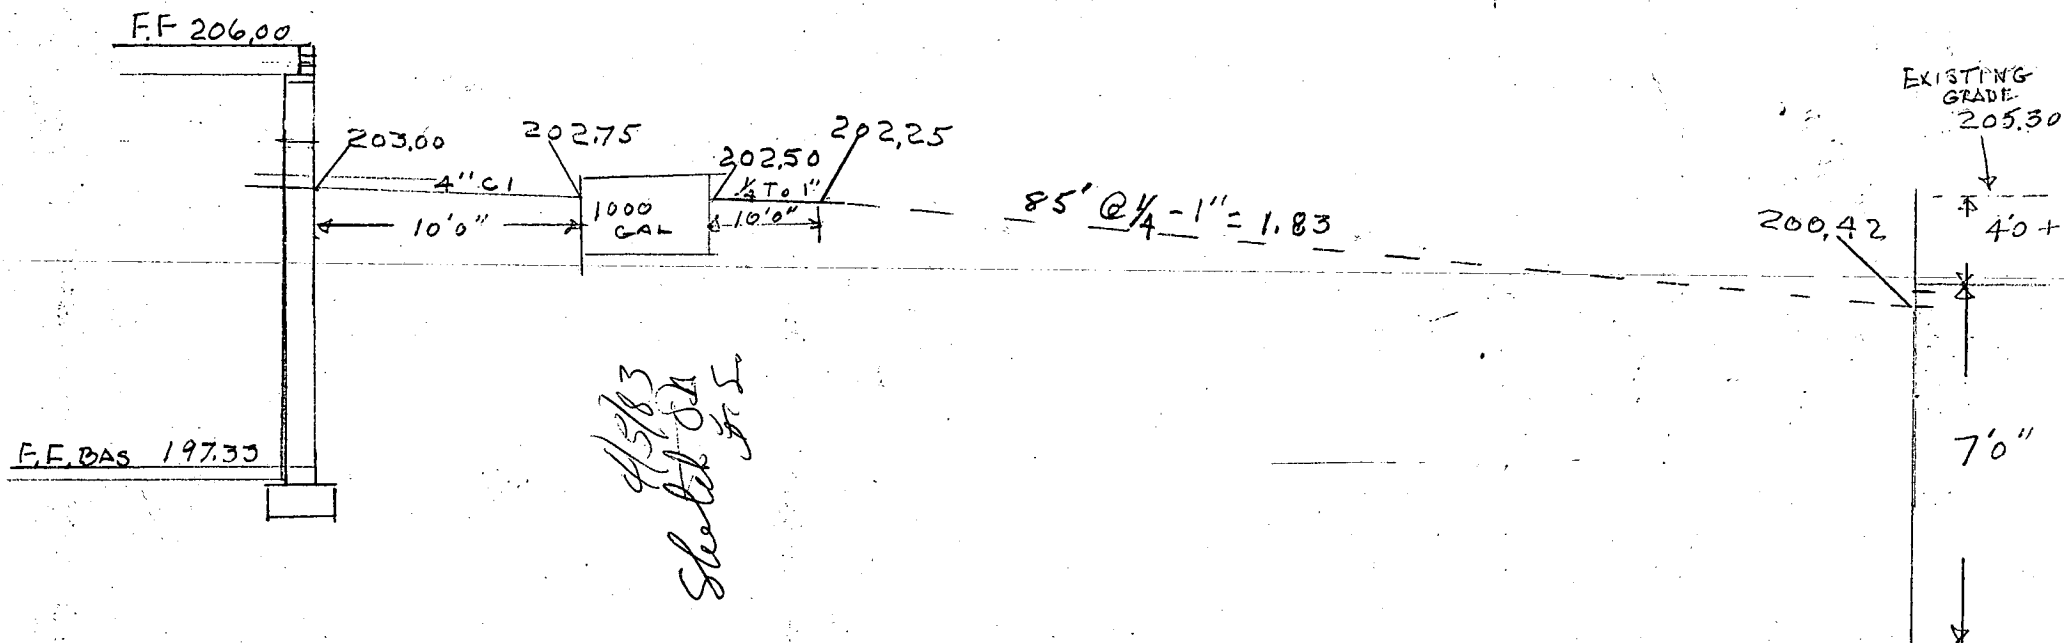

447-2662

EMERGENCY/TEMP NO. IF ANY

B 1 **1991** SEQUENCE NO. **5/5/83** STATE OF MARYLAND
(OEP USE ONLY) **10-3hr P.T. PERMIT TO DRILL WELL**
11-Grout please print or type

OEP PERMIT NUMBER

H0-81-0073

fill in this form completely

Date Received

04/18/83

OWNER INFORMATION

DEHART DENNIS HARRY**130 CHAPEL TOWNE CL****BALTIMORE MD 21236**

DRILLER INFORMATION

Justin Harver **194****Justin Harver Well Drilling Inc.****9125 Bethel RD. Fred****Justin Harver** **04-13-83**

WELL INFORMATION

APPROX. PUMPING RATE (GAL. PER MIN.) **2**AVERAGE DAILY QUANTITY NEEDED (GAL. PER DAY) **800**

USE FOR WATER (CIRCLE APPROPRIATE BOX)

- ☒ HOME (SINGLE OR DOUBLE HOUSEHOLD UNIT ONLY)
☐ FARMING (LIVESTOCK WATERING & AGRICULTURAL IRRIGATION)
☐ INDUSTRIAL, COMMERCIAL, STATE AND FEDERAL GOV. OTHER (REQUIRES APPROPRIATION PERMIT)
☐ PUBLIC OR PRIVATE WATER COMPANY (REQUIRES APPROPRIATION PERMIT AND STATE HEALTH DEPARTMENT APPROVAL)
☐ TEST, OBSERVATION, MONITORING (MAY REQUIRE APPROPRIATION PERMIT)

APPROXIMATE DEPTH OF WELL **100** FEETAPPROXIMATE DIAMETER OF WELL **6** INCH

METHOD OF DRILLING (circle one)

BORED (or Augered) ☒ JETTED ☐ Jetted & DRIVENAIR-ROTary ☒ AIR-PERCussion ☐ ROTARY (Hydraulic Rotary)CABLE ☐ REVERSE-ROTary ☐ Drive-POINT

other

REPLACEMENT OR DEEPEMED WELLS (CIRCLE APPROPRIATE BOX)

- ☒ THIS WELL WILL NOT REPLACE AN EXISTING WELL
☐ THIS WELL WILL REPLACE A WELL THAT WILL BE ABANDONED AND SEALED
☐ THIS WELL WILL REPLACE A WELL THAT WILL BE USED AS A STANDBY
☐ THIS WELL WILL DEEPEMED AN EXISTING WELL

PERMIT NUMBER OF WELL TO BE REPLACED OR DEEPEMED (IF AVAILABLE)

Not to be filled in by driller (OEP USE ONLY)


APPROP. PERMIT NUMBER **GAP**FORCE **FS** WRITE INITIALS IN BOX PERMIT No. **H0-81-0073**

SPECIAL CONDITIONS


LOCATION OF WELL

HOWARD**SUNSET VALLEY**SECTION **1** LOT **7****SYKEVILLE**MILES FROM TOWN (enter 0 if in town) **2** MI

DIRECTION OF WELL FROM TOWN (CIRCLE BOX)

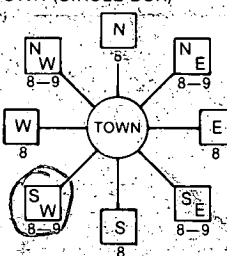**Forsythe**

ON WHICH SIDE OF ROAD (CIRCLE APPROPRIATE BOX)

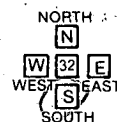

DISTANCE FROM ROAD

ENTER FT or MI **MI**

NOT TO BE FILLED IN BY DRILLER HEALTH DEPARTMENT APPROVAL

HOWARD**A 29162**

COUNTY NAME

COUNTY NO.

OEP SIGNATURE

STATE HEALTH

DATE ISSUED

INSERT S

042683**Frank Skinner 10/26/83**

CO SIGNATURE

EXP. DATE

NORTH GRID **550000**EAST GRID **0805000**

SHOW MAJOR FEATURES OF BOX & LOCATE WELL WITH AN X

SOURCES OF DRILLING WATER

1. well


2.

3.

WRITE THE BOX NUMBER FROM THE MAP HERE

E **800-5**
N **550-0**

DRAW A SKETCH BELOW SHOWING LOCATION OF WELL IN RELATION TO NEARBY TOWNS AND ROADS AND GIVE DISTANCE FROM WELL TO NEAREST ROAD JUNCTION

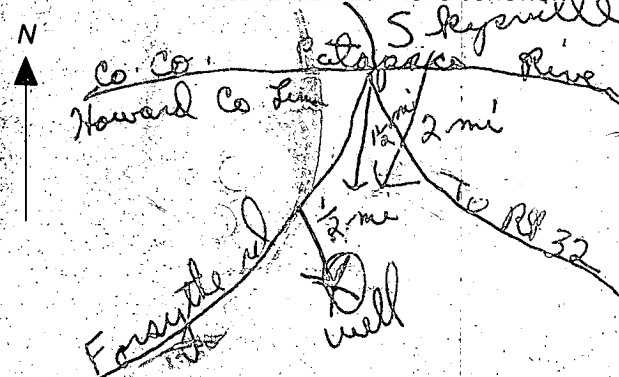

FIELD DATA SHEET
HOWARD COUNTY WELL YIELD TEST

Well Permit No. HO - 81-0073

Location of property (road) 950 Sunset Valley Drive

Subdivision Sunset Valley Lot 7 Block — Plat — Sec. 1

Well Driller Austin Garver Owner Dehart

Depth of well 145

Distance of measuring point (M.P.) above ground, 2 ft.

Static water level (S.W.L.) below M.P. 16.45

1. High rate pumping -- reservoir drawdown

Time pump started 10:15 Pumping rate 8 gpm
Total time 1.5 to reach pumping water level 16 ft. below M.P.

Total time 1.5 to reach pumping water level 16 ft. below M.P.

II. Recovery pump test data - observations to be recorded every 15 minutes

[illegible]

Page 1 of 1
Date 11/1/11

Review

5/5/83
Water sample taken 012¹⁵
149263

FIELD DATA SHEET
HOWARD COUNTY WELL YIELD TEST

Well Permit No. HO - 81-0073
Location of property (road) _____
Subdivision Sunset valley
Well Driller _____

Dry hole ~ 30' away & 30' deep filled to cement
& 300' deep by well, filled MS.

Lot 7 Block Plat Sec. 1
Owner Dehart

Depth of well _____
Distance of measuring point (M.P.) above ground _____
Static water level (S.W.L.) below M.P. _____

1. High rate pumping -- reservoir drawdown

Time pump started _____ Pumping rate _____
Total time _____ to reach pumping water level _____ ft. below M.P.

II. Recovery pump test data - observations to be recorded every 15 minutes

[illegible]

15	SEQUENCE NO. (OEP USE ONLY)	STATE OF MARYLAND WELL COMPLETION REPORT FILL IN THIS FORM COMPLETELY PLEASE PRINT OR TYPE	THIS REPORT MUST BE SUBMITTED WITHIN 45 DAYS AFTER WELL IS COMPLETED.
(THIS NUMBER IS TO BE PUNCHED IN COAS, 3-6 ON ALL CARDS)		COUNTY NUMBER	A29162
Date Received (OEP use only)	DATE WELL COMPLETED 042985	Depth of Well 145 (TO NEAREST FOOT)	PERMIT NO. FROM "PERMIT TO DRILL WELL" HO-81-0073

OWNER last name Dehart	first name Dennis & Mary	
STREET OR RFD 950 Sunset Valley Drive	TOWN Sykesville	
SUBDIVISION Sunset Valley	SECTION 1	LOT 7

WELL LOG Not required for driven wells		
STATE THE KIND OF FORMATIONS PENETRATED, THEIR COLOR, DEPTH, THICKNESS AND IF WATER BEARING		
DESCRIPTION (Use additional sheets if needed)	FEET FROM TO	Check if water bearing
dirt	0 20	
sandstone	20 145	
Dry Hole 385' deep 13 bags Cement		

GROUTING RECORD WELL HAS BEEN GROUTED (Circle Appropriate Box) YES (Y) NO (N)		
TYPE OF GROUTING MATERIAL CEMENT (CM) BENTONITE CLAY (BC)		
NO. OF BAGS 9 NO. OF POUNDS 100		
GALLONS OF WATER 54		
DEPTH OF GROUT SEAL (to nearest foot) from 0 ft. to 34 ft. (enter 0 if from surface)		
CASING RECORD casing types insert appropriate code below		
STEEL (ST) CONCRETE (CO) PLASTIC (PL) OTHER (OT)		
MAIN CASING TYPE ST 6 34		
Nominal diameter top(main) casing (nearest inch)		
Total depth of main casing (nearest foot)		
OTHER CASING (if used) diameter depth (feet) to		
inch from		

SCREEN RECORD screen type or open hole insert appropriate code below		
STEEL (ST) BRASS (BR) OPEN HOLE (HO) BRONZE (PL) OTHER (OT) PLASTIC (PL) OTHER (OT)		
C 2 (Seq. no.)		
DEPTH (nearest ft.)		
HO 34 145		
EACH SCREEN		
2 3 4 100		
SLOT SIZE 2 3		
DIAMETER OF SCREEN (NEAREST INCH)		
from to		
GRAVEL PACK		
IF WELL DRILLED WAS FLOWING WELL (Circle Box) F		

OEP USE ONLY (NOT TO BE FILLED IN BY DRILLER)		
T (E.R.O.S.)		
W Q		
70 71 72 73 74 75 76 77 78 79 80 81 82 83 84 85 86 87 88 89 90 91 92 93 94 95 96 97 98 99 100		
TELESCOPE CASING LOG INDICATOR OTHER DATA		

C 3 (Seq. no.)		
PUMPING TEST 3		
HOURS PUMPED (nearest hour)		
PUMPING RATE (gal. per min. to nearest gal.) 8		
METHOD USED TO MEASURE PUMPING RATE Submersible		
WATER LEVEL (distance from land surface)		
BEFORE PUMPING 16		
WHEN PUMPING 16		
TYPE OF PUMP USED (for test)		
A air P piston T turbine		
C centrifugal R rotary O other (describe below)		
J jet S submersible		

PUMP INSTALLED YES NO		
DRILLER WILL INSTALL PUMP (CIRCLE APPROPRIATE BOX) Y N		
IF DRILLER INSTALLS PUMP, THIS SECTION MUST BE COMPLETED FOR ALL WELLS EXCEPT HOME USE		
TYPE OF PUMP (WRITE APPROPRIATE LETTER IN BOX - SEE ABOVE: (A, C, J, P, R, S, T, O))		
CAPACITY: GALLONS PER MINUTE (to nearest gallon)		
PUMP HORSE POWER 31 35		
PUMP COLUMN LENGTH (nearest ft.) 41 47		
CASING HEIGHT (circle appropriate box and enter casing height)		
above below		
LAND SURFACE 2 (nearest foot)		

LOCATION OF WELL ON LOT		
SHOW PERMANENT STRUCTURE SUCH AS BUILDING, SEPTIC TANKS, AND/OR LANDMARKS AND INDICATE NOT LESS THAN TWO DISTANCES (MEASUREMENTS TO WELL)		
30 40 50 well DH 75		

CIRCLE APPROPRIATE BOX		
A A WELL WAS ABANDONED AND SEALED WHEN THIS WELL WAS COMPLETED		
E ELECTRIC LOG OBTAINED		
P TEST WELL CONVERTED TO PRODUCTION WELL		
I HEREBY CERTIFY THAT THIS WELL HAS BEEN CONSTRUCTED IN ACCORDANCE WITH COMAR 10.17.13 "WELL CONSTRUCTION" AND IN CONFORMANCE WITH ALL CONDITIONS STATED IN THE ABOVE CAPTIONED PERMIT, AND THAT THE INFORMATION PRESENTED HEREIN IS ACCURATE AND COMPLETE TO THE BEST OF MY KNOWLEDGE.		
DRILLERS IDENT NO. 144		
DRILLERS SIGNATURE Austin Garve		
SIT SUPERVISOR (sign of driller or journeyman responsible for sitework if different from permittee)		

SUBDIVISION: SUNSET VALLEYLOT NUMBER: 7 Section 1DRY WELL OR DRY WELL AND TRENCH125 sq. ft./bedroom -3

	<u>Septic Tank</u>	<u>Minimum Total square Feet</u>
3 bedroom	1000 gallon	_____
4 bedroom	1250 gallon	_____
5 bedroom	1500 gallon	_____

Inlet 4 feet below original grade.Bottom maximum depth 11 feet below original grade.Effective area begins at 4 feet below original grade.

NOTE: If trench is used to make up absorbent area, run the trench on level ground and leave a 5 foot earth buffer between dry well and trench.
No trench is to exceed 100 feet in length. Trench inlet to be same as dry well, with _____ feet of stone below distribution pipe.

OR
TRENCHES

158 sq. ft./bedroomTrench to be 2 wide.Inlet 4 feet below original grade.Bottom maximum depth 11 feet below original grade.Effective area begins at 4 feet below original grade.7 feet of stone below distribution pipe.

- NOTE:
- (1) No trench to exceed 100 feet in length.
 - (2) If more than one trench used, a distribution box is required.
 - (3) Trenches to be installed on level ground.
 - (4) Call for inspection of trench before gravel is installed.
 - (5) Provide 6"-8" diameter cleanout and cap to grade or above on septic tank and drywell.
 - (6) If a Garbage disposal is used, increase septic tank capacity by 50% and increase absorbant sidewall area by 22%.

LOCATION: PLACE THE DRY WELL 25 FT FROM THE FRONT
LOT LINE AND 140 FT FROM THE RIGHT SIDE OF
THE LOT AS SEEN WHEN FACING THE LOT FROM
SUNSET VALLEY DRIVE OR START THE DITCH
AT PERC HOLE #2 LOCATED 25 FT FROM THE FRONT
LOT LINE AND 140 FT FROM THE RIGHT SIDE OF
THE LOT AS SEEN WHEN FACING THE LOT FROM
SUNSET VALLEY DR. RUN THE TRENCH TOWARD
THE BEAR

APPLICATION

SEWAGE DISPOSAL TESTING

STATE OF MARYLAND - DEPARTMENT OF HEALTH AND MENTAL HYGIENE

HOWARD COUNTY HEALTH DEPARTMENT
ENVIRONMENTAL HEALTH SERVICES

P.O. BOX 476 ELLICOTT, MARYLAND 21043
TELEPHONE: 992-2330

A 29162

P _____

DISTRICT 3RD

DATE 10/12/78

TO: THE COUNTY HEALTH OFFICER
ELLICOTT CITY, MARYLAND

I, HEREBY, APPLY FOR THE NECESSARY TEST IN ORDER TO CONSTRUCT (OR RECONSTRUCT) A SEWAGE DISPOSAL SYSTEM.

PROPERTY OWNER DENNIS M. DeHart
VIRGINIA M. GARRATT

ADDRESS 130 Chapel Towne Circle
FORSYTHE ROAD SYKESVILLE, MD. PHONE 301-442-2262
Baltimore, Md 21236 21784

PROPERTY LOCATION:

SUBDIVISION SUNSET VALLEY LOT NO. 4 new 7
See 1

ROAD AND DESCRIPTION SUNSHINE WAY 950 Sunset Valley Drive

SIZE OF LOT 3.0 AC. ± TYPE BLDG. SINGLE FAMILY RESIDENCE

THE SYSTEM INSTALLED UNDER THIS APPLICATION IS ACCEPTABLE ONLY UNTIL PUBLIC FACILITIES BECOME AVAILABLE.

I FULLY UNDERSTAND THE FEE CONNECTED WITH THE FILING OF THIS PERC TEST APPLICATION IS NON-REFUNDABLE UNDER ANY CIRCUMSTANCES.

SIGNATURE OF APPLICANT Bruce D Buntin
APPROVED BY Raymond Dodge FOR Trench or myrill DATE 3/10/83
REJECTED BY _____ FOR _____ DATE _____

HOLD PENDING FURTHER TESTS _____ DATE _____
REASONS FOR REJECTION OR HOLDING 3/10/83 fees written BH


BLDG. PERMIT SIGNED
AND RETURNED 4/5/83
Serial # 52985

THIS IS NOT A PERMIT

SOIL PROFILE

0

S
U
N
S
H
-
2
3
3
9
Y

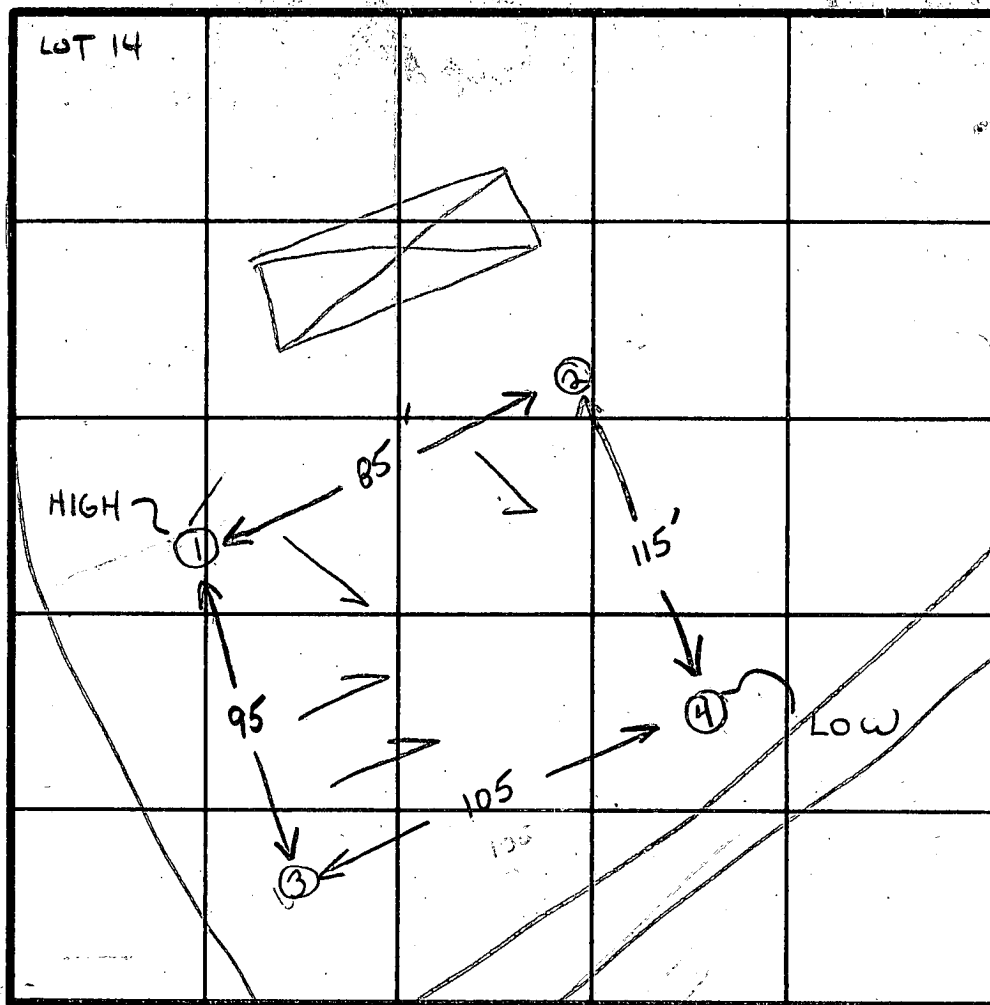

TRENCH
① → ③

OR

① → ②

4 1/2' 3 11mm

INDICATE NORTH - NAME ADJOINING ROADWAY AS BASE LINE.

SUNSET VALLEY DRIVE

DATE	TEST NO.	DEPTH	PRE-WET		TEST - 1" DROP		TIME
			START	STOP	START	STOP	
12/15/78	15	5'	401	405	405	410	5
	10 High	12'	404	410	410	422	12
	25		good soil at 3 1/2' → 4'				
	20	12 1/2'	similar to below				
	35	5'	345	351	351	403	12
	30	12 1/2'	344	350	350	402	12
	45 Low	5'	348	351	351	403	12
	40	13'	348	355	355	407	12
4/5/79	①	14 1/2' - VISUAL	- VERY SANDY DEEP				


good at
4'

REMARKS open field - tests as stated

TYPE OF SOIL SANDY LOAM BELOW CLAY

TESTED BY GLR 3 RD


ALSO PRESENT

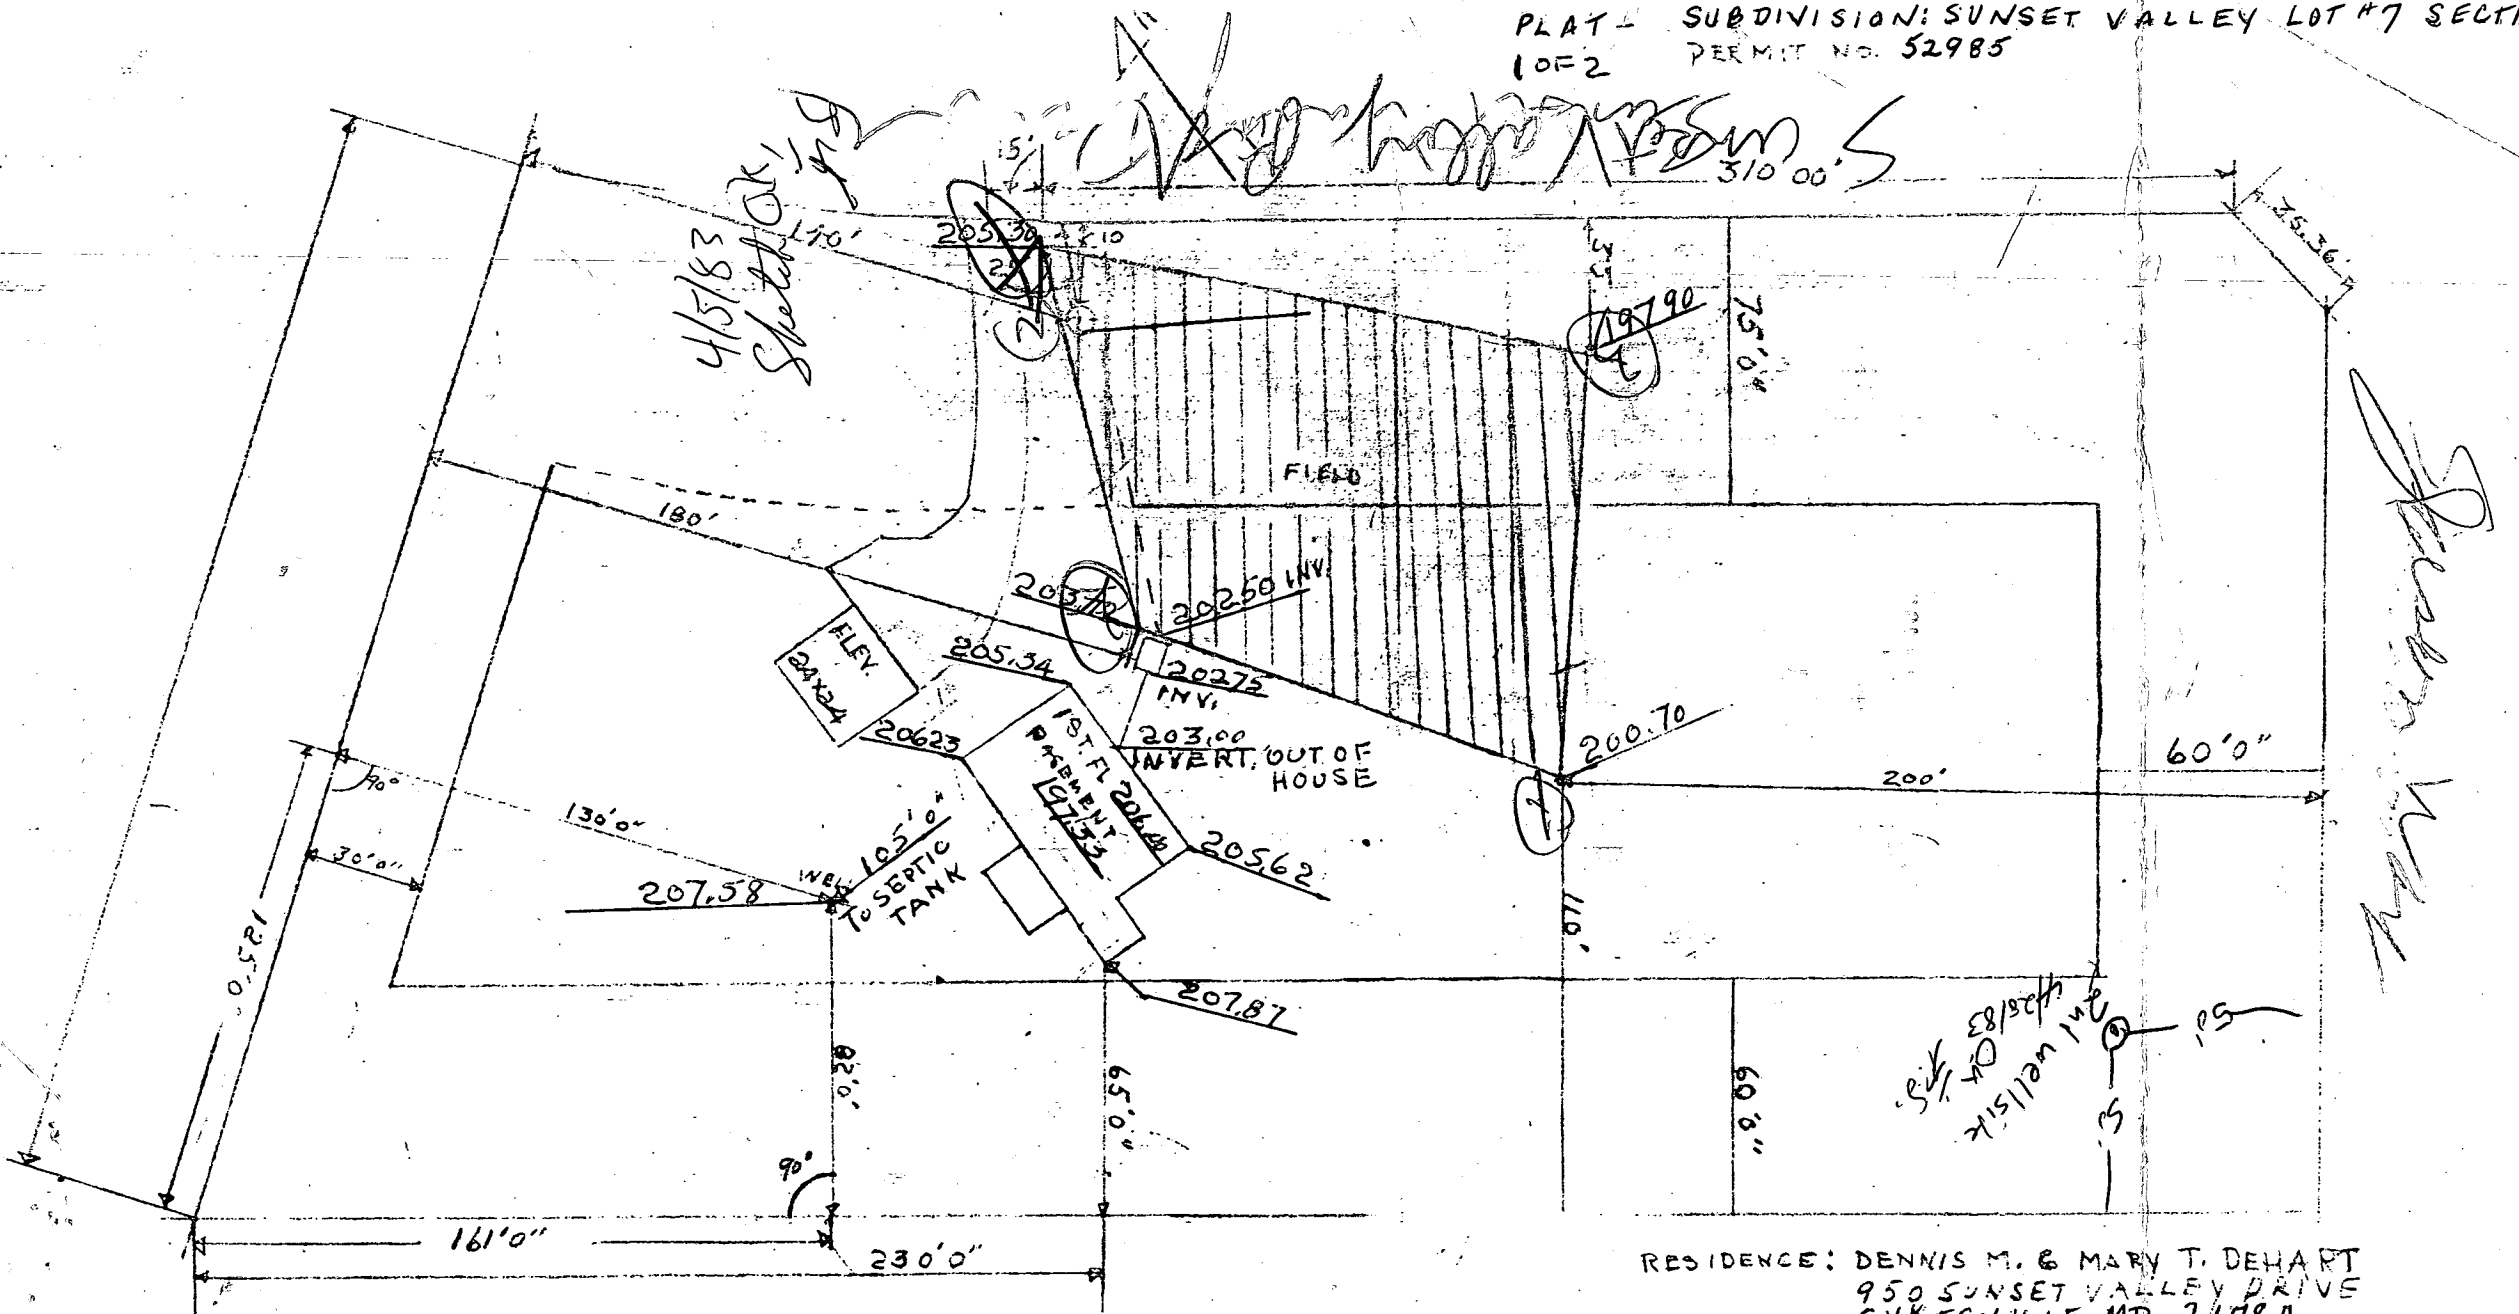

PLAT REVISED 3/31/83
SHOWING RELOCATION OF HOUSE AND ENTRANCE
ALSO SHOWS ELEV. AND INFORMATION REQUESTED
BY HOWARD COUNTY HEALTH DEPARTMENT

RESIDENCE: DENNIS M. & MARY T. DEHART
950 SUNSET VALLEY DRIVE
SYKESVILLE MD. 21784

PLAT & PLANS BY
JAMES L. TOPPER 1-447-2662
SCALE 1"=50'

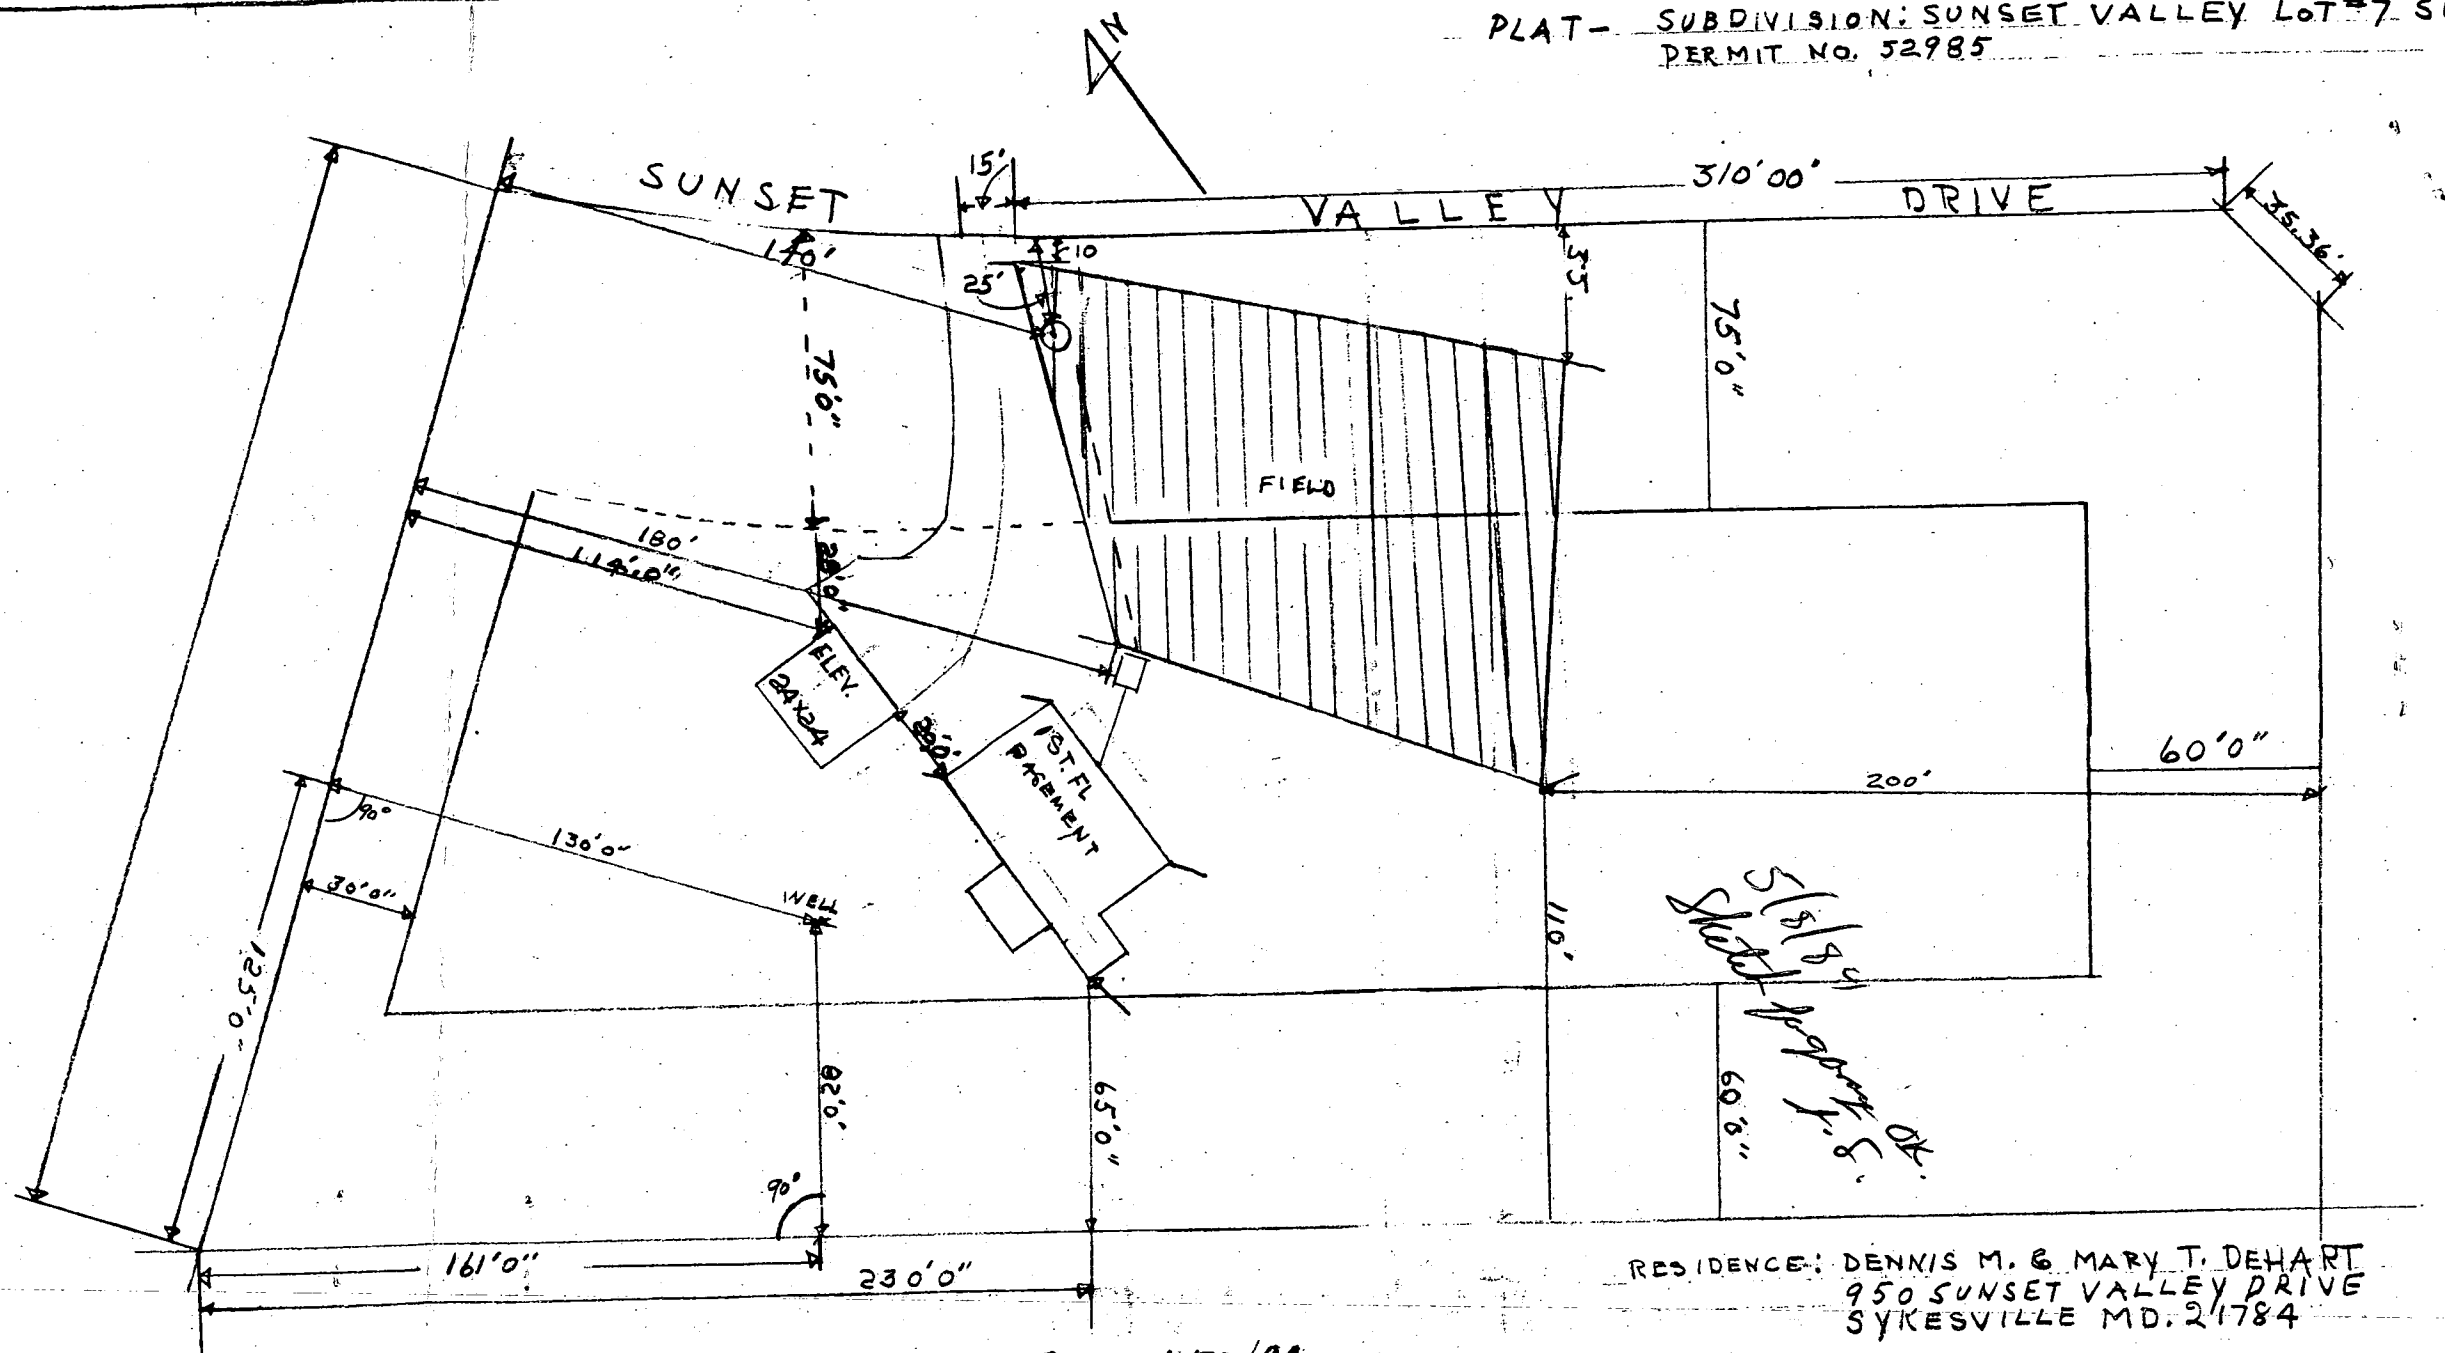

PLAT AMENDED 4/30/84
 SHOWING LOCATION OF HOUSE
 GARAGE AND ENTRANCE

RESIDENCE: DENNIS M. & MARY T. DEHART
 950 SUNSET VALLEY DRIVE
 SYKESVILLE MD. 21784

PLAT & PLANS BY
 JAMES L. TOPPER 1-447-2662
 SCALE 1"=50'