

05-398150

PERMIT

SEWAGE DISPOSAL SYSTEM

MARYLAND STATE DEPARTMENT OF HEALTH

HOWARD COUNTY

BUREAU OF ENVIRONMENTAL HEALTH

XX992-2330X
461-9933

ELLICOTT CITY

DISTRICT 5th

DATE 12/02/86

INDEXED

{ I.C.O.P.
Time expired }

Donald Parlette C.E. ABEND & Sons

IS PERMITTED TO INSTALL ☒ ALTER

ADDRESS

1329 Tannery Hill Road - Westminster, Md
6575 Route 32, Clarksville, Maryland 21029

PHONE

531-2140 P48-0204

SUBDIVISION

Parson's Choice

ROAD

11944 Simpson Road

LOT

8

PROPERTY OWNER

Hunton Whitt

ADDRESS

IF GARBAGE GRINDER IS USED INCREASE SEPTIC TANK CAPACITY BY 50% AND ABSORPTION AREA BY 22%.

GARBAGE GRINDER?

YES

NO ☒

SEPTIC TANK CAPACITY

1250

GALLONS

NUMBER OF BEDROOMS

4

TRENCHES - 200 sq. ft. per bedroom. Trench to be 2 feet wide. Inlet $3\frac{1}{2}$ feet below original grade. Bottom maximum depth 8 feet below original grade. Effective area begins at $3\frac{1}{2}$ feet below original grade. $4\frac{1}{2}$ feet of stone below distribution pipe.

LOCATION - Place distribution box 120 feet from the left lot line and 210 feet from the rear lot line as seen when facing the property from the Right-of-Way. Run trench along contour in both directions.

NOTE - No trench to exceed 100 feet in length. If more than one trench used, a distribution box is required. Call for inspection of trench(s) before and after gravel is installed. Provide 6" - 8" diameter cleanout and cap to grade or above on septic tank.

PLANS APPROVED BY

C. Williams

DATE

8/13/86

COVER NO WORK UNTIL INSPECTED AND APPROVED.

NEITHER THE HOWARD COUNTY COUNCIL NOR THE HEALTH DEPARTMENT IS RESPONSIBLE FOR THE SUCCESSFUL OPERATION OF ANY SYSTEM.

NOTE: IF TRENCH IS USED CALL FOR INSPECTION BEFORE AND AFTER PLACING GRAVEL IN TRENCH.

NOTE: NO DRY WELL SHALL EXCEED 15 FOOT IN DIAMETER. NO ABSORPTION TRENCH TO EXCEED 100 FEET IN LENGTH.

NOTE: ALL PIPE FROM HOUSE TO SEPTIC TANK MUST BE CAST IRON OR SCHEDULE 40 PVC OR ABS.

BLDG. PERMIT SIGNED
AND RETURNED 4/3/87

PERMIT VOID AFTER THREE YEARS.

NOTE: INSTALL STAND PIPE ON SEPTIC TANK AND DRY WELL. STAND PIPES MUST BE 6 INCHES IN DIAMETER. CAST IRON, CONCRETE OR TERRA COTTA, OR PVC OR ABS ACCEPTED. IF TOP OF SEPTIC TANK IS DEEPER THAN 3 FEET MANHOLE TO GRADE REQUIRED.

*INSTALLER IS RESPONSIBLE FOR OBTAINING FINAL APPROVAL ON THIS PERMIT

*CALL 992-2330 FOR INSPECTION OF SEPTIC SYSTEMS.

EH - 2-1082

A 29308

Pret

F

STATE OF MARYLAND - DEPARTMENT OF HEALTH AND MENTAL HYGIENE

P.O. BOX 476 ELLICOTT MARYLAND 21043
TELEPHONE: 992-2330

Septic Tank { 1-3 Bedrooms = 1000 gallons
4 Bedrooms = 1250 gallons

792 effective absorbant sidewall area per bedroom below 12/5/78
 0566 inlet to be 4' below original grade and maximum depth 10'.
 DATE 12/5/78

Location per engineer's plat: 125' from left property line and 110' from rear property line when facing east from Simpson Road. (See hole 6+7) ~~or if dug well & trench used - Need:~~
 (a) 5' earth buffer
 1.5' to 2' to 1 1/4"

I, HEREBY, APPLY FOR THE NECESSARY TEST IN ORDER TO CONSTRUCT (OR RECONSTRUCT) A SEWAGE DISPOSAL SYSTEM

PROPERTY OWNER

ADDRESS

PROPERTY LOCATION:

SUBDIVISION

ROAD AND DESCRIPTION

SIZE OF LOT

TYPE BLDG

THE SYSTEM INSTALLED UNDER THIS APPLICATION IS ACCEPTABLE ONLY UNTIL PUBLIC FACILITIES BECOME AVAILABLE.

I FULLY UNDERSTAND THE FEE CONNECTED WITH THE FILING OF THIS PERC TEST APPLICATION IS NON-REFUNDABLE UNDER

ANY CIRCUMSTANCES.

SIGNATURE OF APPLICANT

APPROVED BY

REJECTED BY

HOLD PENDING FURTHER TESTS

REASONS FOR REJECTION OR HOLDING

BLDG. PERMIT SIGNED

AND RETURNED. 11/71

BP# 8809

S. A. A. A.

144

FOR

FOR

DATE _____

DATE _____



DATE _____

THIS IS NOT A PERMIT



SOIL PROFILE

0

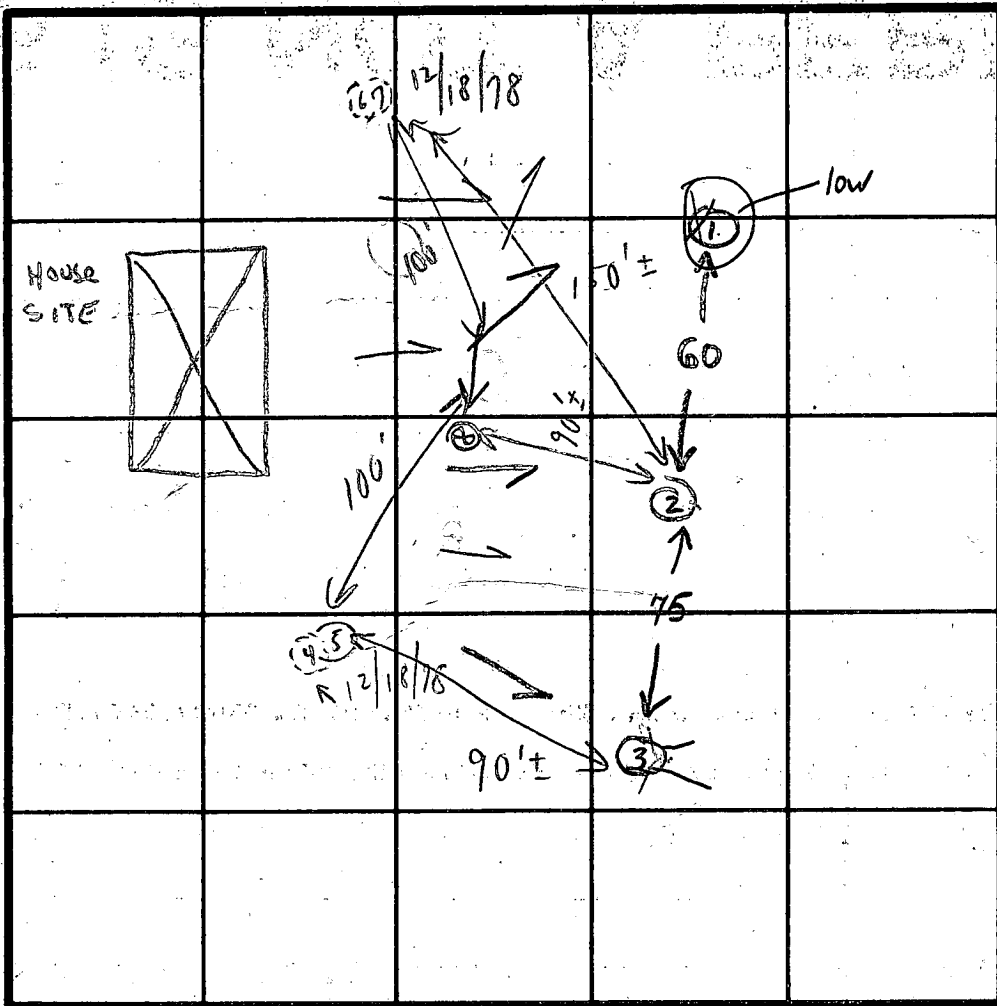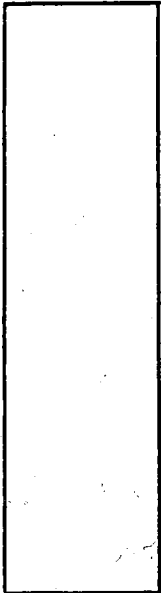

Elevation:

② → ① = 3'

③ → ① = 4'

sight level

INDICATE NORTH - NAME ADJOINING ROADWAY AS BASE LINE.

Simpson RD

DATE	TEST NO.	DEPTH	PRE-WET		TEST - 1" DROP		TIME
			START	STOP	START	STOP	
12/6/78	1	9'	WATER				
	25	3 1/2'	1016	1018	1018	1021	3
	20	12'	1016	1025	1025	1046	21
	35	3 1/2'	1021	1023	1023	1026	3
	30	13 1/2'	WATER				
12/18/78	4	3 1/2'	3:35	3:38	3:38	3:43	5
	5	12'	3:35	3:42	3:42	4:09	27
	6	12'	similar to (8)				5:59
	7						
	8	13'	4' down		Mia loan		
	9						
					(System first)		

Mia loan

12 min
inlet 2
downfields
WATER?

150 yd
per bed room
12 min
4'-11'
(Use #8)

REMARKS

Tests by stakes - Hold for wet season - cannot move to higher elevation.

TYPE OF SOIL

Sandy loam below clay

Hold for house site

TESTED BY

GLK 3 RD

ALSO PRESENT

Kettnerman

SEQUENCE NO.
(OEP USE ONLY)STATE OF MARYLAND
PERMIT TO DRILL WELL

OEP PERMIT NUMBER

40-81-1172
fill in this form completelyNUMBER IS TO BE PUNCHED
IN COLS 3-6 ON ALL CARDS)

please print or type

Date Received

09/10/85

OWNER INFORMATION

15 Last Name 8 13 15 17 19 21 23 25 27 29 31 33 35 37 39 41 43 45 47 49 51 53 55 57 59 61 63 65 67 69 71 73 75 77 79

Owner First Name

9547 Quarry Bridge Ct.

Street of RFD

Columbia MD Zip 76

DRILLER INFORMATION

Driller's Name George F. Easterday 40 License No. 80

Firm Name L. Franklin Easterday, Inc.

Address 9265 Brown Church Rd. Mt. Airy, MD 21771

Signature George F. Easterday Date 9/6/85

WELL INFORMATION

APPROX. PUMPING RATE (GAL. PER MIN.) 3

AVERAGE DAILY QUANTITY NEEDED (GAL. PER DAY) 500

USE FOR WATER (CIRCLE APPROPRIATE BOX)

- ☒ HOME (SINGLE OR DOUBLE HOUSEHOLD UNIT ONLY)
- ☐ FARMING (LIVESTOCK WATERING & AGRICULTURAL IRRIGATION)
- ☐ INDUSTRIAL, COMMERCIAL, STATE AND FEDERAL GOV. OTHER (REQUIRES APPROPRIATION PERMIT)
- ☐ PUBLIC OR PRIVATE WATER COMPANY (REQUIRES APPROPRIATION PERMIT AND STATE HEALTH DEPARTMENT APPROVAL)
- ☐ TEST, OBSERVATION, MONITORING (MAY REQUIRE APPROPRIATION PERMIT)

APPROXIMATE DEPTH OF WELL 200 FEET

APPROXIMATE DIAMETER OF WELL 6 INCH

METHOD OF DRILLING (circle one)

BORED (or Augered) JETTED Jetted & DRIVEN

AIR-ROTARY AIR-PERCussion ROTARY (Hydraulic Rotary)

CABLE REVERSE-ROTARY DRIVE-POINT

other

REPLACEMENT OR DEEPEMED WELLS
(CIRCLE APPROPRIATE BOX)

- ☒ THIS WELL WILL NOT REPLACE AN EXISTING WELL
- ☐ THIS WELL WILL REPLACE A WELL THAT WILL BE ABANDONED AND SEALED
- ☐ THIS WELL WILL REPLACE A WELL THAT WILL BE USED AS A STANDBY
- ☐ THIS WELL WILL DEEPEMED AN EXISTING WELL

PERMIT NUMBER OF WELL TO BE REPLACED OR DEEPEMED (IF AVAILABLE)

Not to be filled in by driller (OEP USE ONLY)

APPROP. PERMIT NUMBER GAP

FORCE FS WRITE INITIALS IN BOX PERMIT No. 40-81-1172

SPECIAL CONDITIONS

LOCATION OF WELL

Howard 8 COUNTY 21

Parson Choice 23 SUBDIVISION 42


SECTION 44 46 LOT 48 50

Hubbard 52 NEAREST TOWN 71

MILES FROM TOWN (enter 0 if in town) 2 MI

B 4

DIRECTION OF WELL FROM TOWN (CIRCLE BOX)

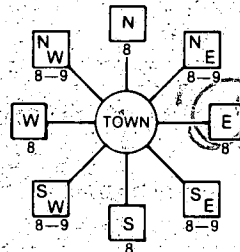

11944 Simson Rd. 11 NEAR WHAT ROAD 30

ON WHICH SIDE OF ROAD (CIRCLE APPROPRIATE BOX)

500
DISTANCE FROM ROAD

ENTER FT or MI FT

NOT TO BE FILLED IN BY DRILLER
HEALTH DEPARTMENT APPROVAL

HOWARD

COUNTY NAME

A 29308

COUNTY NO.

OEP
SIGNATURESTATE HEALTH
INSERT S

DATE ISSUED

09/13/85

Frank Sh

3/13/86

NORTH
GRID

489000

EAST
GRID

0821000

SHOW MAJOR FEATURES OF BOX & LOCATE WELL WITH AN X

SOURCES OF DRILLING WATER

1. well

2.


3.

WRITE THE BOX NUMBER FROM THE MAP HERE

E 820

N 480

DRAW A SKETCH BELOW SHOWING LOCATION OF WELL IN RELATION TO NEARBY TOWNS AND ROADS AND GIVE DISTANCE FROM WELL TO NEAREST ROAD JUNCTION

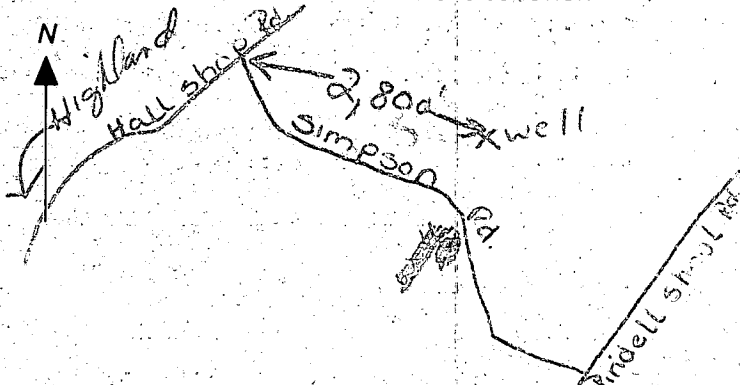

C12427

(THIS NUMBER IS TO BE PUNCHED IN COLS. 3-6 ON ALL CARDS)

STATE OF MARYLAND
WELL COMPLETION REPORT
FILL IN THIS FORM COMPLETELY
PLEASE PRINT OR TYPE

COUNTY NUMBERA29308

PERMIT NO.
FROM "PERMIT TO DRILL WELL"
40-81-1172

DATE Received
DATE WELL COMPLETED101585
Depth of Well190
(TO NEAREST FOOT)

OWNERWittJohn
STREET OR RFD11474 Simpson Rd
SUBDIVISIONParsons ChoiceSECTIONLOT8

WELL LOG		
Not required for driven wells		
STATE THE KIND OF FORMATIONS PENETRATED, THEIR COLOR, DEPTH, THICKNESS AND IF WATER BEARING		
DESCRIPTION (Use additional sheets if needed)	FEET	
	FROM	TO
topsoil	0	1
Red clay w/ cobbles	1	6
SANDY LOAM	6	20
brown mica		
schist w/ flint	20	34
SANDSTONE	34	48
gray mica	48	53
brown mica	53	65
gray mica	65	73
brown mica	73	80
gray mica	80	146

GROUTING RECORD

WELL HAS BEEN GROUTED (Circle Appropriate Box) YES [Y] NO [N]

TYPE OF GROUTING MATERIAL

CEMENT [CM] BENTONITE CLAY [BC]

NO. OF BAGS 8 NO. OF POUNDS 800

GALLONS OF WATER 45

DEPTH OF GROUT SEAL (to nearest foot)

from 48 TOP 52 ft to 34 BOTTOM 58 ft

CASING RECORD

casing types insert appropriate code below

[ST] [CO] STEEL CONCRETE

[PL] [OT] PLASTIC OTHER

MAIN CASING TYPE

Nominal diameter top (main) casing (nearest inch)

Total depth of main casing (nearest foot)

[5] [6] [36]

OTHER CASING (if used)

diameter inch

depth (feet) from to

SCREEN RECORD

screen type or open hole insert appropriate code below

[ST] [BR] [HO] STEEL BRASS OPEN HOLE

[PL] [OT] PLASTIC OTHER

C2

DEPTH (nearest ft.)

1 2 3 1000

CIRCLE APPROPRIATE LETTER

A A WELL WAS ABANDONED AND SEALED WHEN THIS WELL WAS COMPLETED

E ELECTRIC LOG OBTAINED

P TEST WELL CONVERTED TO PRODUCTION WELL

I HEREBY CERTIFY THAT THIS WELL HAS BEEN CONSTRUCTED IN ACCORDANCE WITH COMAR 10.17.13 "WELL CONSTRUCTION" AND IN CONFORMANCE WITH ALL CONDITIONS STATED IN THE ABOVE CAPTIONED PERMIT, AND THAT THE INFORMATION PRESENTED HEREIN IS ACCURATE AND COMPLETE TO THE BEST OF MY KNOWLEDGE.

DRILLERS IDENT. NO. 40

DRILLERS SIGNATURE

SITE SUPERVISOR (sign. of driller or journeyman responsible for sitework if different from permittee)

GRAVEL PACK

IF WELL DRILLED WAS FLOWING WELL INSERT F IN BOX 68

OEP USE ONLY (NOT TO BE FILLED IN BY DRILLER)

T (E.R.O.S.)

WQ

TELESCOPE CASING

LOG INDICATOR

OTHER DATA

C3

PUMPING TEST

HOURS PUMPED (nearest hour) 3

PUMPING RATE (gal. per min. to nearest gal.) 10

METHOD USED TO MEASURE PUMPING RATE Bucket

WATER LEVEL (distance from land surface)

BEFORE PUMPING 31

WHEN PUMPING 35

TYPE OF PUMP USED (for test)

A air

P piston

T turbine

C centrifugal

R rotary

O other (describe below)

J jet

S submersible

PUMP INSTALLED

DRILLER WILL INSTALL PUMP YES NO

IF DRILLER INSTALLS PUMP, THIS SECTION MUST BE COMPLETED FOR ALL WELLS EXCEPT HOME USE

TYPE OF PUMP INSTALLED

PLACE (A,C,J,P,R,S,T,O) IN BOX - SEE ABOVE

CAPACITY: GALLONS PER MINUTE (to nearest gallon)

PUMP HORSE POWER

PUMP COLUMN LENGTH (nearest ft.)

CASING HEIGHT (circle appropriate box and enter casing height)

above

below

LAND SURFACE

(nearest foot)

LOCATION OF WELL ON LOT

SHOW PERMANENT STRUCTURE SUCH AS BUILDING, SEPTIC TANKS, AND/OR LANDMARKS AND INDICATE NOT LESS THAN TWO DISTANCES (MEASUREMENTS TO WELL)

REAR PROPERTY LINE

105' to well

30' to well

8:00

Review OK'd (BA) 5/26/86

Well Permit No. HO - 81-1172
Location of property (road) Simpson Rd
Subdivision Parsons Choice Lot 8 Block Plat Sec.
Well Driller George F. Easterday Owner John Witt
Depth of well 140 ft 256 PM
Distance of measuring point (M.P.) above ground 2
Static water level (S.W.L.) below M.P. 31

I. High rate pumping -- reservoir drawdown

Time pump started 11:30 Pumping rate 10
Total time 1.5 min to reach pumping water level 35 ft. below M.P.

II. Recovery pump test data - observations to be recorded every 15 minutes

[illegible]

APPLICATION FOR PITLESS ADAPTER, WELL PUMP AND PRESSURE TANK INSTALLATION

Howard County Health Department
Bureau of Environmental Health
3525-H Ellicott Mills Drive
Court House Square
Ellicott City, Md. 21043
461-9933

New Installation yes
Replacement _____

Receipt # _____
Date _____

Name of Installer C. Edward Abend

Telephone 848-0204

License number 2276

Certified Well Pump Installer _____ Well Driller _____ Registered Plumber ☒

Name of Property Owner John H. Witt

Telephone _____

Subdivision _____ Lot # 8 Well tag # HO-81-1172

Site Address 11944 Simpson Rd

Pump

1. Type
 - a. Deep well jet _____
 - b. Shallow well jet _____
 - c. Submersible ☒

2. Make Myers

3. Model # 52T72-J78

4. Capacity 8 GPM

5. Pump exceeds well capacity Yes _____ No ☒

6. If Yes, is low pressure cutoff switch installed? Yes _____ No _____

7. What methods are used to protect the pump and electrical wiring from vibrations? Torque arrestors _____ Cable guards ☒ Other _____

Motor

1. Horsepower 3/4

2. RPM 1450

3. Voltage 240

a. 110 _____

b. 220 ☒

Pitless Adapter

1. Make Harvard

2. Model # PT 800

3. Depth 4'

Tank

1. Capacity 40 gal

2. Pressure relief valve? yes

Piping

1. Type Poly Blue

2. Size 1"

3. NSF and/or BOCA

Code approved C902 B113-86 level 30 ft.

4. Depth of supply line 4'

Well data

1. Depth 180 ft.

2. Yield 25 GPM

3. Static water

level 30 ft.

4. Will water supply be disinfected by installer? yes


I understand that it is my responsibility to notify the Howard County Health Department when the installation is ready for inspection (otherwise this permit is null and void).

All information given above is true to the best of my knowledge.

Signature of Applicant: C. Edward Abend

Date: 2/13/87

Note: A sticker indicating approval/status of the installation will be placed on the well casing at the time of the inspection.

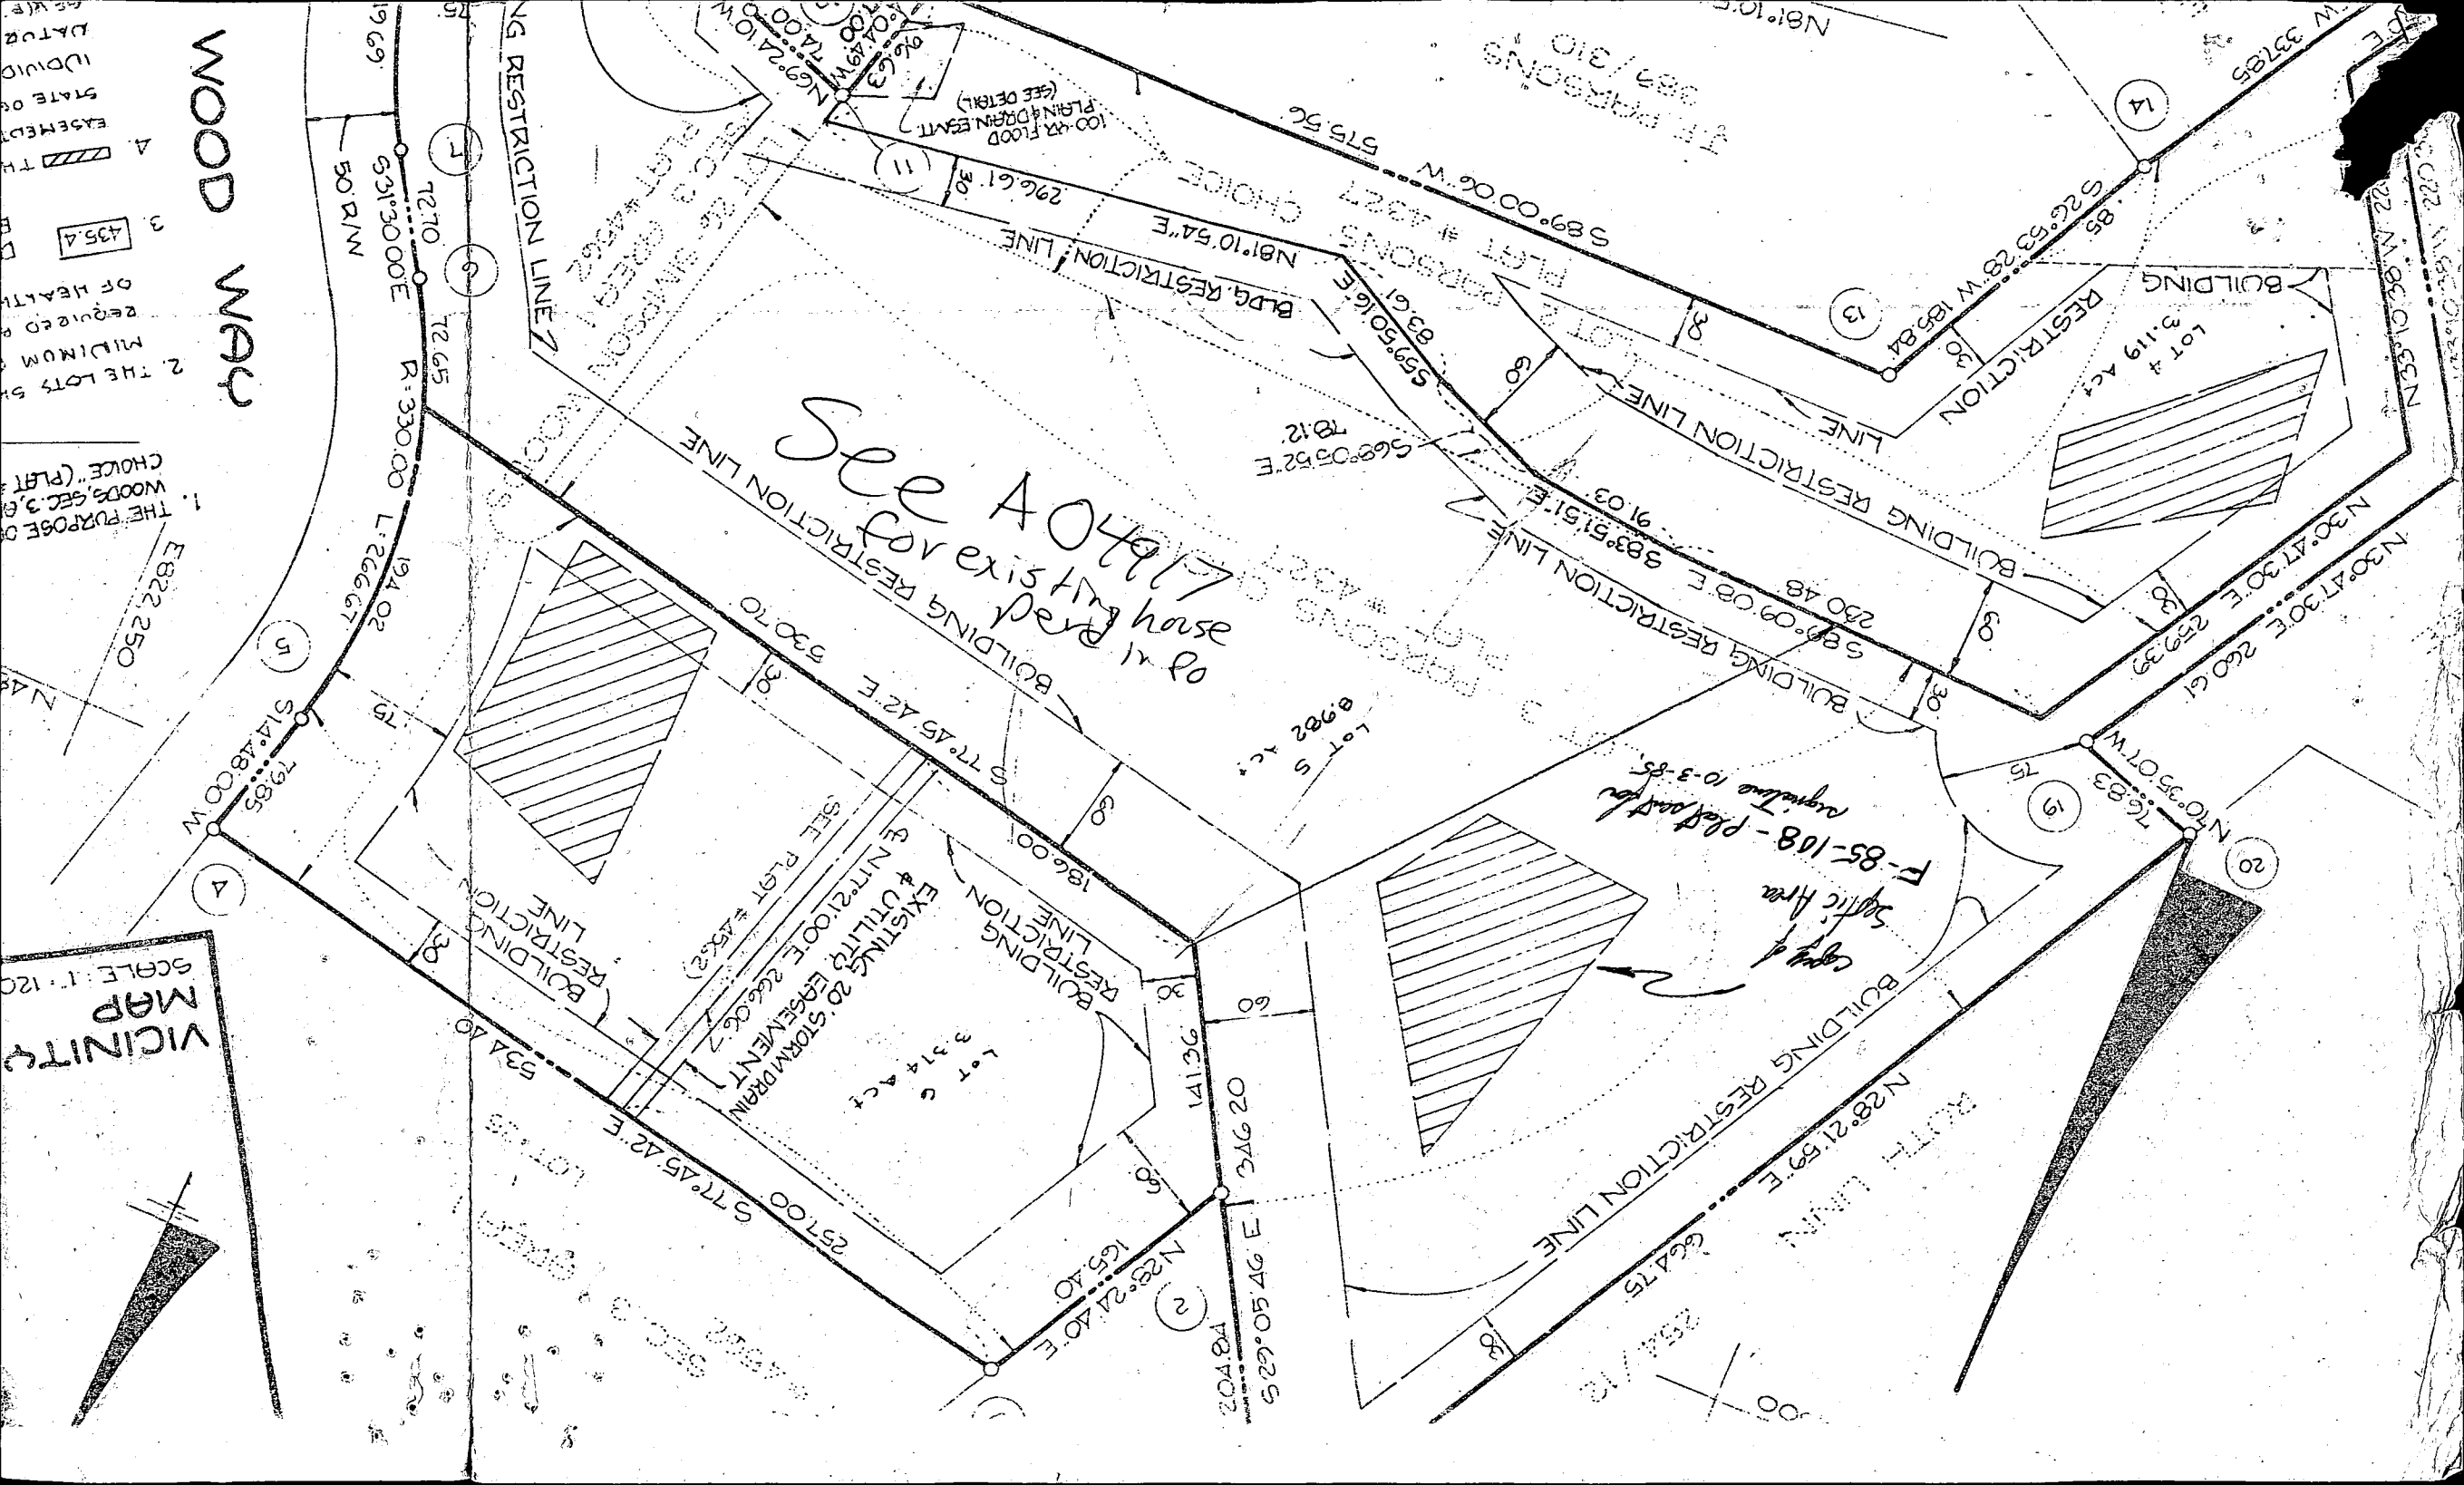

VICINITY
MAP
SCALE 1" = 120'

WOOD WAP

1. THE PURPOSE OF THIS MAP IS TO SHOW THE LOTS AND EASEMENTS REQUIRED FOR THE DEVELOPMENT OF THE TRACT OF LAND HEREIN SHOWN AS BEING RESTRICTED TO RESIDENTIAL USE.

2. THE LOTS SHOWN ON THIS MAP ARE THE MINIMUM REQUIRED FOR THE DEVELOPMENT OF THE TRACT OF LAND HEREIN SHOWN AS BEING RESTRICTED TO RESIDENTIAL USE.

3. THE LOTS SHOWN ON THIS MAP ARE THE MINIMUM REQUIRED FOR THE DEVELOPMENT OF THE TRACT OF LAND HEREIN SHOWN AS BEING RESTRICTED TO RESIDENTIAL USE.

4. THE LOTS SHOWN ON THIS MAP ARE THE MINIMUM REQUIRED FOR THE DEVELOPMENT OF THE TRACT OF LAND HEREIN SHOWN AS BEING RESTRICTED TO RESIDENTIAL USE.

Diagram showing a traverse with bearings and distances:

- From point 19 to point 22: $220.32'$ (North)
- From point 22 to point 21: $192.18'$ (North)
- From point 21 to point 20: $192.18'$ (East)
- From point 20 to point 19: $207.82'$ (South)
- Dashed line from 19 to 22: $30^{\circ} 47' 30''$ W
- Dashed line from 22: $17^{\circ} 30'$ E
- Dashed line from 19: $N 488.50'$ (Distance: $1,250'$)

DETERMINED BY SITE
INSPECTION AND INFLUENCED
BY LOCATION OF SEPTIC AREA
AND POTENTIAL REPAIR AREA
FOR RUTH LINN PROPERTY.

S. Abol.

9-6-85
APPROVABLE
WELL SITE AREA
IN SHADED AREA


529° 05' 46"

9-6-85

WSI

ELIMINATE WELL SITE 2+3
LOWER IN ELEVATION THAN
SEWAGE DISPOSAL AREA FOR
RUTH LINN PROPERTY AND
310-120' AWAY. SITE 1
OK AS WELL AS AREA TO
LEFT (SHOWN IN CORRED.
AREA) 

77. S. Altel

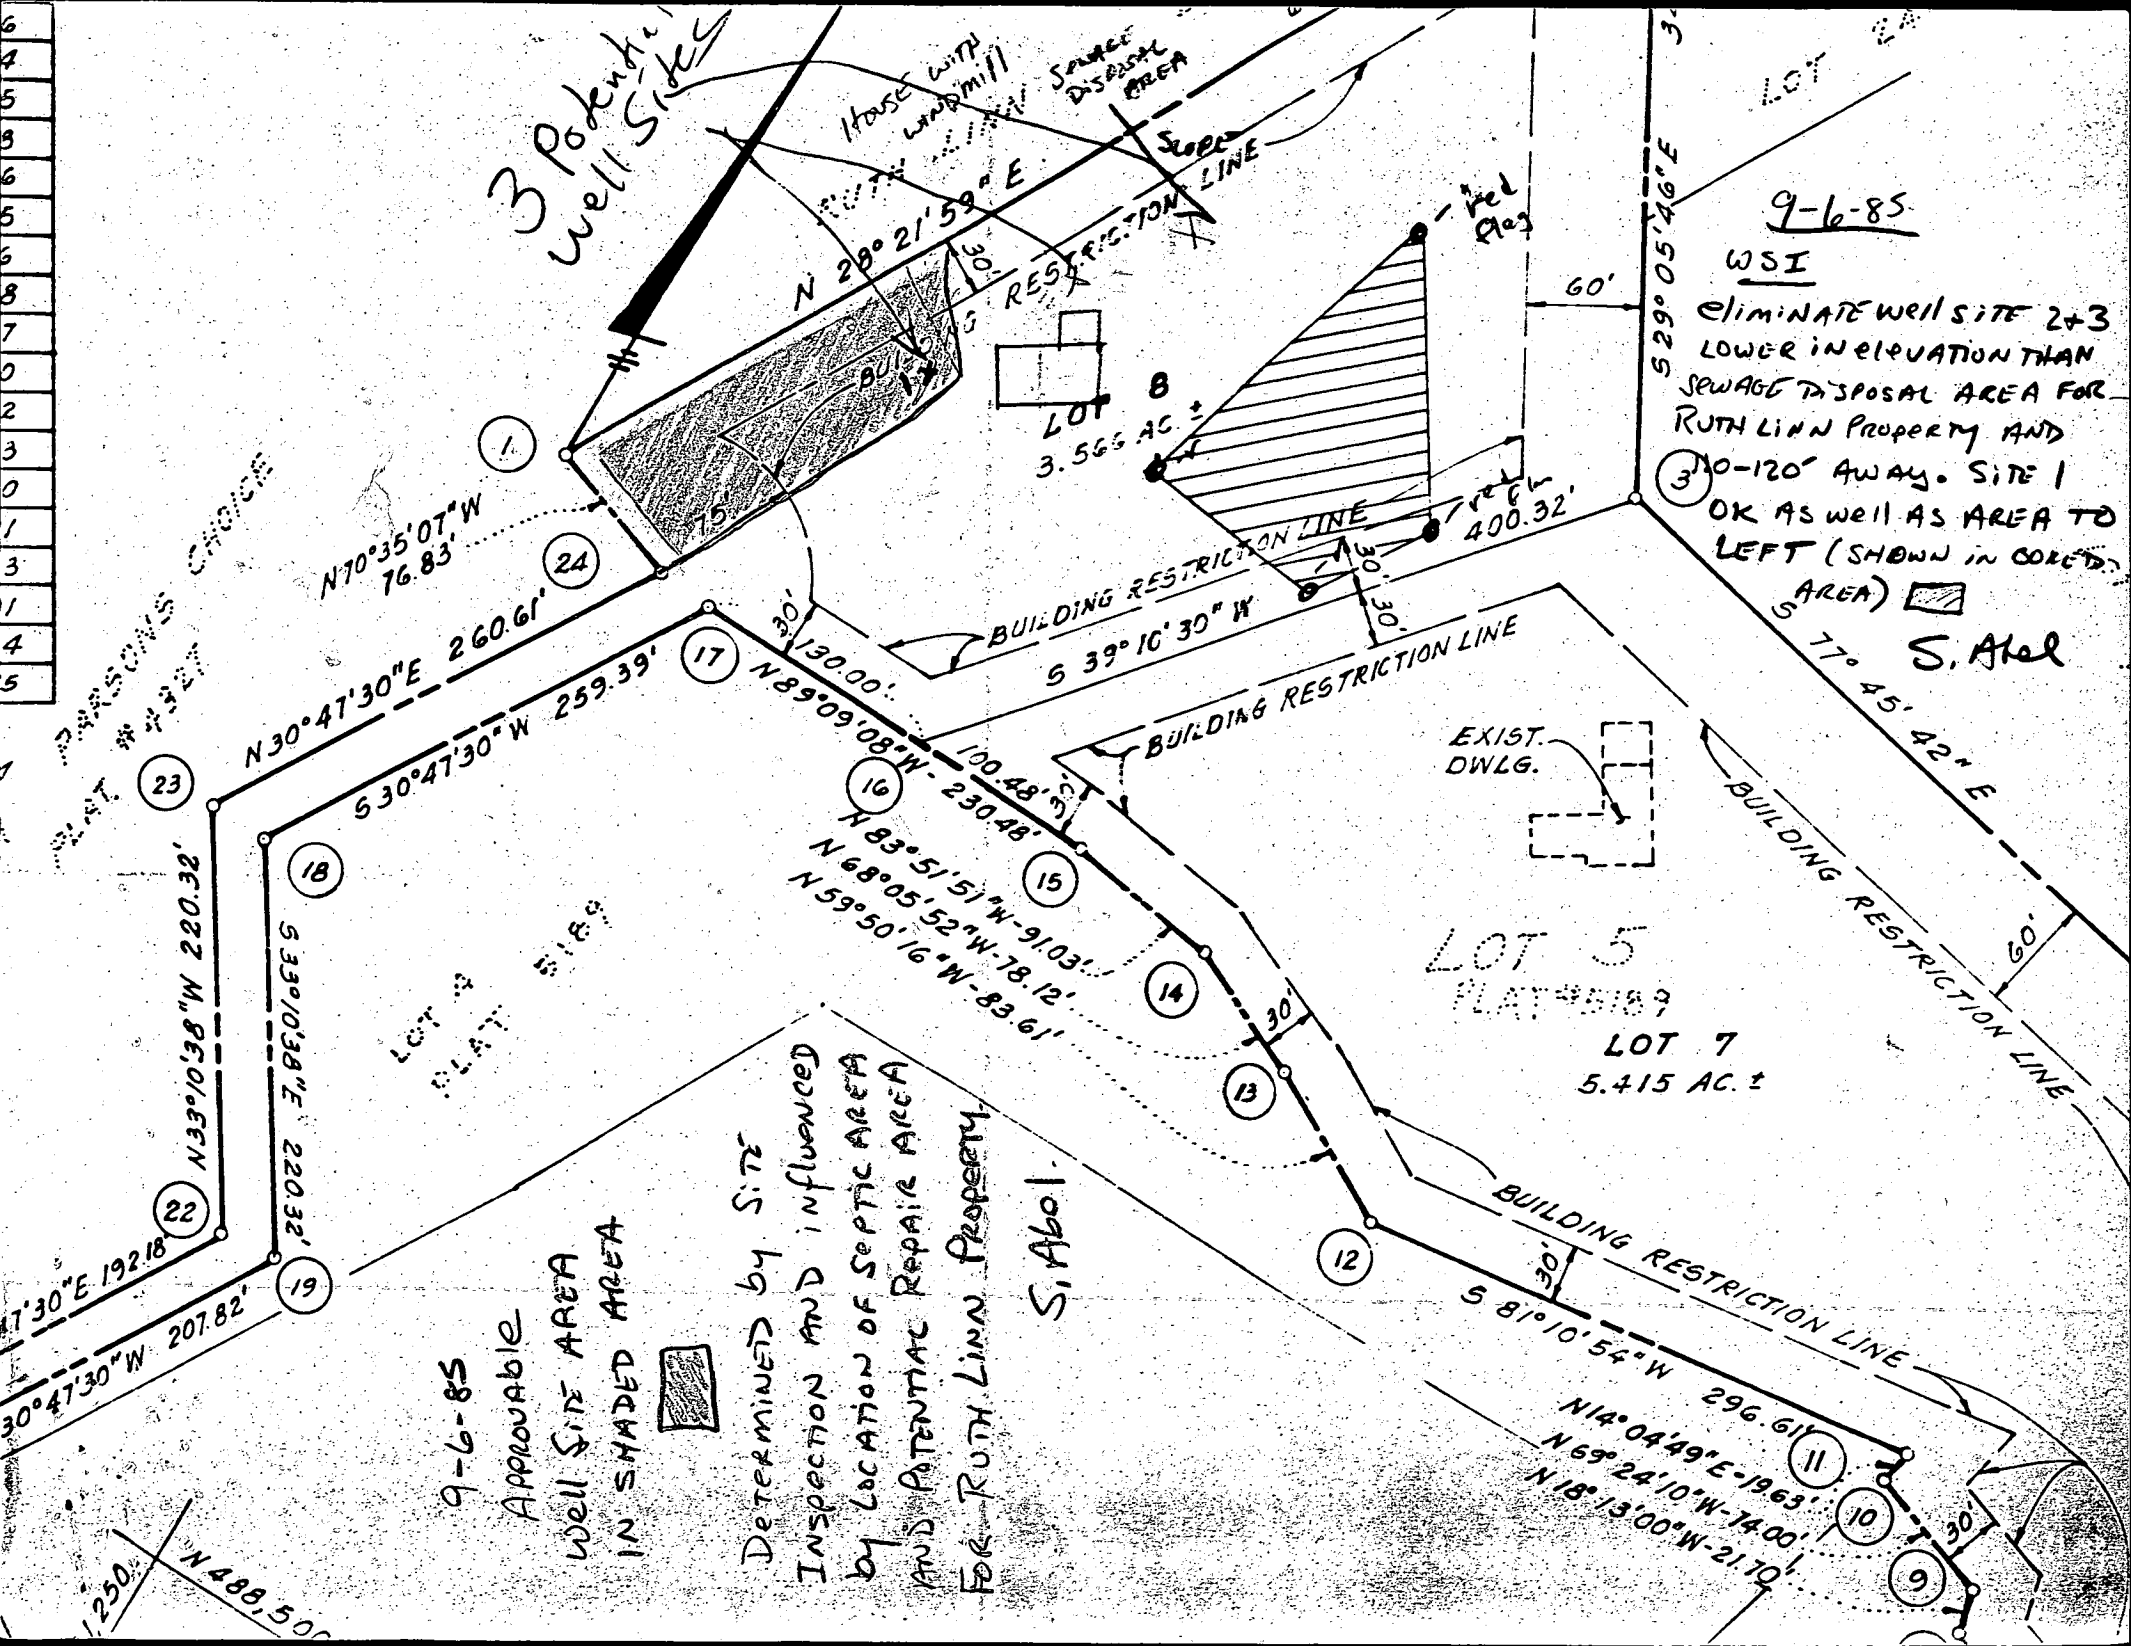

LOT 2A

PRIVATE WELL

LOT 6

346.20'
S 29° 5' 46" E

EX. 60' B.R.L.

(TYP) DRAIN FIELD

EX. SEPTIC TANK

EX. SEPTIC

RESERVE

AREA

H.O. Signed
ON
10-7-85

(Result of LOT 6)

Lots 5, 7, & 8

EX. 30' B.R.L.

EX. WELL

FENCE DATA:
4' HIGH POST/RAIL
FENCE AS PER CODE
(BY M.P.I.)

64.75'
N 28° 21' 59" E

LOT 8

3.56 AC ±

EX. 75' B.R.L.

76.83'
N 70° 35' 7" W

130.00'
N 89° 9' 8" W

Signed Final
F-85-108

11/7/86

BP#8809

N. 28°21'59"E.

664.75'

Ex
O Well

624

30' BRL

620

620

618

619

FF 620.58

BF 613.2

600

Septic
Tank

Pipe

606

STEEL PIPE
OR SILT PILE

Trench #1

Trench #2

130' BRL

60' BRL

846.20'

LOT 24

LOT #8
566 Ac.

S. 39°10'30"W.

400.32'

S. 29°05'46"E.

LOT 6

