

PERMIT

SEWAGE DISPOSAL SYSTEM

DEPARTMENT OF HEALTH AND MENTAL HYGIENE

HOWARD COUNTY HEALTH DEPARTMENT

BUREAU OF ENVIRONMENTAL HEALTH

~~461-9933~~ 313-2640

INDEXED

DATE SYSTEM APPROVED

INSPECTOR

P 50297

A 29665

DISTRICT 3rd

DATE 9/24/94

10/21/94

C. Williams

03-308332

Paul Schissler/South Carroll Backhoe

IS PERMITTED TO INSTALL ☒ ALTER ☐

ADDRESS 4410 Salem Bottom Road, Westminster, Maryland 21157 PHONE 875-4197

SUBDIVISION Slack Estates LOT 15 ROAD 1955 St. James Road

PROPERTY OWNER David & Kelly Fields

ADDRESS

BUILDING PERMIT SIGNED

SEPTIC TANK CAPACITY 1500 GALLONS

AND RETURNED

NUMBER OF BEDROOMS 5

3-1203 800/140644-16 POC

200 SQUARE FEET PER BEDROOM

LINEAR FEET OF TRENCH REQUIRED 200

TRENCHES - Trench to be 2 feet wide. Inlet 1 1/2 feet below original grade. Bottom maximum depth 8 1/2 feet below original grade. Effective area begins at 3 1/2 feet below original grade. 5 feet of stone below distribution pipe.

LOCATION - Place the distribution box 110 feet from the front lot line and 65 feet from the left lot line as seen when facing the property from St. James Road. Run trenches on contour in both directions.

NOTES - No trench to exceed 100 feet in length. Provide 6" - 8" diameter cleanout and cap to grade or above on septic tank. OK 3/30/94 DKS

PLANS APPROVED BY C. Williams/Mark Rifkin

REVISED DATE 3/08/94

COVER NO WORK UNTIL INSPECTED AND APPROVED

NEITHER THE HOWARD COUNTY COUNCIL NOR THE HEALTH DEPARTMENT IS RESPONSIBLE FOR THE SUCCESSFUL OPERATION OF ANY SYSTEM

NOTE: CLEANOUT REQUIRED EVERY 70 FEET OF SEWER LINE AND/OR AT 90° SWEEPS IN LINES FROM HOUSE TO DRAIN FIELDS, 90° ELBOWS NOT ACCEPTABLE.

NOTE: ALL PARTS OF SEPTIC SYSTEMS (I.E. TANK, DISTRIBUTION BOX TRENCHES) TO BE 100 FEET FROM WELL (UNLESS OTHERWISE SPECIFICALLY AUTHORIZED)

NOTE: IF DEEP TRENCH(ES) ARE USED CALL FOR INSPECTION BEFORE AND AFTER PLACING GRAVEL IN TRENCH(ES)

NOTE: NO DRY WELL SHALL EXCEED 15 FOOT IN DIAMETER NO ABSORPTION TRENCH TO EXCEED 100 FEET IN LENGTH

NOTE: ALL PIPE FROM HOUSE TO SEPTIC TANK MUST BE CAST IRON OR SCHEDULE 35/40 PVC OR ABS

PERMIT VOID AFTER TWO YEARS

NOTE: INSTALL STAND PIPE ON SEPTIC TANK AND DRY WELL STAND PIPES MUST BE 6 INCHES IN DIAMETER CAST IRON. CONCRETE OR TERRA COTTA OR PVA OR ABS ACCEPTED. IF TOP OF SEPTIC TANK IS DEEPER THAN 3 FEET. MANHOLE TO GRADE REQUIRED.

NOTE: DISTRIBUTION BOXES MUST HAVE BAFFLES

***INSTALLER IS RESPONSIBLE FOR OBTAINING FINAL APPROVAL ON THIS PERMIT**

HD-260(6-90)


*CALL 461-9933 FOR INSPECTION OF SEPTIC SYSTEM.

BLDG. PERMIT SIGNED

AND RETURNED 5-29-96

Serial # Bcc 100 285

A 29665

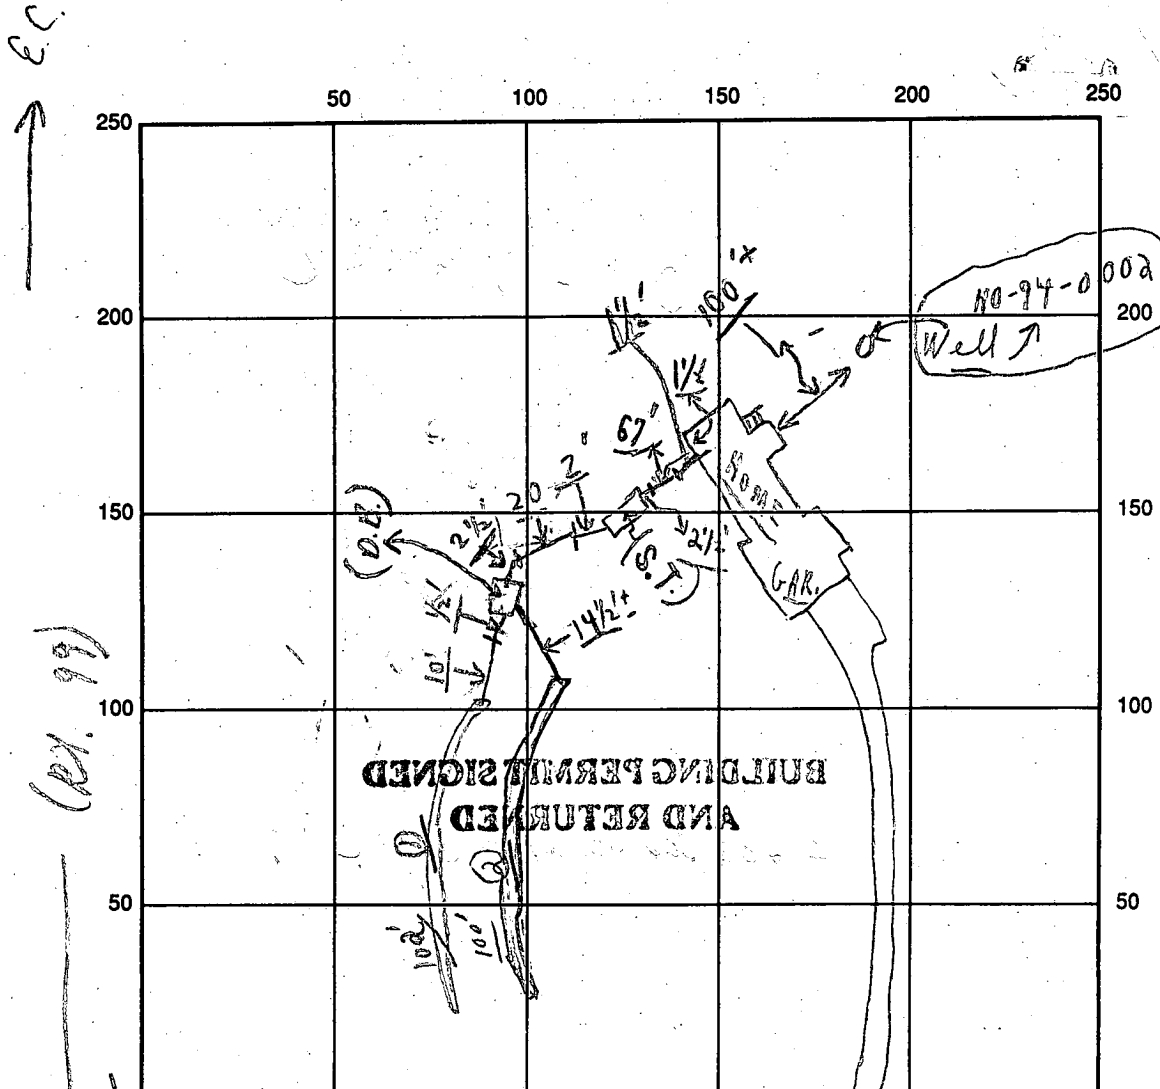

INDICATE NORTH - NAME ADJOINING ROADWAY AS BASE LINE

1500 (ST. JAMES ROAD)

SEPTIC TANK LEVEL OK CLEANOUTS OK

DISTRIBUTION BOX LEVEL OK (Ball does in) me

DRAIN FIELD/TITLE DEPTH 9 1/4 FT. average TRENCH WIDTH 2 FT. INLET DEPTH 4 1/2 FT.

EFFECTIVE GRAVEL DEPTH $\frac{(2)}{8\frac{1}{2} + 0 + 2} = 5$ FT. TOTAL LENGTH $\frac{(1) 102 + (2) 100}{3\frac{1}{2}} = 202$ FT. } = 202

NUMBER OF TRENCHES 2 ONE SIDEWALL/BOTTOM AREA 1010⁺ SQ. FT.

DRYWALL INSIDE DIAMETER 3 FT. EFFECTIVE DEPTH BELOW INLET 1 FT.

ABSORBENT AREA 1.010⁴ SQ. FT.

REMARKS: ^{10/21} Partial (P.M.) - ok. for stone in #1 throat area - 64' + deep of the cover
from home to D. Bates only
10/21 - Later on to cover all of #1 throat and close #2 up
at as go; chs 10/21 Late P.M. Final - ok to cover all work,
chs

Note (W.P.I. done personally)

DATE SYSTEM APPROVED 10/21/94 INSPECTOR Charles B. Baker

APPLICATION

SEWAGE DISPOSAL TESTING

STATE OF MARYLAND - DEPARTMENT OF HEALTH AND MENTAL HYGIENE

HOWARD COUNTY HEALTH DEPARTMENT
ENVIRONMENTAL HEALTH SERVICES

P.O. BOX 476 ELLICOTT, MARYLAND 21043
TELEPHONE: 992-2330

A 29665

P _____

Septic tank { 1-3 Bedrooms 1000 gallons
4 Bedrooms 1250 gallons

DISTRICT 3rd
DATE 4/3/79

*effective absorbent sidewalk area per bedroom below
mtd. depth to be 3 1/2' below original ground level
grade and maximum depth 10' from front property line
when facing lot from St. James Road.*

TO: THE COUNTY HEALTH OFFICER
ELLICOTT CITY, MARYLAND

I HEREBY APPLY FOR THE NECESSARY TEST IN ORDER TO CONSTRUCT (OR RECONSTRUCT) A SEWAGE DISPOSAL SYSTEM.

PROPERTY OWNER Slack property SLACK ESTATES

ADDRESS (David + Kelly Fields)

*+10' Dry Well + Trench. If
trench used - need:*
(1) 5' earth buffer
between trench & dry well
Mr. Young, Security Develop-
ment - 465-4244

PROPERTY LOCATION:

SUBDIVISION

(2) 2 inspections of trench
before and after stone
15 in.

ROAD AND DESCRIPTION

Route 99 1955 ST JAMES RD

LOT NO.

(3) Run trench on contour.

SIZE OF LOT 3 acres m/1

TYPE BLDG. 3 or 4 bedrooms

THE SYSTEM INSTALLED UNDER THIS APPLICATION IS ACCEPTABLE ONLY UNTIL PUBLIC FACILITIES BECOME AVAILABLE.

I FULLY UNDERSTAND THE FEE CONNECTED WITH THE FILING OF THIS PERC TEST APPLICATION IS NON-REFUNDABLE UNDER

ANY CIRCUMSTANCES.

SIGNATURE OF APPLICANT /s/ Stewart Young for Security Development

APPROVED BY C. B. Shaker FOR Dry well + Trench DATE 12/29/80

REJECTED BY _____ FOR _____ DATE _____

HOLD PENDING FURTHER TESTS _____ DATE _____

REASONS FOR REJECTION OR HOLDING

4/24/79 depending on certification of poles.



BLDG PERMIT SIGNED
AND RETURNED 3/8/94
Serial # 52717
SFD-5Bm

THIS IS NOT A PERMIT

15

Field
sheet
Tests
per
stake

SOIL PROFILE

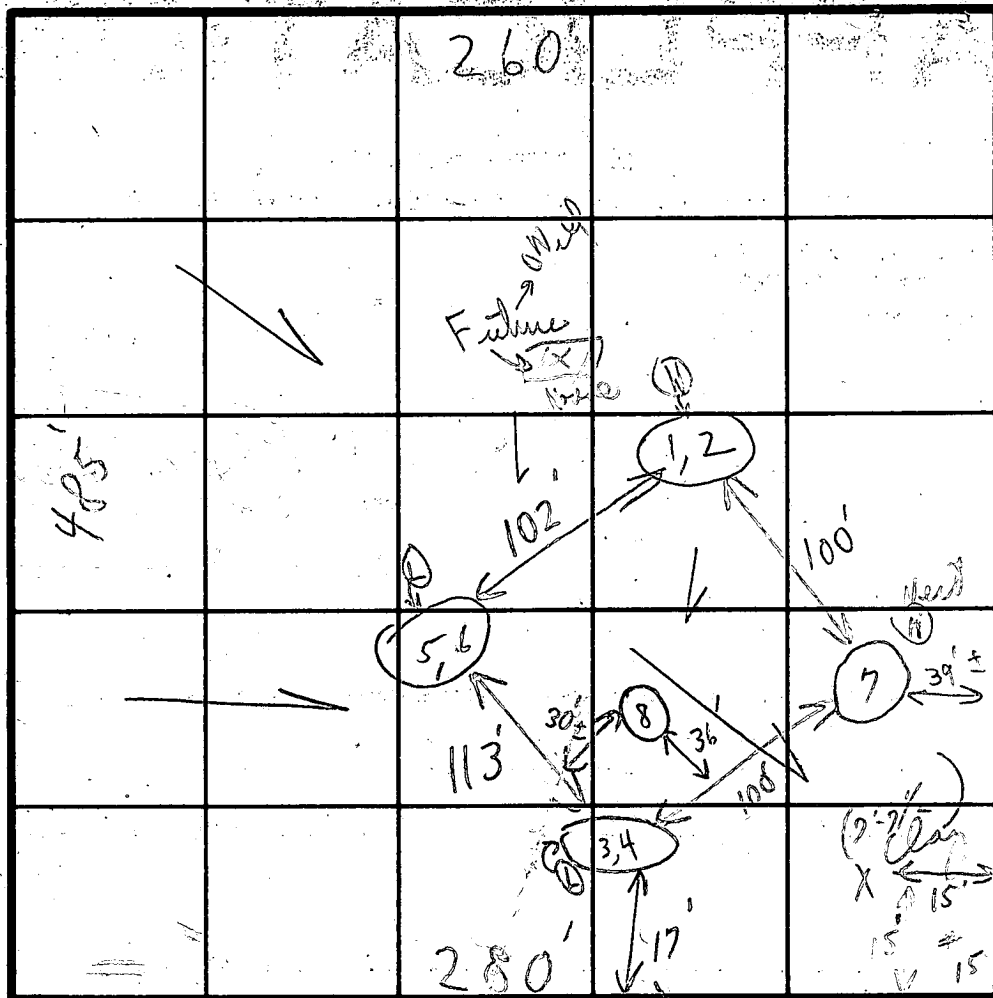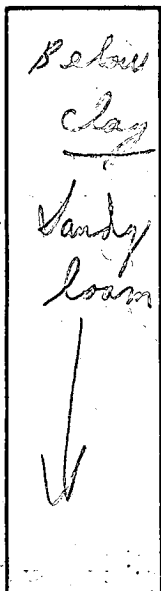

480'

INDICATE NORTH - NAME ADJOINING ROADWAY AS BASE LINE

Unimproved Road

DATE	TEST NO.	DEPTH	PRE-WET		TEST - 1" DROP		TIME
			START	STOP	START	STOP	
4/19/79	1	3 1/2'	12:02	12:04	12:04	12:06	2 in
	2	13 1/2'	12:02	12:04	12:04	12:08	4 in
	3 A	4'	11:35	11:39	11:39	11:47	8 in
	④ 4 A	12 1/2'	11:35	11:39	11:39	11:47	8 in
	⑤ A	5'-6"	11:49	11:	11:	11:	
	6	14'	11:49	11:52	11:52	11:59	7 in
	7	5'-12 1/2'	Visual - loam				
	5 B	6 1/2'	12:16	12:19	12:19	12:46	27 in
	Middle Lower 8	13'	Visual - loam - bottom clay - dry				
						6 56	

135 sq. ft.
effective
absorbent
sidewalk
reservoir
lined
3 1/2'
Maximum
depth 10 1/2'
overlaid
6" loam
mud

REMARKS

Tests in open field

Tests in redeveloped area

TYPE OF SOIL

TESTED BY

C. B. S.

ALSO PRESENT

S. P. Schickel
+ son

B 1 08794 (THIS NUMBER IS TO BE PUNCHED IN COLS. 3-6 ON ALL CARDS)	SEQUENCE NO. (DP USE ONLY)	STATE OF MARYLAND PERMIT TO DRILL WELL please print or type	STATE PERMIT NUMBER HD-94-0002 fill in this form completely
Date Received (APA) 01/12/94 OWNER INFORMATION FIELDNS KELLY 25 TIMBERL SKEWER ROAD OWINGS MILLS MD 21117 Town: Owings Mills State: MD Zip: 21117		B 3 LOCATION OF WELL HOWARD SLACK ESTATES SECTION 44 46 LOT 48 50 52 NEAREST TOWN MILES FROM TOWN (enter 0 if in town) 1.4 MI	
DRILLER INFORMATION DANA KIKER II Driller's Name: Dana Kiker II Firm Name: Westminster Pottery Well Drilling Address: P.O. Box 861 Westminster, MD 21158 Signature: Dana Kiker II Date: 1/10/94 77 License No. 80		B 4 DIRECTION OF WELL FROM TOWN (CIRCLE BOX) NEAR WHAT ROAD RIVER ROAD ST. ANNE'S Rd ON WHICH SIDE OF ROAD (CIRCLE APPROPRIATE BOX) DISTANCE FROM ROAD 80 FT	
B 2 WELL INFORMATION APPROX. PUMPING RATE (GAL. PER MIN.) 5 AVERAGE DAILY QUANTITY NEEDED (GAL. PER DAY) 150		USE FOR WATER (CIRCLE APPROPRIATE BOX) ☒ HOME (SINGLE OR DOUBLE HOUSEHOLD UNIT ONLY) ☐ FARMING (LIVESTOCK WATERING & AGRICULTURAL IRRIGATION) ☐ INDUSTRIAL, COMMERCIAL, STATE AND FEDERAL GOV. OTHER (REQUIRES APPROPRIATION PERMIT) ☐ PUBLIC OR PRIVATE WATER COMPANY (REQUIRES APPROPRIATION PERMIT AND STATE HEALTH DEPARTMENT APPROVAL) ☐ TEST, OBSERVATION, MONITORING (MAY REQUIRE APPROPRIATION PERMIT)	
APPROXIMATE DEPTH OF WELL 250 FEET APPROXIMATE DIAMETER OF WELL 6 INCH		NOT TO BE FILLED IN BY DRILLER HEALTH DEPARTMENT APPROVAL Howard COUNTY NAME STATE SIGNATURE DATE ISSUED 01/25/94 CO SIGNATURE Mark E. Riffin 1/25/95 NORTH GRID 541000 EAST GRID 0816000	
METHOD OF DRILLING (circle one) BORED (or Augered) JETTED Jetted & DRIVEN AIR-ROTARY AIR-PERCussion ROTARY (Hydraulic Rotary) CABLE REVERSE-ROTARY Drive-POINT other		SHOW MAJOR FEATURES OF BOX & LOCATE WELL WITH AN X SOURCES OF DRILLING WATER 1. City WRITE THE BOX NUMBER FROM THE MAP HERE 8186 5481	
REPLACEMENT OR DEEPEINED WELLS (CIRCLE APPROPRIATE BOX) ☒ THIS WELL WILL NOT REPLACE AN EXISTING WELL ☐ THIS WELL WILL REPLACE A WELL THAT WILL BE ABANDONED AND SEALED ☐ THIS WELL WILL REPLACE A WELL THAT WILL BE USED AS A STANDBY ☐ THIS WELL WILL DEEPEIN AN EXISTING WELL PERMIT NUMBER OF WELL TO BE REPLACED OR DEEPEINED (IF AVAILABLE)		DRAW A SKETCH BELOW SHOWING LOCATION OF WELL IN RELATION TO NEARBY TOWNS AND ROADS AND GIVE DISTANCE FROM WELL TO NEAREST ROAD JUNCTION. 	
Not to be filled in by driller (OEP USE ONLY)			
APPROP. PERMIT NUMBER GAP FORCE MR WRITE INITIALS IN BOX PERMIT No. HD-94-0002 SPECIAL CONDITIONS Vicki - 876-1911 or Kelly Fielden 581-2245/356-4617 Real for 997-9676			

10/14/94
Anytime

HOWARD COUNTY HEALTH DEPARTMENT
Bureau of Environmental Health
3525-H Ellicott Mills Drive
Ellicott City, MD 21043
461-9933

APPLICATION FOR PITLESS ADAPTER, WELL PUMP AND PRESSURE TANK INSTALLATION

New Installation ☒
Replacement ☐

Receipt # _____
Date 10/13/94

Name of Installer ROBERT L. FEEVER CO.

Telephone 701-4655

License Number 2122

Certified Well Pump Installer ☒ Well Driller ☐ Registered Plumber ☒

Name of Property Owner M/M MRS. DAVID FIELDS Telephone 795-1425

Subdivision SLICES CORNER Lot # 15 Well Tag # HO-94-0002

Site Address 1955 ST. JAMES RD.

Pump

1. Type
 - a. Deep well jet _____
 - b. Shallow well jet _____
 - c. Submersible ☒
2. Make FLINTAWALLING
3. Model # 4405605-301
4. Capacity 5 GPM
5. Pump exceeds well capacity Yes ? No
6. If Yes, is low pressure cutoff switch installed? Yes No
7. What methods are used to protect the pump and electrical wiring from vibrations? Torque arrestors Cable guards ☒ Other

Motor

1. Horsepower 1/2
2. RPM 3455
3. Voltage
 - a. 110
 - b. 220 ☒

Pitless Adapter

1. Make HAC/MS
2. Model # PT200
3. Depth 42"

Tank WX203 CAPTIVE

1. Capacity 32 GALS.
2. Pressure relief valve? YES

Piping

1. Type Poly.
2. Size 1"
3. NSF and/or BOCA Code approved ☒
4. Depth of supply line 42"

Well data

1. Depth 252 ft.
2. Yield GPM
3. Static water level ft.
4. Will water supply be disinfected by installer? YES

I understand that it is my responsibility to notify the Howard County Health Department when the installation is ready for inspection (otherwise this permit is null and void).

All information given above is true to the best of my knowledge.

Signature of Applicant: [Signature]

Date: 10/13/94

Note: A sticker indicating approval/status of the installation will be placed on the well casing at the time of the inspection.



HOWARD COUNTY HEALTH DEPARTMENT

Joyce M. Boyd, M.D., County Health Officer

April 17, 1995

Mr. and Mrs. David Fields
1955 St. James Road
Marriottsville, MD 21104

RE: Slack Estates, Lot #15
1955 St. James Road
Well Permit #HO-94-0002

Dear Mr. and Mrs. Fields:

This is to advise you that the septic system was installed, inspected, and approved on October 21, 1994.

The water sample recently submitted for testing was free of coliform and fecal coliform bacteria at the time of sampling and is bacteriologically safe for drinking.

A nitrate device has been installed to treat the previously documented excessive nitrate contamination. The nitrate removal system appears to be operating properly as evidenced by the recent water sample taken on March 30, 1995.

COMAR 26.04.04.09 prohibits approval of any water supply with a nitrate-nitrogen contaminant level in excess of 10 parts per million. This department will grant a Permanent Deviation to that section of the regulation on condition that the nitrate removal system effectively maintains the nitrate-nitrogen contaminant level below the 10 parts per million requirement.

FINAL CERTIFICATE OF POTABILITY

This certifies that all sampling requirements of COMAR 26.04.04 "Well Regulations" have been met for the water supply system installed under permit(s) #HO-94-0002. It will be necessary for you to continue to comply with the following conditions:

1. The system must be properly operated and maintained continuously, in accordance with the service contract for the life of the residence.
2. It is recommended that a yearly nitrate analysis be performed.
3. If you decide to sell or rent your home in the future, you must make any potential buyer/tenant aware of the above condition.


Dates of Water Sampling:

March 30, 1995
November 18, 1994

Date of Well Acceptance:

February 4, 1994

Approving Authority

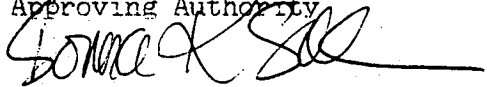

Donna K. See, Sanitarian
Water and Sewerage Program

DKS

NOTE: BSM.T. SEWAGE SERVICE
WILL REQUIRE USE OF
EJECTOR PUMP.

Approved Septic System Plan
Howard County Health Department


Mark E. Kelkin
Signature

3/8/94
Date

MARYLAND ROUTE 99
VEHICULAR INGRESS & EGRESS IS RESTRICTED --
982° 01' 00" E 453.07'

TRENCHES
TYPICAL --
ACTUAL
LENGTH
DETERMINED
BY H.D.

N 52° 59' 00" E
35.35'

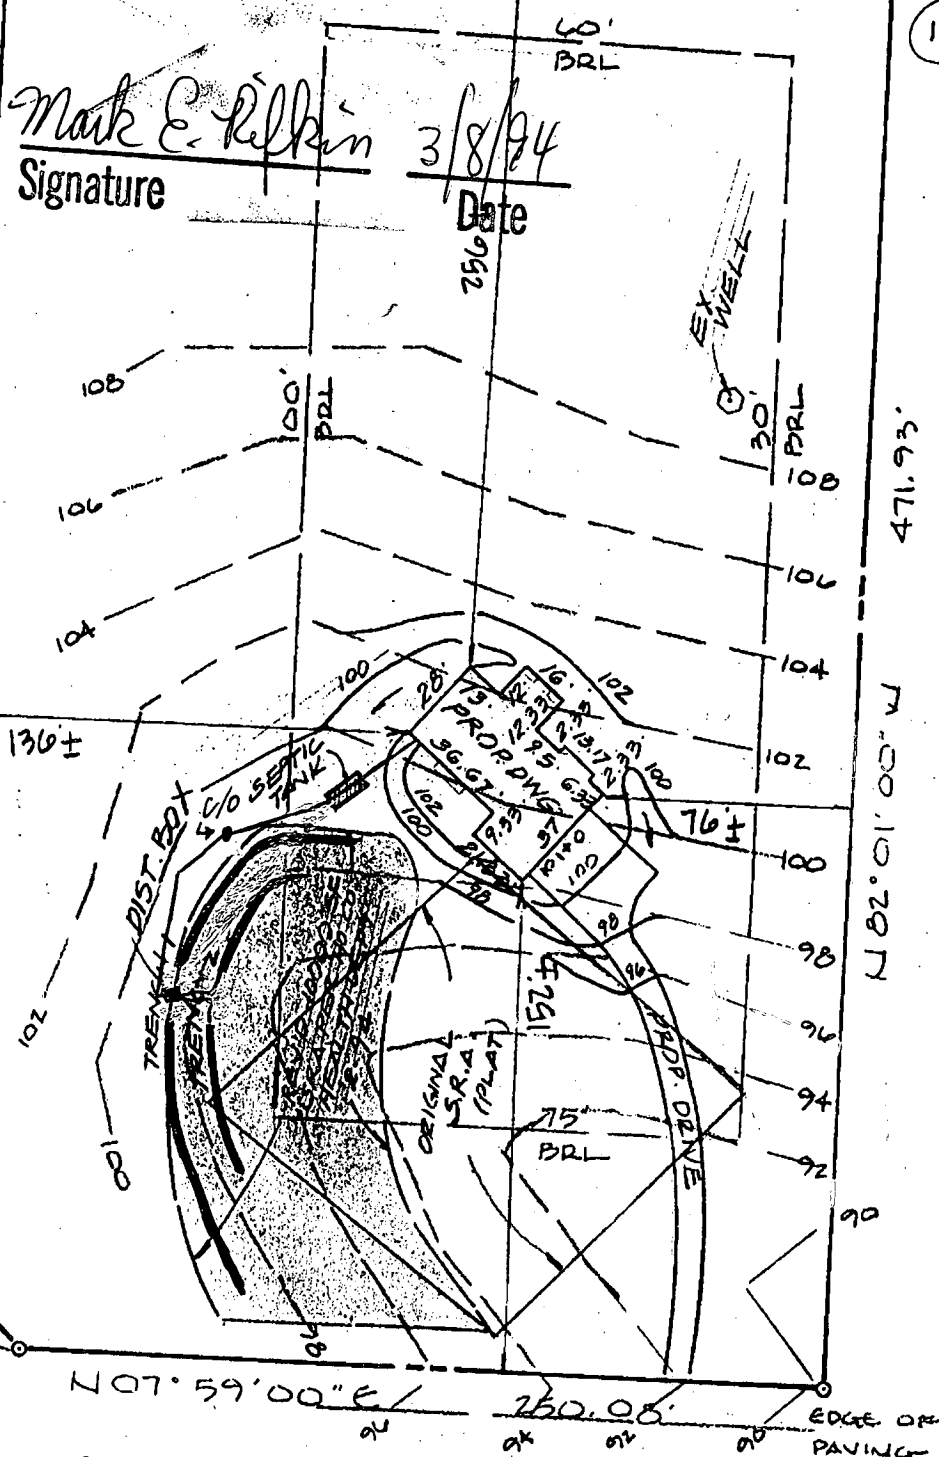

NOTE: BY COPY OF THIS PLAN THE HEALTH DEPT.
ACCEPTS THIS MODIFICATION TO THE RECORDED
SEWAGE DISPOSAL EASEMENT.

FF PROP. 104°
INV. OUT HS. 97.6
INV. IN TANK 97.1 (EX. 99)
INV. OUT TANK 96.9
INV. IN BOX 95.2 (EX. 98.5)
INV. IN TR. 1 95.0 (EX. 98.5)
~~INV. IN TR. 2 95.0 (EX. 98.5)~~
EX. WELL EL. 109


CONTRACTOR SHALL PROVIDE POSITIVE DRAINAGE
AWAY FROM FOUNDATION AT ALL TIMES.

ST. JAMES ROAD
"50' R/W"

TOPOGRAPHY
HEREON FIELD
RUN 2-94
(ASSUMED DATUM)
SITE PLAN

LOT 15, FINAL PLAT
"SLACK ESTATES"
(4736)
3RD ELEC. DIST.
HO. CO., MD

REV.
3-7-94

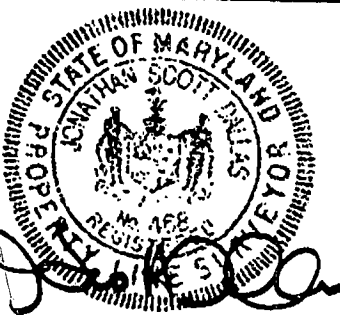

LOT 15, ST. JAMES ROAD

J.S. DALLAS, INC.

Surveying & Engineering

4932 Hazelwood Avenue Baltimore, Md. 21206
(410) 866-2001


Date: 1/26/94

Scale: 1" = 60'

Job Number: 86-107
P156

Drawn By: TE

Checked By: USD

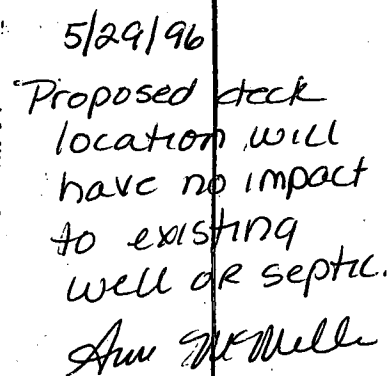


** "PANEL NOT PRINTED
AREA IN ZONE C"

LOT 15. FINAL PLAT
SLACK ESTATES
(4736)
3RD EL. DIST. HD. CO., MD.

Drawn By: VSD.



-- VEHICULAR INGRESS & EGRESS IS RESTRICTED --

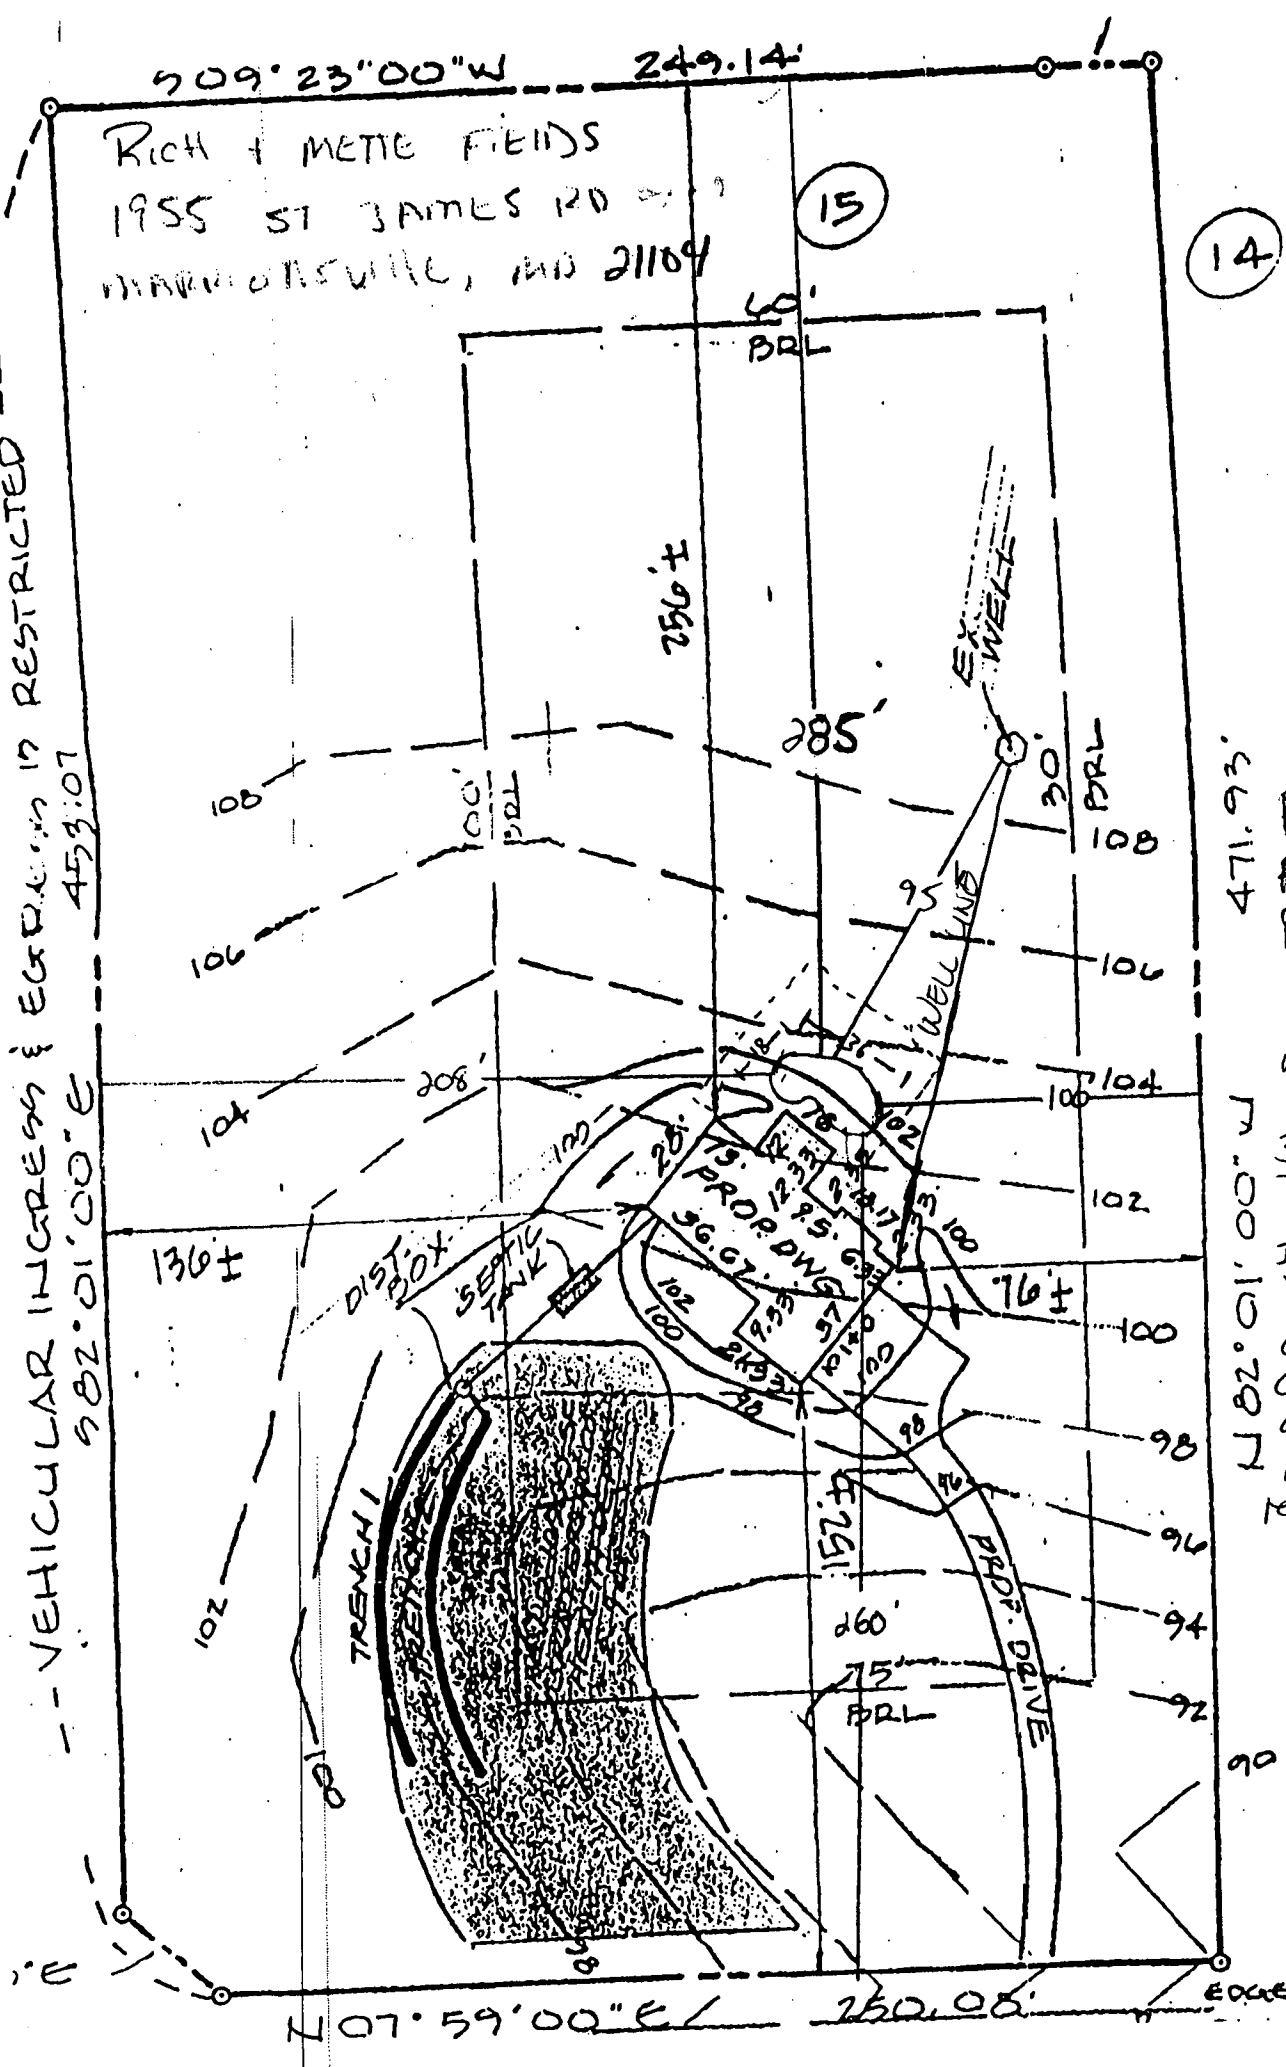

SETBACK
REAR 285'
FRONT 152'
RIGHT 100'
LEFT 208'
well 95'
3/12/03
Pool loc. O.K.
If well line
is struck
during construction
Contractor will
assume all
liability & be
responsible for
repair JB
1" = 60'

HOWARD COUNTY
PERMIT APPLICATION

PERMIT NUMBER

1300140644

Building Address 1955 ST JAMES RD
MARYLAND MD 21104

Suite/Apt. #: --- SDP/WP/Petition #: ---

Census Tract 6030 Subdivision SLACKS ESTATES

Section --- Area --- Lot 15

Tax Map 9 Parcel 319 Grid 24

Zoning RR Map Coordinates 5D13 Lot size ---

Existing Use N/A Single Family Home

Proposed Use 18x36 INGROUND POOL

Estimated Construction Cost \$ 20,000.00

Description of Work INSTALL 18x36 INGROUND

CONCRETE POOL ALUMINUM FENCING/SLIDED

BY TRAILER TRUCK. 3/2-8

Occupant or Tenant owner

Contact Name ---

Address ---

City --- State --- Zip Code ---

Phone --- Fax ---

Property Owner's Name BILL + MENE FIELDS

Address 1955 ST JAMES RD

City MARYLAND State MD Zip Code 21104

Home Phone 410-442-5164 Work Phone ---

Applicant's Name & Mailing Address, (if other than stated hereon):

SAME

Phone --- Fax ---

Contractor Company ELITE POOLS

Contact Person Bill Hubert

Address 3525 C SOPPA RD

City BALTIMORE State MD Zip Code 21234

License No. 120906

Phone 410-663-7946 Fax 410-665-8571

Engineer or Architect Company ---

Contact Person ---

Address ---

City --- State --- Zip Code ---

Phone --- Fax ---

BUILDING DESCRIPTION - COMMERCIAL

BUILDING DESCRIPTION - RESIDENTIAL

Building Characteristics

Utilities

Height: ---

No. of stories: ---

Gross area, sq. ft. per floor: ---

Use group: ---

Construction type:

--- Reinforced Concrete

--- Structural Steel

--- Masonry

--- Wood Frame

--- State Certified Modular

Water Supply:

--- Public

X Private

Sewage Disposal:

--- Public

X Private

Electric Yes X No ---

Gas Yes --- No X

Heating System:

Electric X Oil ---

Natural Gas ---

Propane Gas ---

Sprinkler system: N/A ---

--- Full

--- Partial

--- Other Suppression

--- # of Heads

Building Characteristics

Utilities

SF Dwelling --- SF Townhouse ---

--- Depth --- Width ---

1st floor: ---

2nd floor: ---

Basement: ---

Finished Basement --- Unfinished Basement ---

Crawl space --- Slab on Grade ---

No. of Bedrooms: ---

Multi-family dwellings:

No. of efficiency units: ---

No. of 1 BR units: ---

No. of 2 BR units: ---

No. of 3 BR units: ---

Other Structure: ---

Dimensions: ---

Footings: ---

Roof: ---

--- State Certified Modular

--- Manufactured Home

Water Supply:

--- Public

X Private

Sewage Disposal:

--- Public

X Private

Electric Yes --- No ---

Gas Yes --- No ---

Heating System:

Electric --- Oil ---

Natural Gas ---

Propane Gas ---

Sprinkler system: N/A ---

--- NFPA #13D

--- NFPA #13R

--- Other:

THE UNDERSIGNED HEREBY CERTIFIES AND AGREES AS FOLLOWS: (1) THAT HE/SHE IS AUTHORIZED TO MAKE THIS APPLICATION; (2) THAT THE INFORMATION IS CORRECT; (3) THAT HE/SHE WILL COMPLY WITH ALL REGULATIONS OF HOWARD COUNTY WHICH ARE APPLICABLE THERETO; (4) THAT HE/SHE WILL PERFORM NO WORK ON THE ABOVE REFERENCED PROPERTY NOT SPECIFICALLY DESCRIBED IN THIS APPLICATION; (5) THAT HE/SHE GRANTS COUNTY OFFICIALS THE RIGHT TO ENTER ON TO THE PROPERTY FOR THE PURPOSE OF INSPECTING THE WORK PERMITTED AND POSTING NOTICES.

Applicant's Signature [Signature]

Title/Company ELITE POOLS INC.

Print Name WAD E. TODD

Date 3-12-03

Checks payable to: DIRECTOR OF FINANCE OF HOWARD COUNTY

** PLEASE WRITE NEATLY AND LEGIBLY. **

- FOR OFFICE USE ONLY -

AGENCY --- DATE --- SIGNATURE APPROVAL ---

--- Land Development, DPZ

--- State Highways

--- Building Official

--- Dev. Engineering, DPZ

--- Health

--- Fire Protection

Is Sediment Control approval required prior to issuance?

YES --- NO ---

CONTINGENCY CONSTRUCTION START: ---

ONE STOP SHOP: ---

DPZ SETBACK INFORMATION

Front: ---

Rear: ---

Side: ---

Side St.: ---

All minimum setbacks met?

YES --- NO ---

Is Entrance Permit required?

YES --- NO ---

Historic District?

YES --- NO ---

Lot Coverage for New Town Zone

SDP/Red-line approval date ---

PROPERTY ID# 17213

Filing fee \$ ---

Permit fee \$ 250

Excise tax \$ ---

Add'l per. fee \$ ---

TOTAL FEES \$ 250

Sub-total paid \$ ---

Balance due \$ ---

Check # 3883

Validation # 20780

Accepted by [Signature]

Distribution of Copies: White: Building Official Green: LDD, DPZ Yellow: DED, DPZ Pink: Health Gold: SHA