

PERMIT

SEWAGE DISPOSAL SYSTEM

MARYLAND STATE DEPARTMENT OF HEALTH*

HOWARD COUNTY

ELLICOTT CITY

DISTRICT 4th

INDEXED

DATE 1/2/80

William B. Martin

IS PERMITTED TO INSTALL ☒ ALTER

ADDRESS 3268 Route 94, Woodbine, Md.

PHONE 489-4983

SUBDIVISION _____ ROAD 3238 Route 94

LOT _____

PROPERTY OWNER William B. Martin

ADDRESS same as above

SPECIFICATIONS 4 bedrooms

SEPTIC TANK CAPACITY 1250 GALLONS

DRAIN FIELD _____ DEPTH _____ FEET, BOTTOM AREA _____ SQ. FT.

DEEP TRENCH _____ DEPTH _____ FEET, BOTTOM AREA _____ SQ. FT.

SEEPAGE PITS ☒ ABSORBENT SIDE-WALL AREA 195 SQ. FT. per bedroom in system. 420 sq. ft. in dry well.

INLET PIPE 4 FT. BELOW ORIGINAL GRADE. MAXIMUM DEPTH 11 FT. BELOW ORIGINAL GRADE

EFFECTIVE DEPTH AT _____ FT. BELOW ORIGINAL GRADE.

LOCATE DISPOSAL AREA 330 FT. FROM rear LOT LINE AND 360 FT. FROM right LOT LINE AS SEEN WHEN
FACING LOT FROM the road.

The dry well ~~will~~ be constructed 15'X15' square. Begin the trench 5 ft. from the edge
of the dry well. The trench will be dug 2 ft. wide, 55 ft. long, and contain 7 ft. of
stone. Trench to follow the contour of the land. Dry well to be located in percchhole #4-
property line measurements not exact.

PLANS APPROVED BY Bob DeMarco

DATE 1/2/80

COVER NO WORK UNTIL INSPECTED AND APPROVED.

NEITHER THE HOWARD COUNTY COUNCIL NOR THE HEALTH DEPARTMENT IS RESPONSIBLE FOR THE SUCCESSFUL OPERATION OF ANY SYSTEM.

NOTE: IF TRENCH IS USED CALL FOR INSPECTION BEFORE PLACING GRAVEL IN TRENCH.

NOTE: NO DRY WELL SHALL EXCEED 15 FOOT IN DIAMETER.


NOTE: ALL PIPE FROM HOUSE TO DISPOSAL AREA MUST BE CAST IRON.

PERMIT VOID AFTER THREE YEARS.

NOTE: INSTALL STAND PIPE ON SEPTIC TANK AND DRY WELL. STAND PIPES MUST BE 6 INCHES IN DIAMETER. CAST IRON, CONCRETE OR TERRA
COTTA ACCEPTED.

*INSTALLER IS RESPONSIBLE FOR OBTAINING FINAL APPROVAL ON THIS PERMIT.

A 29714

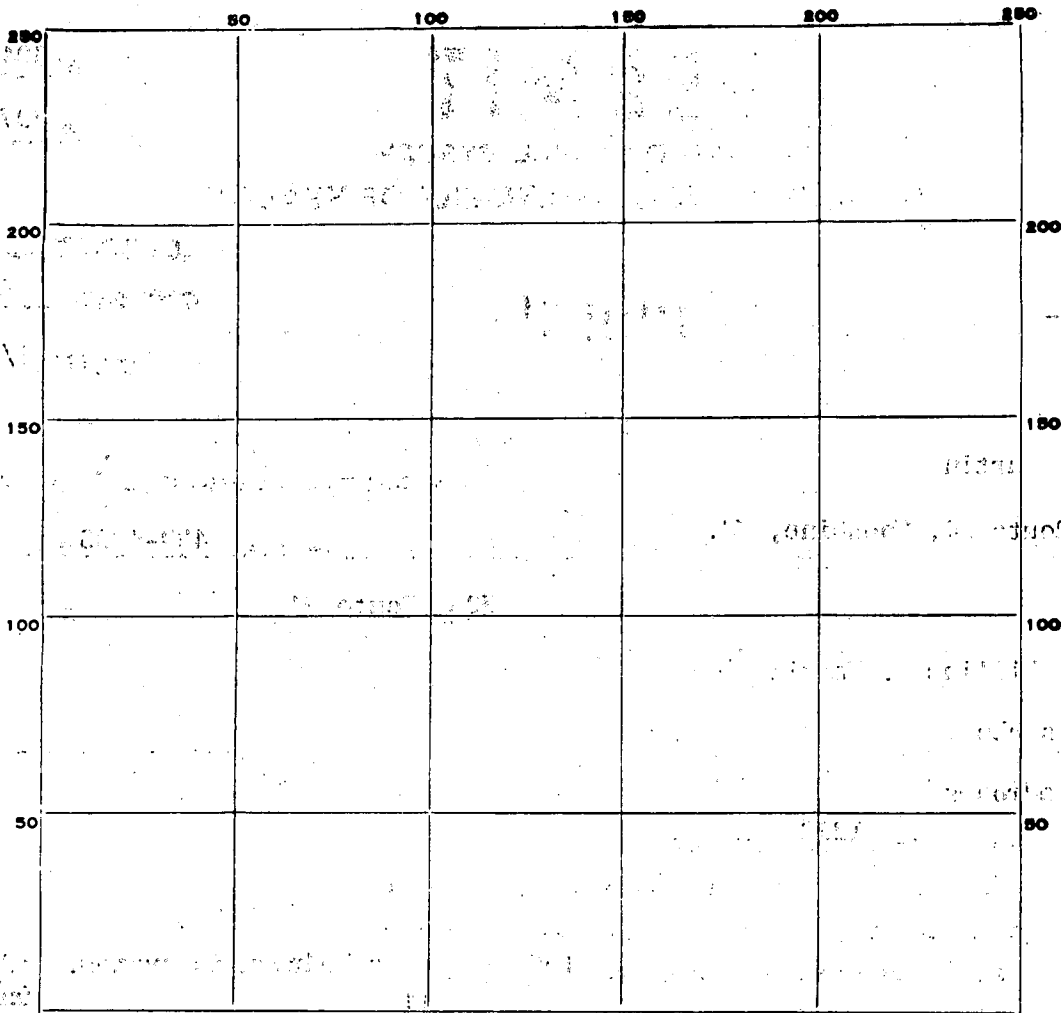

INDICATE NORTH. — NAME ADJOINING ROADWAY AS BASE LINE.

PERMIT CARD _____

SEPTIC TANK, LEVEL _____ CLEANOUTS _____

DISTRIBUTION BOX, LEVEL _____

TILE FIELD, DEPTH _____ FT. TRENCH WIDTH _____ FT.

GRAVEL DEPTH _____ IN. TOTAL LENGTH _____ FT.

NUMBER OF TRENCHES _____ TOTAL BOTTOM AREA _____

SEEPAGE PITS, INSIDE DIAMETER _____ FT. DEPTH BELOW INLET _____ FT.

ABSORBENT AREA _____ SQ. FT.

REMARKS _____

DATE SYSTEM APPROVED _____ INSPECTOR _____

Dry Well and Trench

Septic Tank

~~3 bedrooms - 1000 gallon~~

4 bedrooms - 1250 gallon

APPROX

APPROX

Locate the dry well 330 ft. from the REAR property line, and 360 ft. from the ^{75'}RIGHT property line as seen from the road. The invert will enter the dry well at 4 ft. below original grade and the maximum depth of the dry well will not exceed 11 ft. below original grade. The dry well will be constructed 15 ft. x 15 ft. square for a sidewall area of 420 sq. ft. Begin the trench 5 ft. from the edge of the dry well. The trench will be dug 2 ft. wide, 55 (4 bedroom) ft. long, and contain 7 ft. of stone. The trench will follow the contour of the land.

DRYWELL TO BE LOCATED IN PERC HOLE # 4 - PROP. LINE MEASUREMENTS NOT EXACT.

195 FT² PER BEDROOM

Two (2) inspections

APPLICATION

SEWAGE DISPOSAL TESTING

STATE OF MARYLAND - DEPARTMENT OF HEALTH AND MENTAL HYGIENE

HOWARD COUNTY HEALTH DEPARTMENT
ENVIRONMENTAL HEALTH SERVICES

P.O. BOX 476 ELLICOTT, MARYLAND 21043
TELEPHONE: 992-2330

A 29714

P _____

DISTRICT 4th

DATE 4/12/79

TO: THE COUNTY HEALTH OFFICER
ELLICOTT CITY, MARYLAND

I HEREBY APPLY FOR THE NECESSARY TEST IN ORDER TO CONSTRUCT (OR RECONSTRUCT) A SEWAGE DISPOSAL SYSTEM.

PROPERTY OWNER William B. Martin

ADDRESS 3268 Route 94, Woodbine, Md. 21797 PHONE 489-4983

PROPERTY LOCATION:

SUBDIVISION 3238 LOT NO. _____
ROAD AND DESCRIPTION Route 94

SIZE OF LOT 171 acres TYPE BLDG. 3 or 4 bedrooms

THE SYSTEM INSTALLED UNDER THIS APPLICATION IS ACCEPTABLE ONLY UNTIL PUBLIC FACILITIES BECOME AVAILABLE.

I FULLY UNDERSTAND THE FEE CONNECTED WITH THE FILING OF THIS PERC TEST APPLICATION IS NON-REFUNDABLE UNDER

ANY CIRCUMSTANCES.

SIGNATURE OF APPLICANT William B. Martin

APPROVED BY R. Dumarco FOR Wynell DATE 1/2/80

REJECTED BY _____ FOR _____ DATE _____

HOLD PENDING FURTHER TESTS _____ DATE _____

REASONS FOR REJECTION OR HOLDING _____

BLDG. PERMIT SIGNED
AND RETURNED 1/2/80
serial # 42192

THIS IS NOT A PERMIT

SOIL PROFILE

CLAY

SANDY
WITH
MICA

HOLE 1

CLAY

SANDY
CLAY

TOP SOIL

CLAY

SANDY
SOME
SMALL
1" L
ROCK

WOODED

HIGH HOLE



A hand-drawn diagram showing a hole in a wall. The wall is represented by a vertical line. To the left of the wall is the word 'WOODED'. To the right of the wall is a circle containing the number '4'. An arrow points from the text 'HIGH HOLE' to the circle. Another arrow points from the circle to the wall.

MAX 4' SLOPE
BETWEEN
ANY HOLES

WOOD
LINE

PROP LINE
OVER $\rightarrow$ 1,200

↓ PROP. LINE
OVER 1000

INDICATE NORTH - NAME ADJOINING ROADWAY AS BASE LINE

ROUTE 94

[illegible]

20 MIN.
AVG.

COPY OF PERC GIVEN TO WILLIAM MARTIN-OWNER
RAISING-#HOLES DUG-NO POTHOLES

REMARKS

TYPE OF SOIL

SANDY WITH SOME CLAY

TESTED BY

R.D. & J.S.

ALSO PRESENT

WILLIAM
MARTIN

12/27/79 3:00 PM

DATE RECEIVED (WRA USE ONLY)

12/27/79 3:00 PM

OWNER Martin Mm.

COL 15 LAST NAME FIRST NAME COL. 34

STREET OR RFD 3268 Rt 94

COL 36 COL. 55

POST OFFICE Woodbine Md.

COL 57 COL. 76

STATE OF MARYLAND
WATER RESOURCES ADMINISTRATION
TAWES STATE OFFICE BLDG., ANNAPOLIS, MARYLAND 21401
APPLICATION FOR PERMIT TO DRILL WELL

WRA PERMIT NUMBER

FILL IN THIS FORM COMPLETELY

12/10/79

DATE

40

LICENSE NUMBER

77

80

H. F. Costley

FIRST NAME DRILLER LAST NAME

H. F. Costley

SIGNATURE

5

MAXIMUM PUMPING RATE (GALLONS PER MINUTE)

8

12

500

AVERAGE DAILY QUANTITY NEEDED (GALLONS PER DAY)

14

20

USE FOR WATER (CIRCLE APPROPRIATE BOX)

D HOME (SINGLE OR DOUBLE HOUSEHOLD UNIT ONLY)

F FARMING, AGRICULTURE, IRRIGATION

I INDUSTRIAL, COMMERCIAL, STATE AND FEDERAL GOVERNMENT.

M MUNICIPAL WATER SUPPLY

P PRIVATE WATER COMPANY

Y TEST

MUST HAVE STATE HEALTH DEPT. APPROVAL

APPROXIMATE DEPTH OF WELL 150

24 28 FEET

APPROXIMATE DIAMETER OF WELL 6

(NEAREST INCH)

METHOD OF DRILLING USED (CIRCLE APPROPRIATE METHOD)

BORED (OR AUGERED) JETTED DRIVEN

30-37 AIR-ROTARY AIR-PERCUSSION ROTARY (HYDRAULIC ROTARY)

CABLE REVERSE-ROTARY DRIVE-POINT

OTHER (DESCRIBE)

REPLACEMENT OR DEEPEINED WELLS (CIRCLE APPROPRIATE BOX)

D THIS WELL WILL NOT REPLACE AN EXISTING WELL

Y THIS WELL WILL REPLACE A WELL THAT WILL BE ABANDONED AND SEALED

S THIS WELL WILL REPLACE A WELL THAT WILL BE USED AS A STANDBY

D THIS WELL WILL DEEPEN AN EXISTING WELL

PERMIT NUMBER OF WELL TO BE REPLACED OR DEEPEINED (IF AVAILABLE)

41 52

NOT TO BE FILLED IN BY DRILLER (WRA USE ONLY)

APPROPRIATION PERMIT NUMBER

54 55 56 57 58 59 60 61 62 63 64 65 66 67 68 69 70 71 72 73 74 75 76 77 78 79

ENGINEER REVIEW DISTRICT NO.

FORCE

WRITE INITIALS IN BOX

CONDITIONS

HEALTH DEPARTMENT APPROVAL

Howard

W29714

41

STATE HEALTH (CIRCLE BOTH)

COUNTY NAME COUNTY NO.

DATE 12/11/79

APPROVED BY Donald W. Monaghan, Sanitarian

43 48

BOX NUMBER

760

520

NORTH COORDINATE

50 51 52 53 54 55

EAST COORDINATE

57 58 59 60 61 62 63

ELEVATION AT WELL HEAD (FEET)

65 66 67 68

0/0 5/0

2 1/2 casing above ground

12/27/79 12 Bags of Cement P.W.D.

No house

No house plans

No section in

50' Well casing P.W.D.

46 1/2 Well ground


OK

C.B.S.

ORIGINAL

B 1		3735		SEQUENCE NO. (WRA USE ONLY)		STATE OF MARYLAND WATER RESOURCES ADMINISTRATION TAWES STATE OFFICE BLDG., ANNAPOLIS, MARYLAND 21401 APPLICATION FOR PERMIT TO DRILL WELL		WRA PERMIT NUMBER 110-73-3511 FILL IN THIS FORM COMPLETELY	
1 2 3 (SEQ. NO.) 6		(THIS NUMBER IS TO BE PUNCHED IN COLS. 3-6 ON ALL CARDS)							
DATE RECEIVED (WRA USE ONLY)		OWNER <u>Martin</u> COL. 15 LAST NAME FIRST NAME COL. 34							
STREET OR RFD		COL. 36 <u>326 Mt. Pleasant Rd.</u> COL. 55							
POST OFFICE		COL. 57 <u>Woodbine Md.</u> COL. 76							
B 1 CONTINUED		DRILLER INFORMATION				B 3 LOCATION OF WELL			
1 2 3 (SEQ. NO.) 6		1 2 3 (SEQ. NO.) 6				1 2 3 (SEQ. NO.) 6			
DATE <u>12/10/79</u>		LICENSE NUMBER <u>40</u>		COUNTY <u>Howard</u>		SUBDIVISION <u>23</u>		SECTION <u>44</u> LOT <u>46</u>	
FIRST NAME <u>H. F. Eckerly</u>		DRILLER LAST NAME		NEAREST TOWN <u>Florence</u>		MILES FROM TOWN (ENTER 0 IF IN TOWN) <u>2</u>		M I	
SIGNATURE <u>H. F. Eckerly</u>									
B 2		WELL INFORMATION				B 4 DIRECTION FROM TOWN			
1 2 3 (SEQ. NO.) 6		1 2 3 (SEQ. NO.) 6				1 2 3 (SEQ. NO.) 6			
MAXIMUM PUMPING RATE (GALLONS PER MINUTE) <u>5</u>		AVERAGE DAILY QUANTITY NEEDED (GALLONS PER DAY) <u>100</u>		N NORTH E EAST NE NORTHEAST SE SOUTHEAST		S SOUTH W WEST NW NORTHWEST SW SOUTHWEST		NEAR WHAT ROAD <u>Mt 94</u>	
USE FOR WATER (CIRCLE APPROPRIATE BOX)				ON WHICH SIDE OF ROAD (CIRCLE APPROPRIATE BOX)		DISTANCE FROM ROAD (ENTER DISTANCE AND CIRCLE APPROPRIATE BOX) <u>1000</u>		DRAW A SKETCH BELOW SHOWING LOCATION OF WELL IN RELATION TO NEARBY TOWNS, ROADS AND STREAMS WITH NORTH IN THE DIRECTION OF THE ARROW, AND GIVE DISTANCE FROM WELL TO NEAREST ROAD JUNCTION OR STREAM CROSSING SHOWN ON THE SKETCH. ALSO SHOW, BY MEANS OF AN "X", THE WELL LOCATION IN THE BOX BELOW AND THE BOX NUMBER FROM THE WELL LOCATION MAP.	
☒ HOME (SINGLE OR DOUBLE HOUSEHOLD UNIT ONLY)		☐ FARMING, AGRICULTURE, IRRIGATION		☐ INDUSTRIAL, COMMERCIAL, STATE AND FEDERAL GOVERNMENT.		☐ MUNICIPAL WATER SUPPLY		☐ PRIVATE WATER COMPANY	
☐ TEST									
APPROXIMATE DEPTH OF WELL <u>150</u> FEET		APPROXIMATE DIAMETER OF WELL <u>6</u> (NEAREST INCH)		METHOD OF DRILLING USED (CIRCLE APPROPRIATE METHOD)		BORED (OR AUGERED) JETTED DRIVEN		AIR-ROTARY AIR-PERCUSSION ROTARY (HYDRAULIC ROTARY) CABLE REVERSE-ROTARY DRIVE-POINT	
REPLACEMENT OR DEEPENED WELLS (CIRCLE APPROPRIATE BOX)				OTHER (DESCRIBE)					
☒ THIS WELL WILL NOT REPLACE AN EXISTING WELL		☐ THIS WELL WILL REPLACE A WELL THAT WILL BE ABANDONED AND SEALED		☐ THIS WELL WILL REPLACE A WELL THAT WILL BE USED AS A STANDBY		☐ THIS WELL WILL DEEPEAN AN EXISTING WELL PERMIT NUMBER OF WELL TO BE REPLACED OR DEEPEANED (IF AVAILABLE)			
NOT TO BE FILLED IN BY DRILLER (WRA USE ONLY)				APPROPRIATION PERMIT NUMBER		ENGINEER REVIEW DISTRICT NO.			
FORCE		WRITE INITIALS IN BOX		CONDITIONS		BOX NUMBER			
B 4 CONTINUED		HEALTH DEPARTMENT APPROVAL				NORTH COORDINATE			
1 2 3 (SEQ. NO.) 6		1 2 3 (SEQ. NO.) 6				1 2 3 (SEQ. NO.) 6			
DATE <u>12/11/79</u>		COUNTY NAME <u>Howard</u>		COUNTY NO. <u>W29714</u>		EAST COORDINATE		ELEVATION AT WELL HEAD (FEET)	
APPROVED BY <u>Donald W. Monaghan, Sanitarian</u>									
B 5		SPECIAL CONDITIONS 8-63 (WRA USE ONLY)							
1 2 3 (SEQ. NO.) 6		1 2 3 (SEQ. NO.) 6				1 2 3 (SEQ. NO.) 6			

William B. Martin & Sons
 Timberleigh Farm
 3268 Route 94
 Woodbine, Maryland 21797

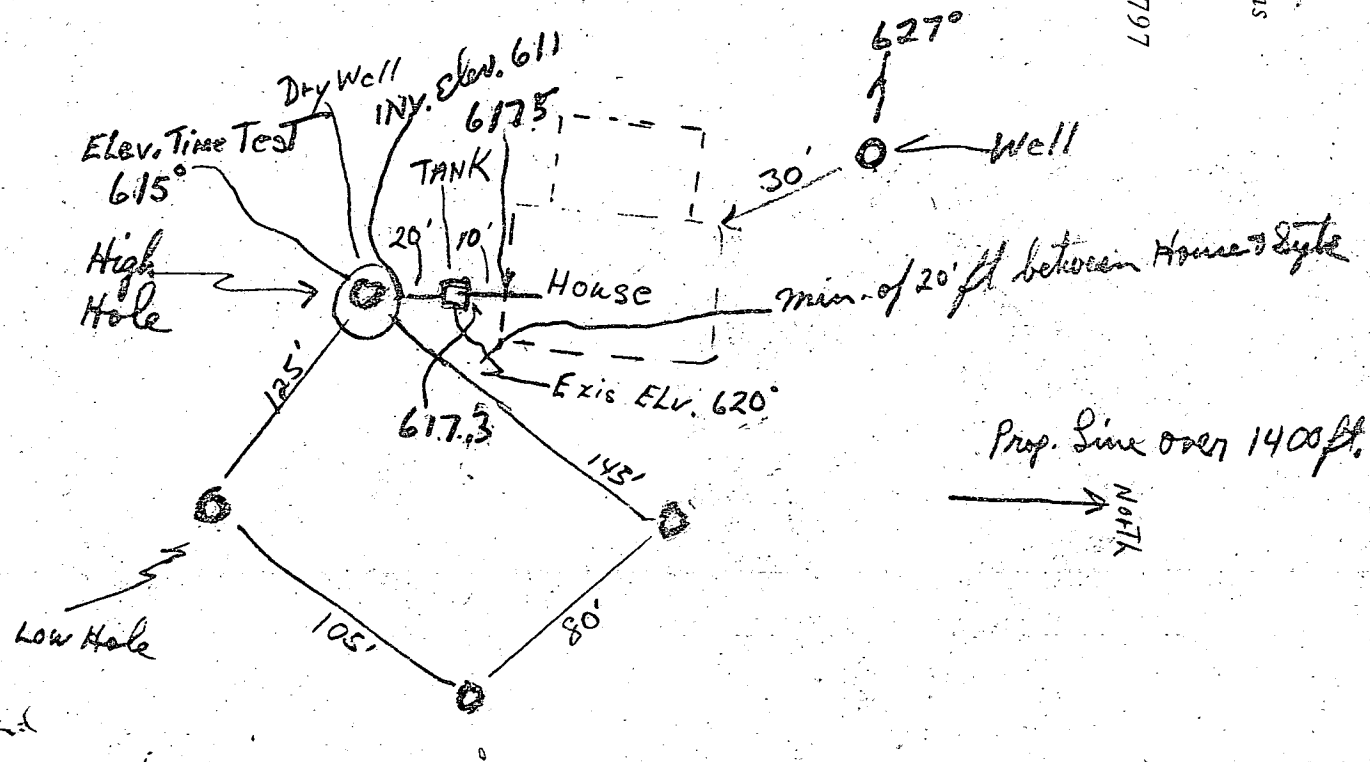

I certify the above measurements and
 elevations differences are actual and correct
 for this Property. William B. Martin

app. sheet
 1-2-80

Prop. Line over 1000 ft.

Route 94

Timberleigh Farm
 489-4983