

05-354021

Approved

(GUC)

6 Apr. 79

P 29632

A Repair

PERMIT

SEWAGE DISPOSAL SYSTEM

MARYLAND STATE DEPARTMENT OF HEALTH

HOWARD COUNTY

ELLICOTT CITY

DISTRICT 5th

DATE 4/2/79

INDEXED

~~Jack Ryck~~ Paul SchisslerIS PERMITTED TO INSTALL ALTER ☒

ADDRESS

PHONE 795-3708

SUBDIVISION

Clarksville Ridge

ROAD

6702 Surrey Lane

LOT

55

PROPERTY OWNER

Mrs. Rappaport

ADDRESS

6702 Surrey Lane, Clarksville, Md. 21029

SPECIFICATIONS

SEPTIC TANK CAPACITY _____ GALLONS

DRAIN FIELD _____ DEPTH _____ FEET, BOTTOM AREA _____ SQ. FT.

DEEP TRENCH _____ DEPTH _____ FEET, BOTTOM AREA _____ SQ. FT.

SEEPAGE PITS _____ ABSORBENT SIDE-WALL AREA _____ SQ. FT.

INLET PIPE _____ FT. BELOW ORIGINAL GRADE. MAXIMUM DEPTH _____ FT. BELOW ORIGINAL GRADE

EFFECTIVE DEPTH AT _____ FT. BELOW ORIGINAL GRADE.

LOCATE DISPOSAL AREA _____ FT. FROM _____ LOT LINE AND _____ FT. FROM _____ LOT LINE AS SEEN WHEN
FACING LOT FROM

Trench - 75 to 100 feet long depending upon recommendation at time of field inspection.

PLANS APPROVED BY Palmer F. Wine

DATE 4/2/79

COVER NO WORK UNTIL INSPECTED AND APPROVED.

NEITHER THE HOWARD COUNTY COUNCIL NOR THE HEALTH DEPARTMENT IS RESPONSIBLE FOR THE SUCCESSFUL OPERATION OF ANY SYSTEM.

NOTE: IF TRENCH IS USED CALL FOR INSPECTION BEFORE PLACING GRAVEL IN TRENCH.

NOTE: NO DRY WELL SHALL EXCEED 15 FOOT IN DIAMETER.

NOTE: ALL PIPE FROM HOUSE TO DISPOSAL AREA MUST BE CAST IRON.

PERMIT VOID AFTER THREE YEARS.

NOTE: INSTALL STAND PIPE ON SEPTIC TANK AND DRY WELL. STAND PIPES MUST BE 6 INCHES IN DIAMETER. CAST IRON, CONCRETE OR TERRA
COTTA ACCEPTED.


*INSTALLER IS RESPONSIBLE FOR OBTAINING FINAL APPROVAL ON THIS PERMIT.

BLDG. PERMIT SIGNED
AND RETURNED 4/2/79Serial # 61038
Addition

P 29632

482

pool
on
ADJACENT
LOT

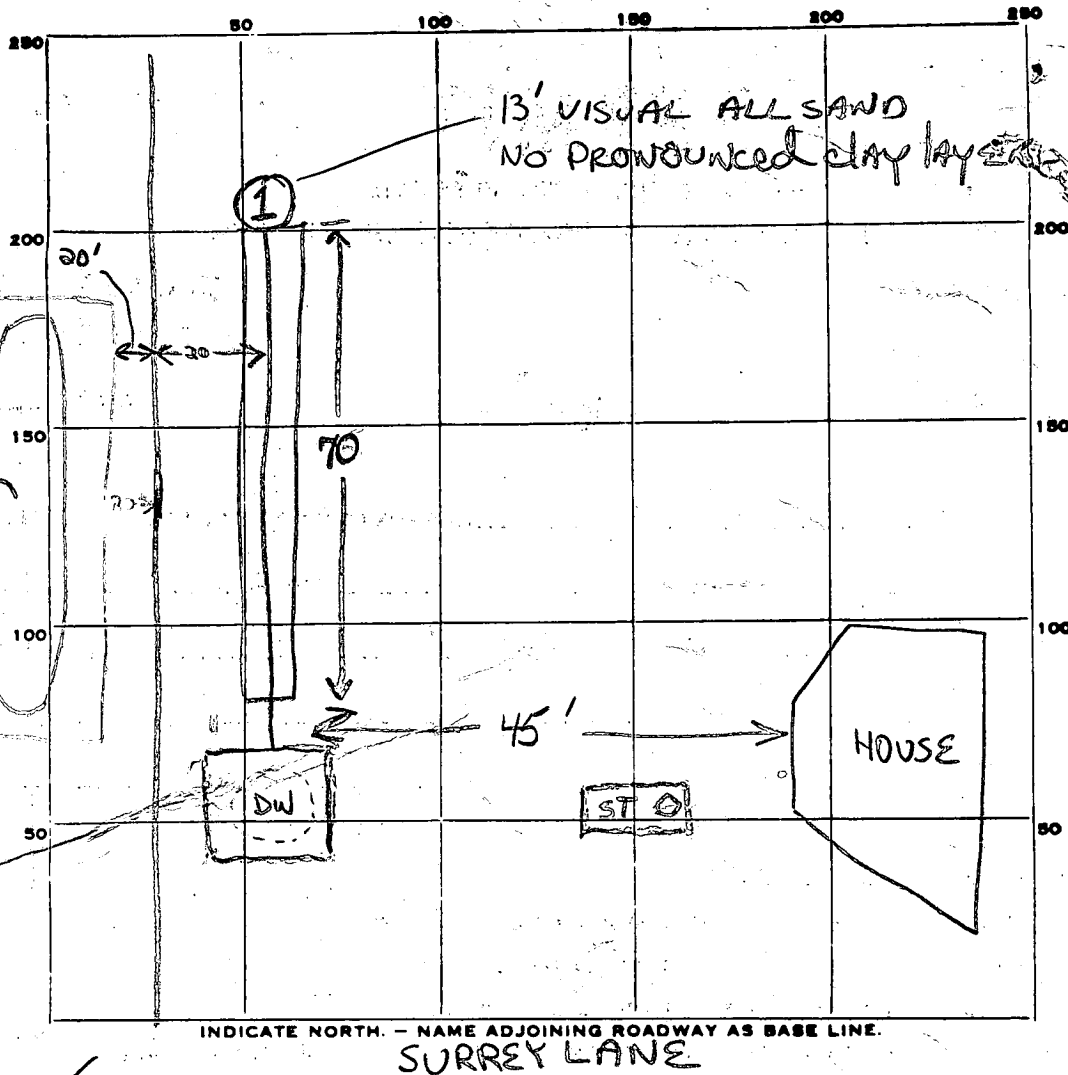

PERMIT CARD ☒

SEPTIC TANK, LEVEL _____

CLEANOUTS _____

DISTRIBUTION BOX, LEVEL _____

TILE FIELD, DEPTH 10 1/2 ^{Avg} FT. TRENCH WIDTH 2 FT.

GRAVEL DEPTH 8 1/2 IN. TOTAL LENGTH ± 70 FT.

NUMBER OF TRENCHES 1 TOTAL BOTTOM AREA ± 595

SEEPAGE PITS, INSIDE DIAMETER _____ FT. DEPTH BELOW INLET _____ FT.

ABSORBENT AREA _____ SQ. FT.

REMARKS 6 Apr. 79 - Initial system 10-15 yrs old - both tank & drywell have been pumped out. Trench excavated on arrival - excavated 13' visual by demand.


6 Apr 79 - Waited for gravel - materials on hand.
FINAL OK. (GLK)

DATE SYSTEM APPROVED 6 Apr. 79

INSPECTOR George L. Keller

Property known as:
6702 SURREY LA.
HOWARD COUNTY, MD.
LOT 55 CLARKSVILLE RIDGE
SECTION 3
PLAT BOOK 6 FOLIO 75
3RD ELECTION DISTRICT

THIS PLAT CAN NOT BE USED TO ESTABLISH PROPERTY
LINES OR CORNERS.

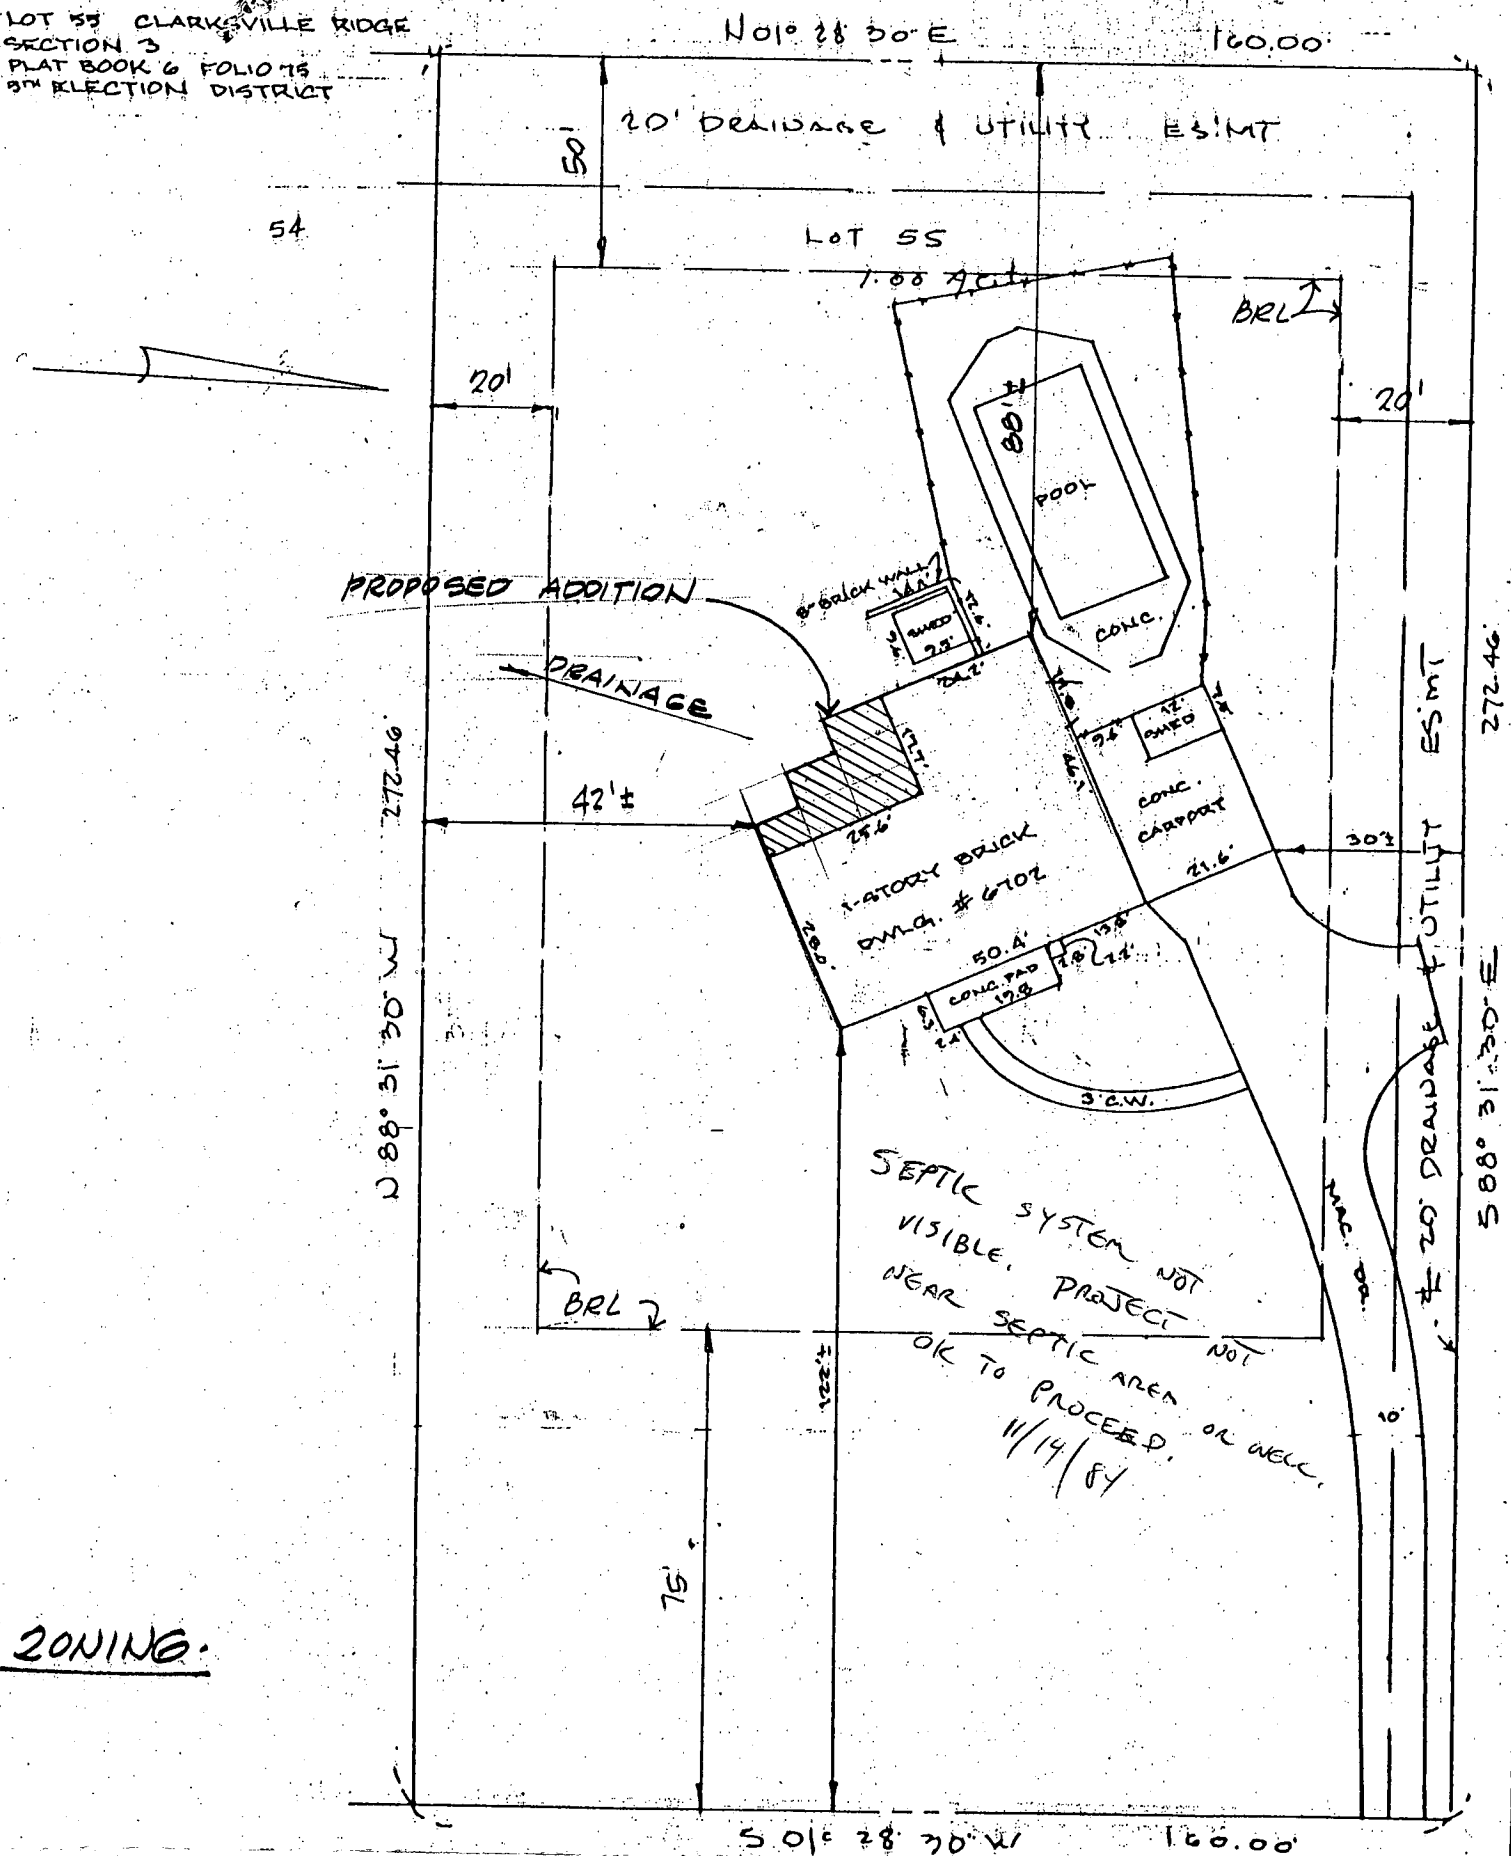

CERTIFICATION

This is to certify that I have surveyed
the property known as:
6702 SURREY LA.

for the purpose of locating the im-
provements thereon, and the improvements
are located as shown.

SEAL



SCALE 1" = 30'

REV 5 NOV 84
DATE 11/30/1978

AXEL F. LOEN
PROFESSIONAL LAND SURVEYOR
730 - 0987
10754 FAULKNER RIDGE CIRCLE
COLUMBIA, MD. 21044