

6-28-79 AP 74

# PERMIT

SEWAGE DISPOSAL SYSTEM

MARYLAND STATE DEPARTMENT OF HEALTH\*

HOWARD COUNTY

01-172557

ELLICOTT CITY

DISTRICT 18t

INDEXED

DATE 6/4/79

P 29888

A

Aarid Septic Tank Company

IS PERMITTED TO INSTALL ALTER X

ADDRESS 122 Camrose Avenue, Baltimore, Md. 21225

PHONE 789-4451

SUBDIVISION ROAD 7540 Washington Blvd.

LOT

PROPERTY OWNER Luskin's

ADDRESS 7540 Washington Boulevard

## SPECIFICATIONS

SEPTIC TANK CAPACITY GALLONS

DRAIN FIELD DEPTH FEET, BOTTOM AREA SQ. FT.

DEEP TRENCH DEPTH FEET, BOTTOM AREA SQ. FT.

SEEPAGE PITS ABSORBENT SIDE-WALL AREA SQ. FT.

INLET PIPE FT. BELOW ORIGINAL GRADE, MAXIMUM DEPTH FT. BELOW ORIGINAL GRADE

EFFECTIVE DEPTH AT FT. BELOW ORIGINAL GRADE.

LOCATE DISPOSAL AREA FT. FROM LOT LINE AND FT. FROM LOT LINE AS SEEN WHEN  
FACING LOT FROM

REPAIR - Call for an appointment when ground is opened up and Sanitarian will

recommend repair system.

6/18/79 - BOY PHILLIPS SAID

FF & DM WERE HERE TWO WEEKS AGO & RECOMMEND SHALLOW BED  
OFF OLD DRY WELL

PLANS APPROVED BY Palmer F. Wine

DATE 6/4/79

COVER NO WORK UNTIL INSPECTED AND APPROVED.

NEITHER THE HOWARD COUNTY COUNCIL NOR THE HEALTH DEPARTMENT IS RESPONSIBLE FOR THE SUCCESSFUL OPERATION OF ANY SYSTEM.

NOTE: IF TRENCH IS USED CALL FOR INSPECTION BEFORE PLACING GRAVEL IN TRENCH.

NOTE: NO DRY WELL SHALL EXCEED 15 FOOT IN DIAMETER.


NOTE: ALL PIPE FROM HOUSE TO DISPOSAL AREA MUST BE CAST IRON.

PERMIT VOID AFTER THREE YEARS.

NOTE: INSTALL STAND PIPE ON SEPTIC TANK AND DRY WELL. STAND PIPES MUST BE 6 INCHES IN DIAMETER. CAST IRON, CONCRETE OR TERRA  
COTTA ACCEPTED.

\*INSTALLER IS RESPONSIBLE FOR OBTAINING FINAL APPROVAL ON THIS PERMIT.

P 29888

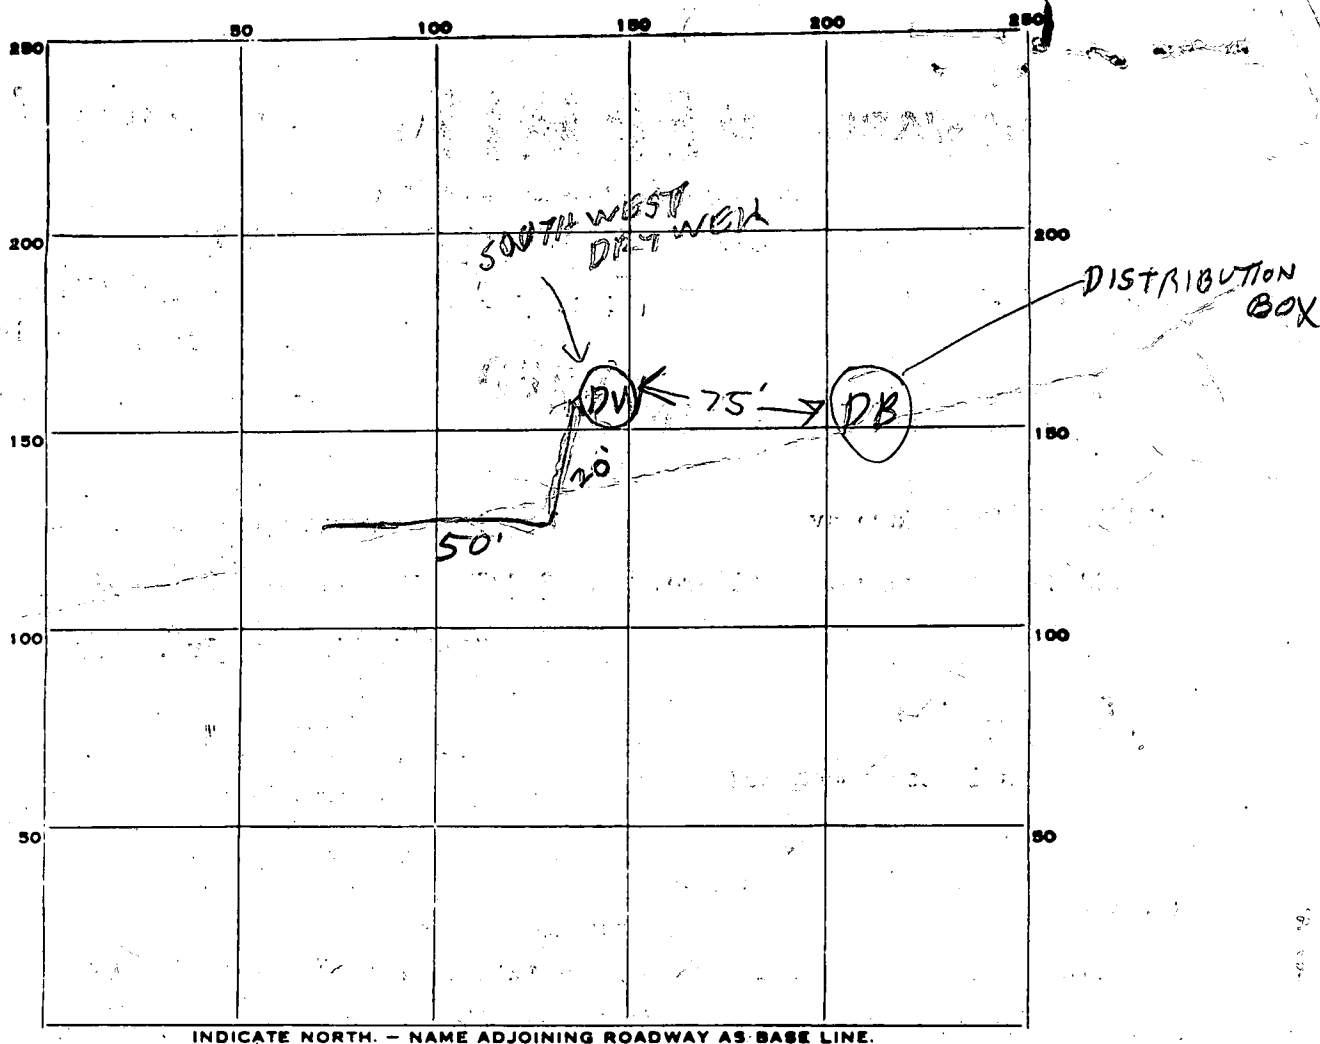

PERMIT CARD \_\_\_\_\_

SEPTIC TANK, LEVEL \_\_\_\_\_ CLEANOUTS \_\_\_\_\_

DISTRIBUTION BOX, LEVEL \_\_\_\_\_

TILE FIELD, DEPTH \_\_\_\_\_ FT. TRENCH WIDTH \_\_\_\_\_ FT.

GRAVEL DEPTH \_\_\_\_\_ IN. TOTAL LENGTH \_\_\_\_\_ FT.

NUMBER OF TRENCHES \_\_\_\_\_ TOTAL BOTTOM AREA \_\_\_\_\_

SEEPAGE PITS, INSIDE DIAMETER \_\_\_\_\_ FT. DEPTH BELOW INLET \_\_\_\_\_ FT.

ABSORBENT AREA \_\_\_\_\_ SQ. FT.

REMARKS 6/18/79 - DITCH OFF OLD DN ONE PART 20 FT  
LONG 2 FT WIDE & THE OTHER 50 FT LONG 7 FT WIDE  
DITCH IS 3 1/2 FT DEEP PER MR PHILLIPS MR. PHILLIPS  
IS USING RED ROSEN PAPER BUT NO PIPE IN DITCH CALLED DN  
HE SAID EVERYTHING OK EXCEPT 70 FT OF PERFORATED PIPE  
NEEDED TO RUN THROUGH DITCH R/L

DATE SYSTEM APPROVED 6-79

INSPECTOR F. J.

# HOWARD COUNTY HEALTH DEPARTMENT

JOYCE M. BOYD, M.D., M.P.H.  
DEPUTY STATE AND  
COUNTY HEALTH OFFICER



P.O. BOX 476  
ELLCOTT CITY, MARYLAND 21043  
TELEPHONE 992-~~XXX~~ 2330

July 3, 1979

Aarid Septic Tank Company  
122 Camrose Avenue  
Baltimore, Maryland 21225

ATTENTION: Mr. Roy Phillips

Dear Mr. Phillips:

Final acceptance of the Luskin's (Permit No. 29888) septic system addition is herewith given in spite of the fact it was installed deeper than originally instructed and the distribution pipe was connected to a gravel ditch not the dry well as instructed.

Very truly yours,

Fred Frommelt,  
Sanitarian

FF:hs