

04 319982

PERMIT INDEXED

P 23548

A 12681

SEWAGE DISPOSAL SYSTEM

MARYLAND STATE DEPARTMENT OF HEALTH

HOWARD COUNTY

ELLICOTT CITY

DISTRICT 4

DATE 7/14/76

INDEXED

IS PERMITTED TO INSTALL ALTER

ADDRESS PHONE 489-4711

A SEWAGE DISPOSAL SYSTEM LOCATED AT

SUBDIVISION 1694 ROAD to District LOT

PROPERTY OWNER ~~Charles J. Evans~~ Philip L. Evans

ADDRESS

SPECIFICATIONS - 3' diameter / 12' x 12' system to be installed in 10' x 10' area

DRAIN FIELD DEPTH FEET, BOTTOM AREA SQ. FT.

SEEPAGE PITS ABSORBENT SIDE-WALL AREA SQ. FT.

SEPTIC TANK CAPACITY 6000 GALLONS

FOR GARBAGE GRINDER, INCREASE DISPOSAL AREA 22% & TANK CAPACITY 50%.

OTHER

PLANS APPROVED BY DATE


FILL SEPTIC TANK AND DISTRIBUTION BOX WITH WATER BEFORE CALLING FOR AN INSPECTION. COVER NO WORK UNTIL INSPECTED AND APPROVED.

NEITHER THE HOWARD COUNTY COMMISSIONERS NOR THE HEALTH DEPARTMENT IS RESPONSIBLE FOR THE SUCCESSFUL OPERATION OF ANY SYSTEM.

BLDG. PERMIT SIGNED AND RETURNED 8/4/76

12681

23548

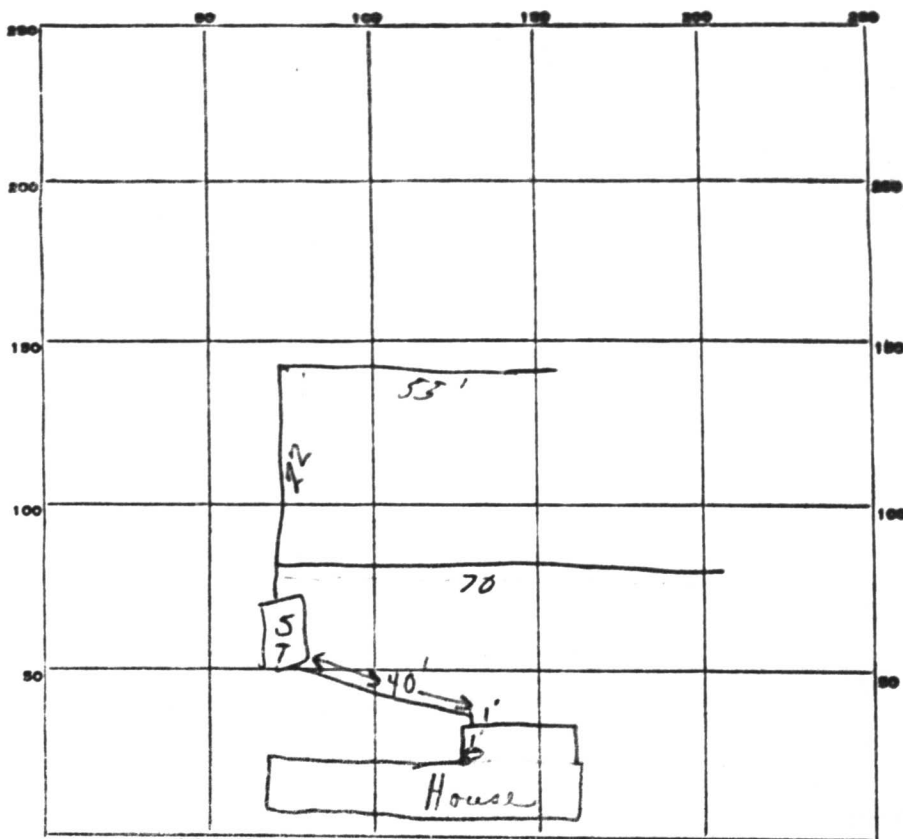

INDICATE NORTH. NAME ADJOINING ROADWAY AS BASE LINE.
ST. MICHAELS RD

PERMIT CARD _____

SEPTIC TANK, LEVEL 1000 gal ✓

CLEANOUTS ST OK

DISTRIBUTION BOX, LEVEL _____

TILE FIELD, DEPTH 5-7' 6 1/2 FT. TRENCH WIDTH ~2 FT.

GRAVEL DEPTH ~3 1/2 FT. TOTAL LENGTH _____ FT.

NUMBER OF TRENCHES 1-U shaped SIDEWALL TOTAL BOTTOM AREA _____

STEPPAGE PITS, INSIDE DIAMETER _____ FT. DEPTH BELOW INLET _____ FT.


ABSORBENT AREA _____ SQ. FT.

REMARKS 8/3/76 Average depth of trenches is 6 1/2', varying from 5' in places to 7' in places. If first trench remain 70' long, 2nd trench must be at least 80' long.

8/4/76 No dist. box is being used, ? this is DWM. W2, RAB
Duce to FF + DWM; OK to allow to continue. OK
to cover all work noted to call for inspection of

connection to house RAB 5 AUG 76 10/26/93 checked house

DATE SYSTEM APPROVED _____ INSPECTOR C. B. Theaker

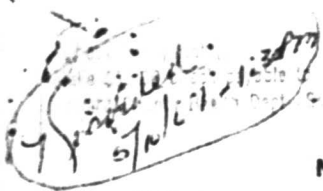

Boundary plot must accompany
the **APPLICATION**

SEWAGE DISPOSAL TESTING

MARYLAND STATE DEPARTMENT OF HEALTH

HOWARD COUNTY

ELLICOTT CITY

DISTRICT 4

DATE 16 May 1967

Septic Tank 1000 gal

Tile Field - 604 sq ft bottom area with trenches installed 3 to 4 ft deep

Place Tile Field in area between 170 ft and 225 ft from front lot line and between 50 ft and 110 ft from right sideline as seen when facing lot from St. Michael's Rd.

TO: THE COUNTY HEALTH OFFICER
ELLICOTT CITY, MARYLAND

I, HEREBY, APPLY FOR THE NECESSARY TESTS IN ORDER TO CONSTRUCT (OR RECONSTRUCT) A SEWAGE DISPOSAL SYSTEM.

✓ PROPERTY OWNER Ray Ronald Rew and Kathleen Anna Rew

✓ ADDRESS 11803 Macon St. Beltsville, Md. 20705 PHONE 301 937 3139

PROPERTY LOCATION:

SUBDIVISION _____ LOT NO. _____

✓ ROAD AND DESCRIPTION St. Michael's Road, Woodbine, RFD 2, Howard Co. Md.

OCCUPANT _____ PHONE _____

PERSON TO CONSTRUCT SYSTEM Howard Triplett

ADDRESS St. Michael's Road, Mt. Airy, Md. PHONE HU 9 4535

✓ SIZE OF LOT 1.09 Ac ± TYPE BLDG. 4 NUMBER OF BEDROOMS _____

IF NOT SINGLE RESIDENCE DESCRIBE _____

✓ SIGNATURE OF APPLICANT Ray Ronald Rew

✓ APPROVED BY Dr. W. H. Thompson FOR Tile Field DATE 5-24-67

REJECTED BY _____ FOR _____ DATE _____


HOLD PENDING FURTHER TESTS _____ DATE _____

REASONS FOR REJECTION OR HOLDING _____

THIS IS NOT A PERMIT


elevations are actual and correct for this property

C.W. Johnson Jr.

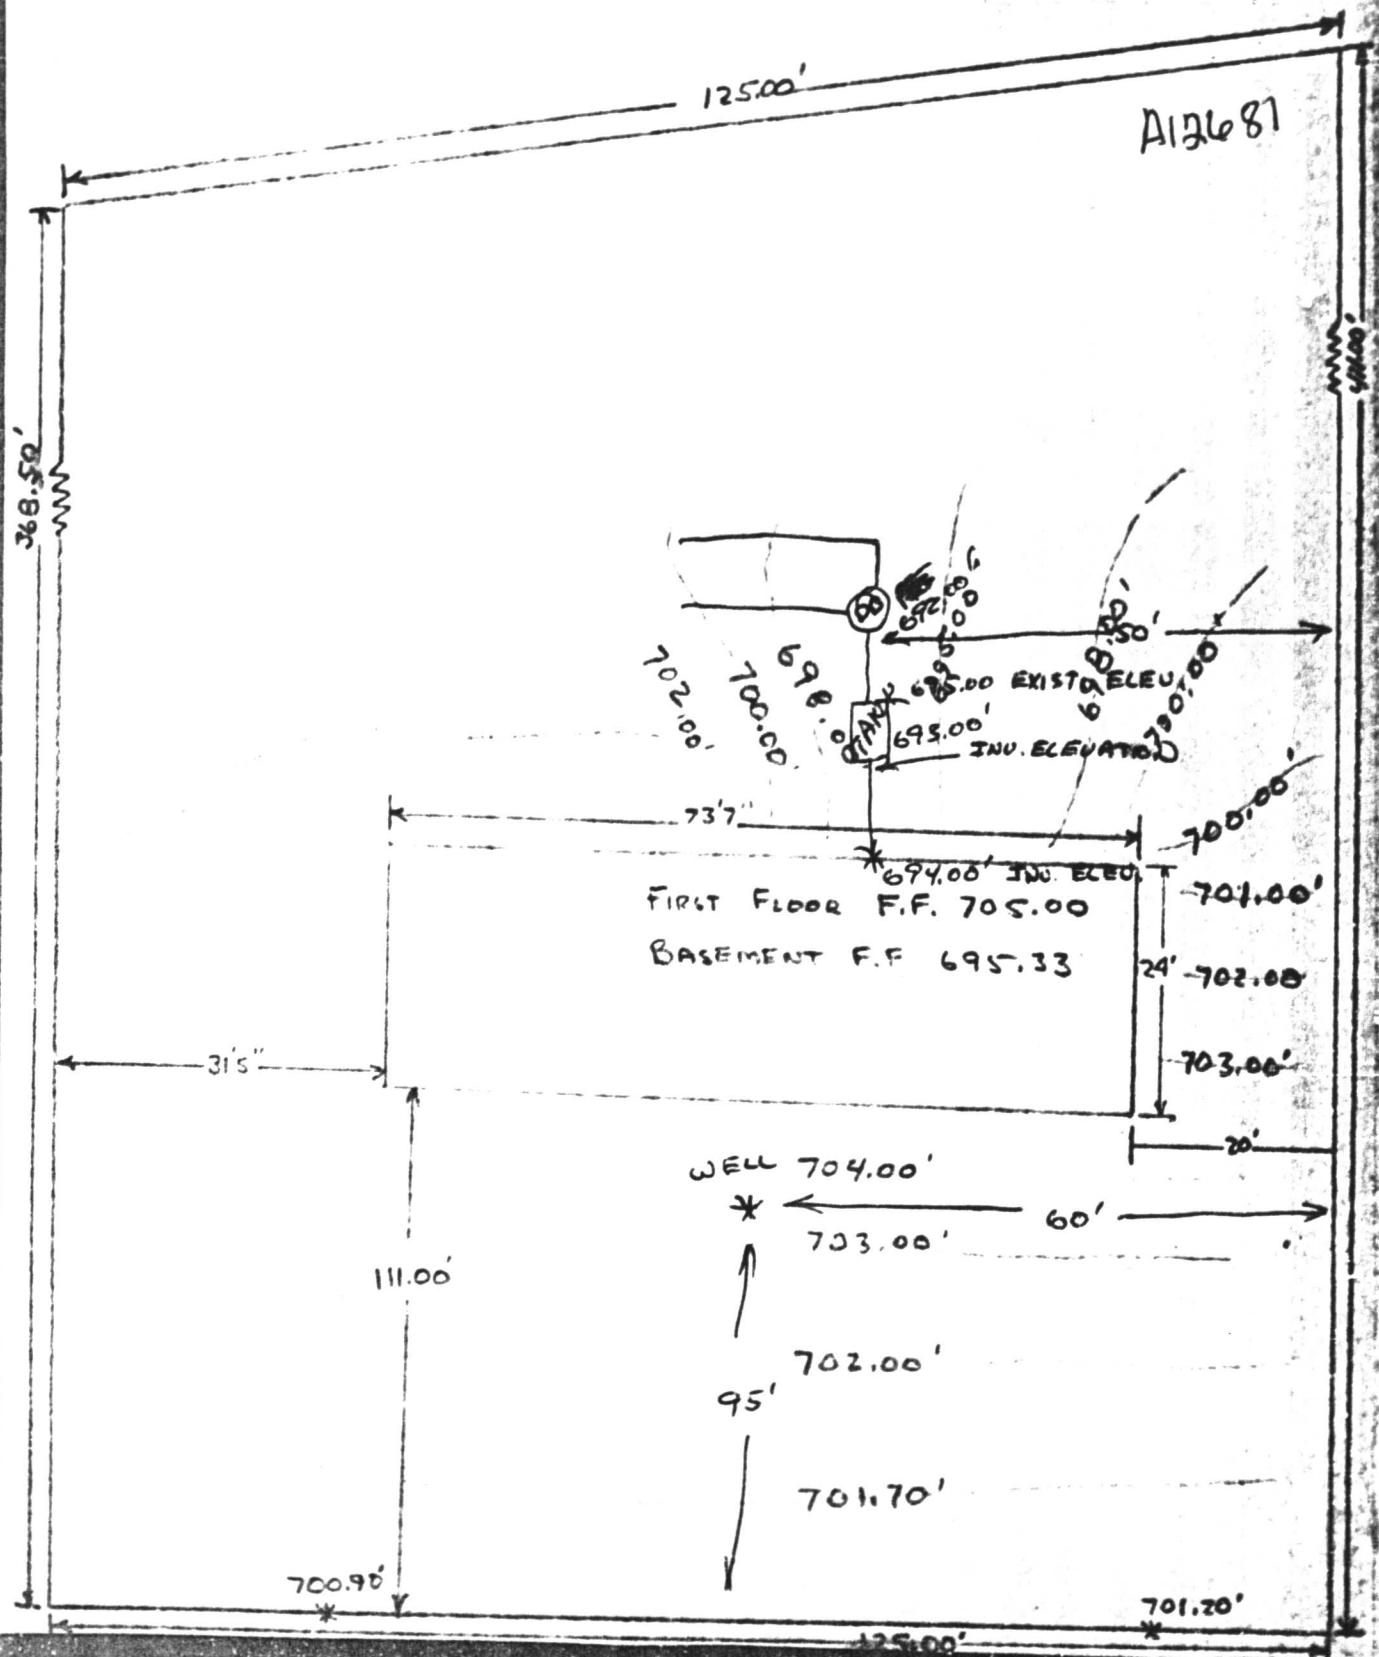

DR. THEODORE E. SHROPSHIRE
HOWARD COUNTY HEALTH OFFICER

DATE
A12681

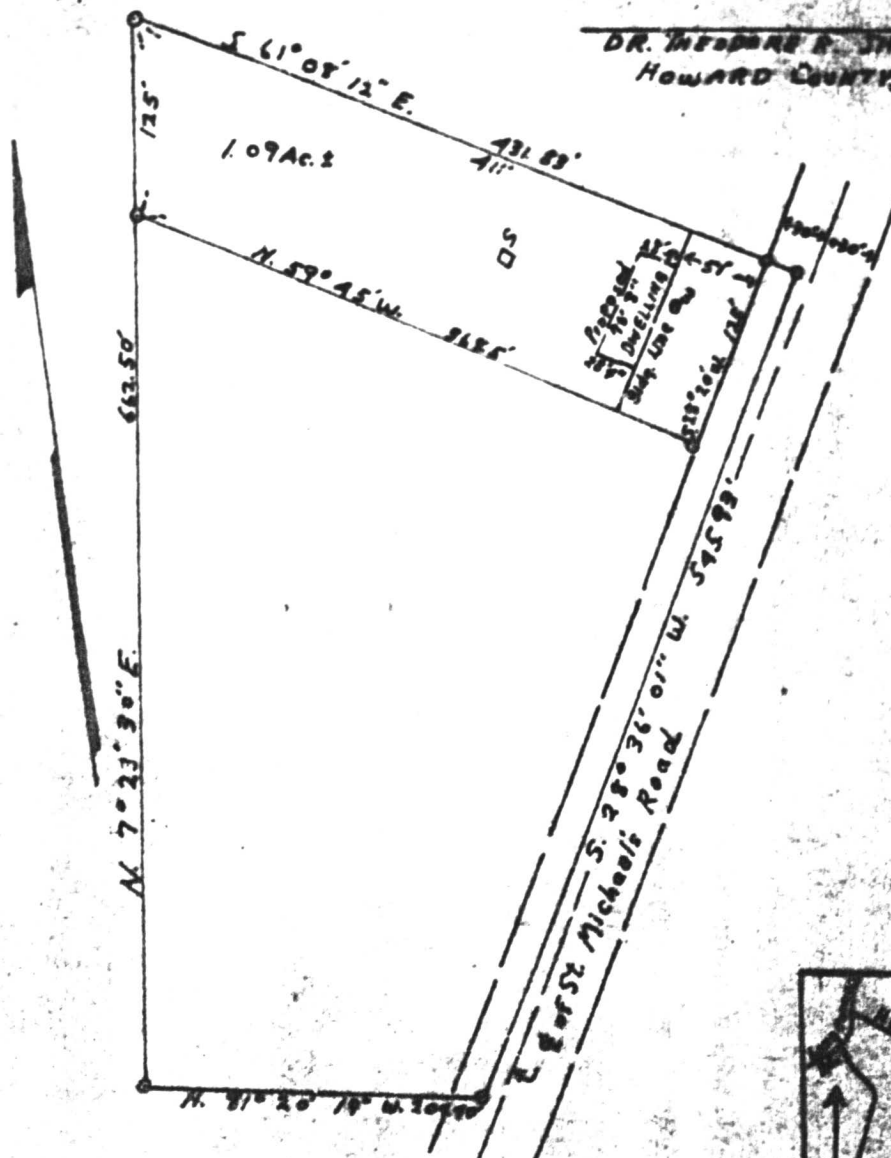

APPROVED BY VIRTUE OF PLANNING COMMISSION ACTION

T. G. HARRIS, JR. PLANNING DIRECTOR. DATE
HOWARD COUNTY PLANNING COMMISSION.



PREPARED BY
J. HARRY KOLLER
REG. LAND SURVEYOR
No. 250
Rt. 2, SYKESVILLE, MD.
PHONE 301-795-1639

OWNER: JOSEPH LEAKINS
4TH ELECTION DISTRICT
HOWARD COUNTY, MD.
TITLE: REFERENCE
LIBER H.S.K. No. 134, Folio 469
SCALE: 1" = 100' APRIL 24, 1967

C 1 2356 (SEQ. NO.)
 (THIS NUMBER IS TO BE PUNCHED IN CO. 9-8 ON ALL CARDS)
 DATE RECEIVED (WRA USE ONLY) Oct. 18 '76
 DATE WELL COMPLETED Oct. 18 '76
 DEPTH OF WELL 280
 (TO NEAREST FOOT)
 PERMIT NO. FROM "PERMIT TO DRILL WELL" 44-11-10003
 COUNTY NUMBER D12681
 DRILLERS IDENTIFICATION NO. 42

OWNER Johnson Jr, Charles
 STREET OR RFD RT 3 Box 1575
 POST OFFICE MT Airy MD.

WELL LOG

STATE THE KIND OF FORMATIONS PENETRATED, THEIR COLOR, DEPTH, THICKNESS AND IF WATER BEARING (USE ADDITIONAL SHEETS IF NECESSARY)

DESCRIPTION	FEET		CHECK IF WATER BEARING
	FROM	TO	
Top Soil	0	2	
SHALE	2	12	
Brown Slate	12	70	✓
BLUE SLATE	70	280	

WELL DESCRIPTION

GROUTING RECORD

WELL HAS BEEN GROUTED (CIRCLE APPROPRIATE BOX) ☒ YES ☐ NO

TYPE OF GROUTING MATERIAL (CIRCLE BOX) ☒ CEMENT ☐ BENTONITE CLAY

NO. OF BAGS 5 NO. OF POUNDS 500

GALLONS OF WATER 25

DEPTH OF GROUT SEAL (TO NEAREST FOOT)

FROM 0 FT. TO 19 FT.

CASING RECORD

CASING TYPES (INSERT APPROPRIATE CODE BELOW)

☒ ST STEEL ☐ CO CONCRETE

☐ PL PLASTIC ☐ OT OTHER

MAIN CASING TYPE ☒ ST

NOMINAL DIAMETER TOP (MAIN) CASING (NEAREST INCH) 6

TOTAL DEPTH OF MAIN CASING (NEAREST FOOT) 21

OTHER CASING (IF USED)

DIAMETER (INCH) _____ DEPTH (FEET) FROM _____ TO _____

SCREEN RECORD

SCREEN TYPE OR OPEN HOLE (INSERT APPROPRIATE CODE BELOW)

☒ ST STEEL ☐ BR BRASS OR BRONZE ☐ HO OPEN HOLE

☐ PL PLASTIC ☐ OT OTHER

PUMPING TEST

HOURS PUMPED (TO NEAREST HOUR) 2

PUMPING RATE (GALLONS PER MINUTE TO NEAREST GALLON) 1

METHOD USED TO MEASURE PUMPING RATE BUCKET

WATER LEVEL (DISTANCE FROM LAND SURFACE)

BEFORE PUMPING 40 (NEAREST FOOT)

WHEN PUMPING 270 (NEAREST FOOT)

TYPE OF PUMPED USED (CIRCLE APPROPRIATE BOX) (FOR PUMPING TEST)

☒ A AIR ☐ P PISTON ☐ T TURBINE

☐ C CENTRIFUGAL ☐ R ROYARY ☐ O OTHER (DESCRIBE BELOW)

☐ J JET ☐ S SUBMERSIBLE

PUMP INSTALLED

TYPE OF PUMP (WRITE APPROPRIATE LETTER IN BOX - SEE ABOVE: A, C, J, P, R, S, T, O) 28

DRILLER WILL INSTALL PUMP (CIRCLE APPROPRIATE BOX) ☐ YES ☒ NO

CAPACITY:

GALLONS PER MINUTE (TO NEAREST GALLON) _____

PUMP HORSE POWER _____

PUMP COLUMN LENGTH (NEAREST FOOT) 43

CASING HEIGHT (CIRCLE APPROPRIATE BOX AND ENTER CASING HEIGHT)

☒ ABOVE } LAND SURFACE

☐ BELOW } 2 (NEAREST FOOT)

CIRCLE APPROPRIATE BOXES

☐ A A WELL WAS ABANDONED AND SEALED WHEN THIS WELL WAS COMPLETED

☐ E ELECTRIC LOG OBTAINED

☐ P TEST WELL CONVERTED TO PRODUCTION WELL

I HEREBY CERTIFY THAT I HAVE COMPLIED WITH ALL CONDITIONS STATED ON THE ABOVE-CAPTIONED "PERMIT TO DRILL WELL", AND THAT INFORMATION CONTAINED IN THIS REPORT IS TRUE, ACCURATE, AND COMPLETE TO THE BEST OF MY KNOWLEDGE, INFORMATION AND BELIEF.

DRILLERS NAME John A. Johnson

(PLEASE PRINT) _____

SIGNATURE _____

LOCATION OF WELL ON LOT

SHOW PERMANENT STRUCTURE SUCH AS BUILDINGS, SEPTIC TANKS, AND/OR OTHER LAND MARKS AND INDICATE NOT LESS THAN TWO DISTANCES (MEASUREMENTS TO WELL).

HOUSE

20

20

WELL

20

WRA USE ONLY (NOT TO BE FILLED IN BY DRILLER)

TELESCOPE CASING ☐ LOG INDICATOR ☐ OTHER DATA AVAILABLE ☐

11/20/98
Meet
Driller 4:00

SITE INSPECTION SHEET

OWNER: Philip Evans

DATE REQUESTED: _____

PHONE #: 301-854-5482

CONTRACTOR: _____

ADDRESS: 1694 St. Michael's Rd


WELL TAG #: _____

COUNTY #: _____

PROPOSAL: replacement well requested, well out of water

LOCATION DIAGRAM

FIELD

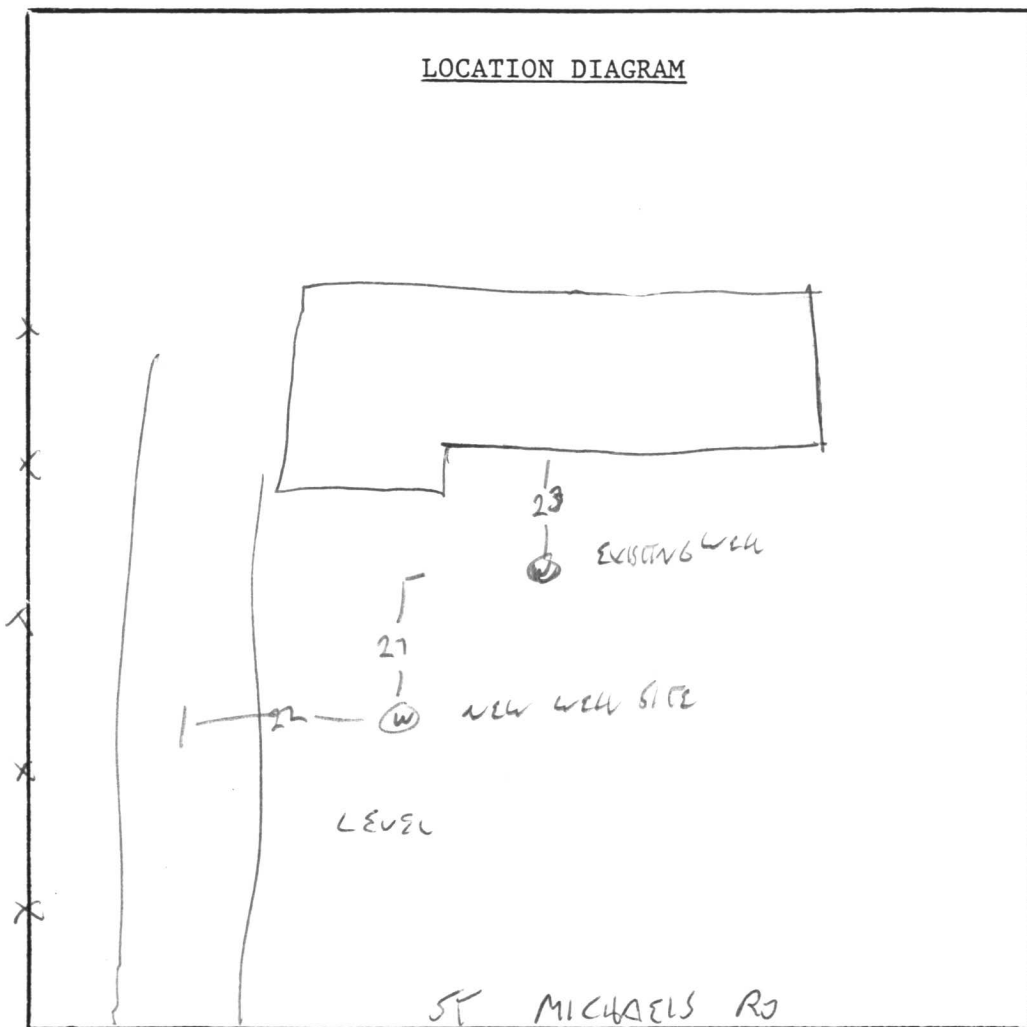

COMMENTS: SEPTIC BEHIND HOUSE, NEW WELL SITE OK

DATE: 11-20-98

INSPECTOR: G. SAVAGE

C 1 6157 SEQUENCE NO. (MDE USE ONLY)

STATE OF MARYLAND
WELL COMPLETION REPORTTHIS REPORT MUST BE SUBMITTED WITHIN
45 DAYS AFTER WELL IS COMPLETED.1 2 3 6
(THIS NUMBER IS TO BE PUNCHED
IN COLS. 3-6 ON ALL CARDS)

11-30-98

FILL IN THIS FORM COMPLETELY
PLEASE PRINT OR TYPECOUNTY
NUMBER

13

SJ/CO USE ONLY

DATE Received
MM DD YY
8 13

DATE WELL COMPLETED

MM DD YY
11 23 98

Depth of Well

22 250 26
(TO NEAREST FOOT)PERMIT NO.
FROM "PERMIT TO DRILL WELL"HO-94-1980
28 29 30 31 32 33 34 35 36 37OWNER EVANS PHILLIP
last name first name
STREET OR RFD 1694 ST. MICHEALS RD. TOWN WOODBINE MD 21797
SUBDIVISION SECTION LOT MAP 7 PAR 293

WELL LOG

Not required for driven wells

STATE THE KIND OF FORMATIONS PENETRATED, THEIR
COLOR, DEPTH, THICKNESS AND IF WATER BEARINGDESCRIPTION (Use
additional sheets if needed)

FEET

FROM

TO

check
if water
bearing

13 BROWN SHALE 0 30

BLUE SLATE 30 250 ✓

WATER AT
57-65-90'

GROUTING RECORD

WELL HAS BEEN GROUTED
(Circle Appropriate Box)yes no
☒ Y ☐ N
44 44

TYPE OF GROUTING MATERIAL (Circle one)

CEMENT ☒ CM BENTONITE CLAY ☐ BCNO. OF BAGS 8 NO. OF POUNDS 852GALLONS OF WATER 48

DEPTH OF GROUT SEAL (to nearest foot)

from 0 ft. to 39 ft.
(enter 0 if from surface)
48 TOP 52 54 BOTTOM 58casing
types
insert
appropriate
code
below

CASING RECORD

☐ S ☐ T

STEEL

☐ C ☐ O

CONCRETE

☐ P ☐ L

PLASTIC

☐ O ☐ T

OTHER

MAIN
CASING
TYPENominal diameter
top (main) casing
(nearest inch)Total depth
of main casing
(nearest foot)ST640

60 61

63 64

66

70

E
A
C
H
C
A
S
I
N
G

OTHER CASING (if used)

diameter

depth (feet)

inch

from to

screen type
or open hole

SCREEN RECORD

(insert
appropriate
code
below)☐ S ☐ T

STEEL

☐ B ☐ R

BRASS

BRONZE

☐ H ☐ O

OPEN

HOLE

☐ P ☐ L

PLASTIC

☐ O ☐ T

OTHER

C 2

DEPTH (nearest ft.)

1 2

E 1

A 8

C 9

H 11

S 23

C 24

3 26

R 30

E 32

N 36

38

39

41

45

47

51

SLOT SIZE 1 2 3

DIAMETER

OF SCREEN

(NEAREST

INCH)

from

to

GRAVEL PACK

IF WELL DRILLED

WAS FLOWING WELL

INSERT F IN BOX 68

MDE USE ONLY

(NOT TO BE FILLED IN BY DRILLER)

T

(E.R.O.S.)

W Q

70

TELESCOPE

CASING

72

LOG

INDICATOR

74

75

76

OTHER DATA

C 3

1 2

PUMPING TEST

HOURS PUMPED (nearest hour)

1
8 9

PUMPING RATE (gal. per min.)

3
11 15METHOD USED TO
MEASURE PUMPING RATETIME

WATER LEVEL (distance from land surface)

BEFORE PUMPING 40 ft.
17 20WHEN PUMPING 250 ft.
22 25

TYPE OF PUMP USED (for test)

☒ A air☐ P piston☐ T turbine☐ C centrifugal☐ R rotary☐ O other
(describe
below)☐ J jet☐ S submersible

PUMP INSTALLED

DRILLER WILL INSTALL PUMP
(CIRCLE) (YES OR NO)YES ☒ NOIF DRILLER INSTALLS PUMP, THIS SECTION
MUST BE COMPLETED FOR ALL WELLS.TYPE OF PUMP INSTALLED
PLACE (A,C,J,P,R,S,T,O)

29

CAPACITY:
GALLONS PER MINUTE
(to nearest gallon)

31 35

PUMP HORSE POWER

37 41

PUMP COLUMN LENGTH
(nearest ft.)

43 47

CASING HEIGHT (circle appropriate box
and enter casing height)☒ + above

LAND SURFACE

☐ - below1 (nearest
foot)
49 50 51

LOCATION OF WELL ON LOT

SHOW PERMANENT STRUCTURE SUCH AS
BUILDING, SEPTIC TANKS, AND /OR
LANDMARKS AND INDICATE NOT LESS
THAN TWO DISTANCES
(MEASUREMENTS TO WELL)MD RT 144DRILLERS LIC. NO. 1 MW D 139DRILLERS SIGNATURE
(MUST MATCH SIGNATURE ON APPLICATION)LIC. NO. 1 MW D 140SITE SUPERVISOR (sign. of driller or journeyman
responsible for sitework if different from permittee)

COUNTY

STATE OF MARYLAND WELL COMPLETION REPORT

WELL IN THIS FORM COMPLETELY
PLEASE PRINT OR TYPE

DATE WELL COMPLETED
11-23-98

WELL HAS BEEN PROTECTED
BY A PERMANENT SEAL

TYPE OF SEAL MATERIAL FOLLOW DOWN
CEMENT
NO. OF BAGS 2
NO. OF COILS 148

GALLONS OF WATER
DEPTH OF CHOUT SEAL (in inches)
38

SEALING METHOD
Casing
Type
21

OTHER CASING (in inches)
40

SEALING METHOD
Casing
Type
21

OTHER CASING (in inches)
40

SEALING METHOD
Casing
Type
21

WELL NO. 132
DATE WELL COMPLETED
11-23-98

WELL HAS BEEN PROTECTED
BY A PERMANENT SEAL

TYPE OF SEAL MATERIAL FOLLOW DOWN
CEMENT
NO. OF BAGS 2
NO. OF COILS 148

GALLONS OF WATER
DEPTH OF CHOUT SEAL (in inches)
38

SEALING METHOD
Casing
Type
21

OTHER CASING (in inches)
40

SEALING METHOD
Casing
Type
21

OTHER CASING (in inches)
40

WELL NO. 132
DATE WELL COMPLETED
11-23-98

WELL HAS BEEN PROTECTED
BY A PERMANENT SEAL

TYPE OF SEAL MATERIAL FOLLOW DOWN
CEMENT
NO. OF BAGS 2
NO. OF COILS 148

GALLONS OF WATER
DEPTH OF CHOUT SEAL (in inches)
38

SEALING METHOD
Casing
Type
21

OTHER CASING (in inches)
40

SEALING METHOD
Casing
Type
21

OTHER CASING (in inches)
40


SEALING METHOD
Casing
Type
21

OTHER CASING (in inches)
40


SEALING METHOD
Casing
Type
21

OTHER CASING (in inches)
40

RECEIVED
HOWARD COUNTY HEALTH DEPT.
ENVIRONMENTAL HEALTH
1998 NO 30 AM 9:30

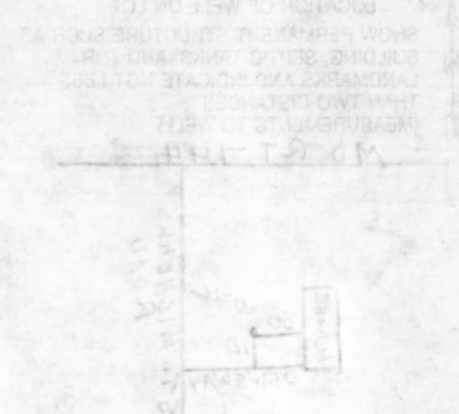


B 1	2664	SEQUENCE NO. (MDE USE ONLY)	STATE OF MARYLAND PERMIT TO DRILL WELL please print or type	STATE PERMIT NUMBER <u>HO-94-1980</u> fill in this form completely
Date Received (APA) 8 MM DD YY 13 <u>Evans</u> <u>Phil</u>		OWNER INFORMATION 15 Last Name Owner First Name 34 <u>1694 Saint Micheals Road</u> 36 Street or RFD 55 <u>Woodbine</u> <u>Md</u> <u>21797</u> 57 Town 70 State 72 Zip 76		
DRILLER INFORMATION Driller's Name <u>Robert L. Cline</u> M W D <u>139</u> Firm Name <u>Cline and Duvall, Inc.</u> Address <u>8093 Hillmark Ct. Frederick 21704</u> Signature <u>Robert L. Cline</u> Date <u>11/20/98</u>		LOCATION OF WELL 8 COUNTY <u>Howard</u> 21 23 SUBDIVISION <u>NA</u> 42 SECTION <u>44</u> <u>46</u> LOT <u>48</u> <u>50</u> 52 NEAREST TOWN <u>Woodbine</u> 71 MILES FROM TOWN (enter 0 if in town) <u>5</u> M I 73 76 77 78		
WELL INFORMATION APPROX. PUMPING RATE <u>5</u> (GAL. PER MIN.) 8 12 AVERAGE DAILY QUANTITY NEEDED <u>300</u> (GAL. PER DAY) 14 20		1594 Saint Micheal 11 NEAR WHAT ROAD 30 ON WHICH SIDE OF ROAD (CIRCLE APPROPRIATE BOX) 34 <u>50</u> 37 DISTANCE FROM ROAD <u>FT</u> ENTER FT OR MI 38 39 TAX MAP: <u>7</u> BLK: <u>26</u> PARCEL <u>283</u>		
USE FOR WATER (CIRCLE APPROPRIATE BOX) ☒ DOMESTIC POTABLE SUPPLY & RESIDENTIAL IRRIGATION ☐ FARMING (LIVESTOCK WATERING & AGRICULTURAL IRRIGATION) ☐ INDUSTRIAL, COMMERCIAL, DEWATERING ☐ PUBLIC WATER SUPPLY WELL ☐ TEST, OBSERVATION, MONITORING ☐ GEO-THERMAL		NOT TO BE FILLED IN BY DRILLER HEALTH DEPARTMENT APPROVAL <u>HOWARD</u> <u>13</u> COUNTY NAME COUNTY NO. STATE SIGNATURE _____ INSERT S → 41 DATE ISSUED <u>11 20 98</u> CO SIGNATURE <u>[Signature]</u> EXP. DATE <u>11 20 99</u> 43 MM DD YY 48 NORTH GRID <u>540</u> 000 EAST GRID <u>765</u> 000 50 55 57 63		
APPROXIMATE DEPTH OF WELL <u>200</u> FEET 24 28 APPROXIMATE DIAMETER OF WELL <u>6</u> INCH NEAREST		SHOW MAJOR FEATURES OF BOX & LOCATE WELL WITH AN X SOURCES OF DRILLING WATER 1. <u>Well</u> 2. <u>Well</u> 3. <u>Well</u> WRITE THE BOX NUMBER FROM THE MAP HERE E <u>760</u> N <u>540</u> 000 000		
METHOD OF DRILLING (circle one) BORED (or Augered) JETTED Jetted & DRIVEN 30 AIR-ROTary <u>AIR-PERCussion</u> ROTARY (Hydraulic Rotary) 37 CABLE REVERSE-ROTary DRIVE-POINT other _____		DRAW A SKETCH BELOW SHOWING LOCATION OF WELL IN RELATION TO NEARBY TOWNS AND ROADS AND GIVE DISTANCE FROM WELL TO NEAREST ROAD JUNCTION 		
REPLACEMENT OR DEEPEMED WELLS (CIRCLE APPROPRIATE BOX) ☐ THIS WELL WILL NOT REPLACE AN EXISTING WELL ☐ THIS WELL WILL REPLACE A WELL THAT WILL BE ABANDONED AND SEALED ☒ THIS WELL WILL REPLACE A WELL THAT WILL BE USED AS A STANDBY-CONTACT LOCAL APPROVING AUTHORITY FOR POLICY ON STANDBY WELLS ☐ THIS WELL WILL DEEPEMED AN EXISTING WELL PERMIT NUMBER OF WELL TO BE REPLACED OR DEEPEMED (IF AVAILABLE) 41 <u>HO-23-1668</u> 52				
Not to be filled in by driller (MDE OR COUNTY USE ONLY) APPROP. PERMIT NUMBER 54 <u>HO 94-1980</u> 63 PERMIT No. <u>HO 94-1980</u> 70 71 72 73 74 75 76 77 78 79				
SPECIAL CONDITIONS NOTE - APPROVING AUTHORITIES SHOULD USE SEPARATE SHEET IF NEEDED -				

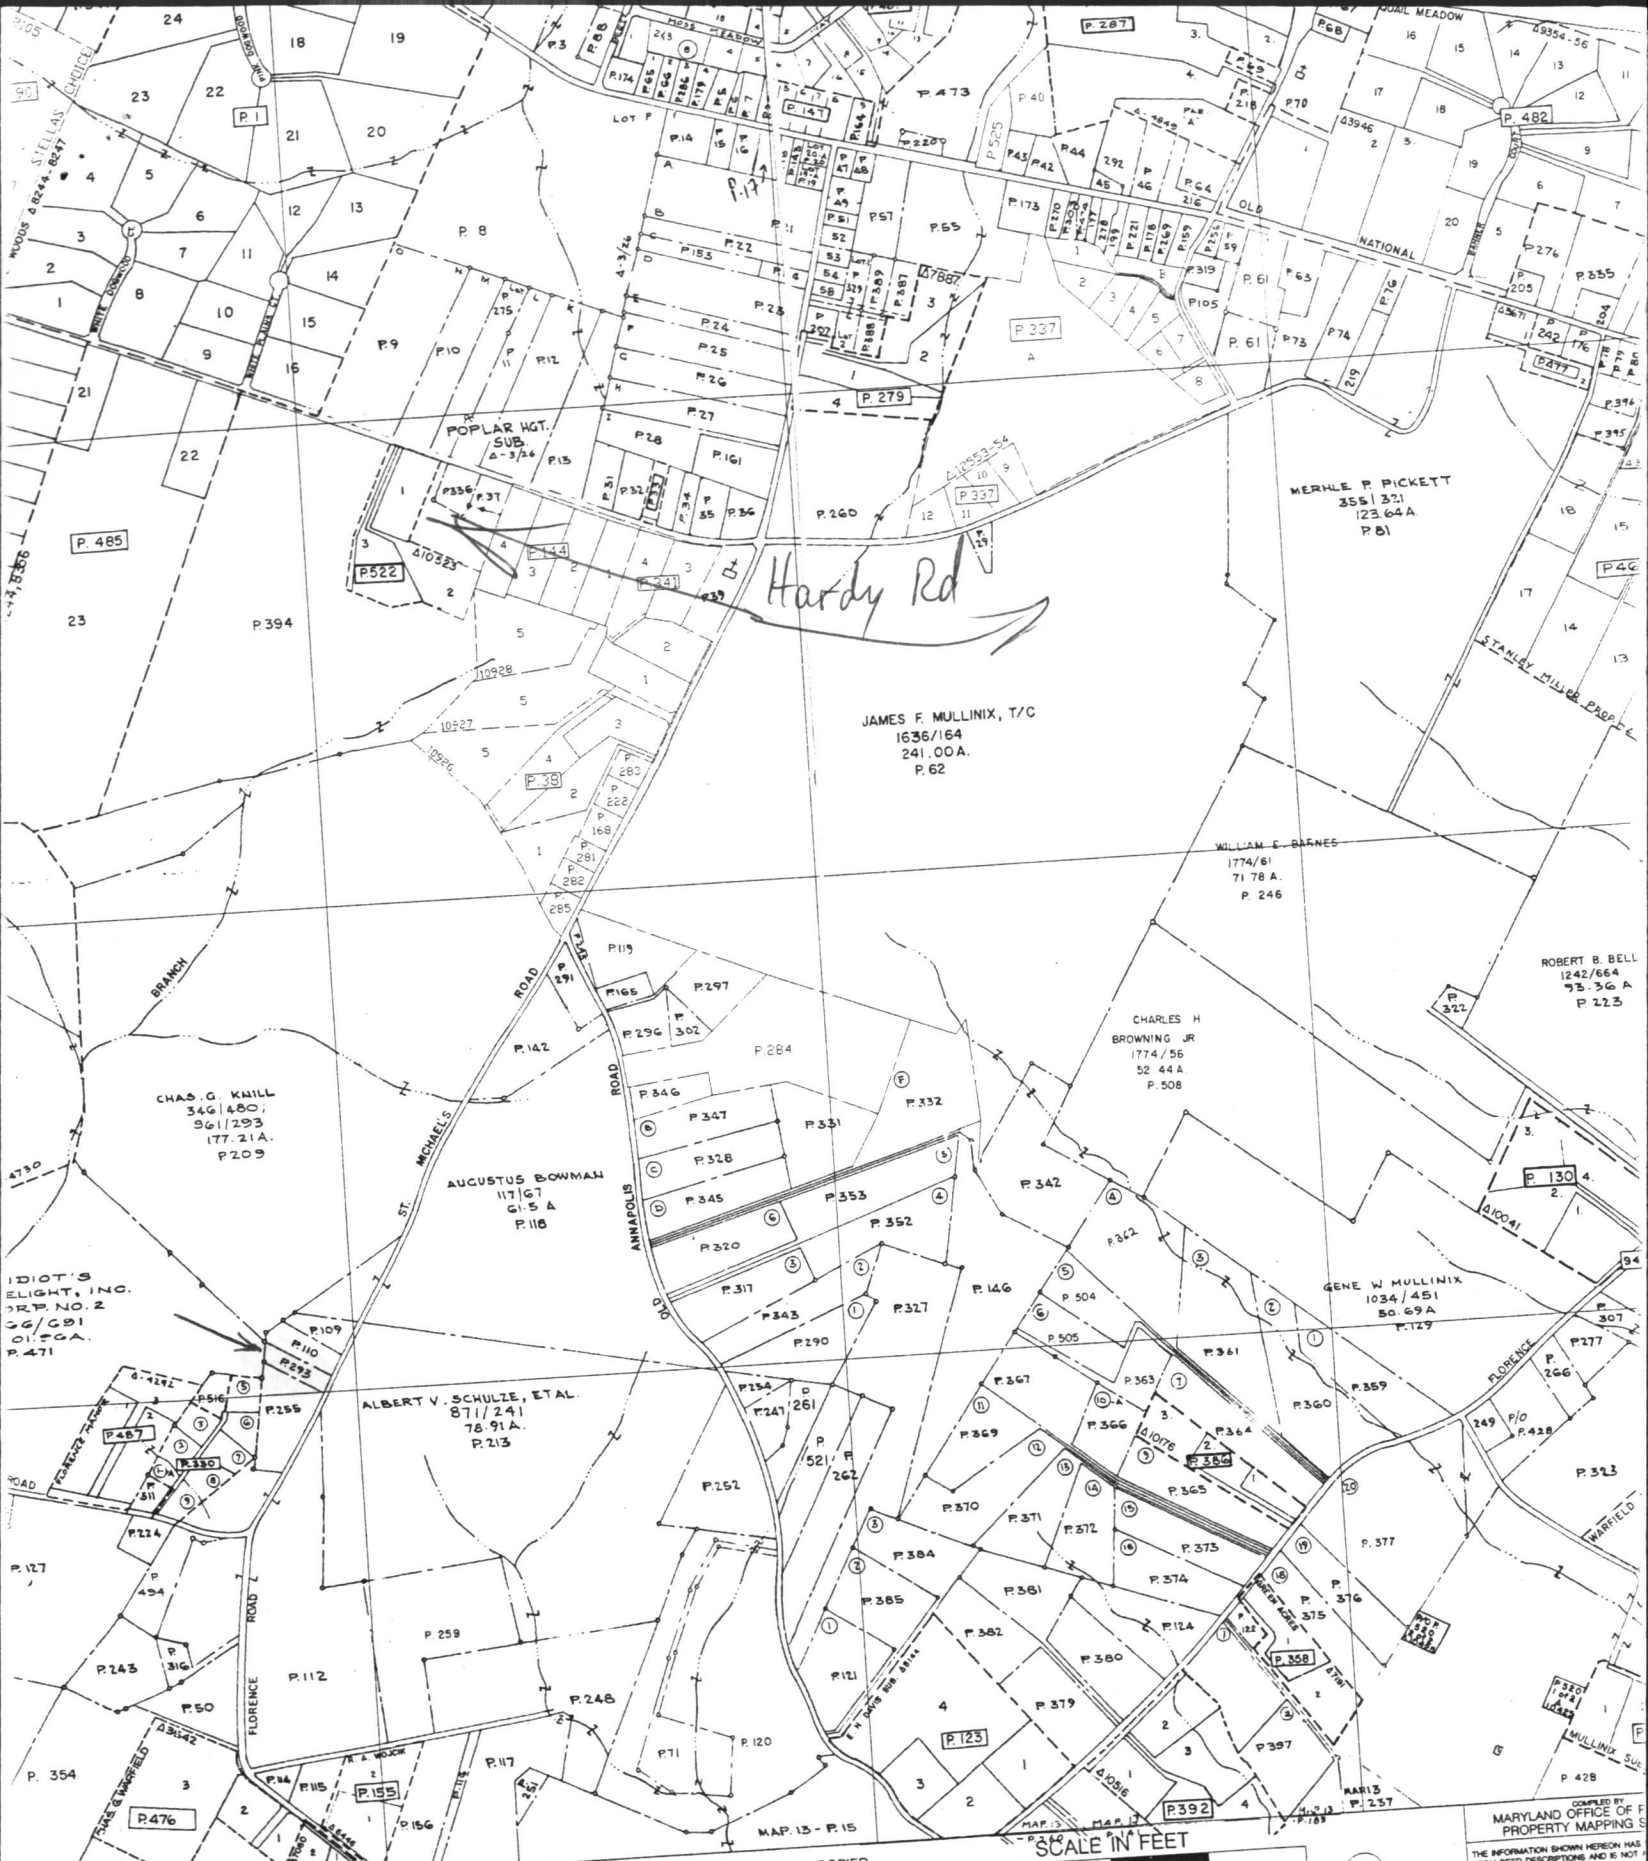

COPYRIGHT - 1992 BY THE
STATE OF MARYLAND
ALL RIGHTS RESERVED.

THESE MAPS ARE PROTECTED BY COPYRIGHT. THEY MAY NOT BE COPIED
OR REPRODUCED IN ANY FORM INCLUDING ELECTRONIC MEANS SUCH AS:
DIGITIZING, SCANNING, VECTORIZING, OR IMAGE PROCESSING, OR BY ANY
SYSTEM NOW KNOWN OR TO BE INVENTED WITHOUT PERMISSION IN
WRITING FROM THE MARYLAND OFFICE OF PLANNING.

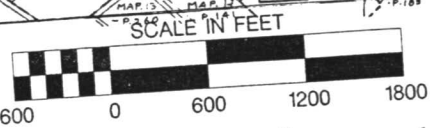

13

COMPILED BY:
MARYLAND OFFICE OF
PROPERTY MAPPING
THE INFORMATION SHOWN HEREON HAS
BEEN DERIVED FROM DEED RECORDS AND IS NOT
GUARANTEED TO BE ACCURATE. IT SHOULD NOT BE USED FOR LEGAL
NOTING ERRORS ARE LARGELY TO NOTIFY
MAPPING SECTION, 300 W. PRESTON ST.
DATE
REVISED TO: FFR

767
1694 St. Michael's Rd Map 7 Parcel 293