

14 23903

# PERMIT

18422

SEWAGE DISPOSAL SYSTEM

MARYLAND STATE DEPARTMENT OF HEALTH

HOWARD COUNTY

*Installed not approved*  
*RAB*

ELLICOTT CITY  
DISTRICT 3rd

REINDEXED

INDEXED

03-299503

DATE 1/9/76

Fjord Construction Inc.

IS PERMITTED TO INSTALL ☒ ALTER ☐

ADDRESS 12101 Belair Road, Kingsville, Md. 21087 PHONE

A SEWAGE DISPOSAL SYSTEM LOCATED AT

SUBDIVISION Woodmark ROAD 12187 Rilland Court LOT 22, B.L. P. Sec. 11

PROPERTY OWNER Fjord Construction Inc. J.L. & D.M. HYNES, JR

ADDRESS SAME AS ABOVE

SPECIFICATIONS 4 bedrooms

DRAIN FIELD DEPTH FEET. BOTTOM AREA SQ. FT.

SEEPAGE PITS ABSORBENT SIDE-WALL AREA SQ. FT.

SEPTIC TANK CAPACITY 1250 GALLONS

FOR GARBAGE GRINDER, INCREASE DISPOSAL AREA 22% & TANK CAPACITY 50%.

OTHER DRY WELL - Dig pit 13 ft. square - set block and top for 10 or 12 ft. diameter and fill in rest of pit with gravel. Inlet to dry well to be 4 ft. below original grade. Maximum depth of dry well 11 ft. below original grade. Come off dry well 3 ft. solid pipe (earth buffer) and begin trench. Trench to be 30 ft. long, 11 ft. deep, with 7 ft. stone under pipe. Place dry well 240 ft. from front lot line and 20 ft. from left side line (point where the 112 ft. and 112 ft. part of left join) as seen when facing from the front court. CALL FOR INSPECTION OF TRENCH BEFORE GRAVEL IS INSTALLED. NOTE: ALL PIPE FROM HOUSE TO DISPOSAL AREA MUST BE CAST IRON. PERMIT VOID AFTER THREE YEARS. NOTE: INSTALL STAND PIPE ON SEPTIC TANK AND DRYWELL. STAND PIPES MUST BE 6 INCHES IN DIAMETER. CAST IRON, CONCRETE OR TERRA COTTA ACCEPTED.

PLANS APPROVED BY Donald W. Monaghan DATE 6/15/76

FOR SEPTIC TANK AND DISTRIBUTION BOX WITH WATER BEFORE CALLING FOR AN INSPECTION. COVER NO WORK UNTIL INSPECTED AND APPROVED.

NEITHER THE HOWARD COUNTY COMMISSIONERS NOR THE HEALTH DEPARTMENT IS RESPONSIBLE FOR THE SUCCESSFUL OPERATION OF ANY SYSTEM.

28520


*not trench follow contour of ground*

ORIGINAL PERMIT SIGNED AND RETURNED 10-29-89 Serial #B0121091

attached garage

18422

14 23903

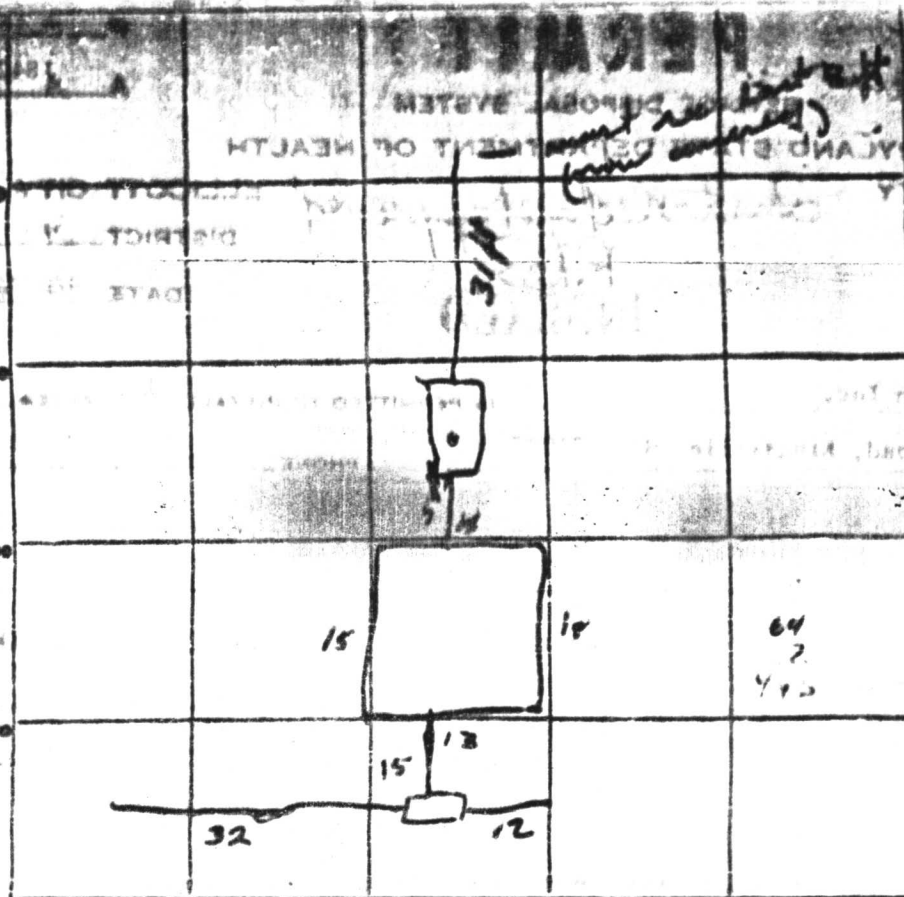

INDICATE NORTH - NAME ADJOINING ROADWAY AS BASE LINE.

PERMIT CARD ☒

SEPTIC TANK, LEVEL ☒

CLEANOUTS DW | ST Manhole

DISTRIBUTION BOX, LEVEL ☒

TILE FIELD, DEPTH 10 FT. TRENCH WIDTH 2 FT.

GRAVEL DEPTH          IN. TOTAL LENGTH 44 FT.

NUMBER OF TRENCHES 2 TOTAL BOTTOM AREA         


SEEPAGE PYS, INSIDE DIAMETER 64 FT. DEPTH BELOW INLET 6 FT.

ABSORBENT AREA 384 SQ. FT.

REMARKS

Unable to determine original grade and need  
to speak to DM about locations (conflict with  
specs and plan RAS 19 NOV 76. Add Manhole to  
septic tank C/O to dunnell shovel to trench


Exist. 80' Maryland Gas  
-Transmission Corp.  
Pipelng R/W

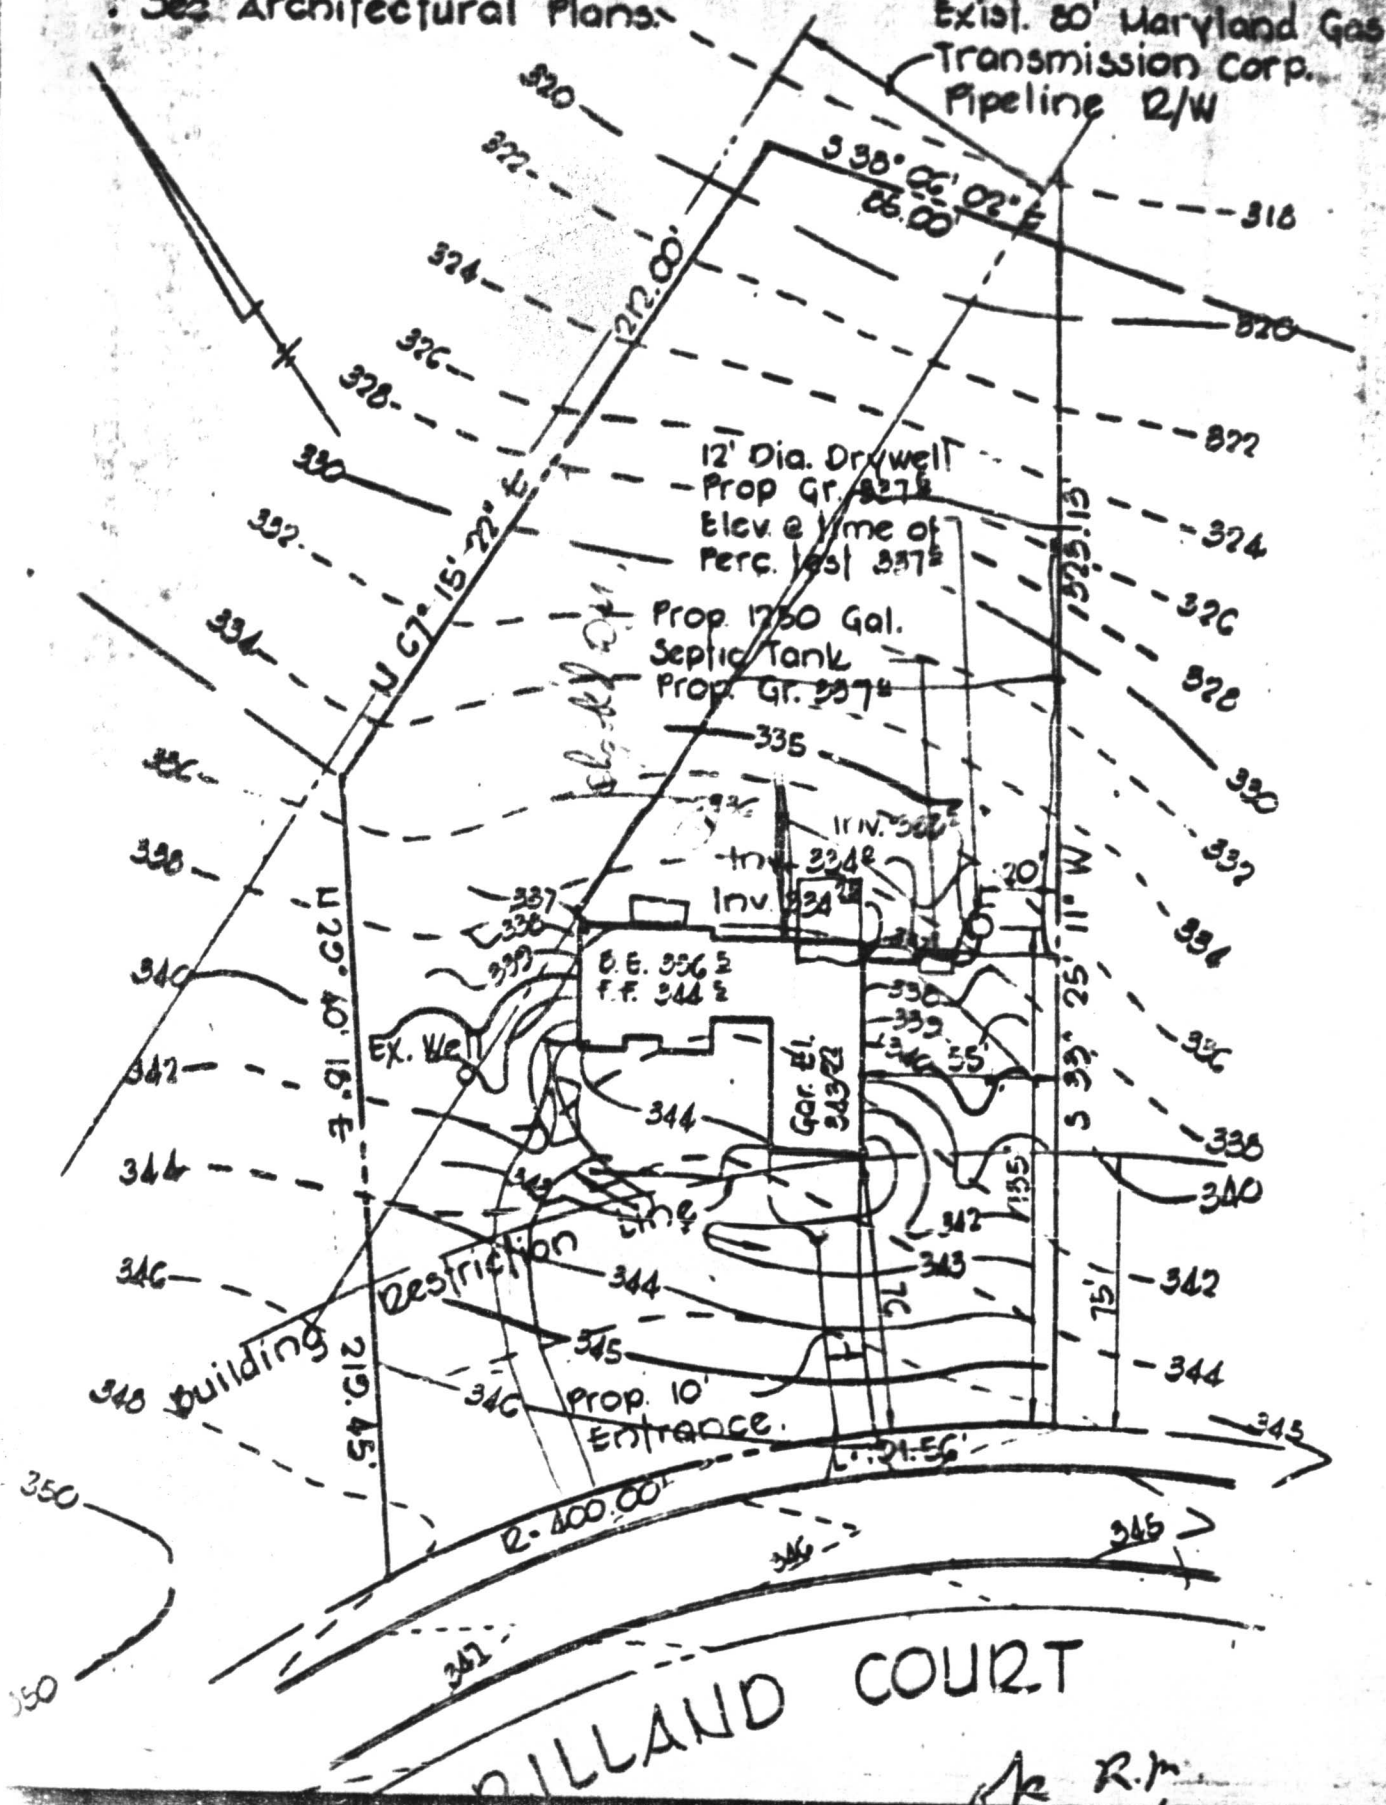

10/29/99

Proposed garage  
location OK  
as shown

(JCS)

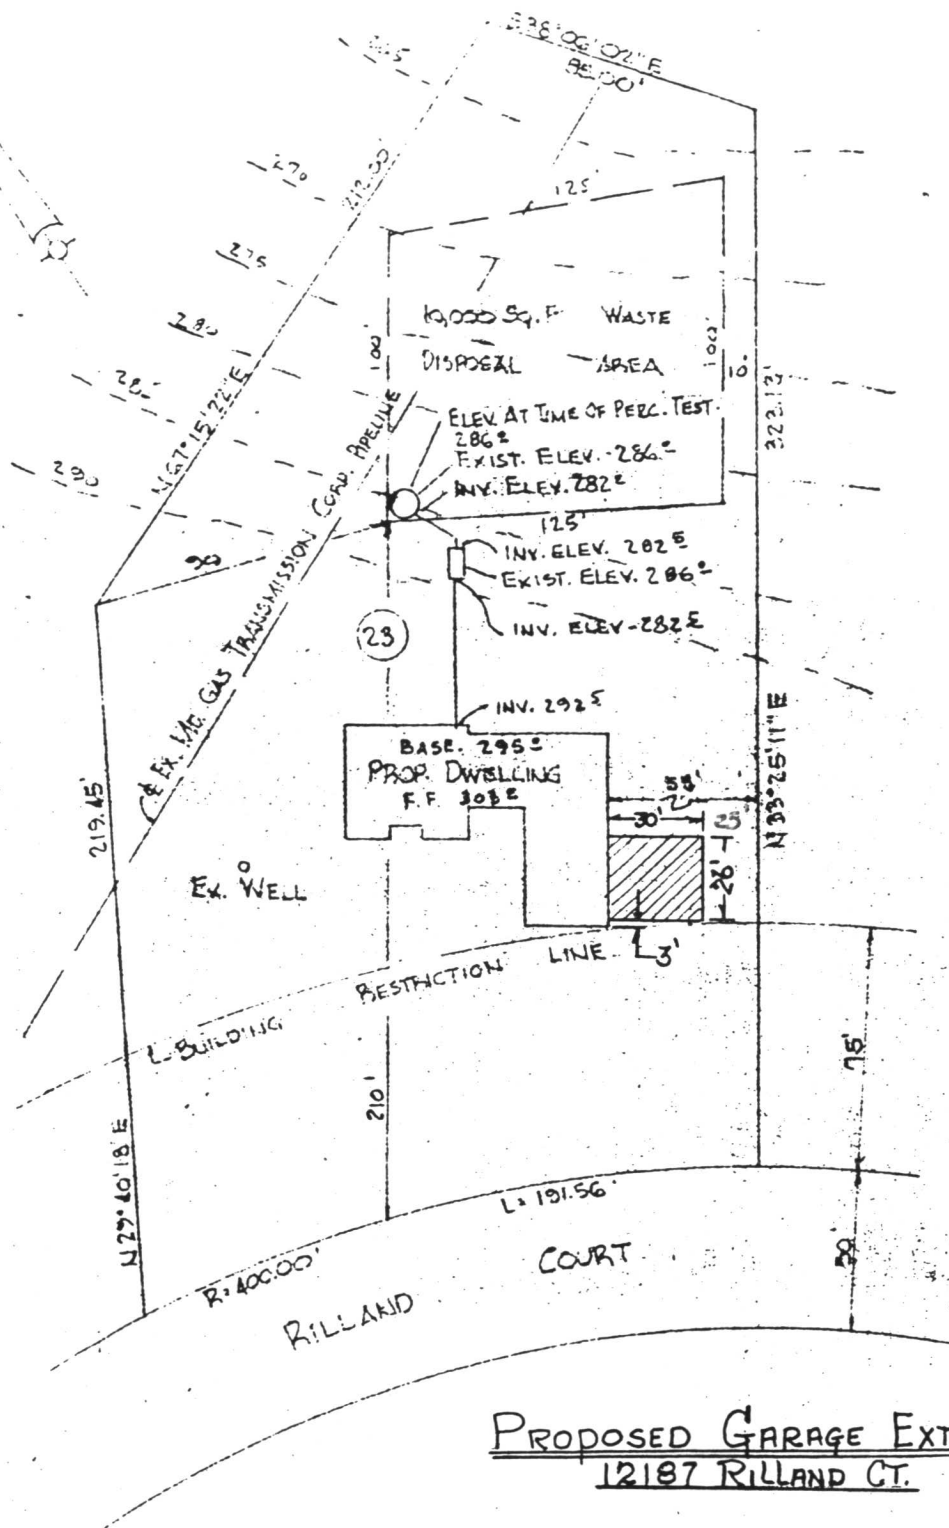

PLOT PLAN

LOT 23

SECTION II

WOODMARK

3rd ELECTION DISTRICT

HOWARD COUNTY, MD

**SHENK-STILL**  
ASSOCIATES, INC.

43 EAST LEE STREET  
BEL AIR, MARYLAND, 21014

DATE

SCALE

FILE NO.

18 MAY 1976

1" = 50'

7460-0

10:31 AM 6251851