

PERMIT

SEWAGE DISPOSAL SYSTEM

MARYLAND STATE DEPARTMENT OF HEALTH*

HOWARD COUNTY

04-324072

ELLICOTT CITY

DISTRICT 3rd

DATE 12/21/81

INDEX

W. Gordon Alexander

Farm Plemmons

IS PERMITTED TO INSTALL ALTER X

ADDRESS 14801 Rt 144 PHONE _____

SUBDIVISION _____ ROAD _____ LOT _____

PROPERTY OWNER Plemmons

ADDRESS 14801 Rt. 144

SPECIFICATIONS

SEPTIC TANK CAPACITY 1250 GALLONS

DRAIN FIELD _____ DEPTH _____ FEET, BOTTOM AREA _____ SQ. FT.

DEEP TRENCH _____ DEPTH _____ FEET, BOTTOM AREA _____ SQ. FT.

SEEPAGE PITS 1 ABSORBENT SIDE-WALL AREA _____ SQ. FT.

INLET PIPE 2 FT. BELOW ORIGINAL GRADE. MAXIMUM DEPTH _____ FT. BELOW ORIGINAL GRADE

EFFECTIVE DEPTH AT _____ FT. BELOW ORIGINAL GRADE.

LOCATE DISPOSAL AREA 80 FT. FROM East LOT LINE AND 120 FT. FROM North LOT LINE AS SEEN WHEN

FACING LOT FROM Fred. Rd

PLANS APPROVED BY CBS DATE 11/12/76

COVER NO WORK UNTIL INSPECTED AND APPROVED.

NEITHER THE HOWARD COUNTY COUNCIL NOR THE HEALTH DEPARTMENT IS RESPONSIBLE FOR THE SUCCESSFUL OPERATION OF ANY SYSTEM.

NOTE: IF TRENCH IS USED CALL FOR INSPECTION BEFORE PLACING GRAVEL IN TRENCH.

NOTE: NO DRY WELL SHALL EXCEED 15 FOOT IN DIAMETER.


NOTE: ALL PIPE FROM HOUSE TO DISPOSAL AREA MUST BE CAST IRON.

PERMIT VOID AFTER THREE YEARS.

NOTE: INSTALL STAND PIPE ON SEPTIC TANK AND DRY WELL. STAND PIPES MUST BE 6 INCHES IN DIAMETER. CAST IRON, CONCRETE OR TERRA COTTA ACCEPTED.

*INSTALLER IS RESPONSIBLE FOR OBTAINING FINAL APPROVAL ON THIS PERMIT.

Bushy PK

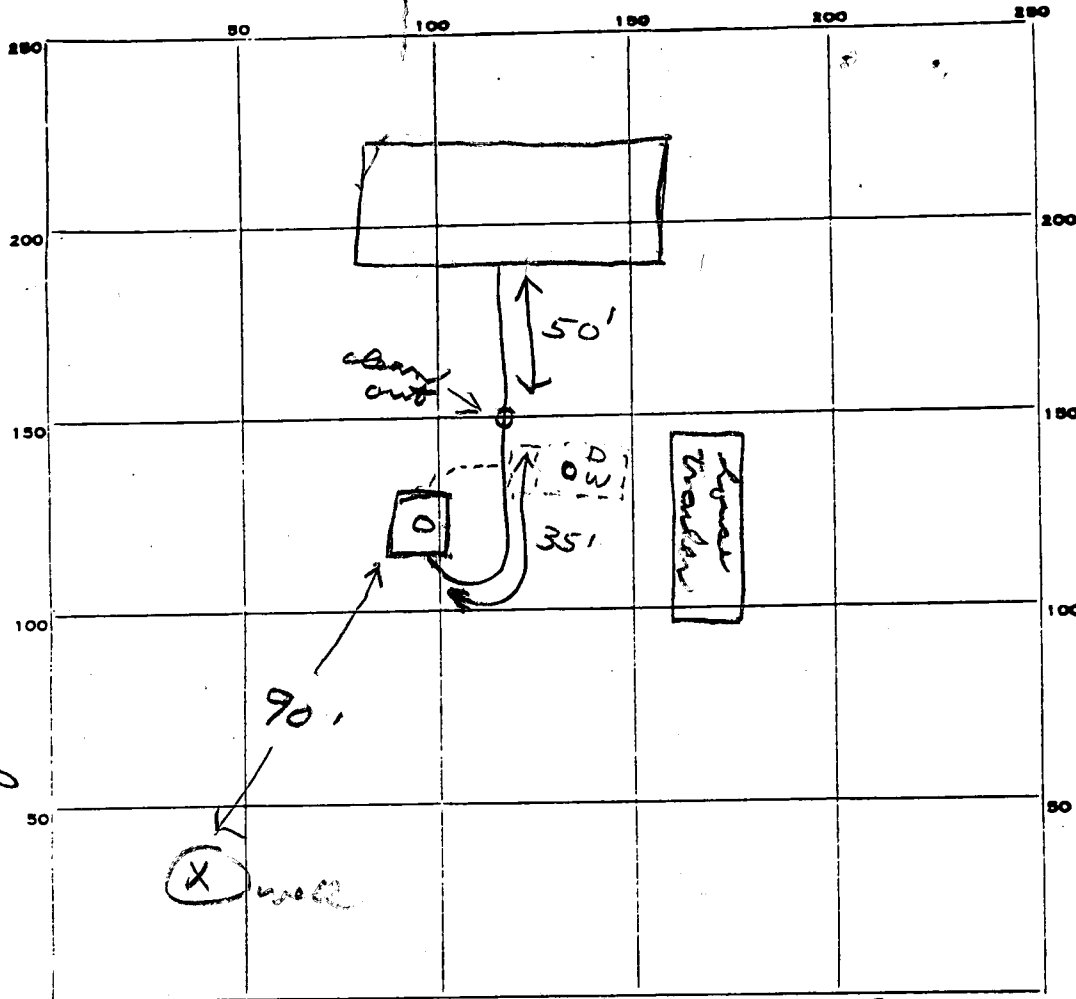

23946

INDICATE NORTH - NAME ADJOINING ROADWAY AS BASE LINE.

PERMIT CARD



RT 144

SEPTIC TANK, LEVEL

CLEANOUTS

ST / DW

DISTRIBUTION BOX, LEVEL

L / Lenna cotta

TILE FIELD, DEPTH _____ FT. TRENCH WIDTH _____ FT.

GRAVEL DEPTH _____ IN. TOTAL LENGTH _____ FT.

NUMBER OF TRENCHES _____ TOTAL BOTTOM AREA _____

SEEPAGE PITS, INSIDE DIAMETER _____ FT. DEPTH BELOW INLET _____ FT.

ABSORBENT AREA _____ SQ. FT.

REMARKS 5/26/81 OK to cover all work. House track to be moved soon as house occupied. fl

DATE SYSTEM APPROVED

5/26/81

INSPECTOR

Stager

PRELIMINARY

APPLICATION

23946

SEWAGE DISPOSAL TESTING

STATE OF MARYLAND - DEPARTMENT OF HEALTH AND MENTAL HYGIENE

HOWARD COUNTY HEALTH DEPARTMENT
ENVIRONMENTAL HEALTH SERVICESP. O. BOX 476, ELLICOTT CITY, MARYLAND 21043
TELEPHONE: 465-5000, EXT. 356

DISTRICT 4th

DATE 9/21/76

1000 gallons
1250 gallons

Septic Tank { 1-3 Bedrooms
4 Bedrooms } Dry well & trench to have
160 sq. ft. effective absorbent sidewall area per bedroom
below first 6' of original ground. Unit can come in at
4' and maximum depth 13'. Location 10' off rear
property line and 100' from left property line where
facing lot from Bushy Park Rd. (Per hole 1+2)

TO: THE COUNTY HEALTH OFFICER
ELLICOTT CITY, MARYLANDI, HEREBY, APPLY FOR THE NECESSARY TEST IN ORDER TO CONSTRUCT (OR RECONSTRUCT) A SEWAGE
DISPOSAL SYSTEM.

PROPERTY OWNER

Robert & Lucille Maisonneuve property

ADDRESS

7715 East Hill Road, Mt. Airy, Md.
Chick's Carry Out, 14600 Frederick Road,
Goochesville, Maryland 21720

Any questions call Mrs. Rose

Trager, 442-2277

PHONE Office: 992-7100

PROPERTY LOCATION:

SUBDIVISION

14600 Frederick Road

LOT NO. Proposed Lot 2

ROAD AND DESCRIPTION

Corner of Route 144 and Bushy Park Road

SIZE OF LOT

(?)

TYPE BLDG.

3 or 4 bedrooms

NUMBER OF BEDROOMS

IF NOT SINGLE RESIDENCE DESCRIBE

THE SYSTEM INSTALLED UNDER THIS APPLICATION IS ACCEPTABLE ONLY UNTIL PUBLIC
FACILITIES BECOME AVAILABLE.

SIGNATURE OF APPLICANT

/s/ Mrs. Rose Trager

BLDG. PERMIT SIGNED

AND RETURNED

5/12/80

APPROVED BY

C. B. Straker

FOR

Dry Well & Trench
(KIND OF SYSTEM)

DATE

11/12/76

REJECTED BY

FOR

(KIND OF SYSTEM)


DATE

HOLD PENDING FURTHER TESTS

DATE

REASONS FOR REJECTION OR HOLDING

THIS IS NOT A PERMIT

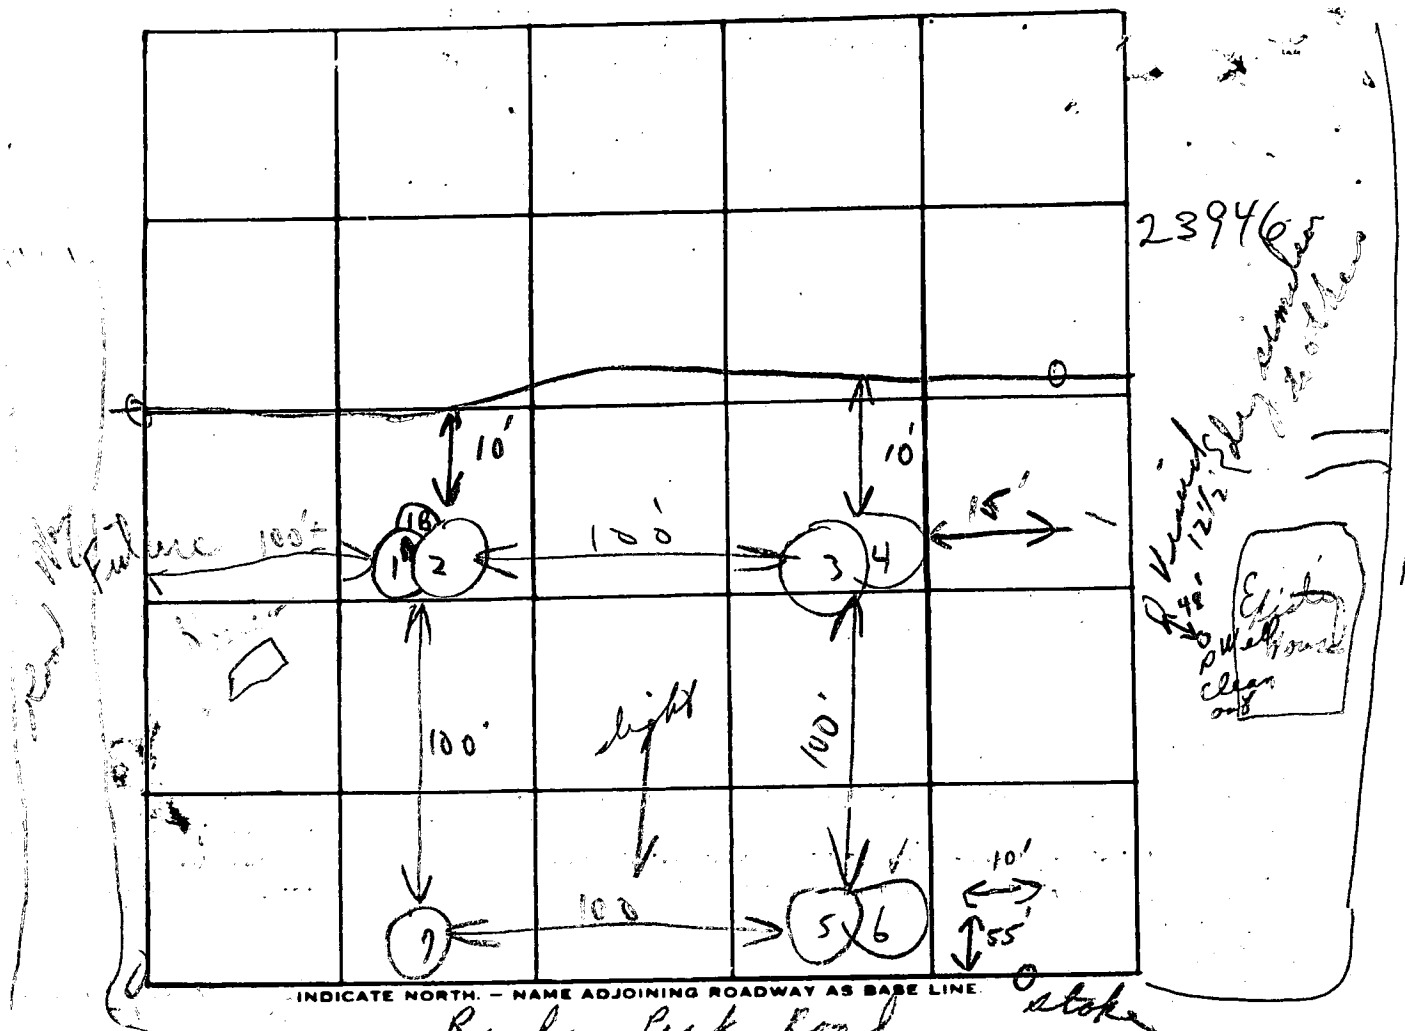

DATE	TEST NO.	DEPTH	PRE-WET		TEST - 1" DROP		TIME
			START	STOP	START	STOP	
11/4/76	1 A	5'	10:10	10:25	10:25		
	2	13'	10:10	10:16	10:16	10:34	18 min
	3	4 1/2'	10:12	10:22	10:22	10:43	21 min
	4	12'	10:12	10:18	10:18	10:33	15 min
	5	5'	10:15	10:18	10:18	10:23	5 min
	6	13'	10:15	10:18	10:18	10:23	5 min
	7	(12'	Visual similar to other)				
	1 B	6'	10:56	10:58	10:58	11:04	6 min
						6	70

REMARKS Not open for a level

TYPE OF SOIL Red loam below clay

TESTED BY C.B.A.

ALSO PRESENT: Mrs. Tracer
+ Mr. Antelope + man

Soil Profile

Loam below clay

10:50 lowered shell to 6'

21 min

15 min

5 min

5 min


6 min

6

70

12 min

23946
 by H. Richard
 Moale
 11/76

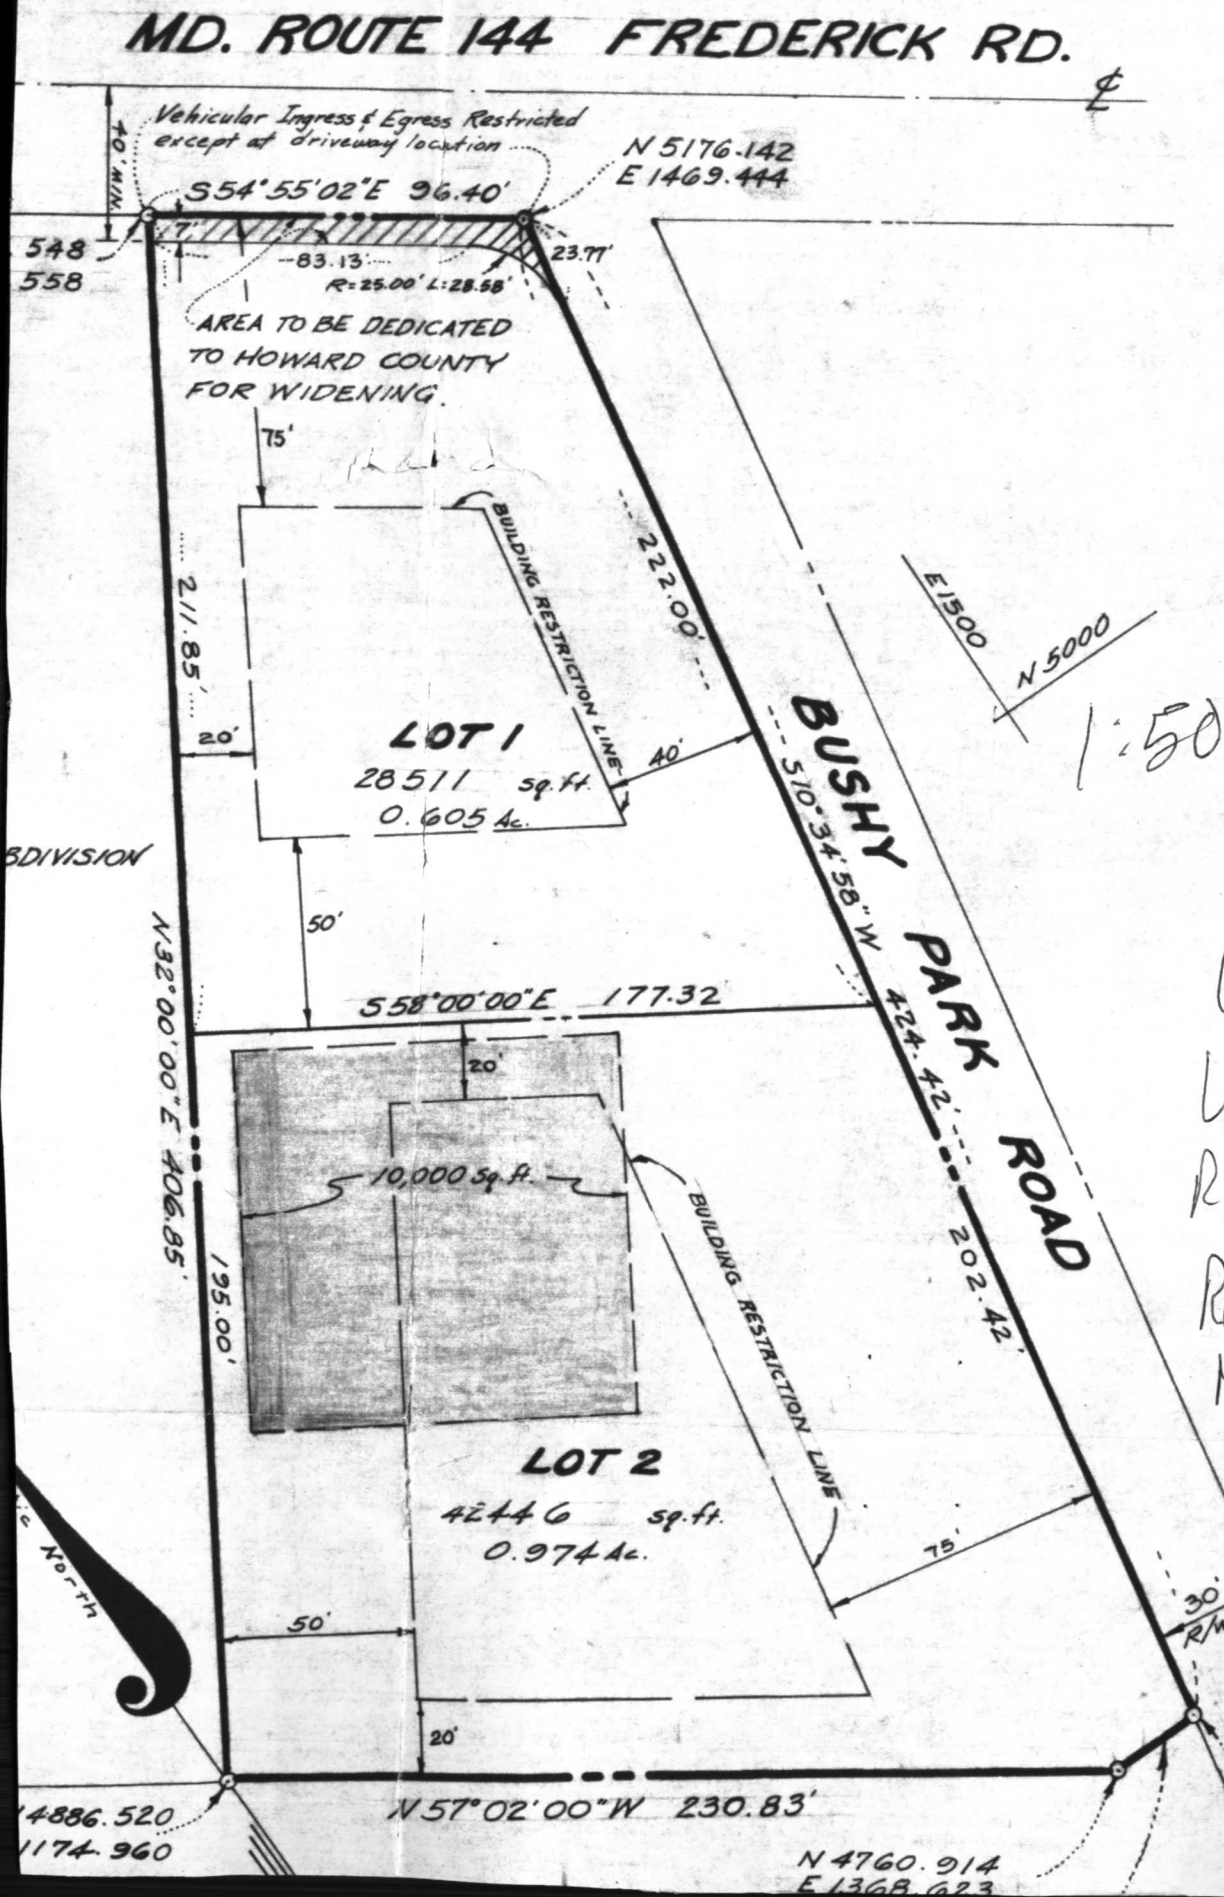

JONES, WALL
 Liber 550 Folio 492

Copy of
 Unsigned
 Record Plat
 Robt. & Lucille
 Maisonneuve
 Prop
 Lots 1 & 2

FREDERICK RD.

Serial No. 41
Temporary trailer
Permit was signed
for them to put
temporary trailer
on property while
house is being
erected.

house is
5000 Constructed.
Told they could
use existing system
for trailer but when
new house is
constructed need
to put in new
septic system.
is to

This is to
be combined
and used
as one body.
Not only
according to
Mr. Plummer

