

PERMIT

SEWAGE DISPOSAL SYSTEM

MARYLAND STATE DEPARTMENT OF HEALTH

HOWARD COUNTY

INDEXED

05-351391  
INDEXED

ELLICOTT CITY

DISTRICT

DATE 8/21/76

William Hopkins

IS PERMITTED TO INSTALL ☒ ALTER

ADDRESS Jennings Chapel Road, Woodbine, Md. 21797 PHONE 888-4711

A SEWAGE DISPOSAL SYSTEM LOCATED AT

SUBDIVISION Beaufort Park ROAD 8364 Reservoir Road LOT 7, Blk. C Sec. 8A

PROPERTY OWNER Anne Kondrup Gray Hu-j-Kun Chacinec

ADDRESS Beaufort Drive, Fulton, Md.

SPECIFICATIONS 4 bedrooms

DRAIN FIELD DEPTH FEET, BOTTOM AREA SQ. FT.

SEEPAGE PITS ABSORBENT SIDE-WALL AREA SQ. FT.

SEPTIC TANK CAPACITY 1,250 GALLONS

FOR GARBAGE GRINDER, INCREASE DISPOSAL AREA 25% & TANK CAPACITY 50%.

OTHER DRY WELL to have 125 sq. ft. effective absorbent sidewall area for disposal below inlet. Inlet to be 4 ft. - 5 ft. below original ground, and maximum depth 13 ft. Location 25' from right property line and 110' from front of lot facing lot from Reservoir Road.

NOTE: ALL PIPE FROM HOUSE TO DISPOSAL AREA MUST BE CAST IRON.

PERMIT VOID AFTER THREE YEARS.

NOTE: INSTALL STAND PIPE ON SEPTIC TANK. STAND PIPES MUST BE 6" INCHES IN DIAMETER. CAST IRON, CONCRETE OR TERRA COTTA ACCEPTED.

PLANS APPROVED BY C.B. Steenaker

DATE 3/11/75

FILL SEPTIC TANK AND DISTRIBUTION BOX WITH WATER BEFORE CALLING FOR AN INSPECTION. COVER NO WORK UNTIL INSPECTED AND APPROVED.

NEITHER THE HOWARD COUNTY COMMISSIONERS NOR THE HEALTH DEPARTMENT IS RESPONSIBLE FOR THE SUCCESSFUL OPERATION OF ANY SYSTEM.

BLDG. PERMIT SIGNED

AND RETURNED 1-30-98

Serial # B7110 9658  
Interior Alterations

BLDG. PERMIT SIGNED


AND RETURNED 4/25/91

Serial # 36396  
addition - MR

171213

7 23812

Howard St

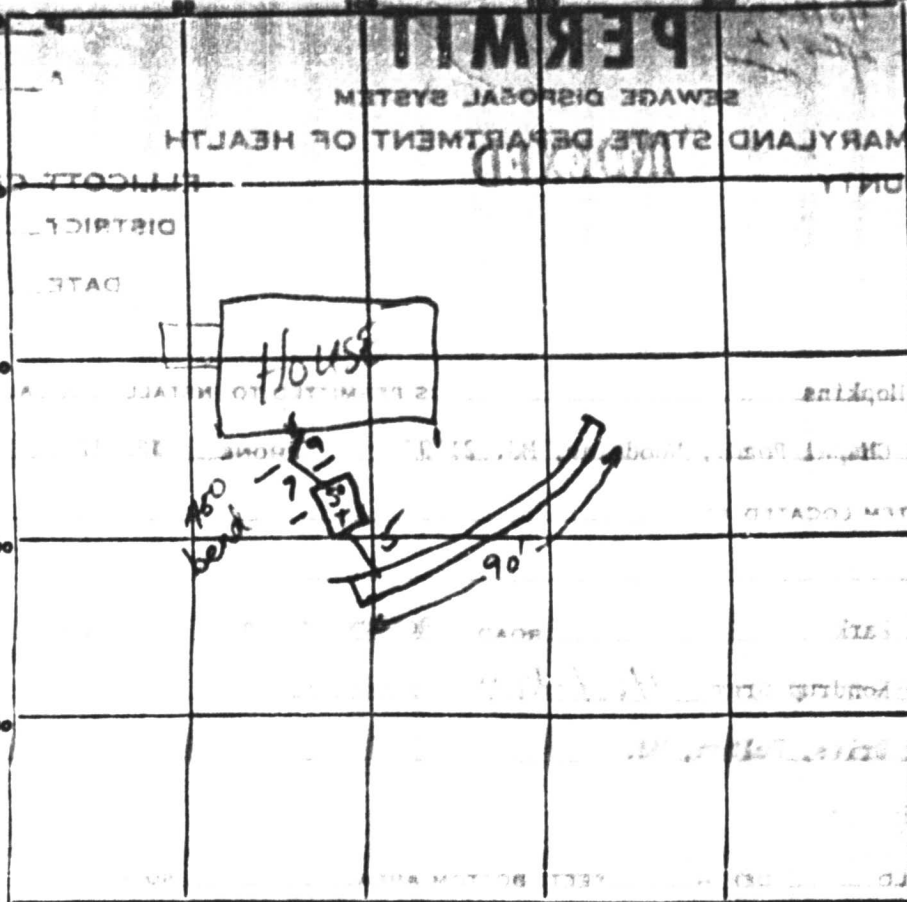

PERMIT CARD none seen

SEPTIC TANK, LEVEL ✓

CLEANOUT ✓

DISTRIBUTION BOX, LEVEL ✓

TILE FIELD, DEPTH 10 1/2 FT. TRENCH WIDTH 2 FT.

GRAVEL DEPTH 8 IN. TOTAL LENGTH 90 FT.

NUMBER OF TRENCHES 1 SIDEWALL TOTAL BOTTOM AREA 720

SEEPAGE PITS, INSIDE DIAMETER     FT. DEPTH BELOW INLET     FT.

ABSORBENT AREA     SQ. FT.

REMARKS 9/1/46 spec call for DW but 90' long trench was installed. 2 1/2'-3' of top has been cut fr. over deposited area. Trench is 10 1/2' deep (average). ∴, if 2 1/2' has been cut off top, ~~gravel~~ we should have absorbent sidewall to w/in 18" of top of ground. → 9/3 corrugated pipe used - experimental system 1/9 WWS.

DATE SYSTEM APPROVED 9/3/46 INSPECTOR R J O'Neill

# APPLICATION

A 17213

SEWAGE DISPOSAL TESTING

P

MARYLAND STATE DEPARTMENT OF HEALTH

HOWARD COUNTY

ELLICOTT CITY

DISTRICT 5

DATE 7/24/72

TO: THE COUNTY HEALTH OFFICER  
ELLICOTT CITY, MARYLAND

I, HEREBY, APPLY FOR THE NECESSARY TESTS IN ORDER TO CONSTRUCT OR RECONSTRUCT A SEWAGE DISPOSAL SYSTEM.

PROPERTY OWNER Anne Kondrup GrayADDRESS Reservoir Road, Fulton, Maryland

Any questions call Mr. Bell, 75

PHONE

PROPERTY LOCATION:

SUBDIVISION Beaufort ParkLOT NO. 7, Blk. C, Sect. 4-AROAD AND DESCRIPTION Reservoir Road

OCCUPANT

PHONE

PERSON TO CONSTRUCT SYSTEM

ADDRESS

PHONE

SIZE OF LOT 41,000 sq. ft.TYPE BLDG. 3 or 4 bedrooms

NUMBER OF BEDROOMS

IF NOT SINGLE RESIDENCE DESCRIBE

SIGNATURE OF APPLICANT /s/ Anne Kondrup Gray

APPROVED BY

FOR

(KIND OF SYSTEM)

DATE

REJECTED BY

FOR

(KIND OF SYSTEM)


DATE

HOLD PENDING FURTHER TESTS

DATE

REASONS FOR REJECTION OR HOLDING

THIS IS NOT A PERMIT

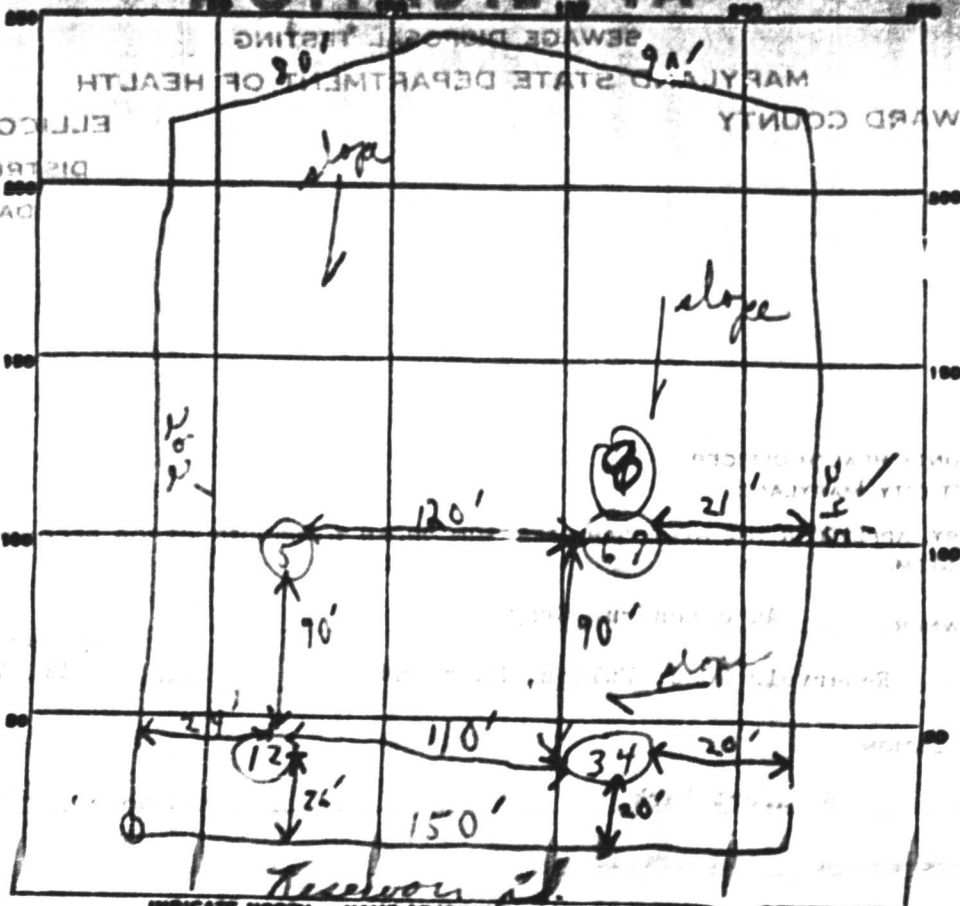

608-7C

| DATE    | TEST NO. | DEPTH             | PRE-WET      |      | TEST - 1" DROP |      | TIME  |
|---------|----------|-------------------|--------------|------|----------------|------|-------|
|         |          |                   | START        | STOP | START          | STOP |       |
| 8/23/25 | 1        | 4' s              | 154          | 156  | 155            | 159  | 3 min |
|         | 2        | 10' d             | water at 10' |      |                |      |       |
|         | 3        | 5' sandy top      |              |      |                |      |       |
|         | 4        | 10' good soil     |              |      |                |      |       |
|         | 5        | 10 1/2' good soil |              |      |                |      |       |
|         | 6        | 4'                | 201          | 205  | 205            | 212  | 7 min |
|         | 7        | 11'               | 202          | 205  | 205            | 210  | 5 min |
| 6/7/16  | 8        | 15'               | ALL SAND DRY |      |                |      |       |

4 min  
aver

chubty ft.

SOIL AUGER FINDING

Measure Front line for stake property line

TESTED BY RS

142 lowest

REMARKS

Area 6 + 21

THIS IS

APPLICATION

HOWARD COUNTY

17213

SERIAL NUMBER

## PERMIT APPLICATION

DEPARTMENT OF INSPECTIONS, LICENSES &amp; PERMIT

3430 COURT HOUSE DRIVE, ELLICOTT CITY, MARYLAND 21043

\$163

B00009658

BUILDING ADDRESS (HOUSE NO., STREET, TOWN OR AREA)

8364 RESERVOIR RD.  
FULTON, MD. 20759

34039

GRADING/SEDIMENT CONTROL ☐ YES ☐ NO

SDP #

DESCRIPTION OF WORK AUTHORIZED 1ST & 2ND FLOOR  
REMODELING OF EXISTING STRUCTURE  
AFTER FIRE AND SMOKE DAMAGE  
DET 97 - REMOVE AND REPLACE WITH  
SAME (EXISTING) BATH AND KITCHEN  
FIXTURES CHANGE WALLS AS NOTED WITH  
HIGHLIGHTER. REPLACE ROOF TRUSSES & CEDAR  
ROOF.

| LOT NO.       | PARCEL NO. | SEC.  | AREA     | BLOCK NO.   | LIBER      | FOLIO |
|---------------|------------|-------|----------|-------------|------------|-------|
| 7             | 49         | 4     | 2        | CS          | -          | 55    |
| SUB DIVISION  |            | ZONE  | ZONE MAP | ELEC. DIST. | CENSUS TR. |       |
| BEAUFORT PARK |            | PP-20 | 45       | 5TH         | 6051.02    |       |

OWNER NAME AND ADDRESS

MR. & MRS. JOHN H.K. & NGON-HWA CHEN  
8364 RESERVOIR RD.  
FULTON, MD. 20759

PHONE NO.

301-490-1409

OCCUPANT'S NAME AND ADDRESS

SAME AS ABOVE

PHONE NO.

ARCHITECT OR ENGINEER'S NAME AND ADDRESS

Huck-Kun Chen

PHONE NO.

CONTRACTOR'S NAME AND ADDRESS

PHONE NO.

REGINALD W. RAINARD CONSTRUCTION INC.  
12000 BERNARD DR.  
WHEATON, MD. 20902

301-933-1949

EXISTING USE

SINGLE FAMILY  
RESIDENTIAL

PROPOSED USE

SINGLE FAMILY  
RESIDENTIAL

EST. CONSTRUCTION COST

\$28,000

LICENSE NUMBER

MHIC38788

PERMIT FEE

| UTILITIES  |              |     |             |              |    |
|------------|--------------|-----|-------------|--------------|----|
| WATER/WELL | SEWER/SEPTIC | GAS | ELECTRICITY | TYPE OF HEAT | AC |
|            |              |     |             |              |    |

I have carefully examined and read this application and know the same is true and correct, and that is doing this work, all provisions of Howard County Ordinances and the State Laws of Maryland will be complied with, whether specified or not; and I will notify the Department of Inspections, and Permits twenty-four hours in advance when I am ready for the inspections called for elsewhere in the application; and that no work will be covered up until such inspections have been complied with.

Reginald W. Rainard  
SIGNATURE  
1-28-97  
DATE

W/S CODE

FOR OFFICE USE ONLY

DISTANCE IN FEET FROM R/W LINE TO FRONT BUILDING LINE

SIDE YARD

(DISTANCE IN FEET FROM SIDE BLDG. LINE TO SIDE PROPERTY LINE)

TO SIDE BUILDING LINE

DISTANCE IN FEET, REAR YD. REQUIRING SET

BACK (CORNER LOT ONLY)

SDP #

Check payable to: DIRECTOR OF FINANCE OF HOWARD COUNTY

## CAUTION

To begin construction before a permit placard has been issued and displayed on the job is a violation of the law.

Use and occupancy permit must be applied for two weeks before it will be issued.

IMPORTANT: PLEASE SHOW ZIP CODES AND AREA CODES WHEREVER REQUIRED.

LP-69-591

CK 6418

APPROVED

DATE

Distribution of Copies:

White - Building Official  
Green - Planning & Zoning

Yellow - Engineering

Pink - Health Dept.

Gold - S.H.A.

AND RETURNED

Serial # 30596  
addition - MB

17213

DATE SYSTEM APPROVED