APPLICATION

PERCOLATION TESTING

44280


DISTRICT _____3

DATE 8-25-88

HOWARD COUNTY HEALTH DEPARTMENT BUREAU OF ENVIRONMENTAL HEALTH P.O. BOX 476 ELLICOTT CITY, MARYLAND 21043 TELEPHONE: 461-9933

O: THE COUNTY HEALTH OFFICER ELLICOTT CITY, MARYLAND	
I, HEREBY, APPLY FOR THE NECESSARY TEST IN ORDER TO CONSTRUCT (OR RECONST	RUCT) A SEWAGE DISPOSAL SYSTEM.
PROPERTY OWNER Vincent Bracciale	
ADDRESS 1830 Wiodstock Rd	PHONE 465-5855 He (, Limit See
PROSPECTIVE BUYER N/A	
ADDRESS	PHONE
PROPERTY LOCATION:	
Subdivision Bracciale Property	LOT NO. 16 COTES
ROAD AND DESCRIPTION DOOLS took Rd north	of MI R+ 99
(1811 Quarter Hors	e Prive)
TAX MAP — 70 PARCEL # 36	
SIZE OF LOT 3.67 & acres	TYPE BLDG SFD
	(SINGLE FAMILY DWELLING OR COMMERCIAL)
THE SYSTEM INSTALLED UNDER THIS APPLICATION IS ACCEPTABLE ONLY UNTIL	PUBLIC FACILITIES BECOME AVAILABLE. I FULLY UNDERSTAND THE
FEE CONNECTED WITH THE FILING OF THIS PERC TEST APPLICATION IS NON-RE	FUNDARI E LINDER ANY CIRCUMSTANCES LAI SO AGREE TO COMPLY
Note that the relation of this tend test are learned in the relation is not the	h In C
WITH ALL M.O.S.H.A. REQUIREMENTS IN TESTING THIS LOT.	(SIGNATURE OF APPLICANT)
APPROVED BYFOR	DATE
REJECTED BY FOR	DATE
HOLD PENDING FURTHER TESTS	DATE
REASONS FOR REJECTION OR HOLDING 5-23-89 Perc Salsfarty - 1	beld for Plat. S.UL
REASONS FOR RESECTION ON HOLDING	BLDG. PERMIT SIGNED
	AND RETURNED 4/28/9/
	Selial #38436-5FD

THIS IS NOT A PERMIT

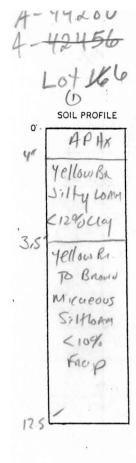

	A CAMPACTURE AND A STATE OF THE	· Annual Control of the Control of t		A SECURITION OF THE SECURITIES OF THE SECURITION	
	¥ .	1			
and the same of th	8		***		
				2	
*	1				x Peac3
×	7 3	105	-4	×	180 DIBN
. ×	7 100=	1	100t-	*	IRO DIBA TWIET S BOTTOM S
X	4	1	H	7	
×	1 × ×	- 100°	910'	×-	
	×			i i i i i i i i i i i i i i i i i i i	20,80 %

INDICATE NORTH - NAME ADJOINING ROADWAY AS BASE LINE.

	TEST NO.		PRE-WET		TEST - 1" DROP		
DATE		DEPTH	START	STOP	START	STOP	TIME
5/23/89	15	3.0	11116	11:19	11:17	11:22	3 Min 2 Min
	IV	12.5-	As Pro.	files	2771		
7/2-	2V	12.0	As PRO				
	35	3,5	11:20 Simila	11:21 u to prof	11:21	11:24	3Min
	4 ×	3.5-	11:22 Simila	11:23 to Profi	11:23	11:25	2 min
				16			
	-			× i			

REMARKS _	Holes NOT	Pen f	PLUT ON STAKES		13/2
TYPE OF SOIL	Glenela				
TESTED BY _	S. Abel			Dale,	0 KQK

. EH-12-1079