HOWARD COUNTY HEALTH DEPARTMENT **BUREAU OF ENVIRONMENTAL HEALTH**

461-9933

PERMIT

SEWAGE DISPOSAL SYSTEM

DEPARTMENT OF HEALTH AND MENTAL HYGIENE

INDEXED

44280

DISTRICT


DATE SYSTEM APPROVED


INSPECTOR
Charles A. Klein & Sons, Inc. IS PERMITTED TO INSTALL X ALTER
ADDRESS 5220 Klees Mill Road, Sykesville, Maryland 21784 PHONE 549-6960
SUBDIVISIONParksideLOT6ROAD1811 Quarter Horse Drive
PROPERTY OWNER Vincent and Theresa Bracciale
ADDRESS Woodstock, Maryland 21163
SEPTIC TANK CAPACITY 1250 GALLONS
NUMBER OF BEDROOMS 4
SQUARE FEET PER BEDROOM
LINEAR FEET OF TRENCH REQUIRED 144
TRENCHES - Trench to be 2 feet wide. Inlet 3½ feet below original grade. Bottom maximum depth 8½ feet below original grade. Effective area begins at 3½ feet below original grade. 5 feet of stone below distribution pipe. LOCATION - Start the first trench 135' from the left lot line and 130' from the rear lot line. Run trenches along contour toward rear of lot. NOTE - No trench to exceed 100 feet in length. Provide 6" - 8" diameter cleanout and cap to grade or above on septic tank. OK 7/18/9/8H
PLANS APROVED BY DATE 10/15/90
COVER NO WORK UNTIL INSPECTED AND APPROVED
NEITHER THE HOWARD COUNTY COUNCIL NOR THE HEALTH DEPARTMENT IS RESPONSIBLE FOR THE SUCCESSFUL OPERATION OF ANY SYSTEM
NOTE: CLEANOUT REQUIRED EVERY 70 FEET OF SEWER LINE AND/OR AT 90° SWEEPS IN LINES FROM HOUSE TO DRAIN FIELDS, 90° ELBOWS NOT ACCEPTABLE.
NOTE: ALL PARTS OF SEPTIC SYSTEMS (I.E. TANK, DISTRIBUTION BOX TRENCHES) TO BE 100 FEET FROM WELL (UNLESS OTHERWISE SPECIFICALLY AUTHORIZED)
NOTE: IF DEEP TRENCH(ES) ARE USED CALL FOR INSPECTION BEFORE AND AFTER PLACING GRAVEL IN TRENCH(ES)
NOTE: NO DRY WELL SHALL EXCEED 15 FOOT IN DIAMETER NO ABSORPTION TRENCH TO EXCEED 100 FEET IN LENGTH
NOTE: ALL PIPE FROM HOUSE TO SEPTIC TANK MUST BE CAST IRON OR SCHEDULE 35/40 PVC OR ABS

PERMIT VOID AFTER TWO YEARS

NOTE: INSTALL STAND PIPE ON SEPTIC TANK AND DRY WELL STAND PIPES MUST BE 6 INCHES IN DIAMETER CAST IRON. CONCRETE OR TERRA COTTA OR PVA OR ABS ACCEPTED. IF TOP OF SEPTIC TANK IS DEEPER THAN 3 FEET. MANHOLE TO GRADE REQUIRED.

NOTE: DISTRIBUTION BOXES MUST HAVE BAFFLES

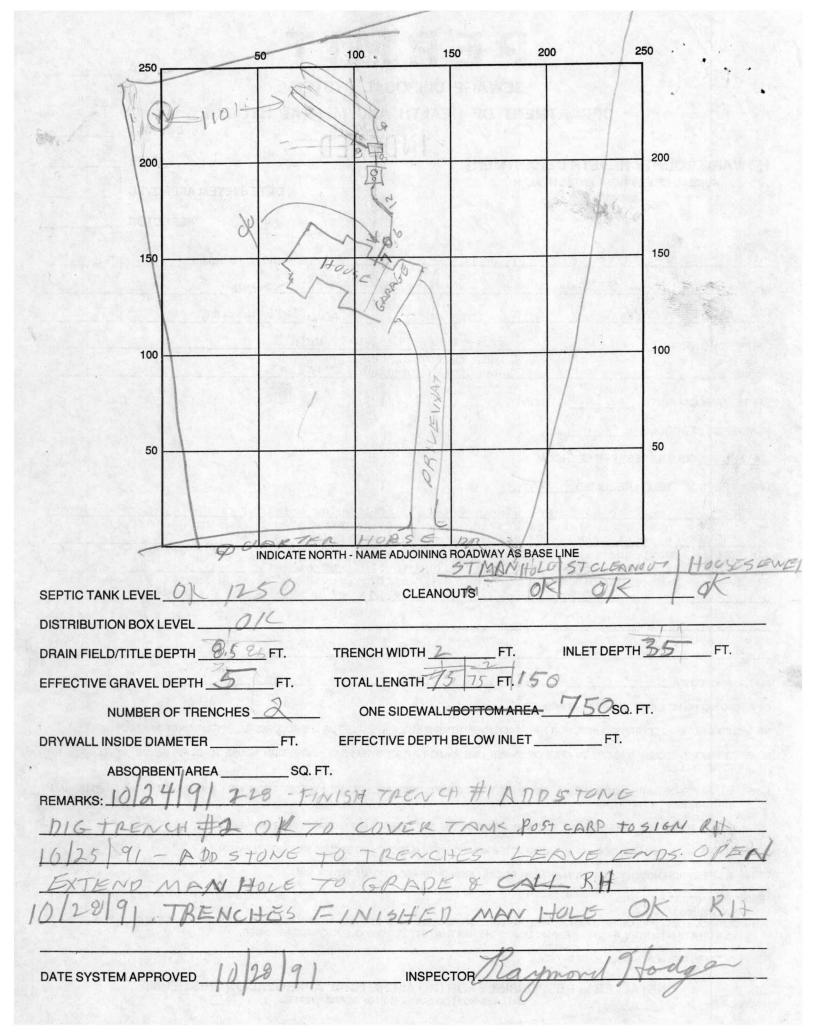

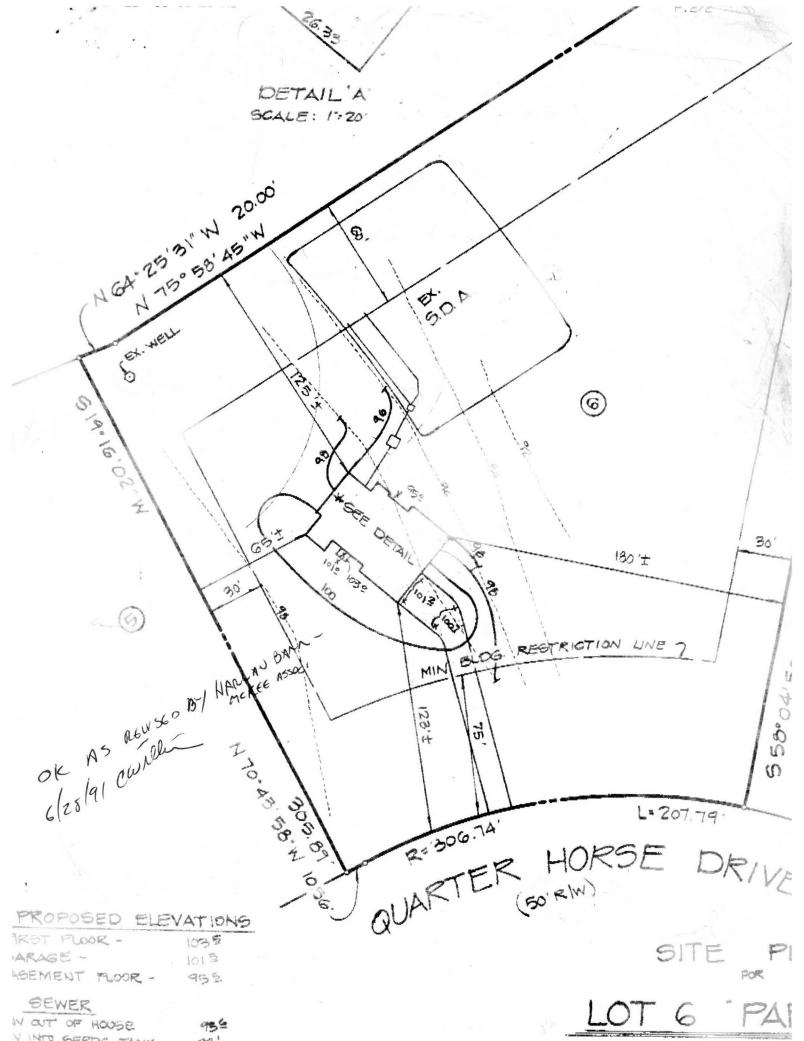

Y INTO SEPTIC TANK 93-

y our of SEPTIC TANK 930 VINTO DIST. BOX 927

Y OUT OF DIST BOX 972

722

CONTRACT PURCHASER

WILLIAM & BONNIE TEAL 3913 FOXHILL DRIVE ELLICOTT GITY, MD 21043 OWNER

SED ELECT DIST.

5CALE: 1"- 50"

A 9681

LOTS 5-17

VINCENT THERES 1830 WOODSTOC WOODSTOCK

CKEE & ASSOCIATES, INC. VIL ENGINEERS - LAND SURVEYORS IAWAN PLACE 5 SHAWAN ROAD INT VALLEY, MD 21030

ONE - (301) 527-1555