

APPLICATION

PERCOLATION TESTING

A 47944

P _____

HOWARD COUNTY HEALTH DEPARTMENT
BUREAU OF ENVIRONMENTAL HEALTH
P.O. BOX 476 ELLICOTT CITY, MARYLAND 21043
TELEPHONE 461-9933

DISTRICT 5th

DATE 3/25/92

TO: THE COUNTY HEALTH OFFICER
ELLICOTT CITY, MARYLAND

I, HEREBY, APPLY FOR THE NECESSARY TEST IN ORDER TO CONSTRUCT (OR RECONSTRUCT) A SEWAGE DISPOSAL SYSTEM.

PROPERTY OWNER Dennis B & Van Malcolm Et. Al.

ADDRESS 2001 Briggs Chaney Road, Silver Spring, MD 20904 PHONE (301) 384-8489

PROSPECTIVE BUYER n/a

ADDRESS _____ PHONE _____

PROPERTY LOCATION:

SUBDIVISION Malcolm Property LOT NO 4 & 7

ROAD AND DESCRIPTION East side of Scaggsville Road (Md. Route 216) 750' plus/minus
northwest of Pindell School Road intersection

TAX MAP 41 PARCEL # 67

SIZE OF LOT 3.535 Acres ± TYPE BLDG Single Family Dwelling
(SINGLE FAMILY DWELLING OR COMMERCIAL)

THE SYSTEM INSTALLED UNDER THIS APPLICATION IS ACCEPTABLE ONLY UNTIL PUBLIC FACILITIES BECOME AVAILABLE. I FULLY UNDERSTAND THE FEE CONNECTED WITH THE FILING OF THIS PERC TEST APPLICATION IS NON-REFUNDABLE UNDER ANY CIRCUMSTANCES. I ALSO AGREE TO COMPLY WITH ALL M.O.S.H.A. REQUIREMENTS IN TESTING THIS LOT. Van S. Malcolm
(SIGNATURE OF APPLICANT)

APPROVED BY _____ FOR _____ DATE _____

REJECTED BY _____ FOR _____ DATE _____

HOLD PENDING FURTHER TESTS _____ DATE _____

REASONS FOR REJECTION OR HOLDING _____

HD-216

THIS IS NOT A PERMIT

A47964

Lot 4

①-④

SOIL PROFILE

0'

org sa
cl loam

3-4

tan sa
lm w/
pink tints
hi mica
10-15%
saprolite
frags12 1/2-13 H₂O @ 11' 9"
in ④

⑤

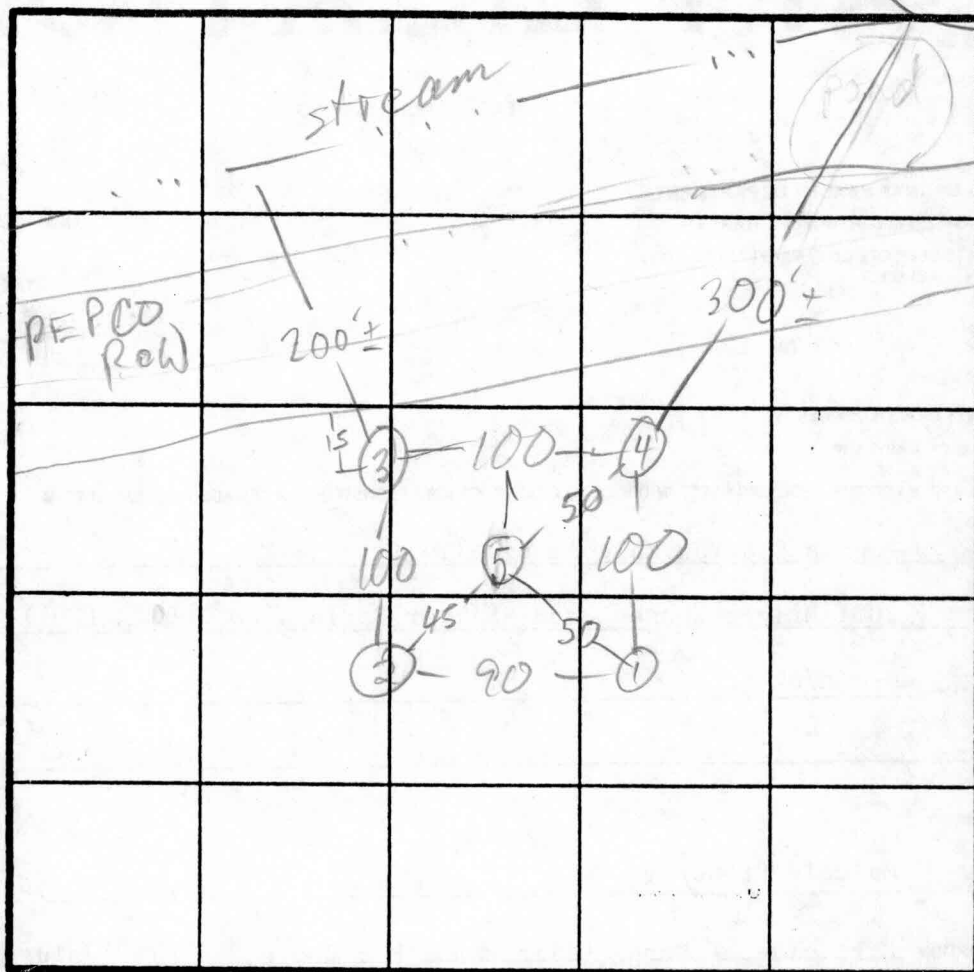
brn
saccl/m

3 1/2

tan
sa
mica
lm
10% frags
H₂O

11' 9"

12' 4"

Holes ①②⑤
X=11
210' BR,
Inlet 4'
Bottom 6'

INDICATE NORTH - NAME ADJOINING ROADWAY AS BASE LINE.

DATE	TEST NO.	DEPTH	PRE-WET		TEST - 1" DROP		TIME
			START	STOP	START	STOP	
4/23/92	1 S	3 1/2	1:57	2:04	2:04	2:14	10
	1 M	7 1/2	4:17	4:18	4:18	4:20	2
	1 V	13	see profile				
	2 S	4	2:01	2:17	2:17	2:38	21
	2 V	13	see profile				
	3 S	4	2:01	2:02	2:02	2:04	2
	3 V	12 1/2	see profile				
	4 S	4 1/2	2:07:30	2:10	2:10	2:16	6
	4 V	12 1/2	H ₂ O @ 11' 9"		2		
4/1/97	5 V	12' 4"	H ₂ O @ 11' 9"		OK		

REMARKS

HOLES PER PLAT ±; PULL SDA UPHILL AWAY FROM ④

TYPE OF SOIL

TESTED BY

M. Rifkin

ALSO PRESENT

Malcolm & horeman

